


AIRCRAFT CRASH SITE

YARRABILBA

LANDSCAPE DOCUMENTATION

SHEET PLAN 1:250

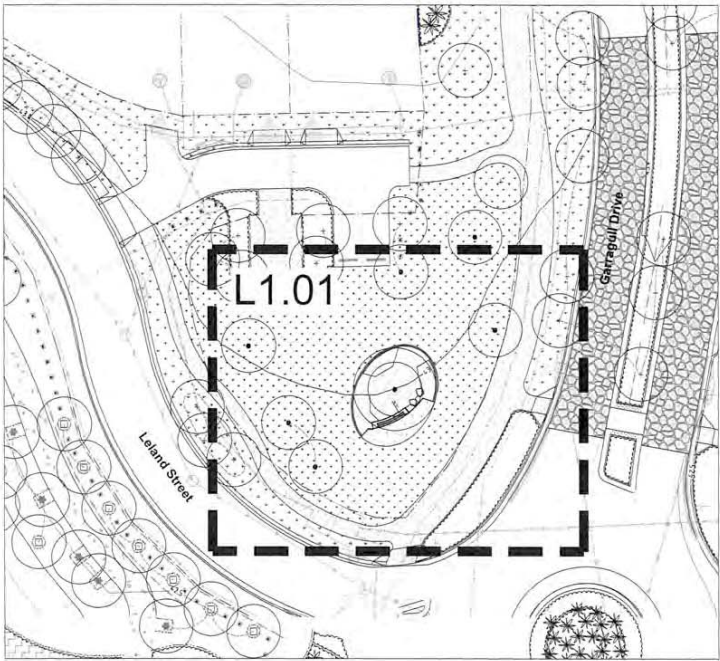

DRAWING SCHEDULE

Drawing Schedule

DWG No.	DWG Title
L0.00	COVER SHEET
L1.01	LANDSCAPE PLAN
L3.01	LANDSCAPE DETAILS

1.0 Do not scale from these drawings - use figured dimensions.

2.0 Services
Verify the 'as built' location of all existing services before excavation works are started. Services shown are indicative only.

3.0 Surface levels
final surface levels to be verified on site. All adjacent surfaces are to be level and flush unless stated or documented otherwise.

4.0 Falls
all pavement, planting & turf areas to be graded evenly. Ponding is unacceptable.

CERTIFIED
27.9.18
E

PLANS AND DOCUMENTS
referred to in the PDA
DEVELOPMENT APPROVAL

Approval no: DEV2018/976
Date: 08/01/19



02	FOR EDQ APPROVAL	27/09/2018	ZLME	DC
01	FOR COSTING AND APPROVAL	25/07/2018	ZLME	MC
Rev. no.	description	date	drawn	appr

PLEASE NOTE:
Annotated dimensions take precedence over scaled dimensions. Contractors are to verify all dimensions on site before commencing any work or producing shop drawings. These drawings are protected by copyright and may not be copied or reproduced without the written permission of RPS Australia East Pty Ltd's management. Refer to L0.00 (cover sheet) for RPS Australia East Pty Ltd drawing disclosures.



RPS Australia East Pty Ltd
ACN 145 252 762
ABN 44 145 252 762
Suite 18, Central Brunswick
455 Brunswick Street
PO Box 2257
Fortitude Valley QLD 4006
T +61 7 3237 8859
F +61 7 3237 8833
W rpsgroup.com.au

client
LENDLEASE

project name
AIRCRAFT CRASH SITE

project location
YARRABILBA

title
COVER SHEET




document reference:
116660-CD - L0.00 - 02
project sheet rev



**PLANS AND DOCUMENTS
referred to in the PDA
DEVELOPMENT APPROVAL**


Approval no: DEV2018/976

Date: 08/01/19

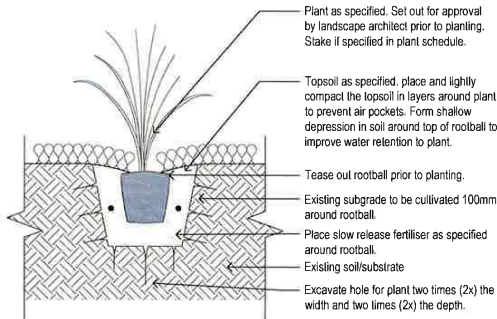


01 Planting in Existing Substrate

SCALE 1:10

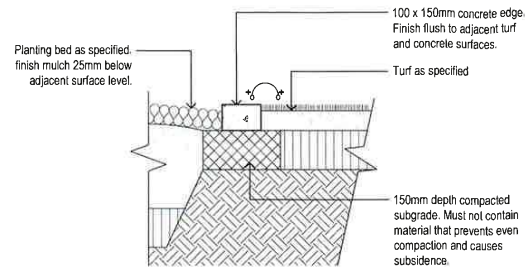


02 Garden Edge

SCALE 1:10

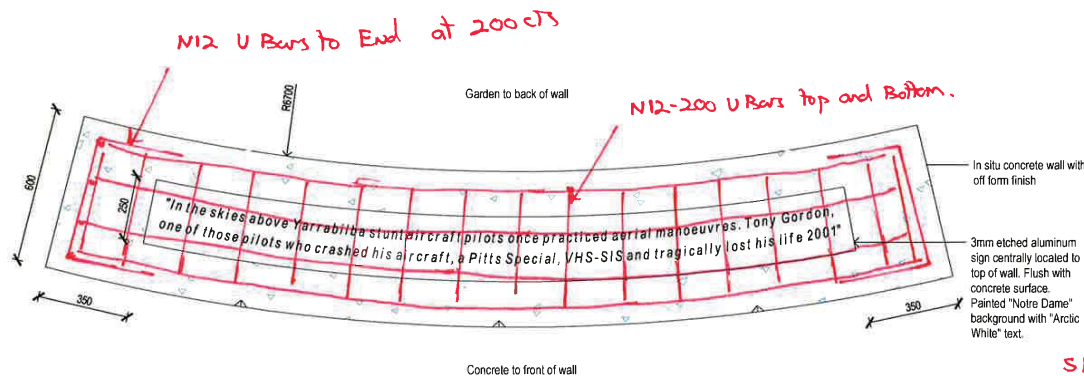


PLAN

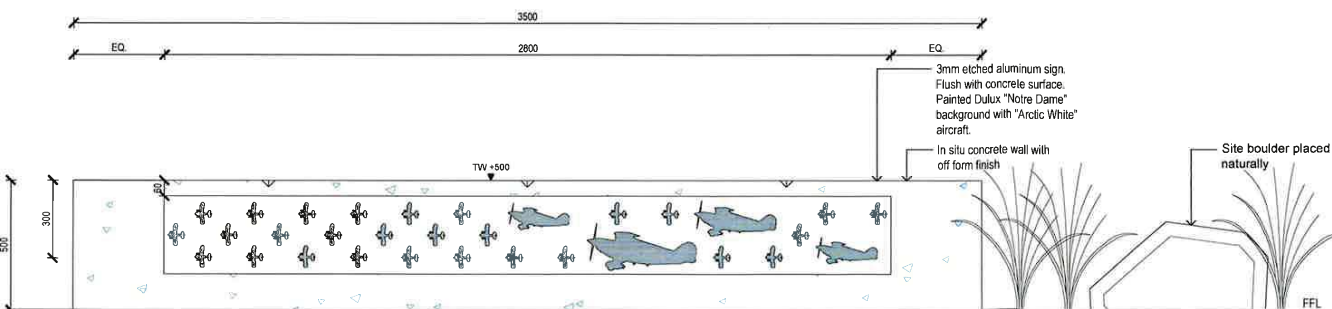

ELEVATION

03 In situ Concrete Wall

SCALE 1:10

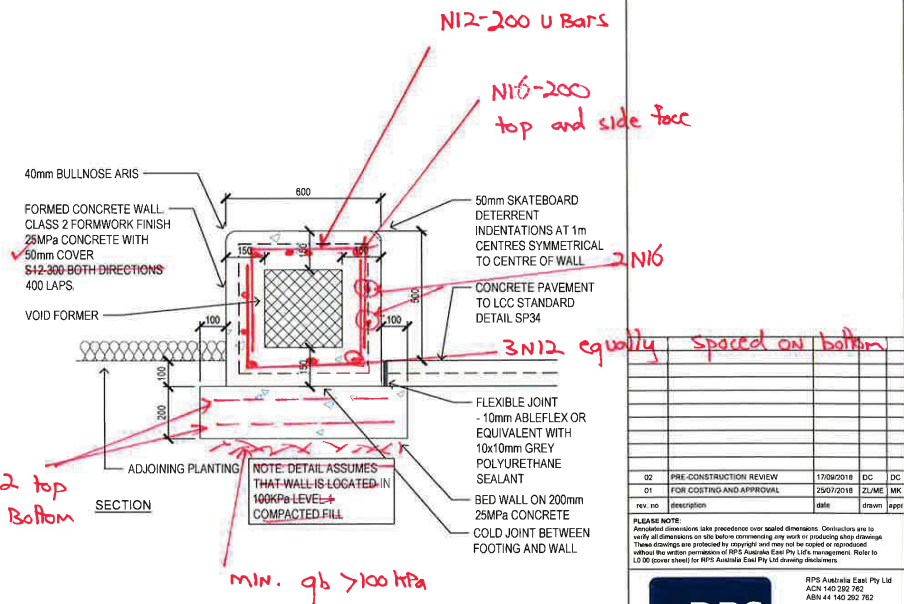

SECTION

rev	no	description	date	drawn	app'd
01	FOR COSTING AND APPROVAL		25/07/2018	ZL/ME	MK

02	PRE-CONSTRUCTION REVIEW	17/06/2018	DC	DC
----	-------------------------	------------	----	----

RPS AN ASSOCIATE OF RPS GROUP AN ASSOCIATE OF RPS GROUP		RPS Australia East Pty Ltd ACN 140 282 762 ABN 44 140 282 762 Suite 18, Central Brunswick 400 Brunswick Street PO Box 237 Fortitude Valley QLD 4006 T +61 7 3237 8899 F +61 7 3237 8833 W rpsgroup.com.au
--	--	---

client	LENDLEASE
project name	AIRCRAFT CRASH SITE
project location	YARRABILBA
title	LANDSCAPE DETAILS
scale	AS SHOWN
project number	116660-CD
drawing number	L3.01
rev	02

Simon Rodenbach
11/11/19 RPEQ 7518