

WATER SYSTEM LEGEND

● FH	PROPOSED FIRE HYDRANT
⊗	PROPOSED ISOLATION VALVE
— W —	PROPOSED WATER MAIN
— M —	PROPOSED WATER METER

OTHER SERVICE LEGEND

— G —	EXISTING GAS MAIN
— SWD —	EXISTING STORMWATER
— T —	EXISTING TELECOMMUNICATIONS
— E —	EXISTING ELECTRICITY
— OH —	EXISTING OVERHEAD ELECTRICITY
— PL —	UNKNOWN PIPELINE
— OF —	EXISTING OPTIC FIBRE
— S —	EXISTING SEWERAGE

DISCLAIMER:

WHILST EVERY EFFORT HAS BEEN MADE TO ENSURE THAT THE INFORMATION PROVIDED IN THIS DRAWING/DESIGN WAS ACCURATE AT THE TIME IT WAS COMPILED, AS PART OF QULU V'S "AS CONSTRUCTED" RECORDS, IT REMAINS THE RESPONSIBILITY OF PROPERTY OWNERS AND THEIR CONTRACTORS, SUB-CONTRACTORS, EMPLOYEES, SERVANTS AND AGENTS AS APPROPRIATE IN THE CIRCUMSTANCES TO MAKE ALL REASONABLE EFFORTS TO ASCERTAIN THE PRECISE LOCATION OF EXISTING INFRASTRUCTURE INCLUDING WATER MAINS, SEWERS AND DRAINS BEFORE UNDERTAKING EXCAVATION OR CONSTRUCTION WORK.

USERS OF THE INFORMATION SHOULD BE AWARE THAT SINCE THE ORIGINAL RECORDING OF THE DEPTHS IN RELATION TO GROUND LEVELS, CHANGES MAY HAVE OCCURRED AS A RESULT OF SUBSEQUENT WORK OF ACTIVITIES INVOLVING FILLING OR EXCAVATION. CONSEQUENTLY, NAXOS ENGINEERS PTY LTD TAKES NO RESPONSIBILITY FOR ANY APPARENT ERROR OR INACCURACIES THAT ARE SHOWN TO EXIST AS AT THE DATE INFORMATION WAS PROVIDED OR AT A LATER DATE.

THE ABOVE ALSO APPLIES TO LOCATION AND DEPTH OF OTHER PUBLIC UTILITIES.

AMENDED IN RED

By: Jennifer Davison

Date: 6 September 2019





PLANS AND DOCUMENTS referred to in the PDA DEVELOPMENT APPROVAL

Approval no: DEV2018/991

Date: 24 September 2019



Western carpark not part of this approval

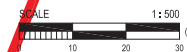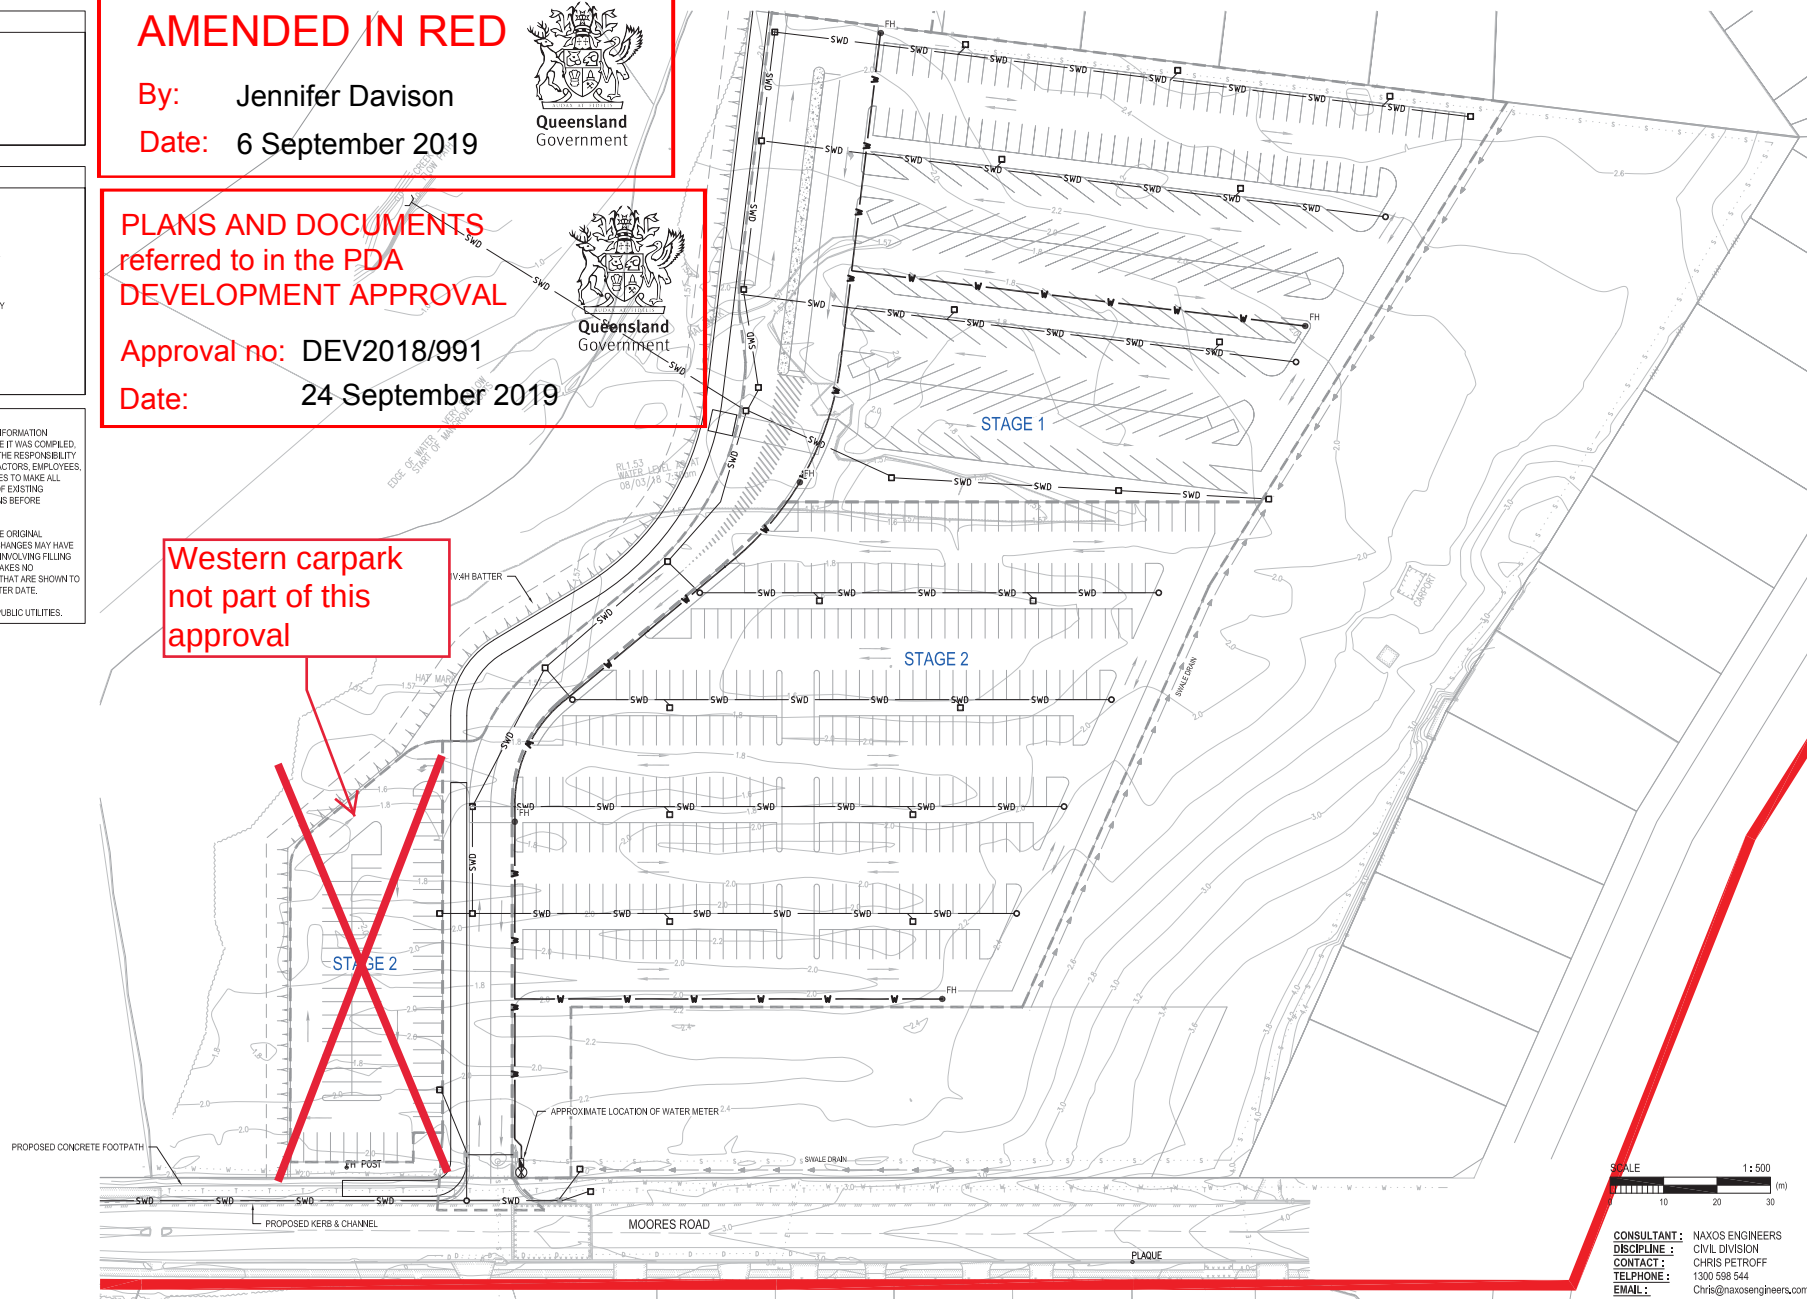

CONSULTANT: NAXOS ENGINEERS
DISCIPLINE: CIVIL DIVISION
CONTACT: CHRIS PETROFF
TELEPHONE: 1300 598 544
EMAIL: Chris@naxosengineers.com.au

NAXOS
ENGINEERS

T 1300 598 544
E info@naxosengineers.com.au
Ground Floor, Suite 1
424 Upper Roma Street, Brisbane 4000
PO Box 224, Spring Hill QLD 4004
NAXOENGINEERS.COM.AU

AMENDMENTS			
No.	DATE	DESCRIPTION	DRAWN
A	3.09.2018	PRELIMINARY ISSUE	SP

Associated Consultant:

RPS GROUP

Approved:

RPEO

Date:

Drawn:

GT

Design:

GT

DISCLAIMER NOTES

THIS PLAN WAS PREPARED FOR DISCUSSION AND ESTIMATING PURPOSES. THE LAYOUT SHOWN IS INDICATIVE ONLY AND MAY BE SUBJECT TO LOCAL AUTHORITY / GOVERNMENT REQUIREMENTS AND FURTHER DETAILED ENGINEERING DESIGN.
THIS PLAN SHALL NOT BE USED FOR CONSTRUCTION PURPOSES AND IS NOT TO BE USED FOR ANY OTHER PURPOSE OR BY ANY OTHER PERSON OR CORPORATION OTHER THAN LISTED AS THE 'CLIENT' ON THE PLAN.
NAXOS ENGINEERS PTY LTD ACCEPTS NO RESPONSIBILITY FOR ANY LOSS OR DAMAGE SUFFERED PROVIDED TO ANY PERSON OR CORPORATION WHO MAY USE OR RELY ON THE PLAN CONTINUATION OF THE TERMS OF THE CLAUSE. ALL COPIES OF THIS PLAN MUST INCLUDE THIS DECLARATION.

NAXOS CADASTRAL AND SURVEY DATA DECLARATION

WHILE EVERY CARE IS TAKEN BY NAXOS ENGINEERS PTY LTD TO ENSURE THE ACCURACY OF THE DATA SUPPLIED BY LOCAL AUTHORITIES, OWNERS AND SURVEYORS, NAXOS ENGINEERS PTY LTD DOES NOT GUARANTEE THE ACCURACY, RELIABILITY, COMPLETENESS OR SUFFICIENCY FOR ANY PARTICULAR PURPOSE AND DOES NOT ACCEPT ANY LIABILITY IN RELATION TO ANY EXPENSES, LOSSES, DAMAGES INCLUDING INDIRECT OR CONSEQUENTIAL DAMAGES AND COSTS WHICH MAY BE INCURRED AS A RESULT OF DATA BEING INCOMPLETE OR INADEQUATE IN ANY WAY AND FOR ANY REASON.



Scale of Land:

Scale:

1:500

Orig. Dwg. Size A1

Client:

Project:

REDLAND INVESTMENT CORPORATION

WENAM CREEK PDA

Job No.

Drawing No.

C18-214

SK05

Revision:

A

PRELIMINARY CARPARK WATERMAIN LAYOUT PLAN