


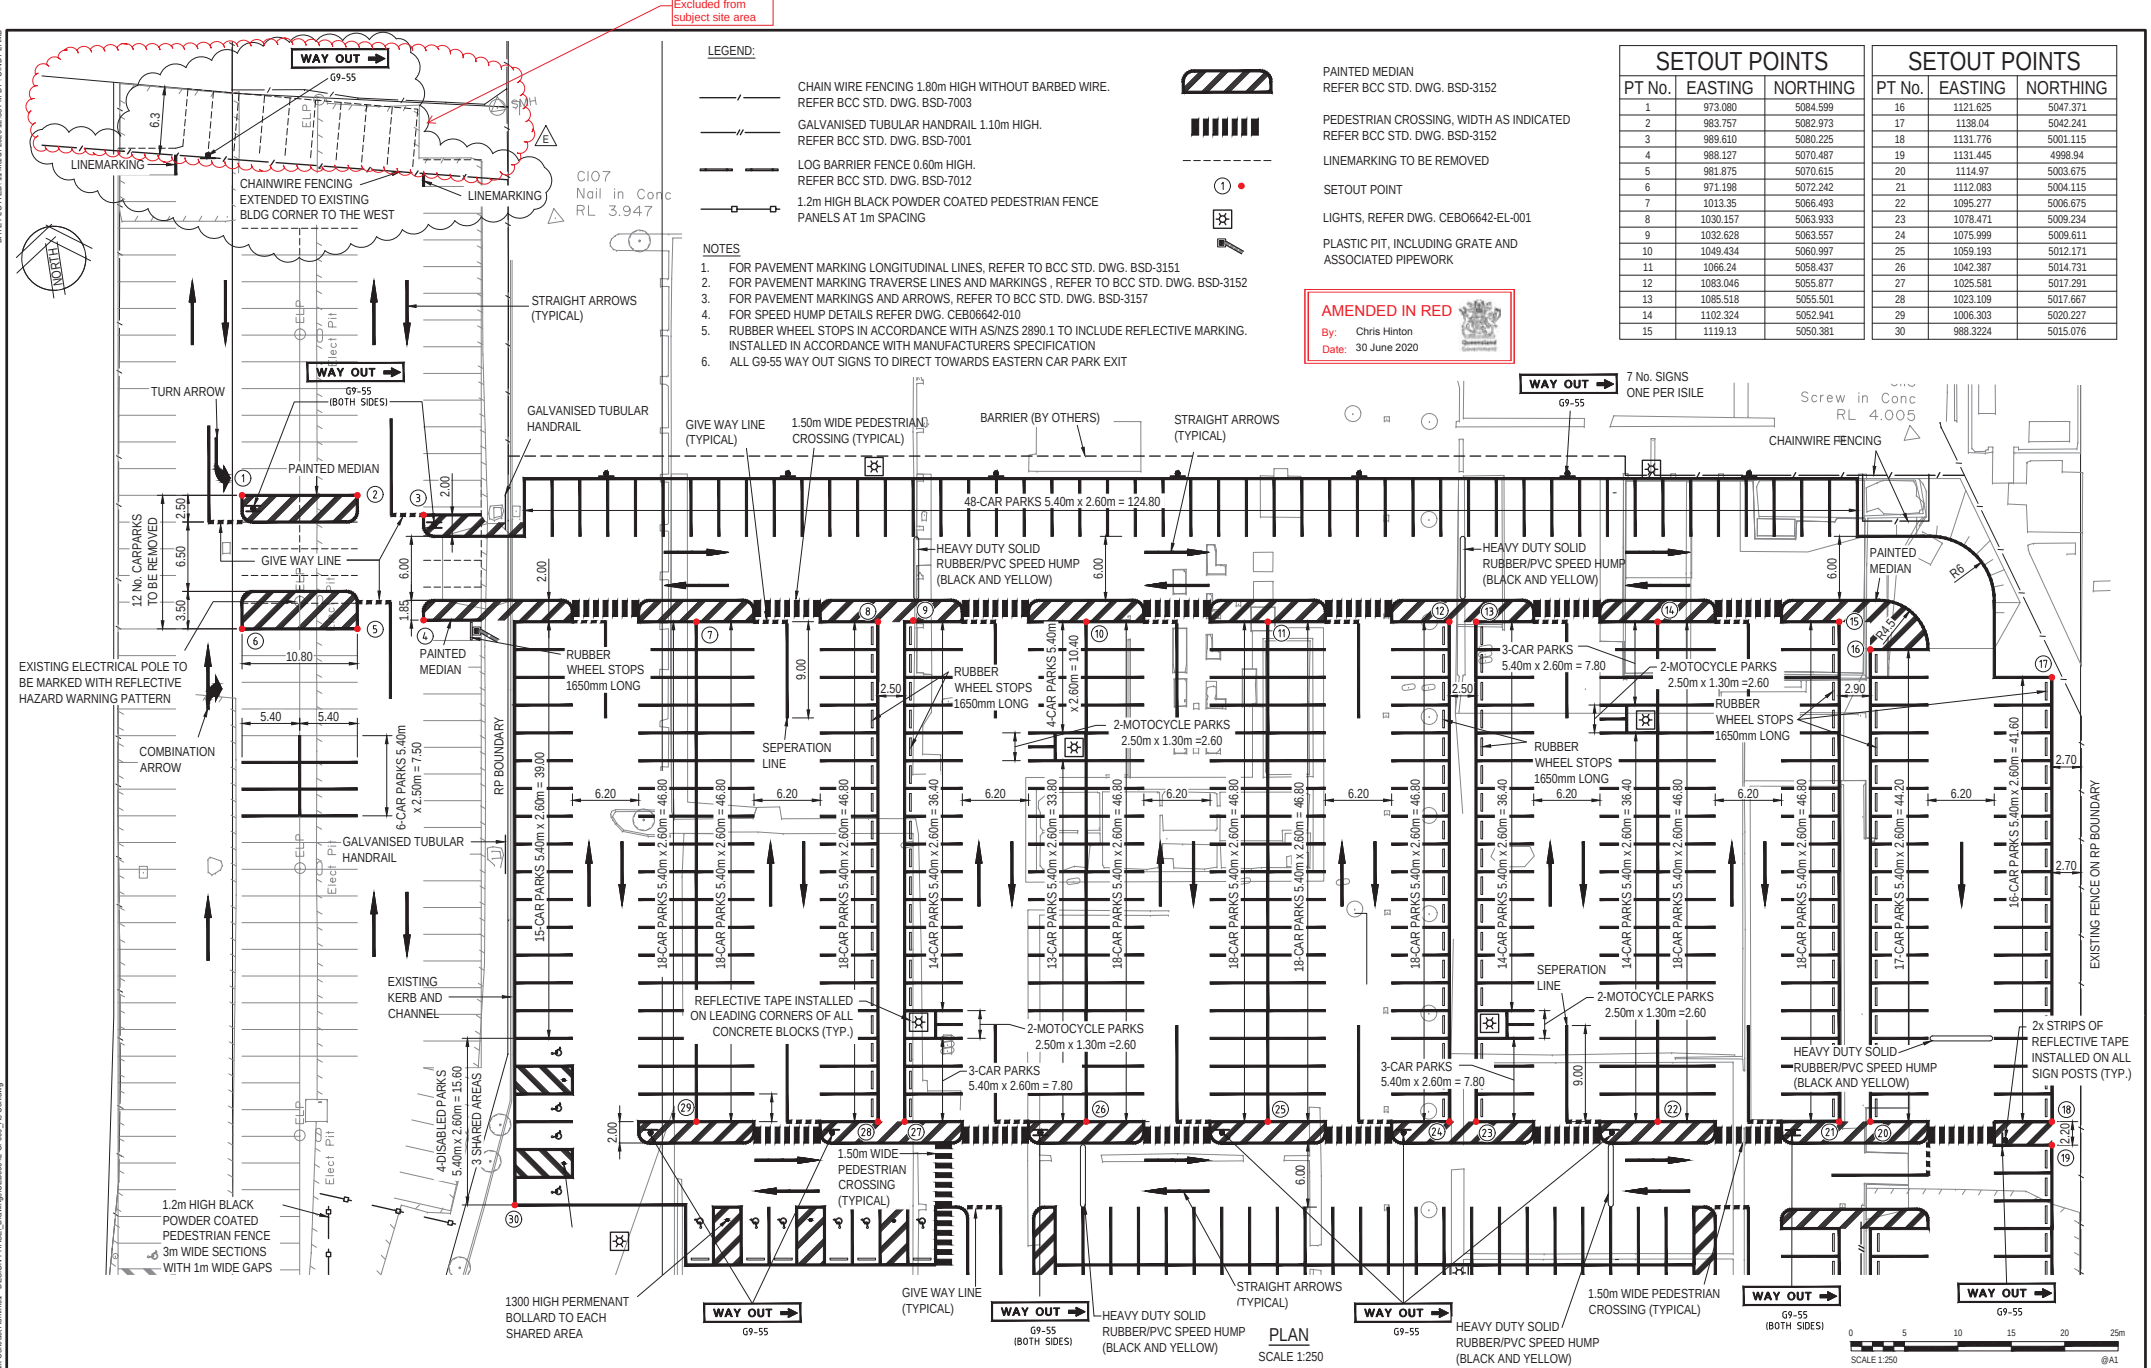

Rev	Date	Description	Des.	Verif.	Appd.
E	11/03/2020	PROPOSED FENCE ADDED	C.L.	A.M.C.	L.G.
D	12/02/2020	AS-CONSTRUCTED	C.L.	A.M.C.	L.G.
C	12/09/2019	MOTORCYCLE PARKING BAYS REMOVED	J.A.M.	A.M.C.	L.G.
B	2/09/2019	ISSUE FOR CONSTRUCTION	C.L.	A.M.C.	L.G.
A	16/07/2019	ISSUE FOR TENDER	D.G.	A.M.C.	
1	3/07/2019	PRELIMINARY ISSUE	D.G.	A.M.C.	

PLANS AND DOCUMENTS referred to in the PDA DEVELOPMENT APPROVAL
Approval no: DEV2019/1056
Date: 3 August 2020

© Cardno Limited All Rights Reserved.
This document is produced by Cardno Limited solely for the benefit of and use by the client in accordance with the terms of the retainer. Cardno Limited does not and shall not assume any responsibility or liability whatsoever to any third party arising out of any use or reliance by third party on the content of this document.

Cardno
Cardno (Qld) Pty Ltd | ABN 57 051 074 992
Level 11, 555 St Pauls Terrace
Fortitude Valley, QLD 4006
Tel: 07 3369 9822 Fax: 07 3369 9722
Web: www.cardno.com.au

Drawn	D.G.	Date	26/06/2019
Checked	A.M.C.	Date	26/06/2019
Design	D.G.	Date	26/06/2019
Verified	A. McCulloch	Date	26/06/2019
Approved		Date	12/02/2020
L. GARDISE	RPEC	22015	

ECONOMIC DEVELOPMENT QUEENSLAND
Project CAR PARK AT 92 MACARTHUR AVE, HAMILTON
EDQ CONTRACT NUMBER: DSDMIP-EDQ-1577-19
Title PROPOSED CARPARK LAYOUT
LINEMARKING - SHEET 1

Status	AS CONSTRUCTED
DATUM	AHD
Scale	AS SHOWN
Size	A1
Drawing Number	CEB06642-CI-009
Revision	E