

SERVICEABILITY REPORT

FOR THE PROPOSED RESIDENTIAL TOWER DEVELOPMENT

LOCATED AT
19 HERCULES STREET, HAMILTON, 4007

PREPARED FOR
PDS

**BORNHORST
+ WARD**

Bornhorst & Ward Pty Ltd

A.B.N. 78 010 151 354

A.C.N. 010 151 354

Level 14, 133 Mary Street

Brisbane Qld 4000

Phone: (07) 3013 4699

E-mail: mail@bornhorstward.com.au

Bornhorst and Ward Project No: **20376**

If you have any queries regarding this proposal, then please contact: **Marnie Stollznow**

Revision	Date	Description	Author	Rev.	App.
A	30/11/2020	Draft Issue to Client	MST	AL	
B	14/12/2020	Issue for Approval – Architectural Layout Updated	MST		NR

Nicholas Rozis: RPEQ 7729

COPYRIGHT: This document is and shall remain the property of Bornhorst & Ward Pty Ltd and shall not be copied in whole or part. Unauthorized use of this document in any form is prohibited.

File Name: J:\2020\20376\07_REPORTS\DESIGNREPORTS\REV_(B)\SERVICEABILITY\RPT_Serviceability(B).docx

CONTENTS

1.	INTRODUCTION.....	1
2.	SITE CHARACTERISTICS	1
2.1	LOCATION AND EXISTING FEATURES	1
2.2	PROPOSED DEVELOPMENT	2
2.3	TOPOGRAPHY AND CATCHMENT CHARACTERISTICS.....	2
2.4	EXISTING FLOODING CONDITIONS AND FREEBOARD REQUIREMENTS.....	3
3.	EXISTING AND PROPOSED CIVIL WORKS AND INFRASTRUCTURE.....	4
3.1	STORMWATER.....	4
3.1.1	Existing Infrastructure.....	4
3.1.2	Proposed Infrastructure	5
3.2	EARTHWORKS	5
3.3	ROADWORKS.....	5
3.4	SEWER	6
3.4.1	Existing Infrastructure.....	6
3.4.2	Proposed Infrastructure	6
3.4.3	Service Advice Notice.....	6
3.5	WATER.....	6
3.5.1	Existing Infrastructure.....	6
3.5.2	Proposed Infrastructure	6
3.5.3	Service Advice Notice.....	7
3.6	ELECTRICITY	7
3.7	COMMUNICATIONS.....	7
3.8	GAS	7
4.	SUMMARY.....	8

LIST OF FIGURES

Figure 1:	Locality Plan.....	2
Figure 2:	Brisbane City Council Interactive Flood Map	3

LIST OF TABLES

Table 1:	Flood Freeboard Requirements – Flood Overlay Code.....	3
Table 2:	Flood Freeboard Requirements - Coastal Overlay Code	4

APPENDICES

Appendix A	Development Drawings
Appendix B	Engineering Drawings
Appendix C	Existing Site Characteristics & Services Information
Appendix D	BCC Potential & Actual Acid Sulphate Overlay Map

1. INTRODUCTION

Bornhorst and Ward has been commissioned to investigate and report on the serviceability requirements pertaining to the proposed Material Change of Use at 19 Hercules Street, Hamilton (Lot 3 on SP172658). The proposal consists of constructing 3 Residential Towers with associated retail podium and outdoor plaza. Plans of the proposed development layout can be seen in Appendix A.

This document reports on the existing and proposed civil works and stormwater infrastructure required as part of the proposed development. The engineering requirements for this proposal shall be in accordance with Engineering Best Management Practices, Brisbane City Council City Plan (2014), the State Planning Policy (2017) and the Economic Development Queensland (EDQ) Priority Development Area (PDA) requirements.

This report outlines the preliminary design methodology in support of a Development Application and should be read in conjunction with other documents issued by the consultant team.

2. SITE CHARACTERISTICS

2.1 LOCATION AND EXISTING FEATURES

The development site, located at 19 Hercules Street, Hamilton has the following existing characteristics:

- The site is bound by Hercules Street to the north, existing commercial and residential lots to the east and west and a private roadway adjacent to the southern boundary of the lot. Kingsford Smith Drive is also approximately 115m from the north-western property boundary;
- The existing development site comprises of a sales office and associated car parking facilities along the Hercules Street frontage, while the remaining site area is unoccupied and contains hardstand with some vegetation;
- The total site area is 7,637m²;
- The existing site entrance is via a crossover from Hercules Street;
- The closest waterway is the Brisbane River which is approximately 120m from the southern property boundary;
- There is a 130m² Energex Easement within the north-eastern corner of the site;

Refer to Figure 1 for Locality details.



Figure 1: Locality Plan

2.2 PROPOSED DEVELOPMENT

The following points outline information regarding the proposed development:

- Material Change of Use for a 3-Stage Residential Tower and Retail development;
- Each Tower will be surrounded by a podium of retail outlets and an outdoor central plaza area will connect each Tower;
- Two accesses will be provided from both Hercules Street and Main Road (the private roadway along the southern boundary). Both will provide access down to the below basement car parking. The existing crossovers will be made redundant;
- Pedestrian link will also be established between Main Road and Hercules Street, via the central outdoor plaza.

Refer to the development drawings in Appendix A for further details of the proposed development.

2.3 TOPOGRAPHY AND CATCHMENT CHARACTERISTICS

The existing topography and catchment characteristics are as follows:

- The high point of the existing site is RL 3.9m AHD which is located along the western property boundary;
- The site is considerably flat, with a low point of approximately 1.8m AHD along the eastern property boundary;
- During major storm events, runoff ponds within the development and eventually discharges as overland flow to Hercules Street where it is collected by stormwater infrastructure;
- Roof water from the sales office is collected by internal pipes and discharges to Hercules Street via kerb adaptors;
- The site is not impacted by any external catchments as it is bound by both road corridors and others buildings which act to divert any potential upstream runoff.

See the survey plan in Appendix C for more information.

2.4 EXISTING FLOODING CONDITIONS AND FREEBOARD REQUIREMENTS

A BCC Floodwise Report has been obtained for the site and states the following:

- The development site is within Flood Planning Area 5 (FPA5) for impacts associated with Brisbane River Flooding;
- FPA5 is described as an area that has no recent history of flooding but rather has the potential to flood;
- The development site is impacted by an overland flow path; and
- The development site falls within a medium storm tide inundation area.

Please refer to the Brisbane City Council's Floodwise Property Report in Appendix C and Figure 2 below for more details.

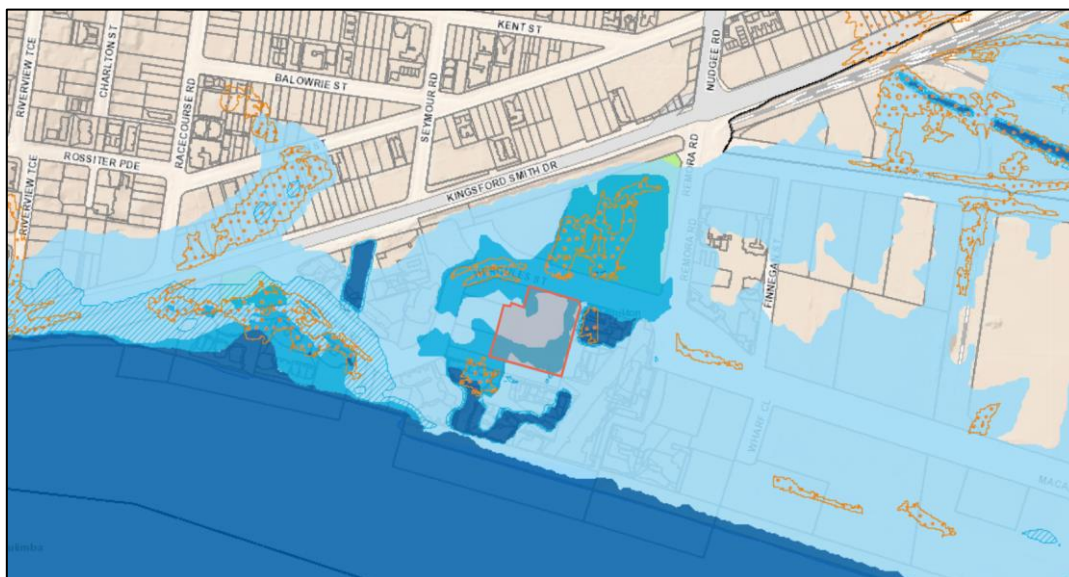


Figure 2: Brisbane City Council Interactive Flood Map

Design levels for the building must comply with the flood immunity standards specified by Brisbane City Council's City Plan 2014. The development will be assessed against the flood levels determined from this investigation. In accordance with the Brisbane City Council City Plan 2014, the minimum flood freeboard requirements must therefore consider impacts associated with both the BCC Flood Overlay Code and BCC Coastal Hazard Overlay Code, as specified in the BCC Floodwise Report. Tables 1 and 2 detail the outcomes of both of these investigations:

Table 1: Flood Freeboard Requirements – Flood Overlay Code

Development Area	Category	Brisbane River	Level (m AHD)	Overland Flow	Level (m AHD)
Building Floor Level (Class 6)	C	DFL	2.5	2% AEP FL	2.2
Basement entry (Class 3)	C + 0.3m	DFL	2.5 + 0.3 = 2.8	2% AEP FL	2.2 + 0.3 = 2.5
Essential services (Class 6)	A	RFL + 0.5m	2.5 + 0.5 = 3	2% AEP FL + 0.5m	2.2 + 0.5 = 2.7

Table 8.2.11.3.D and Table 8.2.11.3.L of the Brisbane City Council's Flood Overlay Code were used to determine recommended development levels. The flood immunity levels have been based on a BCA building classification of 6 for the retail ground floor level and then building classification 3 for the basement residential parking facilities in accordance with Table 8.2.11.3D of the BCC Flood Overlay Code.

Table 2: Flood Freeboard Requirements - Coastal Overlay Code

Development Area	Category	Medium Storm Tide (m AHD)	Level (m AHD)
Building Floor Level (Class 6)	C	3.1	3.1
Basement entry (Class 3)	C + 300mm	3.1 + 0.3	3.4
Essential services (Class 6)	A	3.1 + 0.5	3.6

Table 8.2.6.3C and Table 8.2.6.3D of the Brisbane City Council's Coastal Hazard Overlay Code were used to determine recommended development levels. The flood immunity levels have been based on a medium storm tide as specified in the BCC Floodwise Property Report.

Table 1 and 2 above states the relevant flood immunity levels for the site. As the development site is impacted by both flooding and coastal inundation, the worst-case will be designated as the minimum development level. In this case, the storm tide produces the highest relative levels, so 3.1m AHD will be set as the minimum building floor level, and 3.4m AHD will be set at the minimum basement entry level.

Currently, the building floor level and the basement entry is set at the minimum required flood level, so immunity has been achieved.

3. EXISTING AND PROPOSED CIVIL WORKS AND INFRASTRUCTURE

3.1 STORMWATER

3.1.1 Existing Infrastructure

A Dial Before You Dig investigation was conducted for the site and 'As Constructed' plans from the Remora Road upgrade were sourced. The following stormwater infrastructure has been noted:

- The site has a stormwater property connection of a 525mm dia. class 3 pipe that connects to the northern site boundary off Hercules Street;
- This pipeline is then connected to a 1,500mm dia. BCC manhole located on the northern side of Hercules Street;
- Along the frontage of the site, 2 BCC Type A gully pits are also connected to this manhole;
- This infrastructure was constructed as part of the Remora Road upgrades and is connected to further stormwater infrastructure to the east within the intersection of Hercules Street, Remora Road and MacArthur Avenue. Here stormwater is conveyed south to outlet at the Brisbane River;
- Stormwater infrastructure as part of the Remora Road upgrade were designed to convey Q100 runoff from the surrounding developed lots.

Council Asset Plans of the existing stormwater infrastructure and 'As Constructed' plans can be found in Appendix C of this report.

3.1.2 Proposed Infrastructure

The following points outline the proposed stormwater infrastructure for the development site:

- All stormwater drainage within the development will be captured within internal hydraulics and directed towards the Hercules Street existing 525mm dia. stormwater pipe;
- Major flows that bypass the internal hydraulics will be directed towards Hercules Street through the use of an overland flow path within the central plaza;
- As there will be a negligible increase in the impervious area of the site and as the downstream stormwater infrastructure was designed to convey Q100 flows from the developed site, no stormwater detention is proposed for this development;
- Considering that the works area is greater than 2,500m², stormwater quality treatment measures will be required for the site to comply with State Planning Policy and BCC City Plan requirements;
- Stormwater quality treatment will take the form of proprietary cartridge/filtration devices, these devices will be designed such to treat the entire development site.

Refer to Bornhorst and Ward's Stormwater Management Plan for further details. Refer to the engineering drawings in Appendix B for further information.

3.2 EARTHWORKS

Earthworks will be required to construct building pads and 5 levels of basement car parking. A detailed earthworks plan will be prepared as a part of the detailed design operational works lodgement. A Preliminary Earthworks Plan has been provided in Appendix B and were based on the levels provided from the Architectural drawings seen in Appendix A.

The site has been identified on Brisbane City Council Potential and Actual Acid Sulphate Soils Overlay Map. As the proposed development is to undertake excavation below RL 20.0m AHD, it is anticipated that Acid Sulphate Soils may be encountered. Therefore, it is recommended that an Acid Sulphate Soil investigation be completed as part of the detailed geotechnical investigation conducted for the site. If Acid Sulphate Soils are present, then an Acid Sulphate Soil Management Plan will be required. Refer to Appendix D for the BCC Potential and Actual Acid Sulphate Overlay Map result.

All earthworks will be undertaken in accordance with the Brisbane City Council guidelines.

3.3 ROADWORKS

No major external roadworks are required for this development as the Hercules Street corridor and frontage to the site were upgraded as part of the Remora Road upgrade. The following roadworks are required to provide access to the development site:

- Existing crossovers along Hercules Street will be made redundant, kerb and channel, bicycle and pedestrian paths will be reinstated in these locations as per BCC Roadway corridor standards;
- New access driveway to the basement levels will be constructed on both Hercules Street and Main Road;
- Pedestrian links will connect Hercules Street and Main Road via the outdoor central plaza. Pedestrian facilities will be constructed as per BCC Pedestrian and Access requirements.

Refer to the engineering drawings in Appendix B for further information.

3.4 SEWER

3.4.1 Existing Infrastructure

The 'As Constructed' plans from the Remora Road upgrade indicates the following existing sewer infrastructure;

- A 225mm dia. DICL PN35 property connection is located towards the north-eastern corner of the site, at an invert level of 2.112m AHD;
- This pipeline is connected to a QUU manhole which then feeds into further QUU sewer infrastructure to the east of the development.

'As Constructed' plans of the existing sewer infrastructure can be found in Appendix C of this report.

3.4.2 Proposed Infrastructure

As per QUU advice received back in 2014, the site was originally allocated a Peak Wet Weather Flow of 20L/sec. A Peak Wet Weather Flow from the development site of 8.78L/sec was calculated using known master planned GFA and unit numbers. As this runoff is less than allocated within the masterplan, it is assumed that downstream infrastructure is able to cater for the proposed development. Internal plumbing will connect into the existing sewer connection and a stub for future lot connections will need to be provided between stages. All of the internal sewer infrastructure will be documented by a hydraulic consultant.

Refer to Appendix B for preliminary drawings of the proposed sewer works.

3.4.3 Service Advice Notice

A Service Advice Notice application has been lodged with QUU to determine if there are further requirements necessary to ensure that the site can be adequately serviced by QUU sewer infrastructure. Works required to service the site will be undertaken in accordance with QUU requirements and procedures.

3.5 WATER

3.5.1 Existing Infrastructure

The 'As Constructed' plans from the Remora Road upgrade indicates the following existing sewer infrastructure;

- There is an existing QUU 250mm dia. PE pipeline within the southern verge of Hercules Street, parallel to the frontage of the development site;
- 3, 150mm dia. DICL property connections exist along the northern boundary.

'As Constructed' plans of the existing sewer infrastructure can be found in Appendix C of this report.

3.5.2 Proposed Infrastructure

It is expected that the existing water connections will continue servicing the proposed lots. A QUU standard Water Meter will be constructed and placed along Hercules Street to allow both domestic and fire connections to service each lot. All of the internal water infrastructure will be documented by a hydraulic consultant.

Refer to Appendix B for preliminary drawings of the proposed water works.

3.5.3 Service Advice Notice

A Service Advice Notice application has been lodged with QUU to determine if there are further requirements necessary to ensure that the site can be adequately serviced by QUU water infrastructure. Works required to service the site will be undertaken in accordance with QUU requirements and procedures.

3.6 ELECTRICITY

The Energex Asset Plans from a Dial Before You Dig investigation indicates that underground electrical infrastructure is located on both sides of Hercules Street and services street lighting. The Energex Asset Plan of the existing electrical infrastructure can be found in Appendix C of this report.

Electrical services required for the proposed development including assessment of the existing infrastructure capacity will be designed and determined by an electrical engineer and will be assessed by Energex during the detailed design phase of the development.

3.7 COMMUNICATIONS

The Telstra, Optus, NBN, TPG and OptiComm Asset Plans from a Dial Before You Dig investigation indicate the following:

- Telstra infrastructure exists at the frontage of the site, within the southern verge of Hercules Street;
- Optus infrastructure exists to the west of the site, there is no direct Optus connection for the development site;
- NBN infrastructure exists both to the north of the development, within the southern verge of Hercules Street and it also runs through the development along the eastern property boundary;
- TPG infrastructure exists within the southern verge of Hercules Street, fronting the development site; and
- OptiComm infrastructure also exists within the northern and southern verge of Hercules Street, adjacent to the development site.

Telstra, Optus, NBN, TPG and OptiComm Asset Plans of the existing communications infrastructure can be found in Appendix C of this report.

All works required to provide communication services to the proposed development will be undertaken with the relevant service providers approval and coordination.

3.8 GAS

The APA Asset Plans from a Dial Before You Dig investigation indicate that there is a Medium Pressure PE gas pipeline within the southern verge of Hercules Street, fronting the development site. On the "As Constructed" plans for the Remora Road upgrade, a note signified that this gas pipeline would be removed.

All works required to provide gas services to the proposed development will be undertaken by the appropriate consultant with APA Group's approval and coordination. APA should be contacted to confirm the presence of this existing pipeline and whether or not it was removed during the Remora Road development.

APA Asset Plans of the existing gas infrastructure can be found in Appendix C of this report.


4. SUMMARY

This reporting relating to the proposed Material Change of Use located at 19 Hercules Street, Hamilton has shown the following:

- The proposed site has flags for Brisbane River, overland flow path and medium storm tide flooding. As a result, the site is expected to be at a relatively high risk for flood inundation so development levels have been set that consider freeboard requirements as specified by Brisbane City Council;
- Internal stormwater infrastructure is proposed to collect and convey all storm events to the existing stormwater pipe connection from Hercules Street;
- No stormwater detention measures are proposed as the downstream stormwater infrastructure was designed to convey the Q100 runoff from the surrounding lots in their developed condition;
- To comply with State Planning Policy requirements, stormwater quality treatment will take the form of proprietary filter/cartridge devices that treat the entire development site in the one location;
- Earthworks will be required to construct the proposed 5 levels of basement car parking as well as provide level building pads and ensure that the developments can be serviced;
- No major roadworks are required for this development as the Hercules Street frontage was recently upgraded. The existing crossovers from Hercules Street will be made redundant and a new access driveway will replace them in order to provide access to the lower basement levels. Another access driveway is proposed from Main Road;
- Existing water and sewer connections will continue to service the future lots. QUU must confirm the adequacy of these connection. Internal plumbing will connect each lot into the existing property connections;
- There is existing electrical, gas and telecommunications surrounding the site which may be used to service the development.

APPENDIX A
DEVELOPMENT DRAWINGS

HERCULES STREET

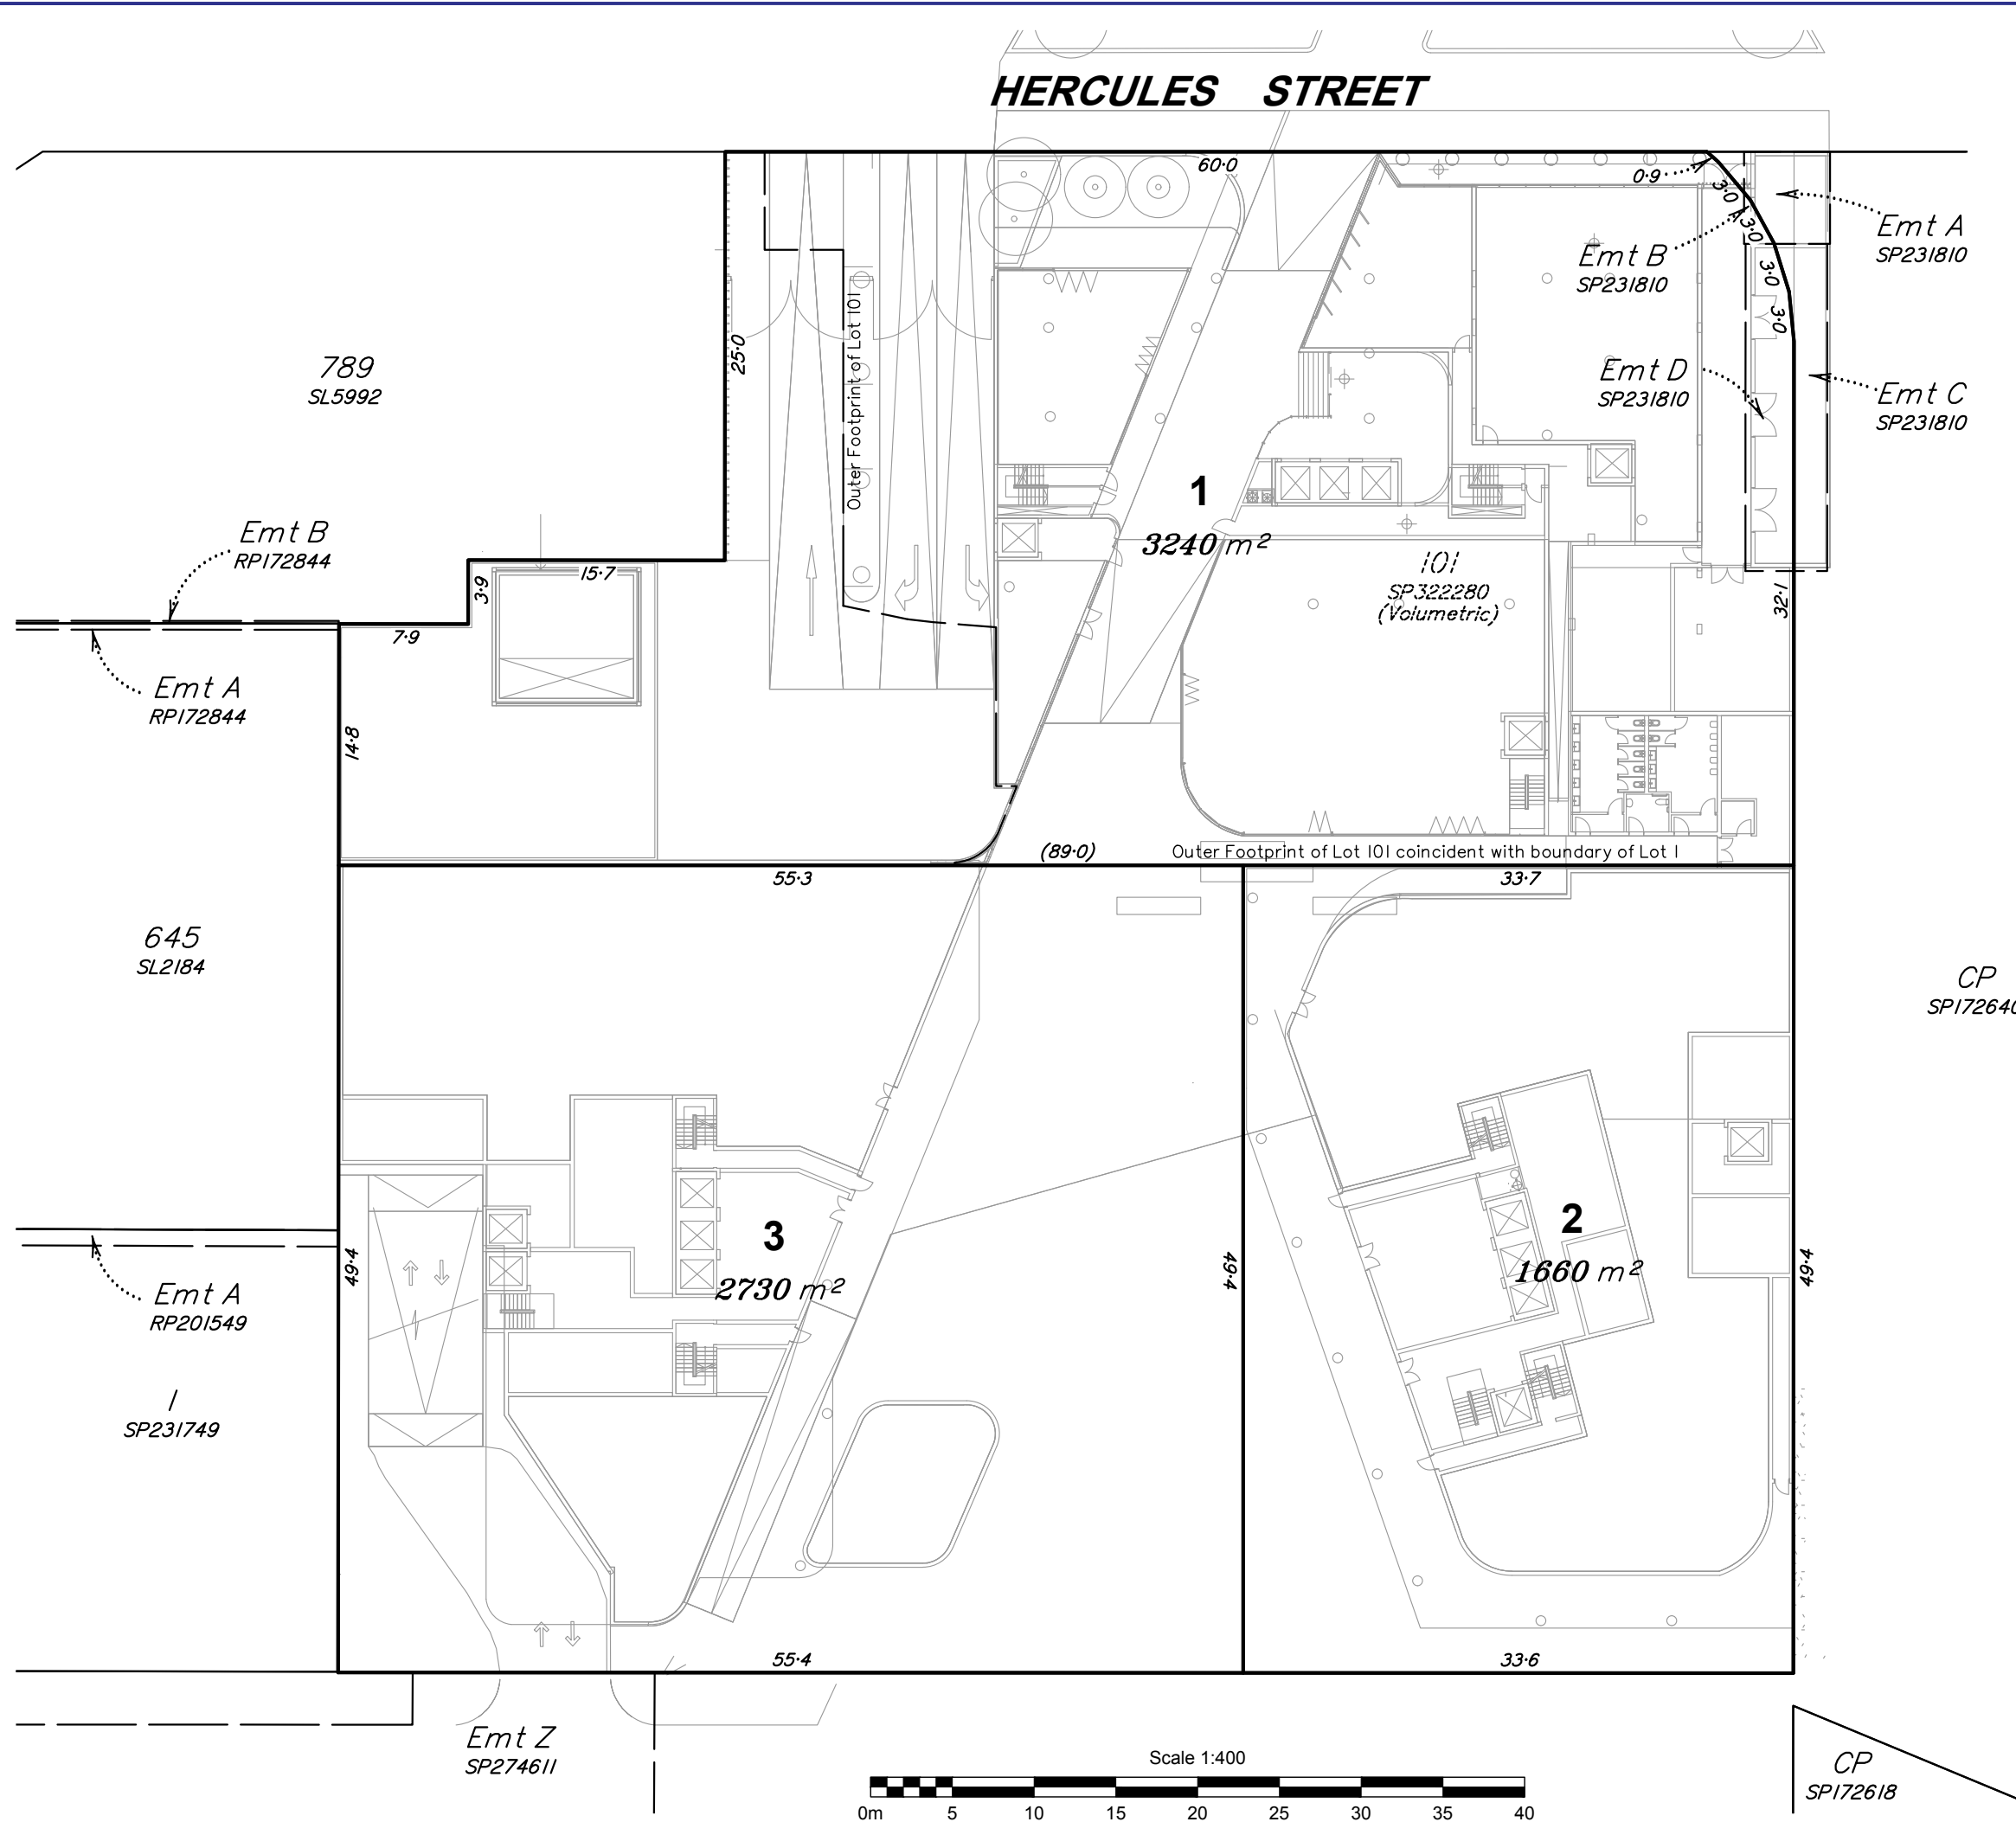

Note: Volumetric Format Lot 101 is fully contained within Standard Format Lot 1

DRAFT

- NOTES:
1. Drawn to scale on an A3 sheet.
 2. All dimensions and areas are subject to final survey and approval by E.D.Q.
 3. Architectural Information shown for Ground Level only. This information has been provided by Fuse & is proposed only.


A	Original Issue	DJL	11/11/2020
Issue	Revision	Int	Date

Title:
Plan of Proposed Standard Format Subdivision of Lots 1-3
 Cancelling Lot 900 on SP322280
(SP322281)


Client: **PDS**

Locality:	HAMILTON	Prepared By:	DJL
Local Gov:	BCC	Approved:	BWM
Surveyed By:		Date Created:	11/11/2020
Date Created:	11/11/2020	Scale:	1:400
Comp File:	10391.PROJECT		
Plan No:	10391_004_PRO		

CP
 SPI72618

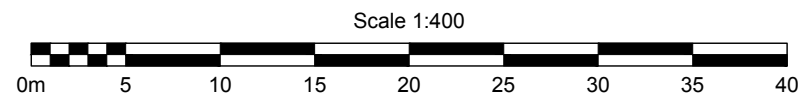

APPENDIX B
ENGINEERING DRAWINGS

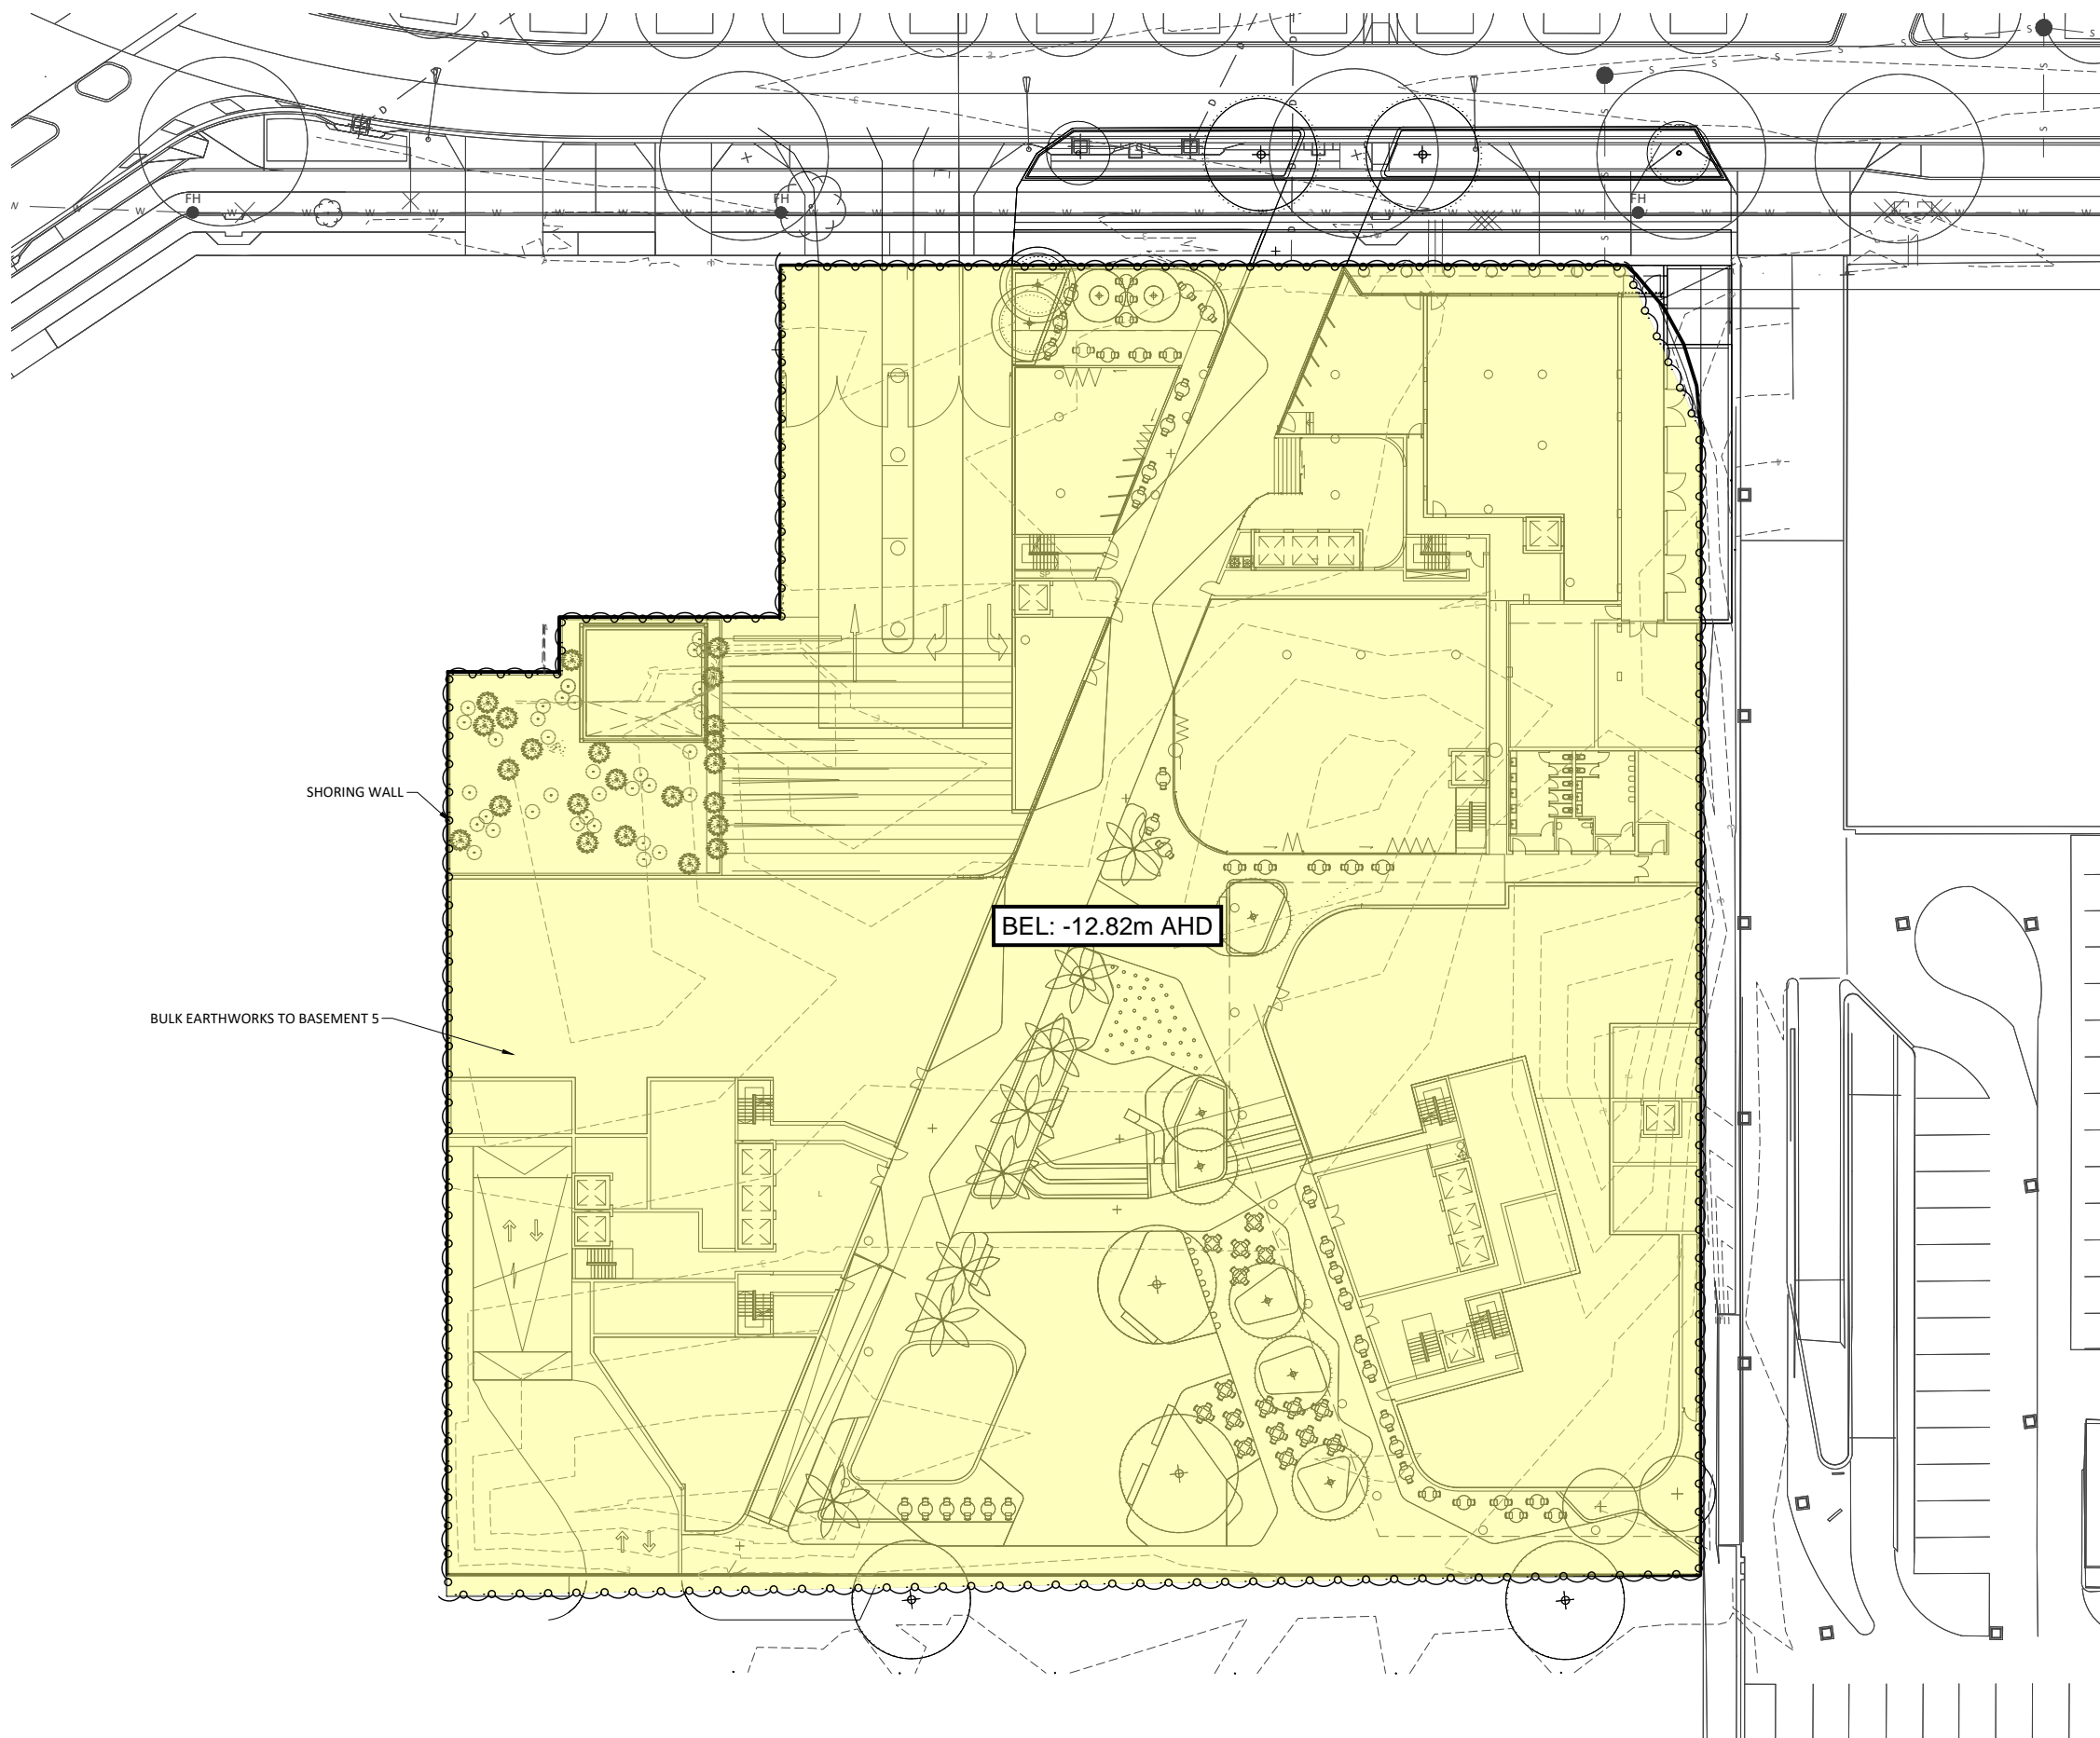

EARTHWORKS

EXISTING	PROPOSED	
	12.82 —	BULK EARTHWORKS LEVEL
		CUT
		FILL

ESTIMATED BULK EARTHWORKS VOLUME

CUT	98,627m ³
-----	----------------------

SHORING WALL

BULK EARTHWORKS TO BASEMENT 5

BEL: -12.82m AHD


THIS DRAWING IS BEST VIEWED IN COLOUR AND ON AN ELECTRONIC DEVICE

PROJECT NORTH



DIMENSIONS IN METRES EXCEPT WHERE SHOWN OTHERWISE. CULVERT AND PIPE SIZES IN MILLIMETRES

SCALES UNREDUCED / REDUCED

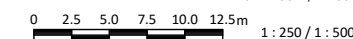

STATUS

PRELIMINARY

PLAN
SCALE 250

SCAN QR CODE TO CONFIRM CURRENT DRAWING REVISION
<http://docs.bornhorstward.com.au/revision/>



REV	DATE	DESCRIPTION	DWN	DES	CHK	APP
A	19.11.20	PRELIMINARY EARTHWORKS	TK	MST	AL	

ASSOCIATED CONSULTANTS	APPROVED	CHECKED
 7729 RPEQ	
	DATE	DATE

BORNHORST + WARD
+61 (7) 3013 4699 www.bornhorstward.com.au


CLIENT
WENTWORTH ENQUIRIES No.2

PROJECT
HERCULES ST HAMILTON

SUBJECT
EARTHWORKS LAYOUT

PROJECT No.
20376

DRAWING No. REVISION
DA-C010 A

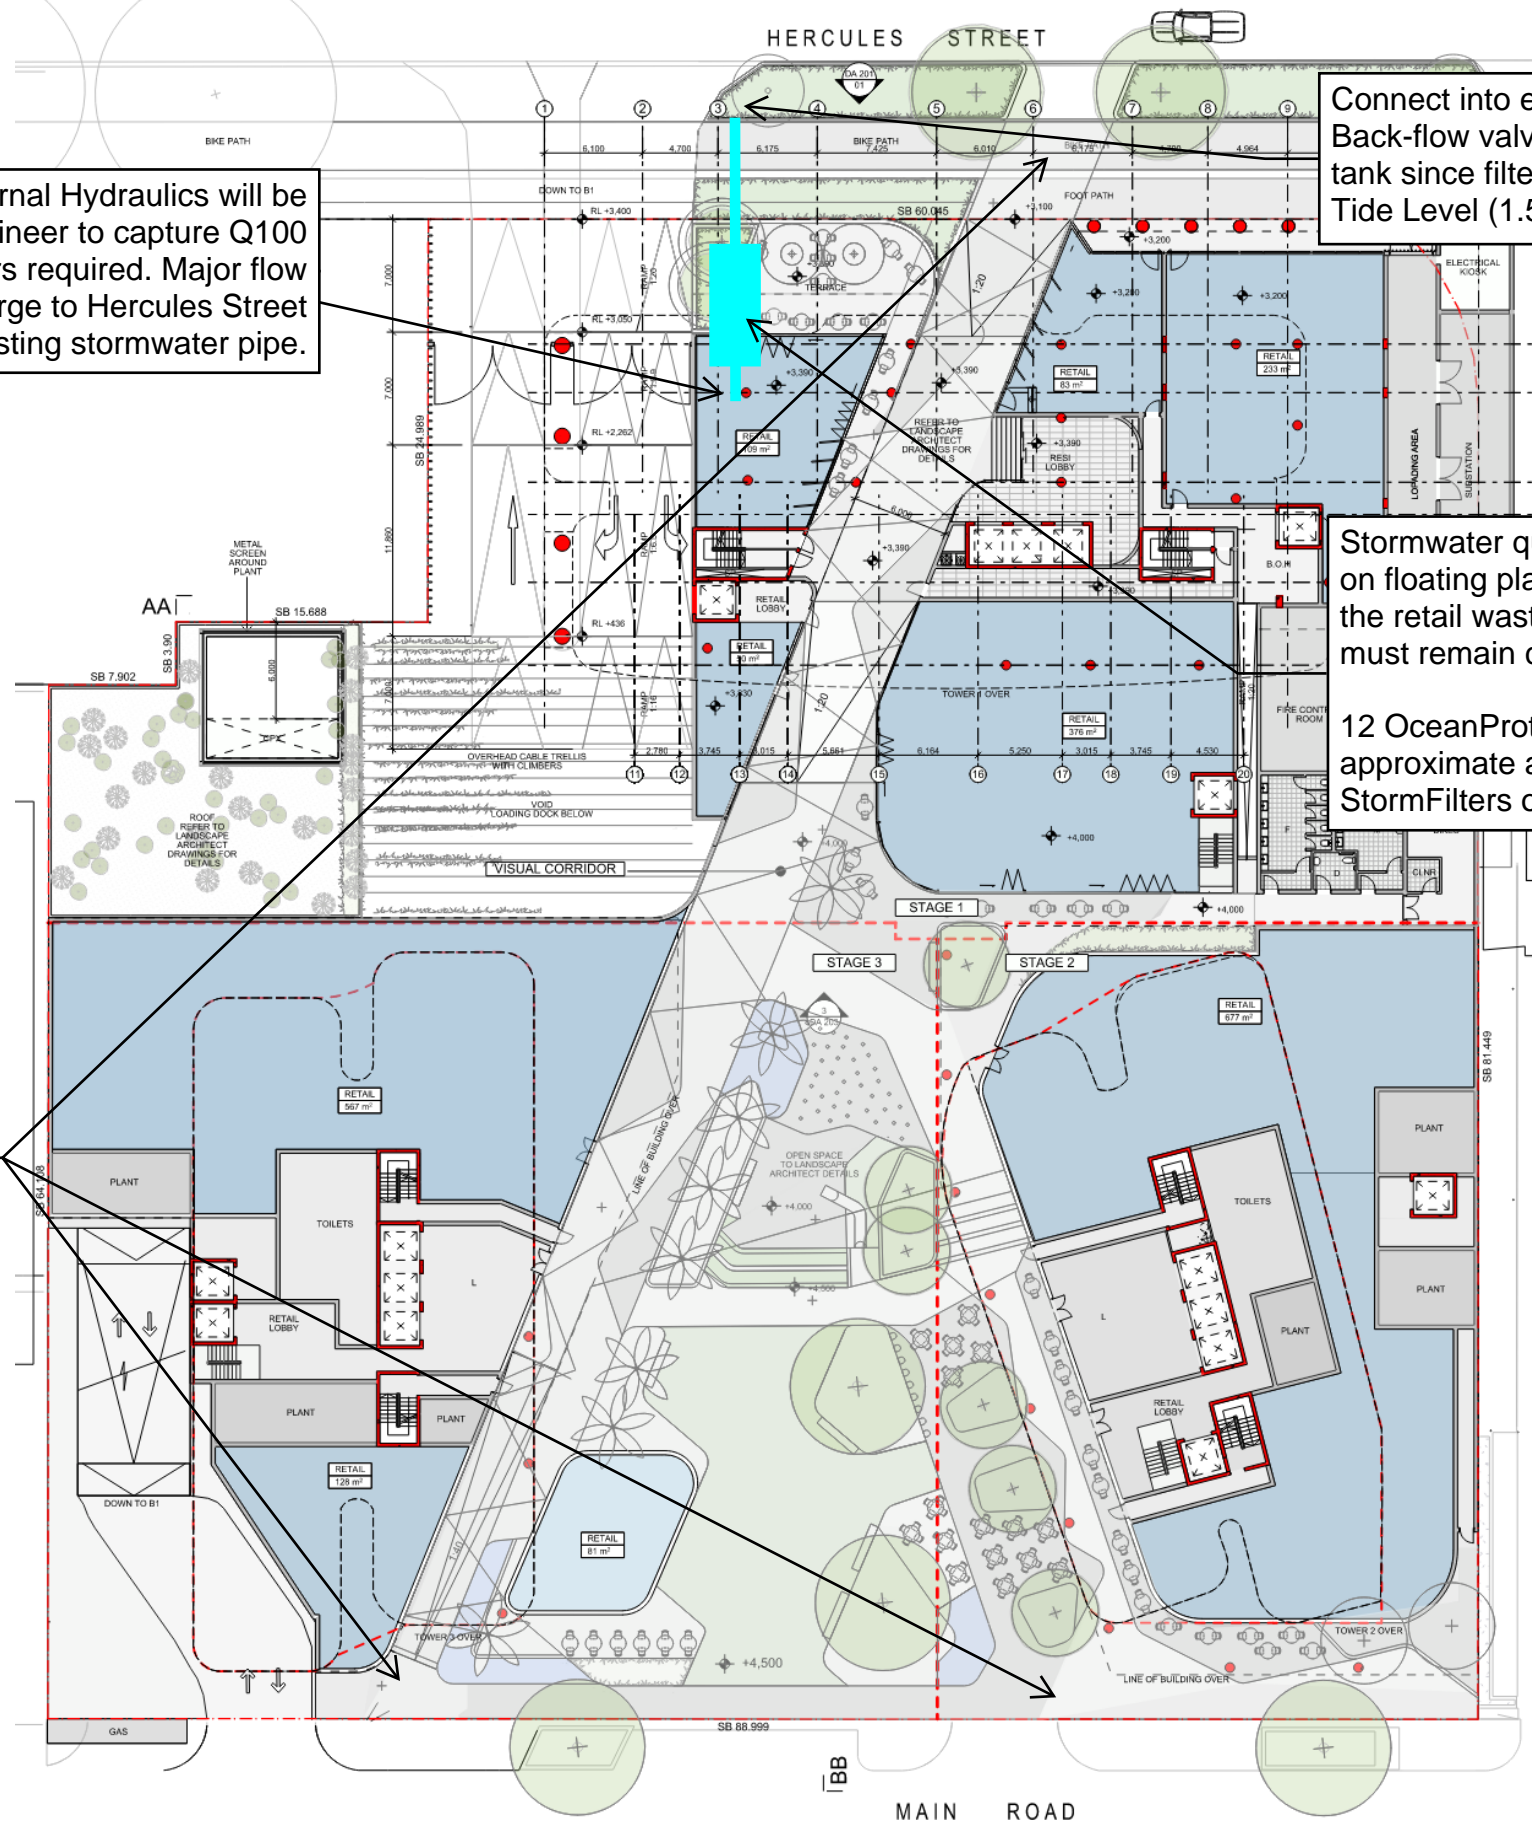

Connection for hydraulics. Internal Hydraulics will be documented by a Hydraulic Engineer to capture Q100 runoff. Low flow diversion to filters required. Major flow to bypass stormfilters and discharge to Hercules Street existing stormwater pipe.

Connect into existing 525mm dia. stormwater pipeline. Back-flow valve to be fitted onto outlet from treatment tank since filters will be below the Highest Astronomical Tide Level (1.55m AHD)

Stormwater quality filters to be located within Basement 1 on floating platform/podium, approximately located within the retail waste collection area. Access via surface which must remain clear of obstructions/planting.

12 OceanProtect StormFilters and 2 OceanGuards, approximate area of system = 4.5m² (OceanGuards + StormFilters only)

Proposed Pedestrian link between Main Road and Hercules Street.

**BORNHORST
+WARD**

+61 (7) 3013 4699 www.bornhorstward.com.au

PROJECT

SUBJECT

PROJECT No.

DRAWING No. REVISION

0 10 20 30 40 50


ORIGINAL SIZE A3

Existing QUU 150mm dia. DICL Fire, Sprinkler and Domestic Connection as per Bornhorst and Ward's As Constructed Plans: P3-S1-C0711(02)

HERCULES STREET

Existing QUU 225mm dia. DICL Property Connection as per Bornhorst and Ward's As Constructed Plan: P3-S1-C061(02)

QUU Standard Water Meter QUU-WAT-006, fire and domestic connection for each lot to be installed within basement 1. Location to be determined at design and development stage

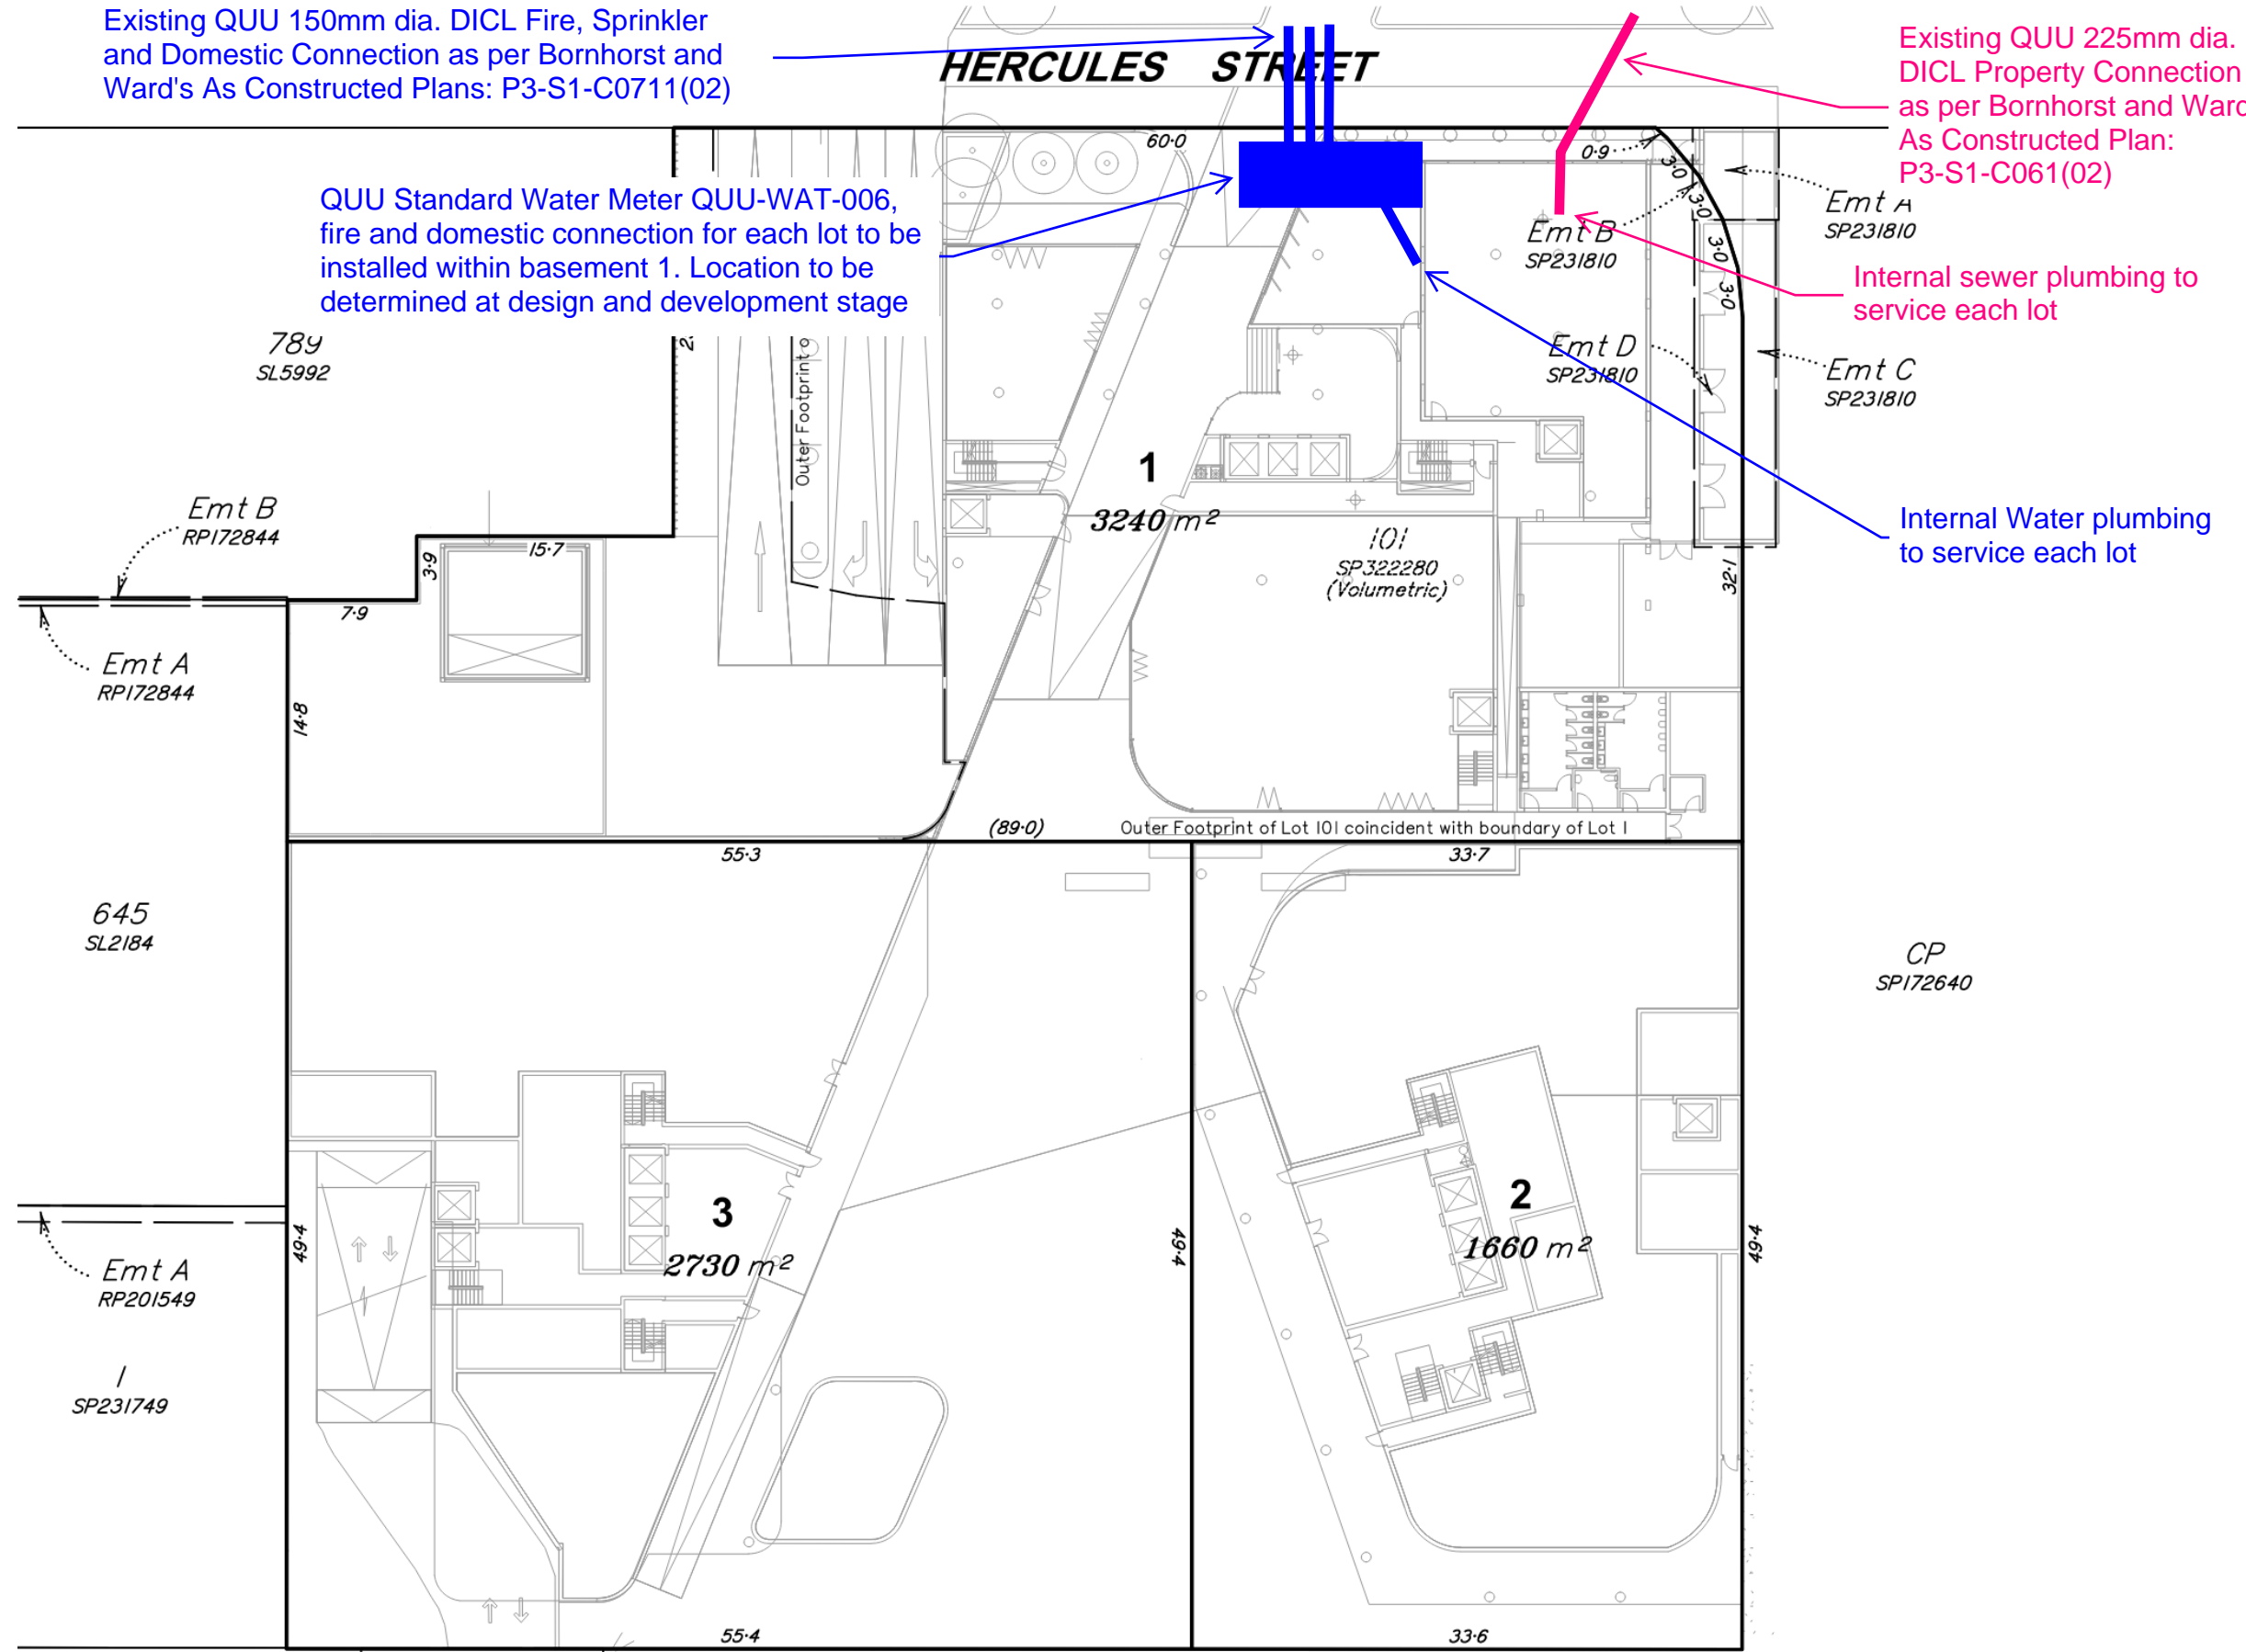

Internal sewer plumbing to service each lot

Internal Water plumbing to service each lot

**BORNHORST
+WARD**

+61 (7) 3013 4699 www.bornhorstward.com.au

PROJECT

SUBJECT

PROJECT No.

DRAWING No. REVISION

0 10 20 30 40 50

ORIGINAL SIZE A3

APPENDIX C

**EXISTING SITE CHARACTERITICS &
SERVICES INFORMATION**



Brisbane City Council FloodWise Property Report

Report Reference

1605493249099

16/11/2020 12:20:49

Dedicated to a better Brisbane

THIS REPORT IS FOR BUILDING AND DEVELOPMENT PURPOSES ONLY

The FloodWise Property Report provides property or lot-based flood information for building and development requirements. This report provides information on estimated flood levels, habitable floor level requirements and more technical information on the four sources of flooding: river, creek / waterway, storm tide and overland flow. Refer to the Useful Definitions section for a glossary of terms.


To find out more about how the contents of this report may affect building or development on this property, please visit www.brisbane.qld.gov.au/planning-building. For more general information about understanding your flood risk and how to prepare your property, family or business for potential flooding visit www.brisbane.qld.gov.au/beprepared

THIS IS A REPORT FOR:


Rateable Address: 19 HERCULES ST, HAMILTON QLD 4007

Lot Details: L.3 SP.172658

FLOOD LEVEL INFORMATION

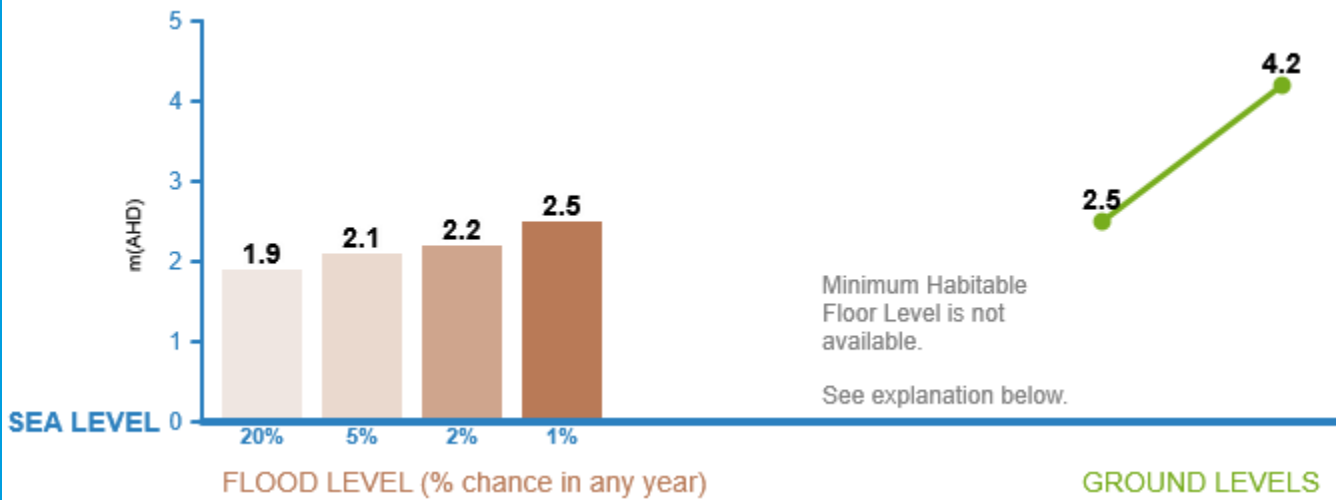

EXPLANATION

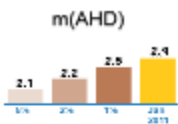

m(AHD) - Metres Australia Height Datum. The level of 0.0m AHD is approximately mean sea level.

Flood Levels - The Flood level bar chart above shows the possible flooding level and percentage chance of that level being reached or exceeded in any year. If an orange bar shows, it is the calculated January 2011 flood level at this address or lot. Refer to 'Useful Definitions' for further information.

Minimum Habitable Floor Level - Applies to residential development only. Please refer to Council's planning scheme to learn how this may affect you. If a property is in an overland flow path, or a large allotment, a minimum habitable floor level cannot be provided. Refer flood and planning development flags below.

Ground Levels - The green line above shows this property's approximate lowest and highest ground levels based on latest available information (2019 airborne laser survey) to Council. If you are building, please confirm with a surveyor.

For further information and definitions please refer to the Useful Definitions page

FLOOD AND PLANNING DEVELOPMENT FLAGS

DEVELOPMENT
FLAG(S)

This property may also be affected by one or more flood or property development overlays or flags. These include: OVERLAND FLOW PATH, LARGE ALLOTMENT

Please review the technical summary over page and refer to Council's planning scheme for further information.



Dedicated to a better Brisbane

TECHNICAL SUMMARY

This section of the FloodWise Property Report contains more detailed flood information for this property so surveyors, builders, certifiers, architects and engineers can plan and build in accordance with Council's planning scheme. For more information about building and development in Brisbane please visit www.brisbane.qld.gov.au/planning-building or talk to a Development Assessment Planning Information Officer via Council's Contact Centre on (07) 3403 8888.

THIS IS A REPORT FOR:

Rateable Address: 19 HERCULES ST, HAMILTON QLD 4007

Lot Details: L.3 SP.172658

PROPERTY INFORMATION (Summary)

The following table provides a summary of flood information for this property. More detailed flood level information is provided in the following sections of this report.

PROPERTY SUMMARY	LEVEL (mAHD)
Minimum Ground Level	2.5
Maximum Ground Level	4.2
Min Habitable Floor Level	Contact Council
Defined Flood Event Level	2.5
Defined Flood Event Level Source	STORMTIDE
Flooding may also occur from	STORMTIDE,RIVER,OVERLAND FLOW

ESTIMATED PEAK FLOODING LEVELS

The table below displays the peak estimated flood levels by probability for this property. Estimated flood level data should be used in conjunction with applicable planning scheme requirements - Refer to Flood Planning Development Information.

Note that the overland flow flooding level maybe higher than the levels below from other sources.

DESCRIPTION	LEVEL (mAHD)	SOURCE
20% AEP	1.9	STORMTIDE
5% AEP	2.1	STORMTIDE
2% AEP	2.2	STORMTIDE
1% AEP	2.5	STORMTIDE
1% AEP	2.2	RIVER

FLOOD PLANNING DEVELOPMENT INFORMATION

This section of the FloodWise Property Report contains information about Council's planning scheme overlays. Overlays identify areas within the planning scheme that reflect distinct themes that may include constrained land and/or areas sensitive to the effects of development.

FLOOD OVERLAY CODE

The Flood overlay code of Council's planning scheme uses the following information to provide guidelines when developing properties. The table below summarises the Flood Planning Areas (FPAs) that apply to this property. Development guidelines for the FPAs are explained in Council's planning scheme, which is available from www.brisbane.qld.gov.au/planning-building.

FLOOD PLANNING AREAS (FPA)		
RIVER	CREEK/WATERWAY	OVERLAND FLOW
FPA5		Applicable

COASTAL HAZARD OVERLAY CODE

The coastal hazard overlay code of Council's planning scheme uses the following information to provide guidelines when conducting new development. The table below summarises the coastal hazard categories that apply to this property. Development guidelines for the following coastal hazard overlay sub-categories are explained in the planning scheme, which is available from www.brisbane.qld.gov.au/planning-building.

COASTAL HAZARD OVERLAY SUB-CATEGORIES

Medium Storm Tide Inundation Area

NOTE: Where land is identified within one or more flood planning area on the Flood Overlay, or is identified within a Storm Tide Inundation area on the Coastal Hazard Overlay, the assessment criteria that provide the highest level of protection from any source of flooding applies.

PROPERTY DEVELOPMENT FLAGS

Overland Flow Path - Mapping indicates this property may be located within an overland flow path. Overland flow flooding usually occurs when the capacity of the underground piped drainage system is exceeded and/or when the overland flow path is blocked. It is recommended you consult a Registered Professional Engineer of Queensland to determine this property's habitable floor level and flooding depth. Please refer to Council's planning scheme for further information.

Large Allotment - This property is either a Large Allotment of over 1000 square metres or is located within a Large Allotment. Flood levels may vary significantly across allotments of this size. Further investigations may be warranted in determining the variation in flood levels and the minimum habitable floor level across the site. For more information or advice, it is recommended you engage a Registered Professional Engineer of Queensland.

Revision	Date
A	4/07/2011
B	26/08/2011
C	3/04/2014

LEGEND

- S - Underground Sewer Line
- SW - Underground Stormwater Line
- W - Underground Water Reticulation Line
- T - Underground Telecommunications Line
- E - Overhead Power Line
- UE - Underground Power Line
- G - Underground Gas Line
- S - Sewer By Records
- SW - Stormwater By Records
- W - Water By Records
- G - Gas By Records
- E - Electricity By Records
- T - Telecommunications By Records
- Building Line
- Edge of Bitumen
- Top of Bank
- Toe of Bank
- Telecom Pit
- Power Pole
- Light Pole
- Direction & Number of Photograph

- NOTES**
1. Drawn to scale on an A1 sheet.
 2. All levels are in metres on Australian Height Datum as determined by PSM 35295 - RL 3.11m AHD.
 3. All dimensions are vide title and subject to confirmation by survey.
 4. Area vide title 7637m²
 5. The location of services is approximate only and is plotted from surface installations and the relevant authority records. The exact nature and location of these services should be confirmed prior to construction.
 6. Contour Interval . . . 0.25m
 7. Boundaries need to be confirmed vide field survey.

Sheet 1 of 2

TITLE

**Plan of Detail Survey
19 Hercules Street
(Lot 3 on SP172658)**

Client **WENTWORTH EQUITIES**

Local Government **BRISBANE CITY COUNCIL**

Locality **HAMILTON**

Comp File


Drawn **SS** Surv'd **CD** Approved **CWW**

Date Created **3/4/14** Job Ref. **10391**

SCALE @ A1 1:250 PLAN No. **4** Rev. **C**

SCALE @ A3 1:500


Plot Date: 08/04/2014

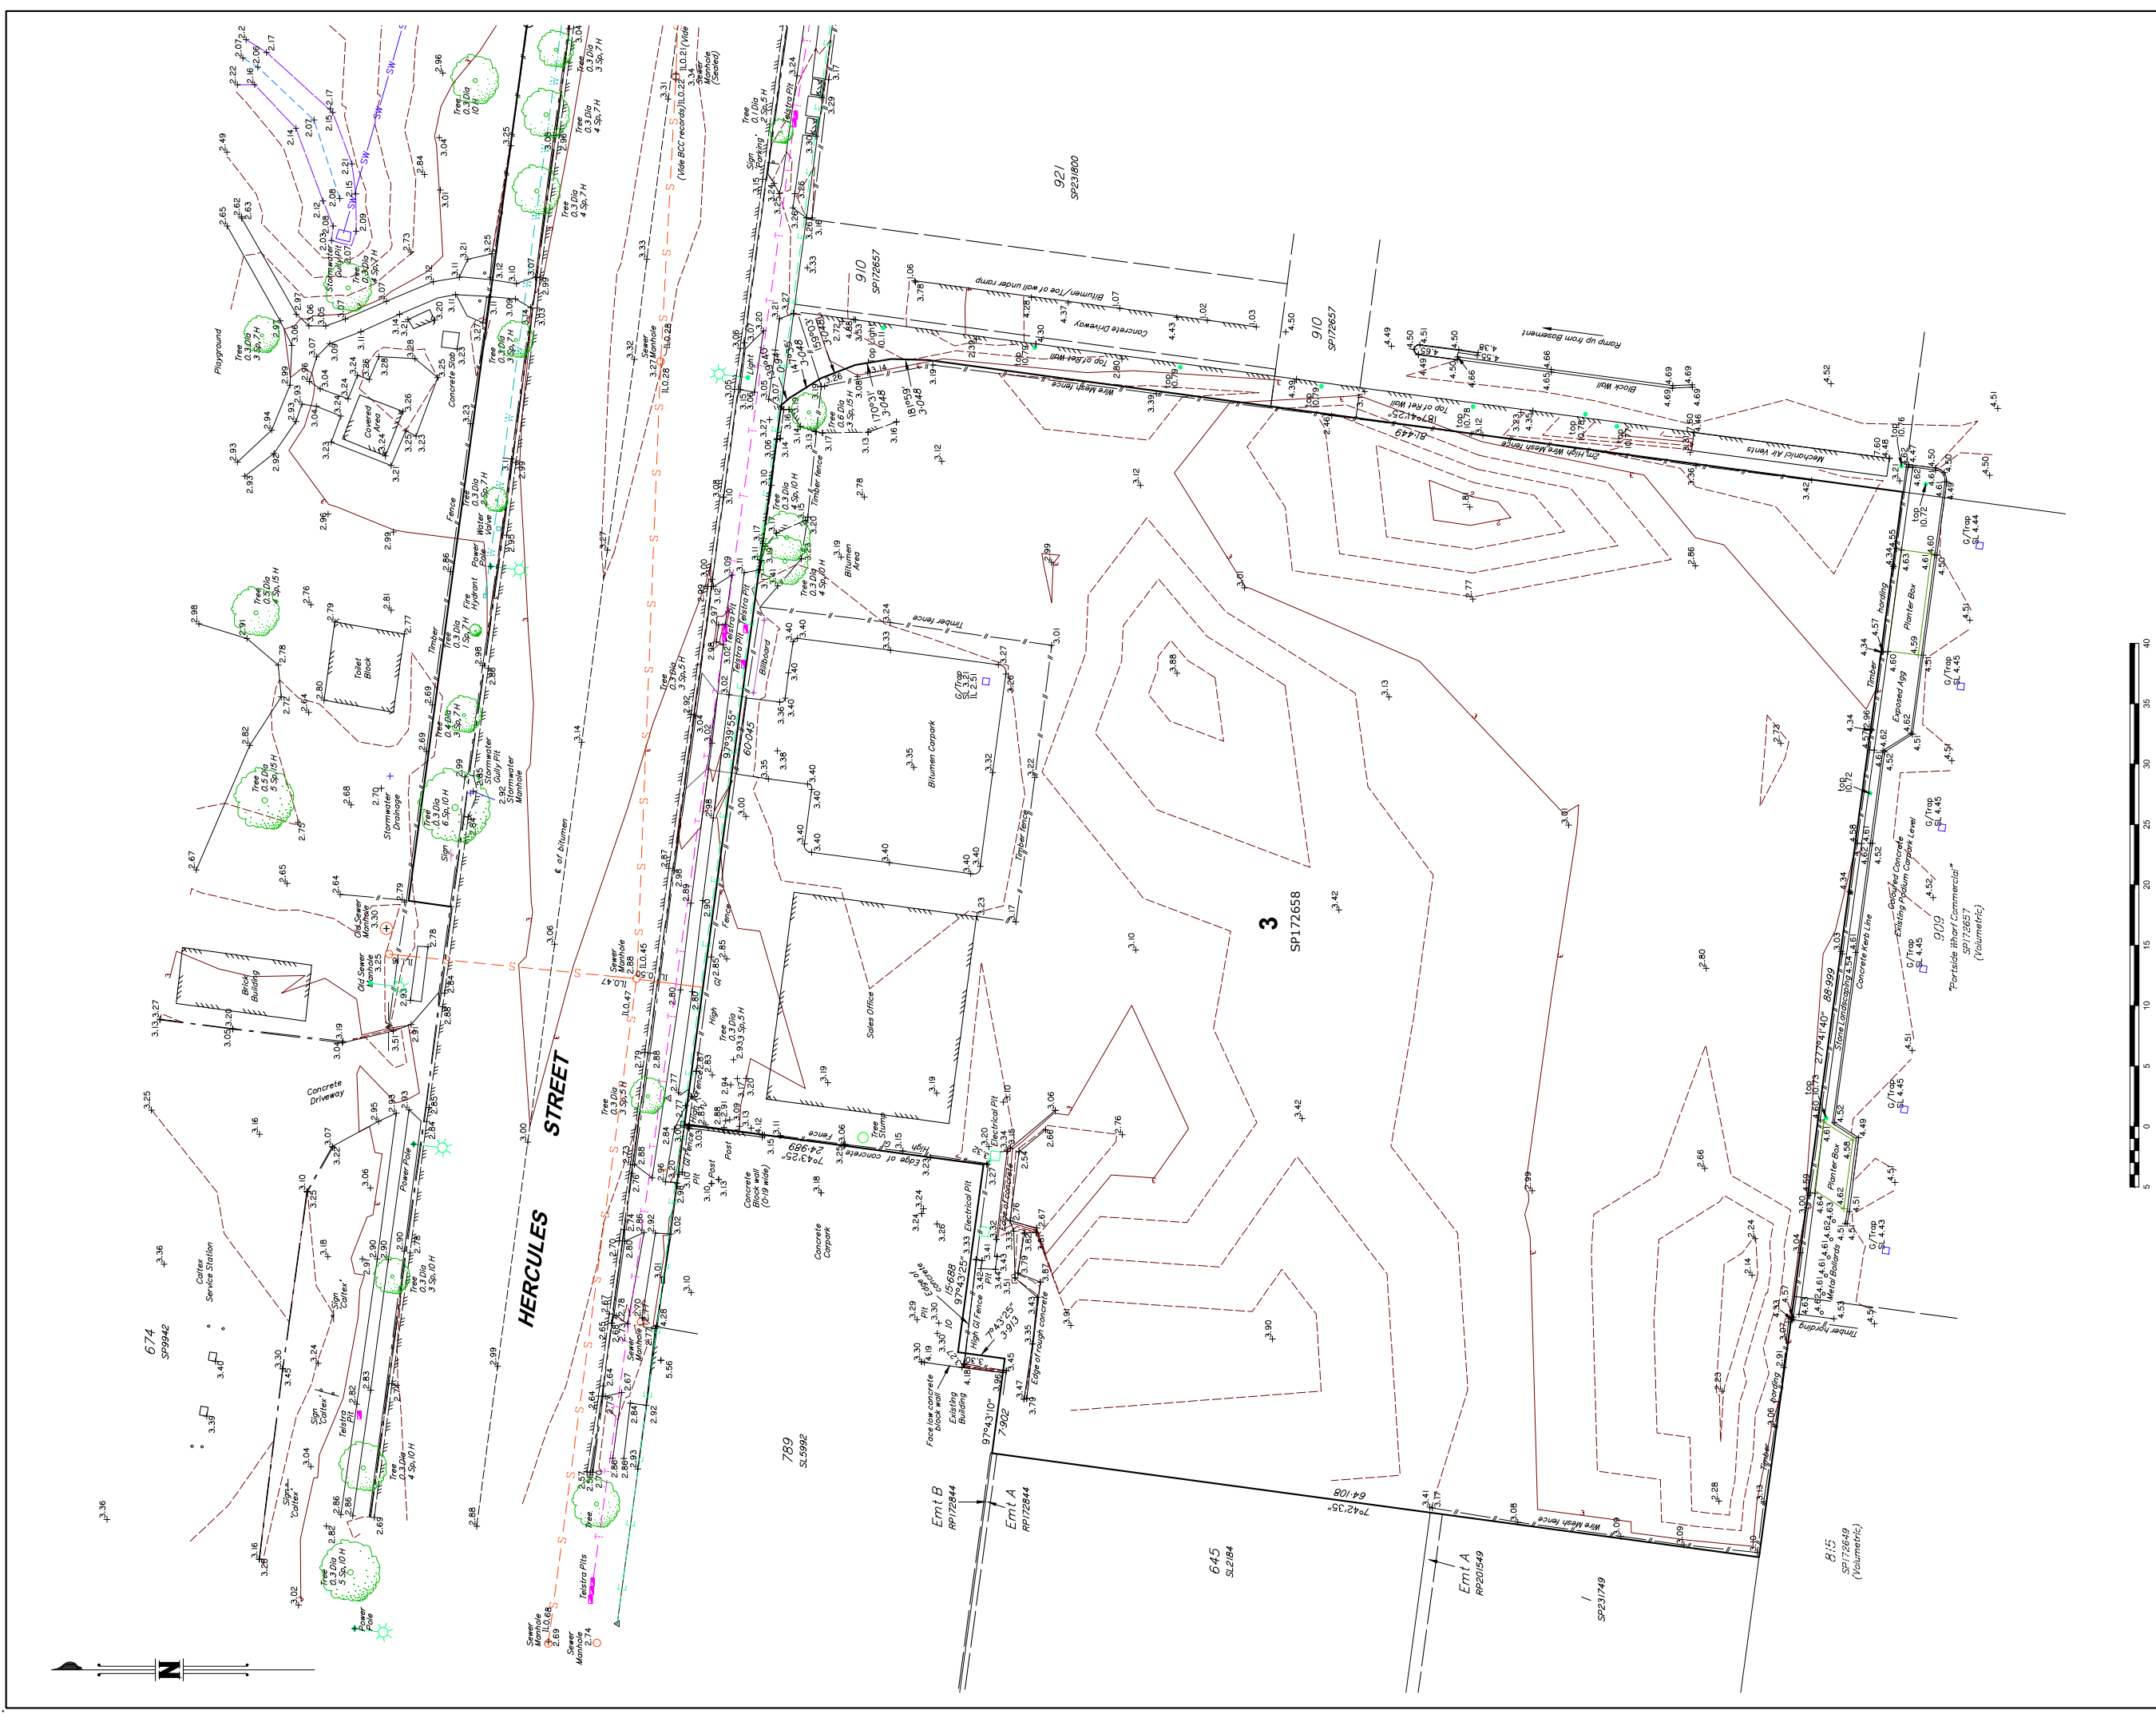

REGISTERED SURVEYOR'S CERTIFICATION

I, Paul William Wild, hereby certify that the vertical and horizontal locations and dimensions shown on this plan are a true and correct record and were located by survey.

Registered Surveyor (sig.) Reg. Surveyor No. S1820 Date: 04/03/18

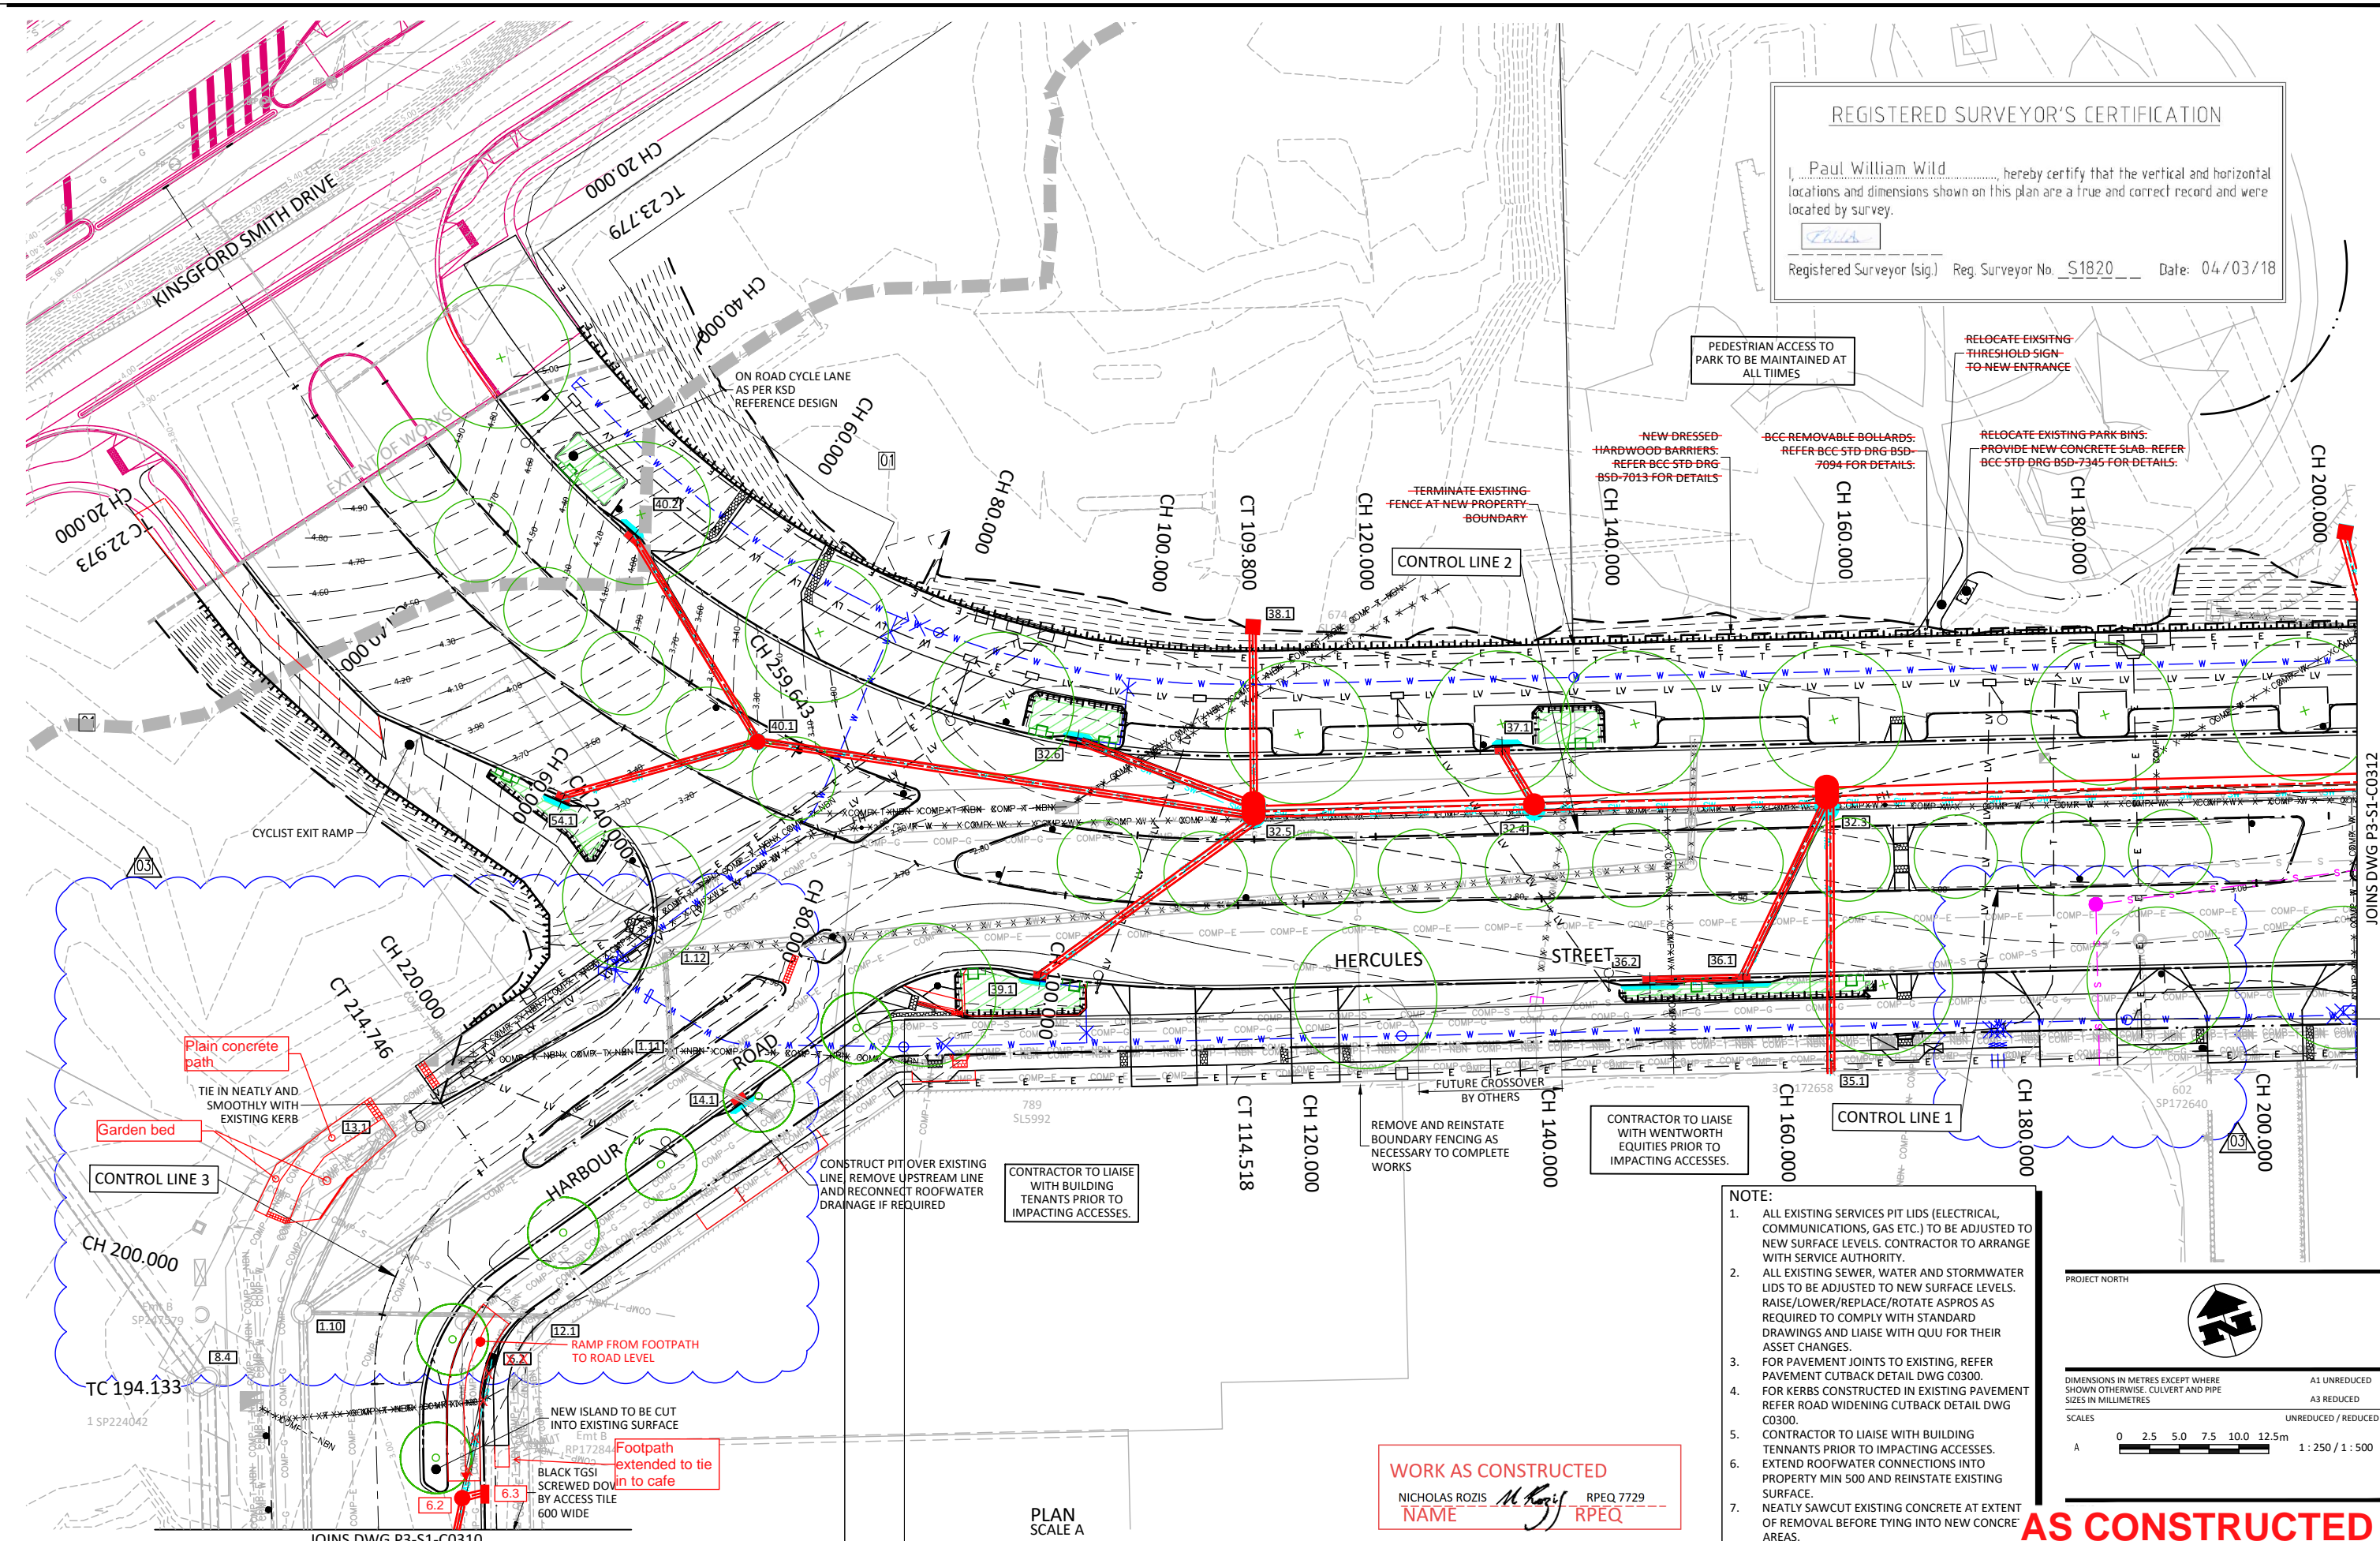

PEDESTRIAN ACCESS TO PARK TO BE MAINTAINED AT ALL TIMES

RELOCATE EXISTING THRESHOLD SIGN TO NEW ENTRANCE

NEW DRESSED HARDWOOD BARRIERS. REFER BCC STD DRG B5D-7013 FOR DETAILS

BCC REMOVABLE BOLLARDS. REFER BCC STD DRG B5D-7094 FOR DETAILS.

RELOCATE EXISTING PARK BINS. PROVIDE NEW CONCRETE SLAB. REFER BCC STD DRG B5D-7345 FOR DETAILS.

TERMINATE EXISTING FENCE AT NEW PROPERTY BOUNDARY

CONTROL LINE 2

CH 140.000

CH 160.000

CH 180.000

CH 200.000

Plain concrete path

Garden bed

CONTROL LINE 3

CH 200.000

TC 194.133

RAMP FROM FOOTPATH TO ROAD LEVEL

NEW ISLAND TO BE CUT INTO EXISTING SURFACE

Footpath extended to tie in to safe

BLACK TGS1 SCREWED DOWN BY ACCESS TILE 600 WIDE

CONSTRUCT PIT OVER EXISTING LINE REMOVE UPSTREAM LINE AND RECONNECT ROOFWATER DRAINAGE IF REQUIRED

CONTRACTOR TO LIAISE WITH BUILDING TENANTS PRIOR TO IMPACTING ACCESSES.

REMOVE AND REINSTATE BOUNDARY FENCING AS NECESSARY TO COMPLETE WORKS

CONTRACTOR TO LIAISE WITH WENTWORTH EQUITIES PRIOR TO IMPACTING ACCESSES.

CONTROL LINE 1


CH 160.000

CH 180.000

CH 200.000

NOTE:

- ALL EXISTING SERVICES PIT LIDS (ELECTRICAL, COMMUNICATIONS, GAS ETC.) TO BE ADJUSTED TO NEW SURFACE LEVELS. CONTRACTOR TO ARRANGE WITH SERVICE AUTHORITY.
- ALL EXISTING SEWER, WATER AND STORMWATER LIDS TO BE ADJUSTED TO NEW SURFACE LEVELS. RAISE/LOWER/REPLACE/ROTATE ASPROS AS REQUIRED TO COMPLY WITH STANDARD DRAWINGS AND LIAISE WITH QUU FOR THEIR ASSET CHANGES.
- FOR PAVEMENT JOINTS TO EXISTING, REFER PAVEMENT CUTBACK DETAIL DWG C0300.
- FOR KERBS CONSTRUCTED IN EXISTING PAVEMENT REFER ROAD WIDENING CUTBACK DETAIL DWG C0300.
- CONTRACTOR TO LIAISE WITH BUILDING TENANTS PRIOR TO IMPACTING ACCESSES.
- EXTEND ROOFWATER CONNECTIONS INTO PROPERTY MIN 500 AND REINSTATE EXISTING SURFACE.
- NEATLY SAWCUT EXISTING CONCRETE AT EXTENT OF REMOVAL BEFORE TYING INTO NEW CONCRETE AREAS.

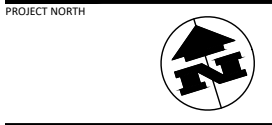

DIMENSIONS IN METRES EXCEPT WHERE SHOWN OTHERWISE. CURVERT AND PIPE SIZES IN MILLIMETRES

SCALE: UNREDUCED / REDUCED

0 2.5 5.0 7.5 10.0 12.5m

1:250 / 1:500

WORK AS CONSTRUCTED

NICHOLAS ROZIS *N. Rozis* RPEQ 7729

NAME *N. Rozis* RPEQ

AS CONSTRUCTED

REV	DATE	DESCRIPTION	DWN	DES	CHK	APP
03	12.10.17	ISLAND FRONTING DEVINE ENTRY REVISED	ASU	BBE	KR	
02	18.07.17	TEMPORARY WORKS REMOVED	MS	KR	KR	NR
01	01.12.16	FOR CONSTRUCTION	SE	BBE	KR	NR
G	31.08.16	ISSUE FOR TENDER				
F	23.05.16	FOOTPATH AMENDED				

ASSOCIATED CONSULTANTS	APPROVED	CHECKED
	N. ROZIS 7729	K. RENSCH
	RPEQ	
	DATE 01/12/16	DATE 01/12/16

APPROVED	CHECKED
N. ROZIS 7729	K. RENSCH
RPEQ	
DATE 01/12/16	DATE 01/12/16

BORNHORST + WARD

CONSULTING ENGINEERS

CIVIL AND STRUCTURAL

Level 4, 67 Astor Terrace
Spring Hill, QLD 4000, Australia
P. +61 (7) 3013 4699
mail@bornhorstward.com.au
www.bornhorstward.com.au

CLIENT: ECONOMIC DEVELOPMENT QUEENSLAND (EDQ)

PROJECT: REMORA ROAD ROADWORKS NORTHSHORE HAMILTON

SUBJECT: ROADWORKS AND DRAINAGE LAYOUT SHEET 2

PROJECT No. 12191C

DRAWING No. P3-S1-C0311

REVISION 04

JOINS DWG P3-S1-C0312


13/10/2017 2:36:44 PM

ORIGINAL SIZE A1

STRUCTURE NAME	32.4
STRUCTURE DESCRIPTION	BCC MANHOLE 1350mm DIA
	32.3
	BCC MANHOLE 1500mm DIA; EXT 900mm
	32.2
	BCC MANHOLE 1500mm DIA; EXT 600mm
	32.1
	BCC MANHOLE 1500mm DIA; EXT 600mm
	29.1
	CUSTOM CHAMBER, 2.300 x 3.200 REFER MANHOLE STRUCTURAL DETAILS DRG C050

SETOUT DETAILS FOR MANHOLES & GULLIES

STRUCTURE TYPE	SET-OUT POINT	LEVEL REFERENCE
MANHOLE & ROOFWATER PIT	CENTRE OF MAIN SHAFT	FINISHED SURFACE LEVEL - MANHOLE/PIT COVER
GULLY PIT ROADWAY TYPE CHANNEL	CO-ORDINATE SETOUT (CENTRE OF GULLY) CHAINAGE SETOUT	LIP OF KERB
FIELD INLET AND ROOFWATER PIT	CENTRE OF GULLY	TOP OF GRATE OR COVER
END WALL	CENTRE OF END WALL (END OF INLET/OUTLET PIPE)	INVERT OF OUTLET/INLET PIPE

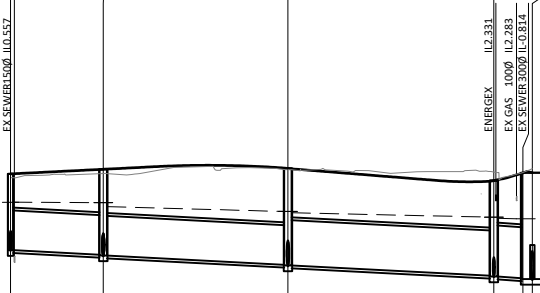


PIPE SIZE (mm)	1050	1050	1200	1350
PIPE CLASS	3 SW	3 SW	3 SW	3 SW
PIPE GRADE (%)	0.48% -0.50%	0.49% -0.50%	0.46% -0.50%	0.13% -0.45%
PIPE SLOPE (1 in X)	200.00 207.81	200.03 204.60	200.74 215.38	220.56 215.27
FULL PIPE VELOCITY (m/s)	0.70	1.61	1.59	1.34
PART FULL VELOCITY (m/s)	1.97	2.43	2.59	2.55
DATUM RL	-12.0	-12.0	-12.0	-12.0
H.G.L IN PIPE & W.S.E IN STRUCTURE	2.138 2.142	2.130 2.024	1.896 1.863	1.747 1.715
PIPE FLOW (m³/s)	0.605	1.397	1.799	1.923
PIPE CAPACITY AT GRADE (m³/s)	1.932	1.932	2.753	3.595
DEPTH TO INVERT	2.033 1.998 2.038 2.033	0.895 0.893 0.873 0.895	2.187 2.163 2.187 2.283	2.033 1.998 2.038 2.033
INVERT LEVEL OF DRAIN	0.895 0.893 0.873 0.895	0.495 0.486 0.466 0.455	2.023 2.014 1.994 1.965	2.033 1.998 2.038 2.033
DESIGN SURFACE LEVEL	2.928 2.891	3.046 3.036	2.875 2.875	2.753 2.715
SETOUT COORDS / RD CHAINAGE	E 6812.435 CH 133.356 OFF 2.000 N 4820.369	E 6806.273 CH 154.918 OFF 2.000 N 4813.911	E 6883.001 CH 206.796 OFF 2.000 N 4800.237	E 6935.231 CH 261.110 OFF 2.004 N 4885.308
CHAINAGE	39.664 24.729 24.562	48.491 48.885	54.276 54.529	167.629 168.183

STRUCTURE NAME	33.1	34.1	35.1	36.2	37.1	38.1
STRUCTURE DESCRIPTION	BCC TYPE A GULLY (SAG) L.L.I; 2.4m Lintel; TYPE E & K&C	BCC FIELD INLET 900x900 TYPE 1	STUB CONNECTION	BCC TYPE A GULLY (SAG) L.L.I; 4.8m Lintel; TYPE E & K&C	BCC TYPE A GULLY (SAG) L.L.I; 2.4m Lintel; TYPE E & K&C	BCC FIELD INLET 900x900 TYPE 1
	33.1	34.1	35.1	36.2	37.1	38.1
	BCC MANHOLE 1500mm DIA; EXT 600mm	BCC MANHOLE 1500mm DIA; EXT 600mm	BCC MANHOLE 1500mm DIA; EXT 900mm	BCC TYPE A GULLY (SAG) L.L.I; 4.8m Lintel; TYPE E & K&C	BCC TYPE A GULLY (SAG) L.L.I; 4.8m Lintel; TYPE E & K&C	BCC MANHOLE 1500mm DIA; EXT 900mm
PIPE SIZE (mm)	450	600	525	525	450	450
PIPE CLASS	3 SW	3 SW	3 SW	3 SW	3 SW	3 SW
PIPE GRADE (%)	1.82% -1.00%	0.22% -0.20%	0.74% -0.80%	0.64% -0.59%	1.74% -1.00%	0.32% -0.30%
PIPE SLOPE (1 in X)	100.00 54.96	500.00 458.61	124.91 135.60	168.82 157.29	100.01 57.61	333.33 315.35
FULL PIPE VELOCITY (m/s)	1.21	1.52	3.18	0.97	0.47	1.87
PART FULL VELOCITY (m/s)	1.93	1.52	3.18	1.62	1.51	1.87
DATUM RL	-11.0	-11.0	-11.0	-11.0	-11.0	-11.0
H.G.L IN PIPE & W.S.E IN STRUCTURE	1.786 1.747 1.715	2.006 1.896 1.863	2.715 2.130 2.024	2.371 2.350 2.201	2.142 2.138 2.142	2.405 2.229 2.173
PIPE FLOW (m³/s)	0.193	0.431	0.688	0.210	0.074	0.297
PIPE CAPACITY AT GRADE (m³/s)	0.285	0.275	0.385	0.331	0.285	0.156
DEPTH TO INVERT	1.350 1.326 1.253	0.530 0.529 0.480	1.473 1.463 1.423	1.473 1.445 1.337	1.385 1.287 1.184	1.090 1.078 1.026
INVERT LEVEL OF DRAIN	1.253 1.103 1.119	0.480 0.486 0.455	0.763 0.750 0.732	1.443 1.366 1.292	1.287 1.184 1.090	1.078 1.026 1.000
DESIGN SURFACE LEVEL	2.579 2.554	2.010 3.162	2.963 2.963	2.750 2.735	2.828 2.891	2.827 2.773
SETOUT COORDS / RD CHAINAGE	E 6884.279 CH 254.644 OFF 2.000 N 4877.803	E 6884.272 CH 254.644 OFF 2.000 N 4877.803	E 6829.757 CH 300.000 OFF 2.000 N 4813.911	E 6916.966 CH 330.000 OFF 2.000 N 4813.911	E 6811.289 CH 370.000 OFF 2.000 N 4820.369	E 6794.541 CH 400.000 OFF 2.000 N 4820.369
CHAINAGE	8.344 8.466	22.472 22.308	22.859 22.859	8.441 8.441	5.934 5.912	16.388 16.263

STORMWATER DRAINAGE LONGITUDINAL SECTION
SCALE A (HOR)
B (VERT)


REGISTERED SURVEYOR'S CERTIFICATION
I, Paul William Wild, hereby certify that the vertical and horizontal locations and dimensions shown on this plan are a true and correct record and were located by survey.
Registered Surveyor (sig) Reg. Surveyor No. S1820 Date: 04/03/18

WORK AS CONSTRUCTED
NICHOLAS ROZIS RPEQ 7729
NAME M. Rozis RPEQ 7729

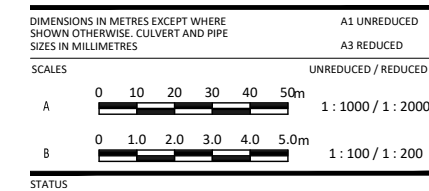

AS CONSTRUCTED

COPYRIGHT © - This document is and shall remain the property of BORNHORST + WARD Pty. Ltd. The document may only be used for the purpose for which it was commissioned and in accordance with the terms of engagement. Unauthorised use of this document in any form whatsoever is prohibited.	<table border="1"> <tr> <th>REV</th> <th>DATE</th> <th>DESCRIPTION</th> <th>DWN</th> <th>DES</th> <th>CHK</th> <th>APP</th> </tr> <tr> <td>02</td> <td>26.06.17</td> <td>REVISED PIT DEPTH AS SHOWN</td> <td>AB</td> <td>BBE</td> <td>NR</td> <td>NR</td> </tr> <tr> <td>01</td> <td>01.12.16</td> <td>FOR CONSTRUCTION</td> <td>SE</td> <td>BBE</td> <td>KR</td> <td>NR</td> </tr> <tr> <td>D</td> <td>31.03.16</td> <td>ISSUE FOR TENDER</td> <td>MS</td> <td>BBE</td> <td>KR</td> <td>NR</td> </tr> <tr> <td>E</td> <td>11.03.16</td> <td>FOR REVIEW</td> <td></td> <td></td> <td></td> <td></td> </tr> <tr> <td>C</td> <td>24.02.16</td> <td>ISSUE TO APA FOR CO-ORDINATION</td> <td></td> <td></td> <td></td> <td></td> </tr> </table>	REV	DATE	DESCRIPTION	DWN	DES	CHK	APP	02	26.06.17	REVISED PIT DEPTH AS SHOWN	AB	BBE	NR	NR	01	01.12.16	FOR CONSTRUCTION	SE	BBE	KR	NR	D	31.03.16	ISSUE FOR TENDER	MS	BBE	KR	NR	E	11.03.16	FOR REVIEW					C	24.02.16	ISSUE TO APA FOR CO-ORDINATION					<table border="1"> <tr> <th>ASSOCIATED CONSULTANTS</th> <th>APPROVED</th> <th>CHECKED</th> </tr> <tr> <td></td> <td>N. ROZIS 7729 RPEQ</td> <td>K. RENSCH</td> </tr> <tr> <td></td> <td>DATE 01/12/16</td> <td>DATE 01/12/16</td> </tr> </table>	ASSOCIATED CONSULTANTS	APPROVED	CHECKED		N. ROZIS 7729 RPEQ	K. RENSCH		DATE 01/12/16	DATE 01/12/16	<table border="1"> <tr> <th>BORNHORST + WARD</th> <th>Level 4, 67 Astor Terrace Spring Hill, QLD 4000, Australia P. +61 (7) 3013 4699 mail@bornhorstward.com.au www.bornhorstward.com.au</th> </tr> <tr> <th>CONSULTING ENGINEERS</th> <th>CIVIL AND STRUCTURAL</th> </tr> </table>	BORNHORST + WARD	Level 4, 67 Astor Terrace Spring Hill, QLD 4000, Australia P. +61 (7) 3013 4699 mail@bornhorstward.com.au www.bornhorstward.com.au	CONSULTING ENGINEERS	CIVIL AND STRUCTURAL	<table border="1"> <tr> <th>ECONOMIC DEVELOPMENT QUEENSLAND (EDQ)</th> <th>CLIENT</th> </tr> <tr> <td></td> <td>REMONA ROAD ROADWORKS NORTHSHORE HAMILTON</td> </tr> </table>	ECONOMIC DEVELOPMENT QUEENSLAND (EDQ)	CLIENT		REMONA ROAD ROADWORKS NORTHSHORE HAMILTON	<table border="1"> <tr> <th>PROJECT</th> <th>PROJECT No.</th> </tr> <tr> <td>REMONA ROAD ROADWORKS NORTHSHORE HAMILTON</td> <td>12191C</td> </tr> <tr> <th>SUBJECT</th> <th>DRAWING No.</th> </tr> <tr> <td>STORMWATER DRAINAGE LONGITUDINAL SECTIONS SHEET 6</td> <td>P3-S1-C0505 03</td> </tr> </table>	PROJECT	PROJECT No.	REMONA ROAD ROADWORKS NORTHSHORE HAMILTON	12191C	SUBJECT	DRAWING No.	STORMWATER DRAINAGE LONGITUDINAL SECTIONS SHEET 6	P3-S1-C0505 03
REV	DATE	DESCRIPTION	DWN	DES	CHK	APP																																																																		
02	26.06.17	REVISED PIT DEPTH AS SHOWN	AB	BBE	NR	NR																																																																		
01	01.12.16	FOR CONSTRUCTION	SE	BBE	KR	NR																																																																		
D	31.03.16	ISSUE FOR TENDER	MS	BBE	KR	NR																																																																		
E	11.03.16	FOR REVIEW																																																																						
C	24.02.16	ISSUE TO APA FOR CO-ORDINATION																																																																						
ASSOCIATED CONSULTANTS	APPROVED	CHECKED																																																																						
	N. ROZIS 7729 RPEQ	K. RENSCH																																																																						
	DATE 01/12/16	DATE 01/12/16																																																																						
BORNHORST + WARD	Level 4, 67 Astor Terrace Spring Hill, QLD 4000, Australia P. +61 (7) 3013 4699 mail@bornhorstward.com.au www.bornhorstward.com.au																																																																							
CONSULTING ENGINEERS	CIVIL AND STRUCTURAL																																																																							
ECONOMIC DEVELOPMENT QUEENSLAND (EDQ)	CLIENT																																																																							
	REMONA ROAD ROADWORKS NORTHSHORE HAMILTON																																																																							
PROJECT	PROJECT No.																																																																							
REMONA ROAD ROADWORKS NORTHSHORE HAMILTON	12191C																																																																							
SUBJECT	DRAWING No.																																																																							
STORMWATER DRAINAGE LONGITUDINAL SECTIONS SHEET 6	P3-S1-C0505 03																																																																							

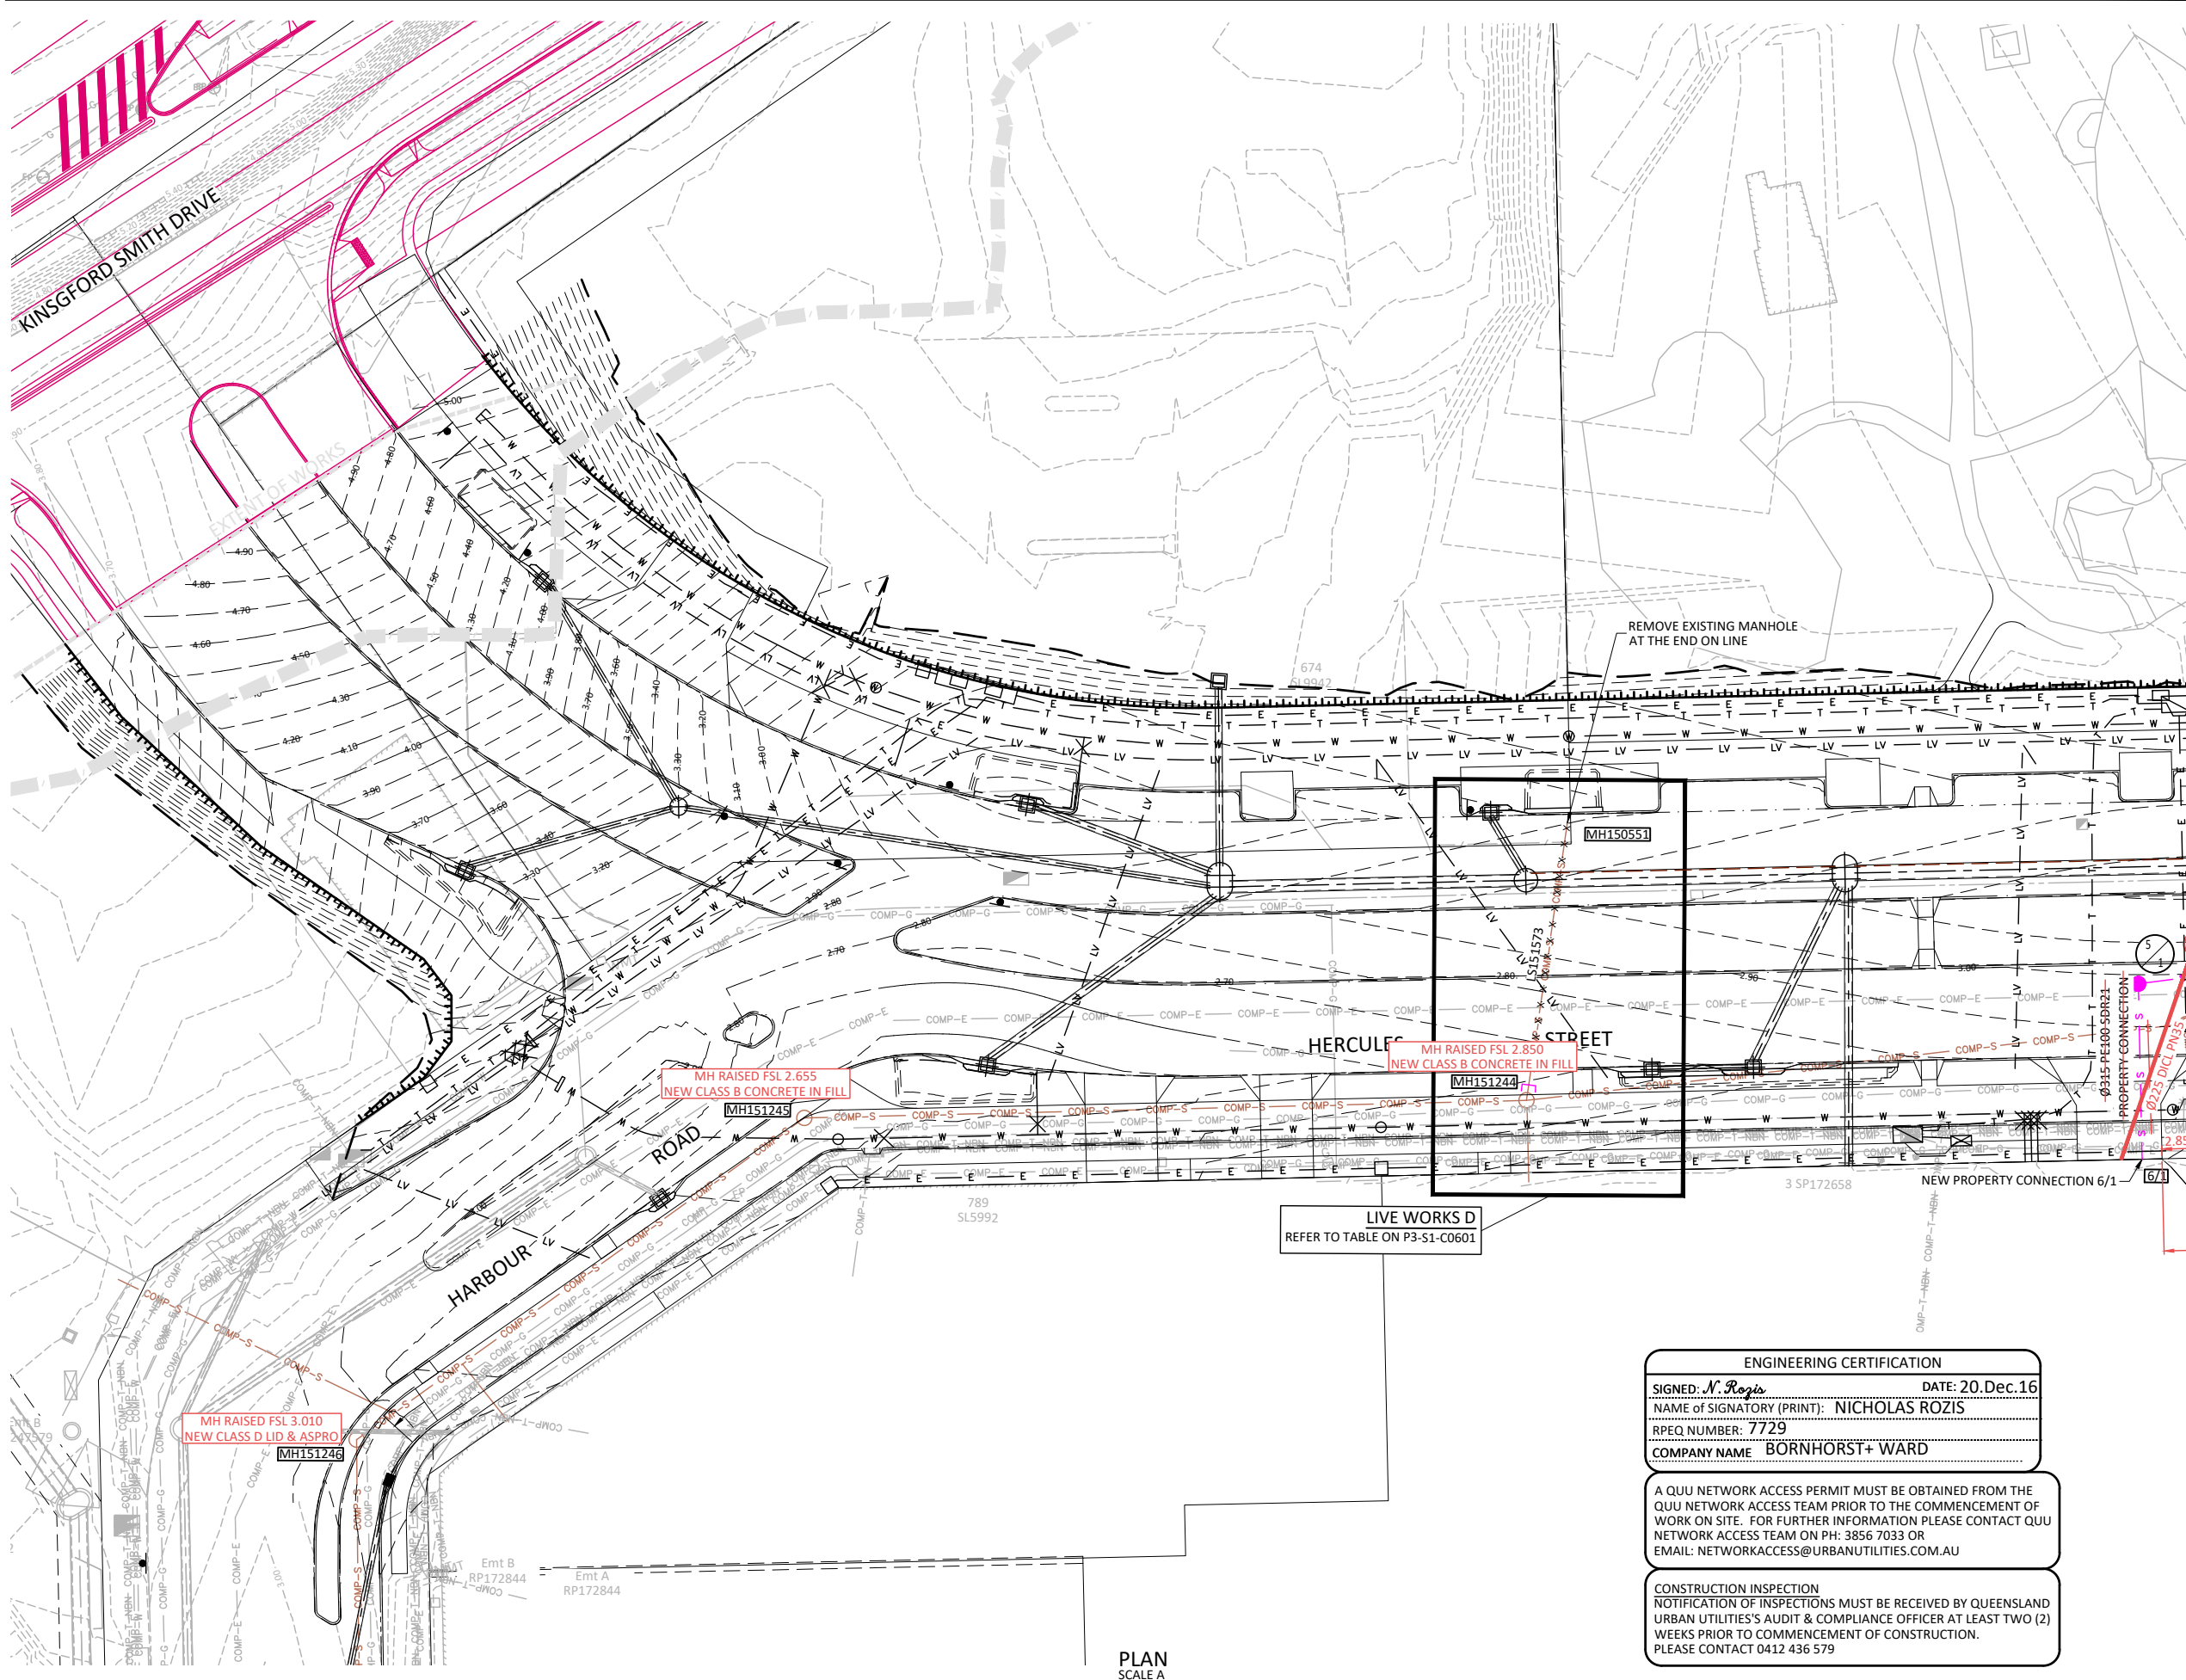

NOTE:
 1. ALL SEWER AND ASSOCIATED MANHOLES MARKED TO BE ABANDONED LOCATED INSIDE WORKS ZONE TO BE REMOVED FROM SITE UNLESS NOTED OTHERWISE. TRENCHES TO BE BACKFILLED WITH IMPORTED MATERIAL AS PER EARTHWORKS SPECIFICATION.
 2. FOR EXISTING MANHOLES TO BE ADJUSTED, REFER LIVE WORKS G TABLE DRG C0601.

AS CONSTRUCTED
 EYRE CONSTRUCTION SURVEYING PTY LTD
 ENGINEERING SURVEYORS Hereby certify that this drawing is a true and accurate representation of the As-constructed works at the time of survey.
 I hereby certify that the vertical and horizontal locations and dimensions shown on this plan are a true and correct record and were located by survey.
 Name: Paul Wild Date: 16/01/18
 Signature: *Paul Wild* (S1820)

ORIGINAL SIGNED BY *Pakee Bala* DATE: 22/12/16
 QUEENSLAND URBAN UTILITIES DELEGATE
 (VALID FOR 12 MONTHS FROM DATE SHOWN)


CLIENT: ECONOMIC DEVELOPMENT QUEENSLAND
 CONTACT: BORNHORST & WARD
 QUU AUDITOR: AUDIT AND COMPLIANCE OFFICER
 CONTACT: GREG LOVELOCK 0414 326 408

AS CONSTRUCTED DETAILS FOR AMEND. A

I CERTIFY THAT THE "AS CONSTRUCTED" DETAILS SHOWN ON THIS PLAN ARE TRUE AND ACCURATE RECORD OF THE WORKS

SIGNED: *N. Rozis* DATE: 14/04/20
 NAME OF SIGNATORY: NICK ROZIS
 RPEQ No. or LICENCE: 7729
 COMPANY NAME: BORNHORST + WARD PTY LTD
 START DATE: 01/02/17 FINISH DATE: 05/02/18

SHEET No. 3 OF 8
 QUEENSLAND URBAN UTILITIES DRAWING No. 486/5/9 - 0271 - 003
 AMEND. A

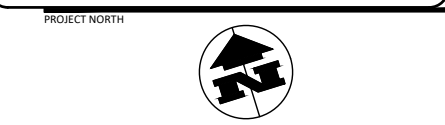

DIMENSIONS IN METRES EXCEPT WHERE SHOWN OTHERWISE. CULVERT AND PIPE SIZES IN MILLIMETRES
 A1 UNREDUCED
 A3 REDUCED
 SCALES UNREDUCED / REDUCED
 0 2.5 5.0 7.5 10.0 12.5m 1:250 / 1:500

STATUS: **AS CONSTRUCTED**

ENGINEERING CERTIFICATION
 SIGNED: *N. Rozis* DATE: 20. Dec. 16
 NAME OF SIGNATORY (PRINT): NICHOLAS ROZIS
 RPEQ NUMBER: 7729
 COMPANY NAME: BORNHORST+ WARD

A QUU NETWORK ACCESS PERMIT MUST BE OBTAINED FROM THE QUU NETWORK ACCESS TEAM PRIOR TO THE COMMENCEMENT OF WORK ON SITE. FOR FURTHER INFORMATION PLEASE CONTACT QUU NETWORK ACCESS TEAM ON PH: 3856 7033 OR EMAIL: NETWORKACCESS@URBANUTILITIES.COM.AU

CONSTRUCTION INSPECTION
 NOTIFICATION OF INSPECTIONS MUST BE RECEIVED BY QUEENSLAND URBAN UTILITIES'S AUDIT & COMPLIANCE OFFICER AT LEAST TWO (2) WEEKS PRIOR TO COMMENCEMENT OF CONSTRUCTION. PLEASE CONTACT 0412 436 579

LIVE WORKS D
 REFER TO TABLE ON P3-S1-C0601

PLAN SCALE A

REV	DATE	DESCRIPTION	DWN	DES	CHK	APP
02	27.07.18	AS CONSTRUCTED FOR QUU COMMENT	ABL	BBE	KR	NR
01	20.12.16	FOR CONSTRUCTION	SE	BBE	KR	NR
E	31.08.16	ISSUE FOR TENDER				
D	31.03.16	ISSUE FOR TENDER				
C	11.03.16	FOR REVIEW				

ASSOCIATED CONSULTANTS	APPROVED	CHECKED
BORNHORST + WARD CONSULTING ENGINEERS CIVIL AND STRUCTURAL 7729 RPEQ
	DATE	DATE


BORNHORST + WARD
 Level 4, 67 Astor Terrace
 Spring Hill, QLD 4000, Australia
 P. +61 (7) 3013 4699
 mail@bornhorstward.com.au
 www.bornhorstward.com.au

CLIENT: ECONOMIC DEVELOPMENT QUEENSLAND (EDQ)

PROJECT: REMORA ROAD ROADWORKS NORTHSHORE HAMILTON

SUBJECT: SEWER RETICULATION LAYOUT SHEET 1

PROJECT No. 12191C
 DRAWING No. P3-S1-C0610 REVISION 02

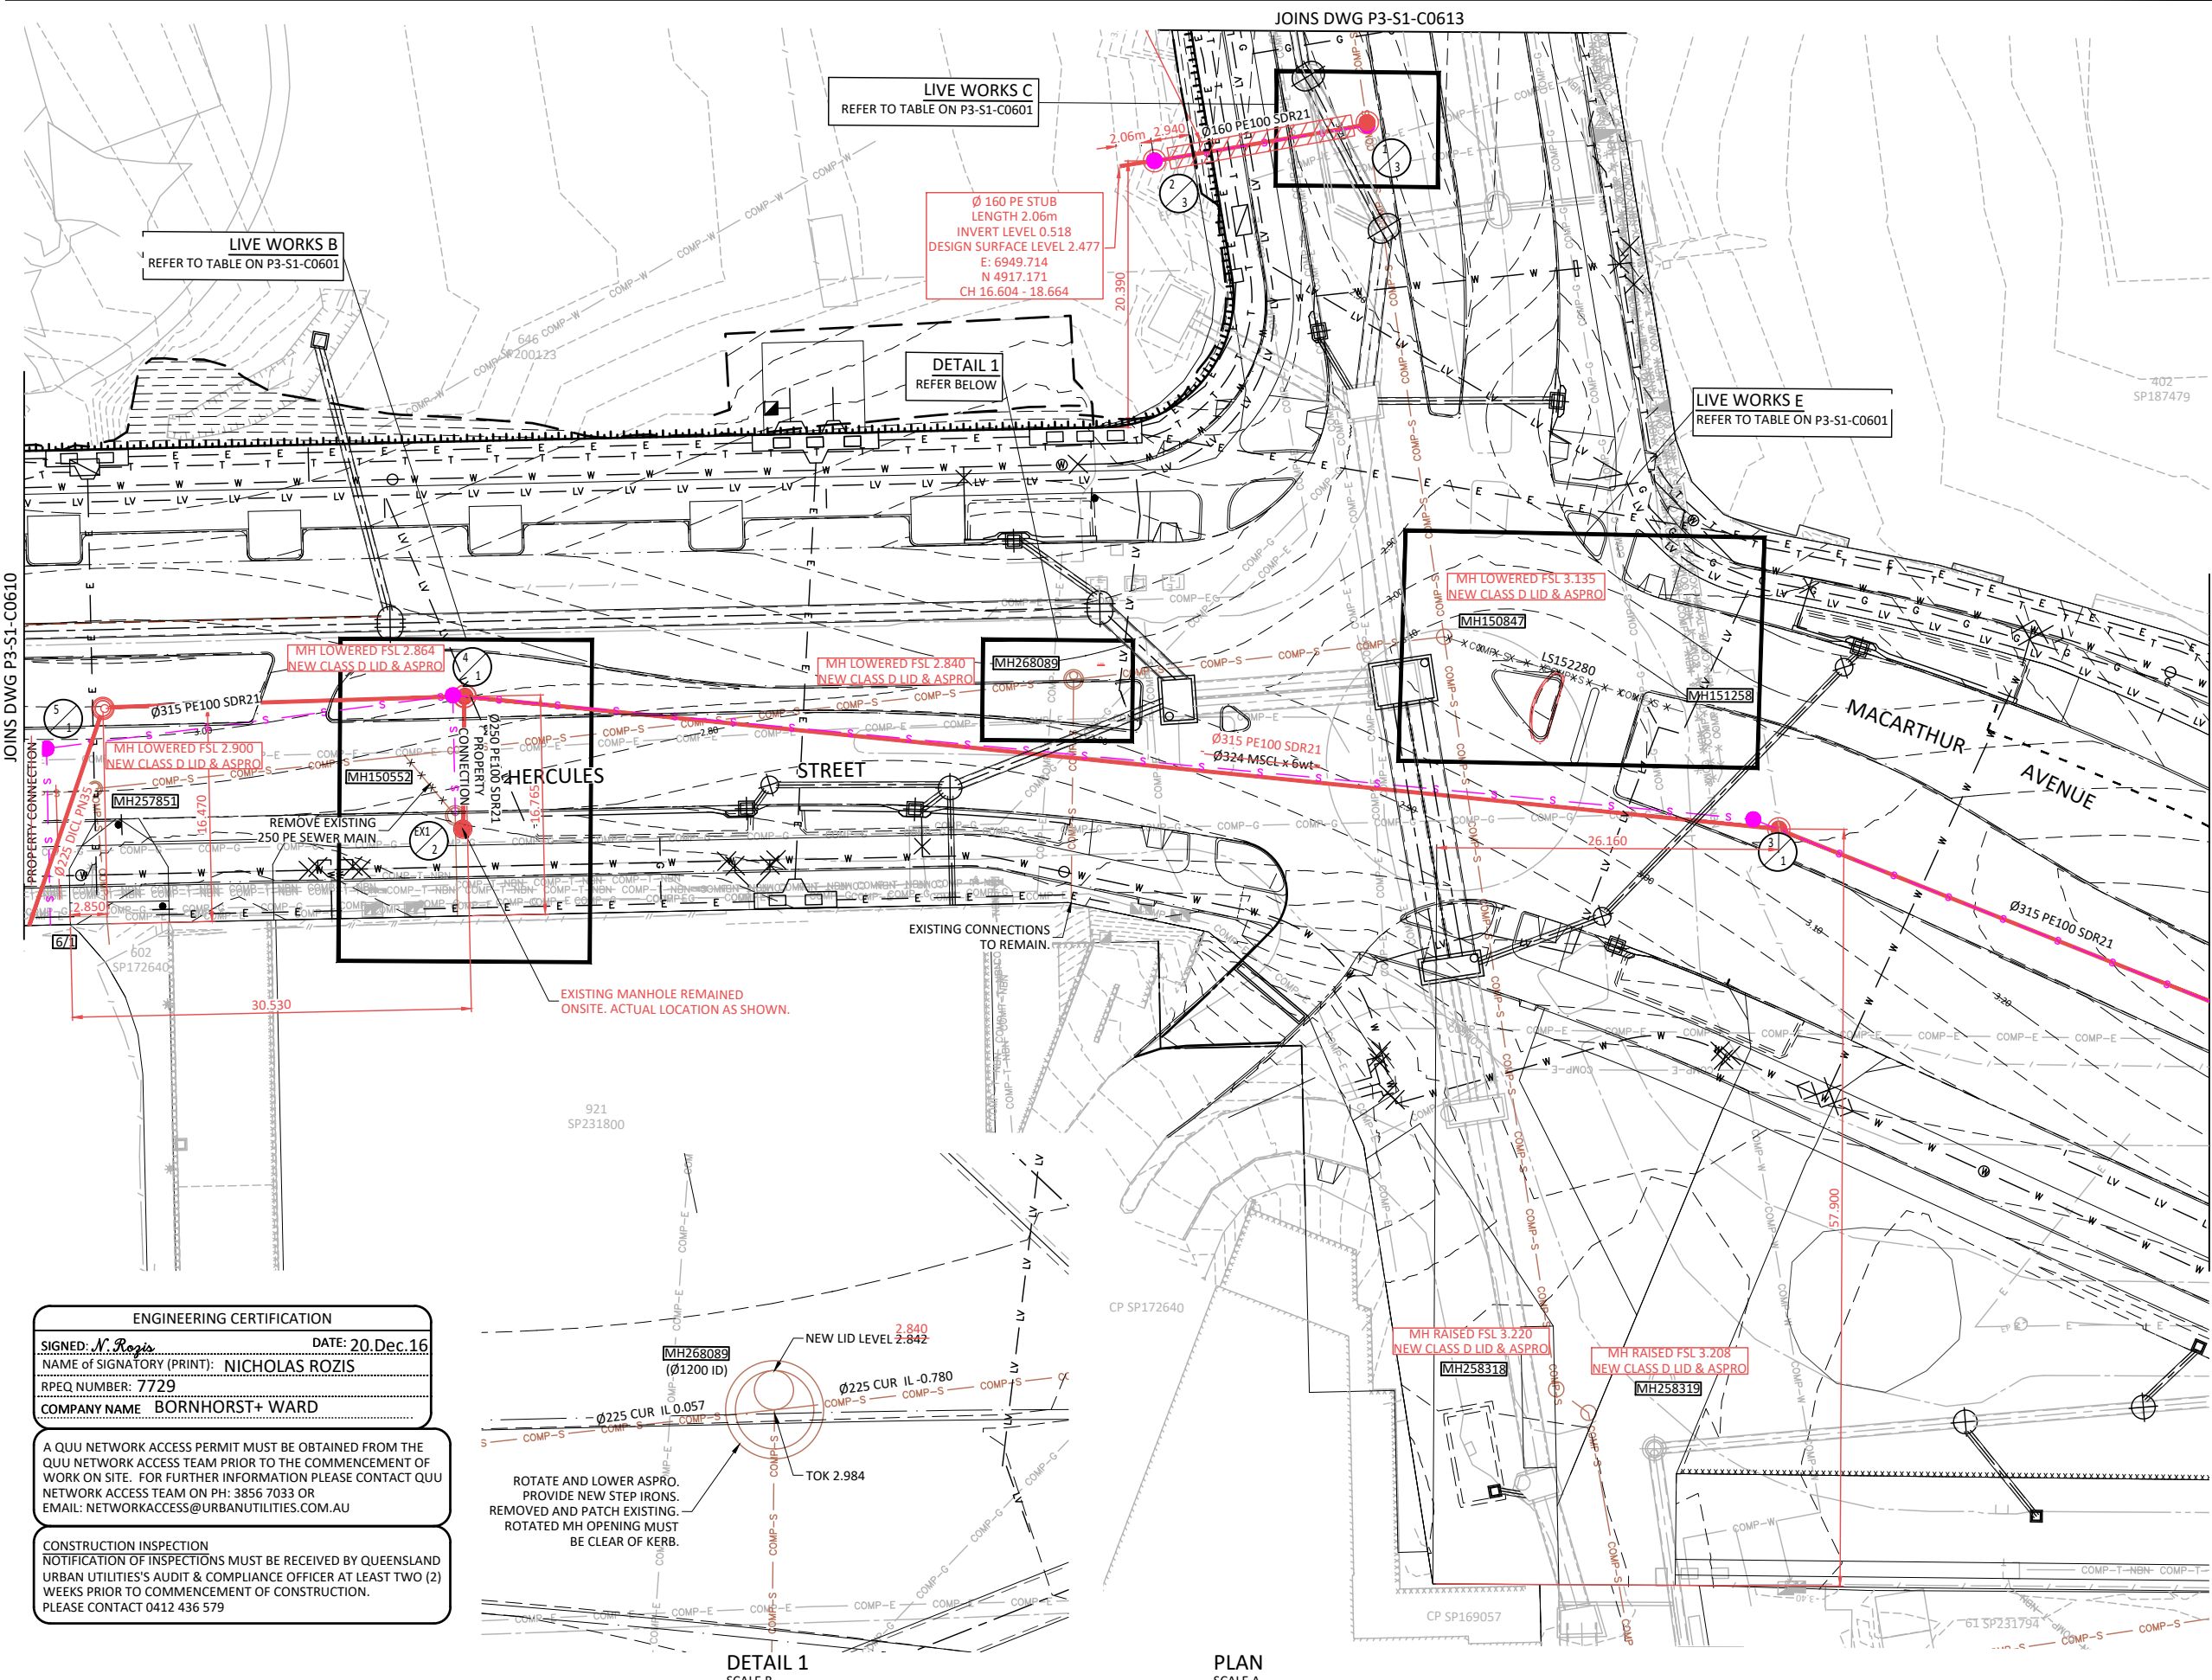

NOTE:
FOR ALL CONNECTIONS TO EXISTING MANHOLES, CONTRACTOR TO VERIFY INVERT LEVELS AT THESE MANHOLES PRIOR TO COMMENCEMENT OF CONSTRUCTION.

NOTE:
1. ALL SEWER AND ASSOCIATED MANHOLES MARKED TO BE ABANDONED LOCATED INSIDE WORKS ZONE TO BE REMOVED FROM SITE UNLESS NOTED OTHERWISE. TRENCHES TO BE BACKFILLED WITH IMPORTED MATERIAL AS PER EARTHWORKS SPECIFICATION.
2. FOR EXISTING MANHOLES TO BE ADJUSTED, REFER LIVE WORKS G TABLE DRG C0601.

AS CONSTRUCTED
EYRE CONSTRUCTION SURVEYING PTY LTD
ENGINEERING SURVEYORS Hereby certify that this drawing is a true and accurate representation of the AS-constructed works at the time of survey.
I hereby certify that the vertical and horizontal locations and dimensions shown on this plan are a true and correct record and were located by survey
Name: Paul Wild Date: 16/01/18
Signature: [Signature] (S18201)

ORIGINAL SIGNED BY [Paul Wild] DATE: 22/12/16
QUEENSLAND URBAN UTILITIES DELEGATE
(VALID FOR 12 MONTHS FROM DATE SHOWN)

CLIENT: ECONOMIC DEVELOPMENT QUEENSLAND
CONTACT: BORNHORST & WARD
QUU AUDITOR: AUDIT AND COMPLIANCE OFFICER
CONTACT: GREG LOVELOCK 0414 326 408


AS CONSTRUCTED DETAILS FOR AMEND. A

I CERTIFY THAT THE "AS CONSTRUCTED" DETAILS SHOWN ON THIS PLAN ARE TRUE AND ACCURATE RECORD OF THE WORKS

SIGNED: [Signature] DATE: 14/04/20
NAME OF SIGNATORY: NICK ROZIS
RPEQ No. or LICENCE: 7729
COMPANY NAME: BORNHORST + WARD PTY LTD
START DATE: 01/02/17 FINISH DATE: 05/02/18

SHEET No. 4 OF 8


QUEENSLAND URBAN UTILITIES DRAWING No. 486/5/9 - 0271 - 004 AMEND. A

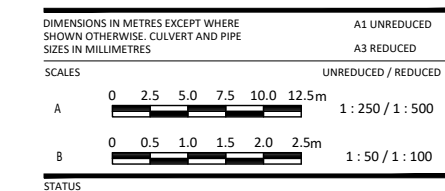

ENGINEERING CERTIFICATION
SIGNED: N. Rozis DATE: 20.Dec.16
NAME OF SIGNATORY (PRINT): NICHOLAS ROZIS
RPEQ NUMBER: 7729
COMPANY NAME: BORNHORST+ WARD

A QUU NETWORK ACCESS PERMIT MUST BE OBTAINED FROM THE QUU NETWORK ACCESS TEAM PRIOR TO THE COMMENCEMENT OF WORK ON SITE. FOR FURTHER INFORMATION PLEASE CONTACT QUU NETWORK ACCESS TEAM ON PH: 3856 7033 OR EMAIL: NETWORKACCESS@URBANUTILITIES.COM.AU

CONSTRUCTION INSPECTION NOTIFICATION OF INSPECTIONS MUST BE RECEIVED BY QUEENSLAND URBAN UTILITIES'S AUDIT & COMPLIANCE OFFICER AT LEAST TWO (2) WEEKS PRIOR TO COMMENCEMENT OF CONSTRUCTION. PLEASE CONTACT 0412 436 579

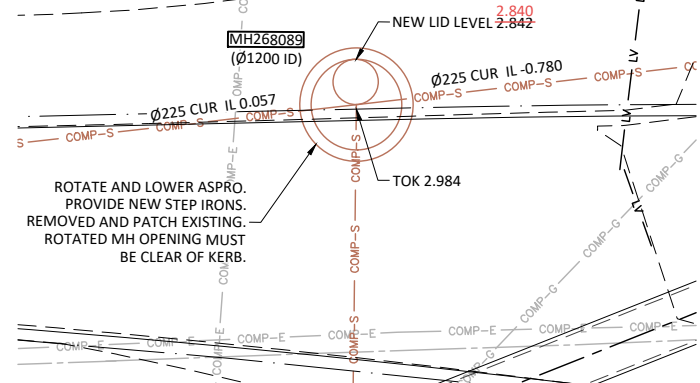

DETAIL 1 SCALE B


PLAN SCALE A

<p>REV DATE DESCRIPTION DWN DES CHK APP</p> <p>03 27.07.18 AS CONSTRUCTED FOR QUU COMMENT ABL BBE KR NR</p> <p>02 10.02.17 PIPE DETAIL MENDED SE BBE KR NR</p> <p>01 20.12.16 FOR CONSTRUCTION SE BBE KR NR</p> <p>D 31.03.16 ISSUE FOR TENDER MS BBE KR NR</p> <p>C 11.03.16 FOR REVIEW</p>				<p>ASSOCIATED CONSULTANTS</p> <p>BORNHORST + WARD CONSULTING ENGINEERS CIVIL AND STRUCTURAL</p>		<p>APPROVED</p> <p>7729 RPEQ</p>		<p>CHECKED</p>		<p>Level 4, 67 Astor Terrace Spring Hill, QLD 4000, Australia P. +61 (7) 3013 4699 mail@bornhorstward.com.au www.bornhorstward.com.au</p>		<p>CLIENT: ECONOMIC DEVELOPMENT QUEENSLAND (EDQ)</p>		<p>PROJECT: REMORA ROAD ROADWORKS NORTHSHORE HAMILTON</p>		<p>SUBJECT: SEWER RETICULATION LAYOUT SHEET 2</p>		<p>PROJECT No. 12191C DRAWING No. P3-S1-C0611 REVISION 03</p>	
--	--	--	--	--	--	----------------------------------	--	----------------	--	---	--	--	--	---	--	---	--	---	--

COPYRIGHT © - This document is and shall remain the property of Bornhorst & Ward Pty. Ltd. The document may only be used for the purpose for which it was commissioned and in accordance with the terms of engagement. Unauthorised use of this document in any form whatsoever is prohibited.

15/04/2018 09:57:46 AM \\V:\WORK\DESIGN\2018\12\12\12191C_03_BORNHORST\DRG\P3-S1-C0613.DWG

MANHOLE/END NAME	EX1/4	2/1	3/1	4/1	5/1	6/1		4/1	EX1/2	1/3	2/3	MH521119	1/4	MH521120	1/5
MANHOLE TYPE	EXISTING	F	F	F	F	PROPERTY CONNECTION END CAP		F	F	F	F	INTERNAL DROP IN EXISTING MANHOLE REFER SEQ STD DRG SEQ-SEW-1301-8	F	INTERNAL DROP IN EXISTING MANHOLE REFER SEQ STD DRG SEQ-SEW-1301-8	F
LID TYPE		D	D	D	D			D	D	D	D		D	D	D
JUNCTION LINE															
DROP TYPE		A	A	A	A			A	A	A	A		A	A	A
DEPTH TO HC															
HC INVERT LEVEL															
INVERT LEVEL															
HC TYPE															
HC LOT No.															
CH. FROM D/S MH															

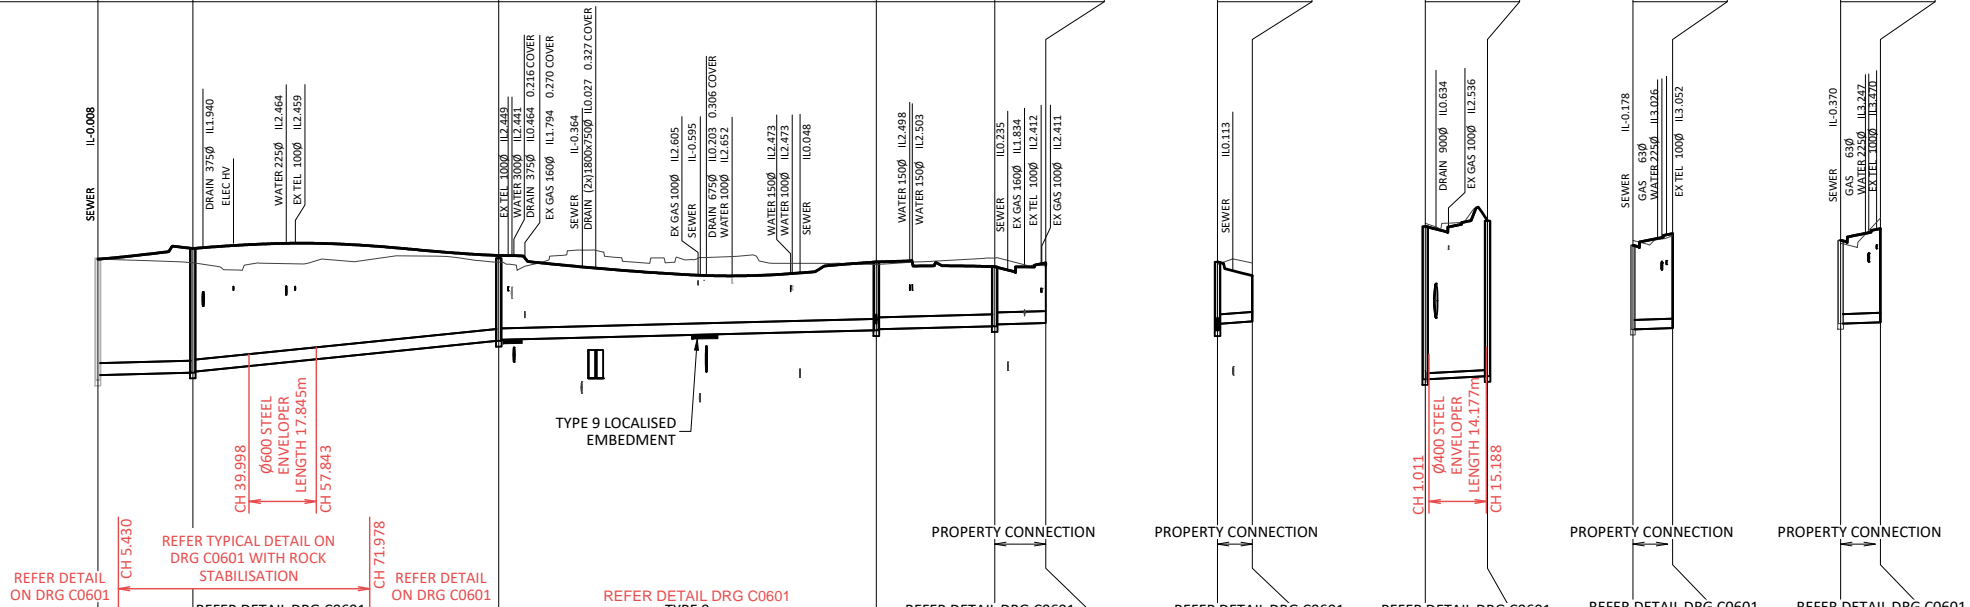

EMBEDMENT TYPE	PROPERTY DESCRIPTION	DIAMETER	GRADE	DATUM RL	JUNCTION INVERT LEVEL	DEPTH TO INVERT	INVERT LEVEL	DESIGN SURFACE LEVEL	NATURAL SURFACE	COORDINATES	CHAINAGE
MACARTHUR AVENUE	315 PE 100 SDR 21	224	1 in 400	-11.000	3.228	3.187	-0.020	3.187	3.188	E 7065.140 N 4796.724	0.000
HERCULES STREET	315 PE 100 SDR 21	101.00	1 in 100.00	-11.000	3.362	3.106	0.154	3.106	3.106	E 6976.228 N 4854.214	25.142
HERCULES STREET	315 PE 100 SDR 21	296	1 in 400	-11.000	2.319	2.285	0.081	2.285	3.106	E 6976.228 N 4854.214	81.009
HERCULES STREET	315 PE 100 SDR 21	345	1 in 400	-11.000	1.473	1.473	0.981	1.473	3.106	E 6886.785 N 4893.527	106.150
HERCULES STREET	315 PE 100 SDR 21	199	1 in 400	-11.000	1.757	1.740	1.352	1.740	3.106	E 6886.785 N 4893.527	103.884
HERCULES STREET	315 PE 100 SDR 21	20	1 in 151	-12.000	1.636	1.636	1.297	1.636	3.106	E 6886.785 N 4893.527	99.966
HERCULES STREET	315 PE 100 SDR 21	18	1 in 203	-13.000	1.735	1.735	1.473	1.735	3.106	E 6886.785 N 4893.527	101.078
HERCULES STREET	315 PE 100 SDR 21	199	1 in 400	-13.000	1.085	1.085	1.352	1.085	3.106	E 6886.785 N 4893.527	117.533
HERCULES STREET	315 PE 100 SDR 21	121	1 in 200	-11.000	3.578	3.500	1.352	3.500	3.106	E 6886.785 N 4893.527	133.501
HERCULES STREET	315 PE 100 SDR 21	190	1 in 200	-11.000	2.243	2.175	1.408	2.175	3.106	E 6886.785 N 4893.527	135.501

SEWER RETICULATION LONGITUDINAL SECTION
SCALE A (HOR)
SCALE B (VERT)

ENGINEERING CERTIFICATION
SIGNED: *N. Rozis* DATE: 20. Dec. 16
NAME OF SIGNATORY (PRINT): NICHOLAS ROZIS
RPEQ NUMBER: 7729
COMPANY NAME: BORNHORST+ WARD

A QUU NETWORK ACCESS PERMIT MUST BE OBTAINED FROM THE QUU NETWORK ACCESS TEAM PRIOR TO THE COMMENCEMENT OF WORK ON SITE. FOR FURTHER INFORMATION PLEASE CONTACT QUU NETWORK ACCESS TEAM ON PH: 3856 7033 OR EMAIL: NETWORKACCESS@URBANUTILITIES.COM.AU

CONSTRUCTION INSPECTION NOTIFICATION OF INSPECTIONS MUST BE RECEIVED BY QUEENSLAND URBAN UTILITIES'S AUDIT & COMPLIANCE OFFICER AT LEAST TWO (2) WEEKS PRIOR TO COMMENCEMENT OF CONSTRUCTION. PLEASE CONTACT 0412 436 579

MILD STEEL PIPES
M1 MILD STEEL PIPES AND FITTINGS SHALL COMPLY WITH A.S.1579 AND BE CEMENT LINED IN ACCORDANCE WITH A.S.1281 UNLESS NOTED OTHERWISE.
M2 EXTERNAL COATINGS ON THE PIPES AND FITTINGS SHALL BE FUSION BONDED MEDIUM DENSITY POLYETHYLENE COMPLYING WITH A.S.4321 (SINTAKOTE II).
M3 ALL MILD STEEL FITTINGS (BRANCHES ETC.) TO BE WELDED IN ACCORDANCE WITH THE SEQ WATER SUPPLY AND SEWERAGE DESIGN & CONSTRUCTION CODE (2013).

AS CONSTRUCTED
EYRE CONSTRUCTION SURVEYING PTY LTD
ENGINEERING SURVEYORS Hereby certify that this drawing is a true and accurate representation of the As-constructed works at the time of survey.
I hereby certify that the vertical and horizontal locations and dimensions shown on this plan are a true and correct record and were located by survey
Name: Paul Wild Date: 16/01/18
Signature: *Paul Wild* (S1820)


Paresh Bala DATE: 22. Dec. 16
QUEENSLAND URBAN UTILITIES DELEGATE
(VALID FOR 12 MONTHS FROM DATE SHOWN)

CLIENT: ECONOMIC DEVELOPMENT QUEENSLAND
CONTACT: BORNHORST & WARD
QUU AUDITOR: AUDIT AND COMPLIANCE OFFICER
CONTACT: GREG LOVELOCK 0414 326 408

AS CONSTRUCTED DETAILS FOR AMEND.


I CERTIFY THAT THE "AS CONSTRUCTED" DETAILS SHOWN ON THIS PLAN ARE TRUE AND ACCURATE RECORD OF THE WORKS
SIGNED: *N. Rozis* DATE: 14/04/20
NAME OF SIGNATORY: NICK ROZIS
RPEQ No. or LICENCE: 7729
COMPANY NAME: BORNHORST + WARD PTY LTD
START DATE: 01/02/17 FINISH DATE: 05/02/18

SHEET No. 8 OF 8
QUEENSLAND URBAN UTILITIES DRAWING No. 486/5/9 - 0271 - 008 AMEND. 0

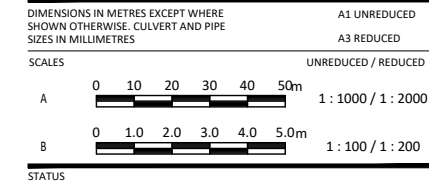

STATUS: **AS CONSTRUCTED**

<p>REV DATE DESCRIPTION</p> <p>03 27.07.18 AS CONSTRUCTED FOR QUU COMMENT</p> <p>02 09.02.17 PIPE DETAIL AMENDED</p> <p>01 20.12.16 FOR CONSTRUCTION</p> <p>F 31.08.16 ISSUE FOR TENDER</p> <p>F 31.03.16 ISSUE FOR TENDER</p>	<p>ASSOCIATED CONSULTANTS</p> <p>APPROVED: <i>N. Rozis</i> 7729 RPEQ</p> <p>CHECKED: <i>K. Rensch</i></p> <p>DATE: 22/12/16</p>	<p>APPROVED</p> <p>CHECKED</p> <p>DATE: 22/12/16</p>	<p>BORNHORST + WARD</p> <p>CONSULTING ENGINEERS</p> <p>CIVIL AND STRUCTURAL</p> <p>Level 4, 67 Astor Terrace Spring Hill, QLD 4000, Australia P: +61 (7) 3013 4699 mail@bornhorstward.com.au www.bornhorstward.com.au</p>	<p>CLIENT: ECONOMIC DEVELOPMENT QUEENSLAND (EDQ)</p>	<p>PROJECT: REMORA ROAD ROADWORKS NORTHSHORE HAMILTON</p>	<p>SUBJECT: SEWER RETICULATION LONGITUDINAL SECTIONS</p>	<p>PROJECT No. 12191C</p> <p>DRAWING No. P3-51-C0620</p> <p>REVISION 03</p>
--	---	--	---	--	---	--	---

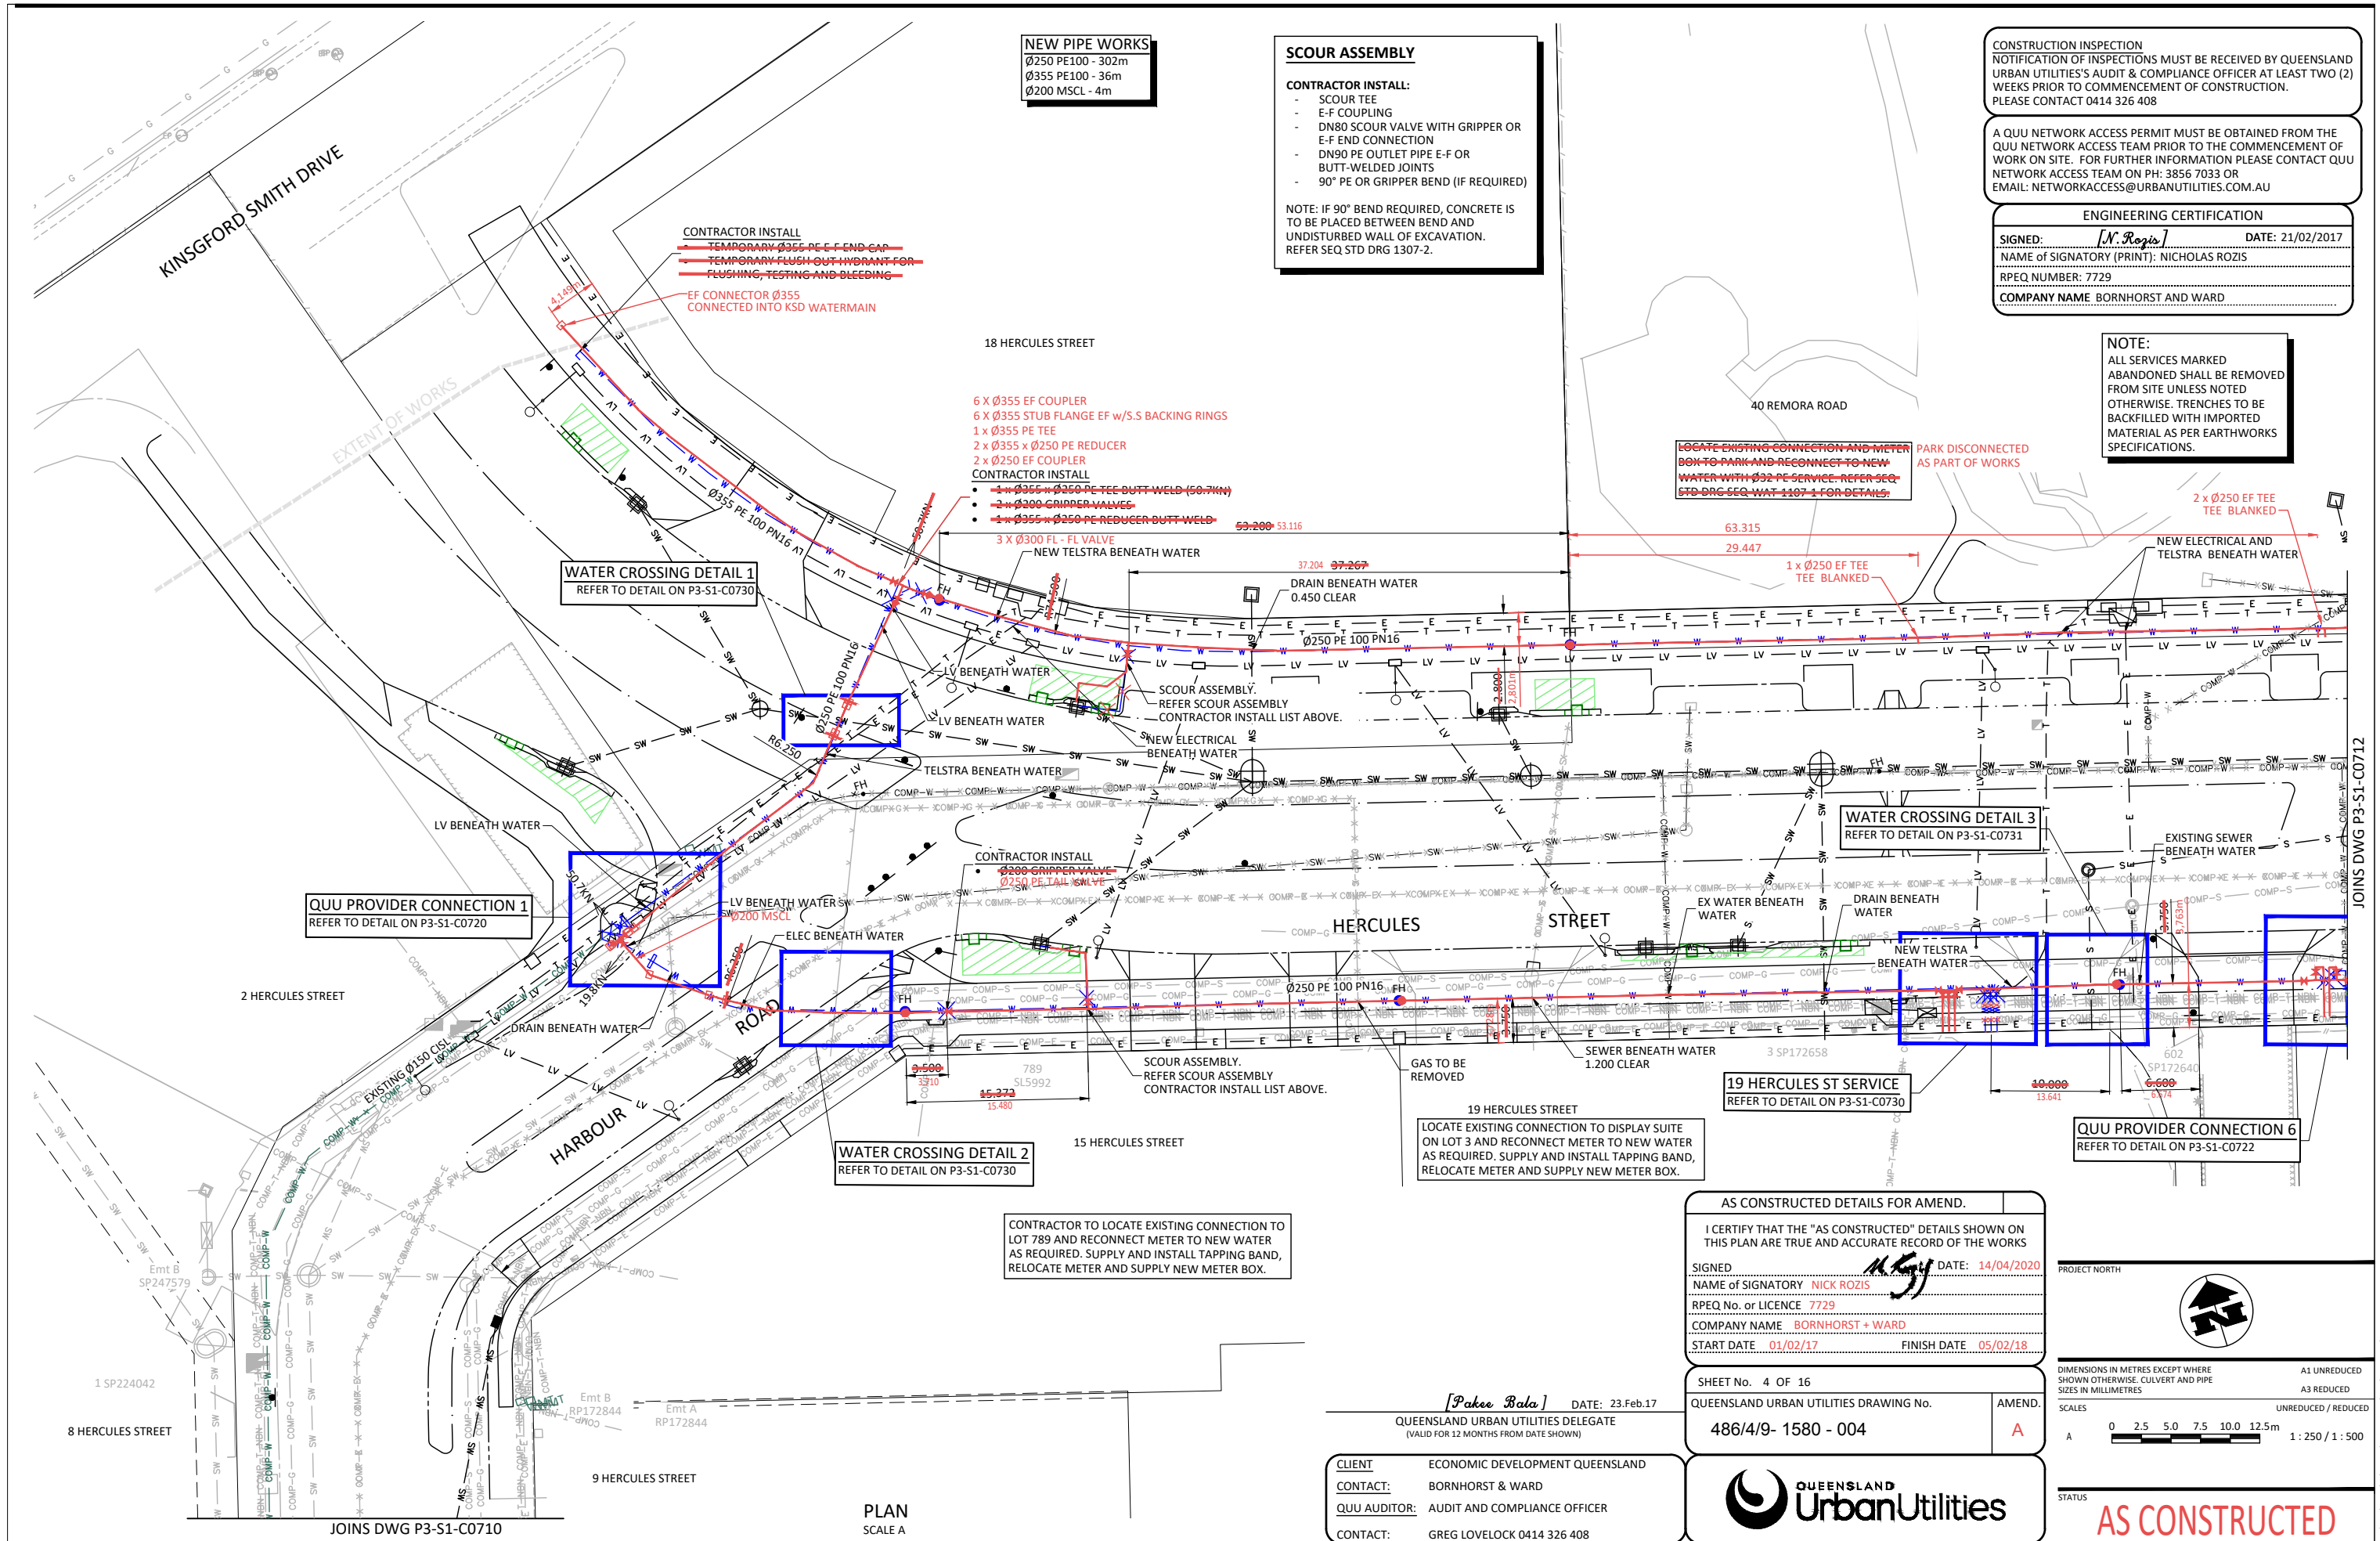

NEW PIPE WORKS
 - Ø250 PE100 - 302m
 - Ø355 PE100 - 36m
 - Ø200 MSCL - 4m

SCOUR ASSEMBLY
CONTRACTOR INSTALL:
 - SCOUR TEE
 - E-F COUPLING
 - DN80 SCOUR VALVE WITH GRIPPER OR E-F END CONNECTION
 - DN90 PE OUTLET PIPE E-F OR BUTT-WELDED JOINTS
 - 90° PE OR GRIPPER BEND (IF REQUIRED)
 NOTE: IF 90° BEND REQUIRED, CONCRETE IS TO BE PLACED BETWEEN BEND AND UNDISTURBED WALL OF EXCAVATION. REFER SEQ STD DRG 1307-2.

CONSTRUCTION INSPECTION NOTIFICATION OF INSPECTIONS MUST BE RECEIVED BY QUEENSLAND URBAN UTILITIES'S AUDIT & COMPLIANCE OFFICER AT LEAST TWO (2) WEEKS PRIOR TO COMMENCEMENT OF CONSTRUCTION. PLEASE CONTACT 0414 326 408

A QUU NETWORK ACCESS PERMIT MUST BE OBTAINED FROM THE QUU NETWORK ACCESS TEAM PRIOR TO THE COMMENCEMENT OF WORK ON SITE. FOR FURTHER INFORMATION PLEASE CONTACT QUU NETWORK ACCESS TEAM ON PH: 3856 7033 OR EMAIL: NETWORKACCESS@URBANUTILITIES.COM.AU

ENGINEERING CERTIFICATION
 SIGNED: [N. Rozis] DATE: 21/02/2017
 NAME OF SIGNATORY (PRINT): NICHOLAS ROZIS
 RPEQ NUMBER: 7729
 COMPANY NAME: BORNHORST AND WARD

NOTE:
 ALL SERVICES MARKED ABANDONED SHALL BE REMOVED FROM SITE UNLESS NOTED OTHERWISE. TRENCHES TO BE BACKFILLED WITH IMPORTED MATERIAL AS PER EARTHWORKS SPECIFICATIONS.

CONTRACTOR INSTALL
 - TEMPORARY Ø355 PE E-F END CAP
 - TEMPORARY FLUSH OUT HYDRANT FOR FLUSHING, TESTING AND BLEEDING
 - EF CONNECTOR Ø355 CONNECTED INTO KSD WATERMAIN

6 X Ø355 EF COUPLER
 6 X Ø355 STUB FLANGE EF W/S BACKING RINGS
 1 X Ø355 PE TEE
 2 X Ø355 X Ø250 PE REDUCER
 2 X Ø250 EF COUPLER
CONTRACTOR INSTALL
 - 1 X Ø355 X Ø250 PE TEE BUTT WELD (50.7MM)
 - 2 X Ø300 GRIPPER VALVES
 - 1 X Ø355 X Ø250 PE REDUCER BUTT WELD
 3 X Ø300 FL - FL VALVE
 NEW TELSTRA BENEATH WATER

LOCATE EXISTING CONNECTION AND METER BOX TO PARK AND RECONNECT TO NEW WATER WITH Ø32 PE SERVICE. REFER SEQ STD DRG SEQ WAT-1107-1 FOR DETAILS.

WATER CROSSING DETAIL 1
 REFER TO DETAIL ON P3-S1-C0730

WATER CROSSING DETAIL 3
 REFER TO DETAIL ON P3-S1-C0731

QUU PROVIDER CONNECTION 1
 REFER TO DETAIL ON P3-S1-C0720

WATER CROSSING DETAIL 2
 REFER TO DETAIL ON P3-S1-C0730

QUU PROVIDER CONNECTION 6
 REFER TO DETAIL ON P3-S1-C0722


CONTRACTOR TO LOCATE EXISTING CONNECTION TO LOT 789 AND RECONNECT METER TO NEW WATER AS REQUIRED. SUPPLY AND INSTALL TAPPING BAND, RELOCATE METER AND SUPPLY NEW METER BOX.

19 HERCULES ST SERVICE
 REFER TO DETAIL ON P3-S1-C0730
 LOCATE EXISTING CONNECTION TO DISPLAY SUITE ON LOT 3 AND RECONNECT METER TO NEW WATER AS REQUIRED. SUPPLY AND INSTALL TAPPING BAND, RELOCATE METER AND SUPPLY NEW METER BOX.

AS CONSTRUCTED DETAILS FOR AMEND.
 I CERTIFY THAT THE "AS CONSTRUCTED" DETAILS SHOWN ON THIS PLAN ARE TRUE AND ACCURATE RECORD OF THE WORKS
 SIGNED: [Signature] DATE: 14/04/2020
 NAME OF SIGNATORY: NICK ROZIS
 RPEQ No. or LICENCE: 7729
 COMPANY NAME: BORNHORST + WARD
 START DATE: 01/02/17 FINISH DATE: 05/02/18

SHEET No. 4 OF 16
 QUEENSLAND URBAN UTILITIES DRAWING No. 486/4/9- 1580 - 004
 AMEND. A

CLIENT: ECONOMIC DEVELOPMENT QUEENSLAND
CONTACT: BORNHORST & WARD
QUU AUDITOR: AUDIT AND COMPLIANCE OFFICER
CONTACT: GREG LOVELOCK 0414 326 408

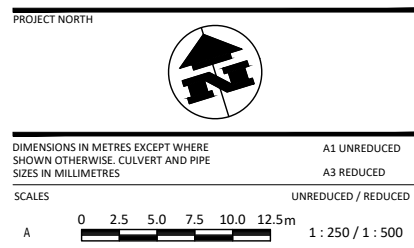

AS CONSTRUCTED


REV	DATE	DESCRIPTION	DWN	DES	CHK	APP
02	06.06.19	AS CONSTRUCTED	HA	KR	NR	NR
01	21.02.17	FOR CONSTRUCTION				
G	17.02.17	QUU REVIEW SET				
F	19.12.16	FOR INFORMATION				
F	31.08.16	ISSUE FOR TENDER				

ASSOCIATED CONSULTANTS	APPROVED	CHECKED
BORNHORST + WARD CONSULTING ENGINEERS CIVIL AND STRUCTURAL	N.ROZIS 7729 RPEQ	K.RENSCH
Level 4, 67 Astor Terrace Spring Hill, QLD 4000, Australia P. +61 (7) 3013 4699 mail@bornhorstward.com.au www.bornhorstward.com.au	DATE 21-02-17	DATE 21-02-17

CLIENT	PROJECT	SUBJECT	PROJECT No.
ECONOMIC DEVELOPMENT QUEENSLAND	REMORA ROAD ROADWORKS NORTHSHORE HAMILTON	WATER RETICULATION LAYOUT SHEET 2	12191C
DATE: 23.Feb.17 QUEENSLAND URBAN UTILITIES DELEGATE (VALID FOR 12 MONTHS FROM DATE SHOWN)			DRAWING No. P3-S1-C0711 REVISION 02

WATER CROSSING 1

- CONTRACTOR INSTALL:**
- 4 x Ø200 45° MSCL BUTT WELD BENDS
 - 2 x Ø200 LOOSE FLANGES
 - 2 x Ø250 PE FULL FACE FLANGES WITH S/S STEEL BACKING RINGS
 - 2.4m Ø200 MSCL PIPE

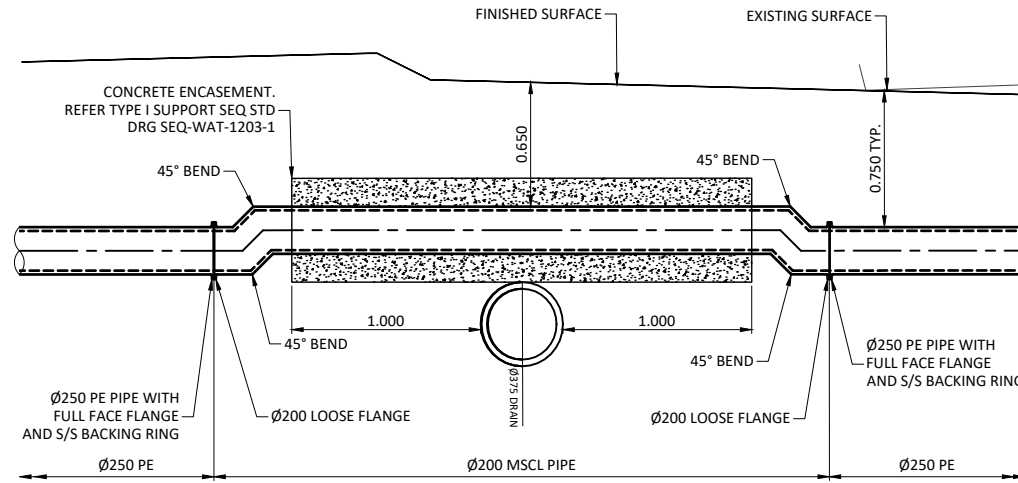


WATER CROSSING DETAIL 1
SCALE A

NOTE:
CONFIRM ALL SERVICE DEPTHS ON SITE
PRIOR TO COMMENCEMENT OF WORKS


WATER CROSSING 2

- CONTRACTOR INSTALL:**
- 2 x Ø200 LOOSE FLANGE
 - 2 x Ø250 PE FULL FACE FLANGES WITH S/S STEEL BACKING RINGS
 - 2.1m Ø200 MSCL PIPE

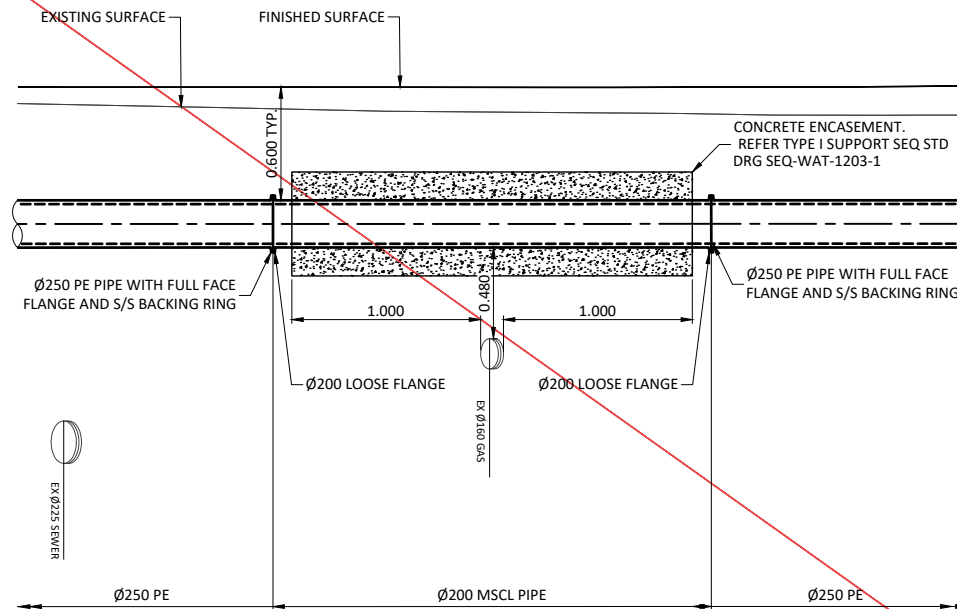

WATER CROSSING DETAIL 2
SCALE A


NOT REQUIRED - SUFFICIENT COVER OVER THE GAS

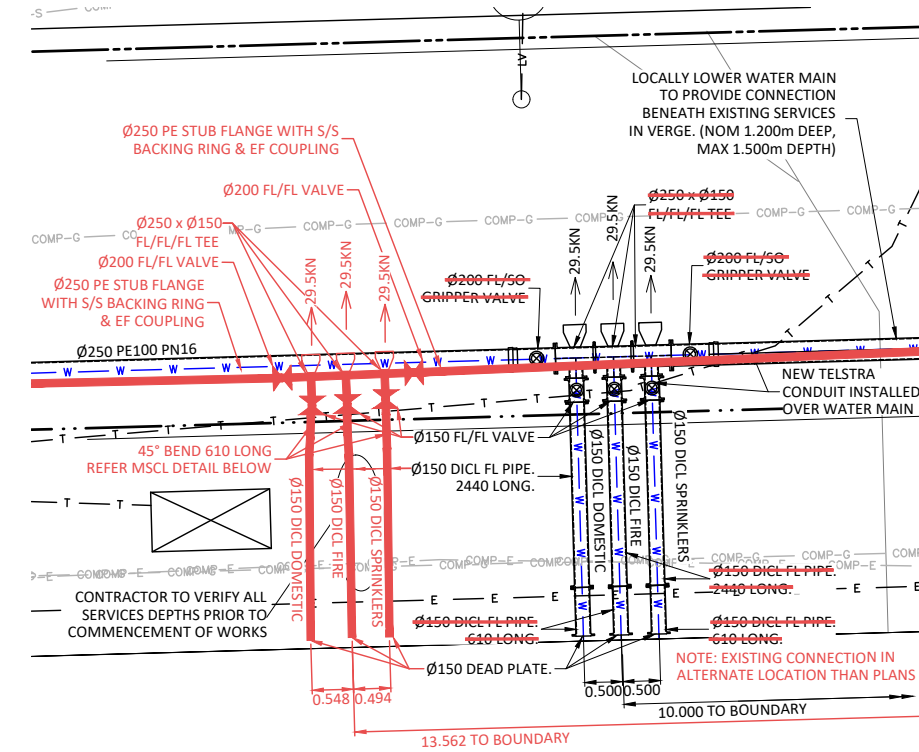

19 HERCULES STREET WATER SERVICE
SCALE A

WATER SERVICE

- CONTRACTOR INSTALL:**
- 3 x Ø150 DEAD PLATE
 - 3 x Ø150 DI CL FL PIPE 610 LONG
 - 3 x Ø150 DI CL FL PIPE 2440 LONG
 - 3 x Ø150 FL/FL VALVE
 - 2 x Ø200 FL/50 GRIPPER VALVE
 - 3 x Ø250 x Ø150 FL/FL TEE
 - 3 x Ø150 MSCL FL PIPE 610 LONG
 - 2 x Ø200 FL/FL VALVE
 - 6 x Ø150 45° MSCL BUTT WELD BENDS
 - 2 x Ø200 FL-SP ADAPTOR
 - 6 x LOOSE FLANGES
 - 2 x Ø250 EF COUPLING
 - 2 x Ø250 PE STUB FLANGES WITH S/S BACKING RING

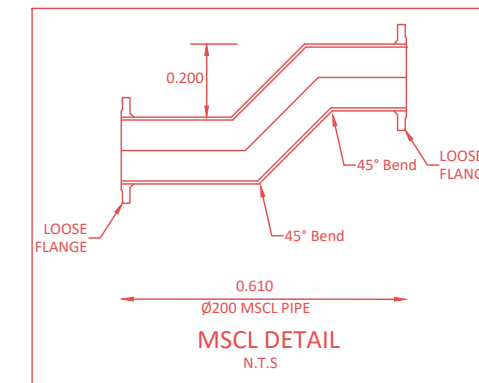


[Pakee Bala] DATE: 23.Feb.17

QUEENSLAND URBAN UTILITIES DELEGATE
(VALID FOR 12 MONTHS FROM DATE SHOWN)

CLIENT ECONOMIC DEVELOPMENT QUEENSLAND
CONTACT: BORNHORST & WARD
QUU AUDITOR: AUDIT AND COMPLIANCE OFFICER
CONTACT: GREG LOVELOCK 0414 326 408

AS CONSTRUCTED DETAILS FOR AMEND.
I CERTIFY THAT THE "AS CONSTRUCTED" DETAILS SHOWN ON THIS PLAN ARE TRUE AND ACCURATE RECORD OF THE WORKS
SIGNED: [Signature] DATE: 14/04/2020
NAME OF SIGNATORY: NICK ROZIS
RPEQ No. or LICENCE: 7729
COMPANY NAME: BORNHORST + WARD
START DATE: 01/02/17 **FINISH DATE:** 05/02/18

SHEET No. 14 OF 16
QUEENSLAND URBAN UTILITIES DRAWING No. 486/4/9 - 1580 - 014 **AMEND.** A

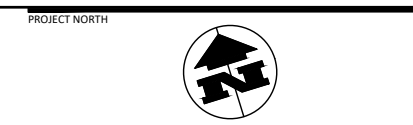

CONSTRUCTION INSPECTION
NOTIFICATION OF INSPECTIONS MUST BE RECEIVED BY QUEENSLAND URBAN UTILITIES'S AUDIT & COMPLIANCE OFFICER AT LEAST TWO (2) WEEKS PRIOR TO COMMENCEMENT OF CONSTRUCTION. PLEASE CONTACT 0414 326 408

A QUU NETWORK ACCESS PERMIT MUST BE OBTAINED FROM THE QUU NETWORK ACCESS TEAM PRIOR TO THE COMMENCEMENT OF WORK ON SITE. FOR FURTHER INFORMATION PLEASE CONTACT QUU NETWORK ACCESS TEAM ON PH: 3856 7033 OR EMAIL: NETWORKACCESS@URBANUTILITIES.COM.AU

ENGINEERING CERTIFICATION
SIGNED: [Signature] **DATE:** 21/02/2017
NAME OF SIGNATORY (PRINT): NICHOLAS ROZIS
RPEQ NUMBER: 7729
COMPANY NAME: BORNHORST AND WARD

STATUS
AS CONSTRUCTED

REV	DATE	DESCRIPTION	DWN	DES	CHK	APP
02	06.06.19	AS CONSTRUCTED				
01	21.02.17	FOR CONSTRUCTED				
F	17.02.17	QUU REVIEW SET				
E	19.12.16	FOR INFORMATION				
D	31.08.16	ISSUE FOR TENDER				

DATE	APPROVED	CHECKED
21-02-17	N.ROZIS	K.RENSCH

DATE	APPROVED	CHECKED
21-02-17	N.ROZIS	K.RENSCH

BORNHORST + WARD
CONSULTING ENGINEERS
CIVIL AND STRUCTURAL
Level 4, 67 Astor Terrace
Spring Hill, QLD 4000, Australia
P. +61 (7) 3013 4699
mail@bornhorstward.com.au
www.bornhorstward.com.au

CLIENT
ECONOMIC DEVELOPMENT QUEENSLAND (EDQ)

PROJECT
REMORA ROAD ROADWORKS
NORTHSHORE HAMILTON

SUBJECT
WATER RETICULATION
DETAILS SHEET 1

PROJECT No. 12191C
DRAWING No. P3-S1-C0730
REVISION 02

All underground cables shall be treated as being energised. Where a cable is located that is not represented on the ENERGEX EnerGISE DBYD map, then ENERGEX shall be contacted immediately.

For Emergency Situations
Please call 13 19 62



**EnerGISE
DBYD**

Date: 16 Nov 20 Time: 12.11.42
Requested By: DBYD


NOT TO SCALE



Enquiry No: 103924029

KEY MAP

 Enquiry Area

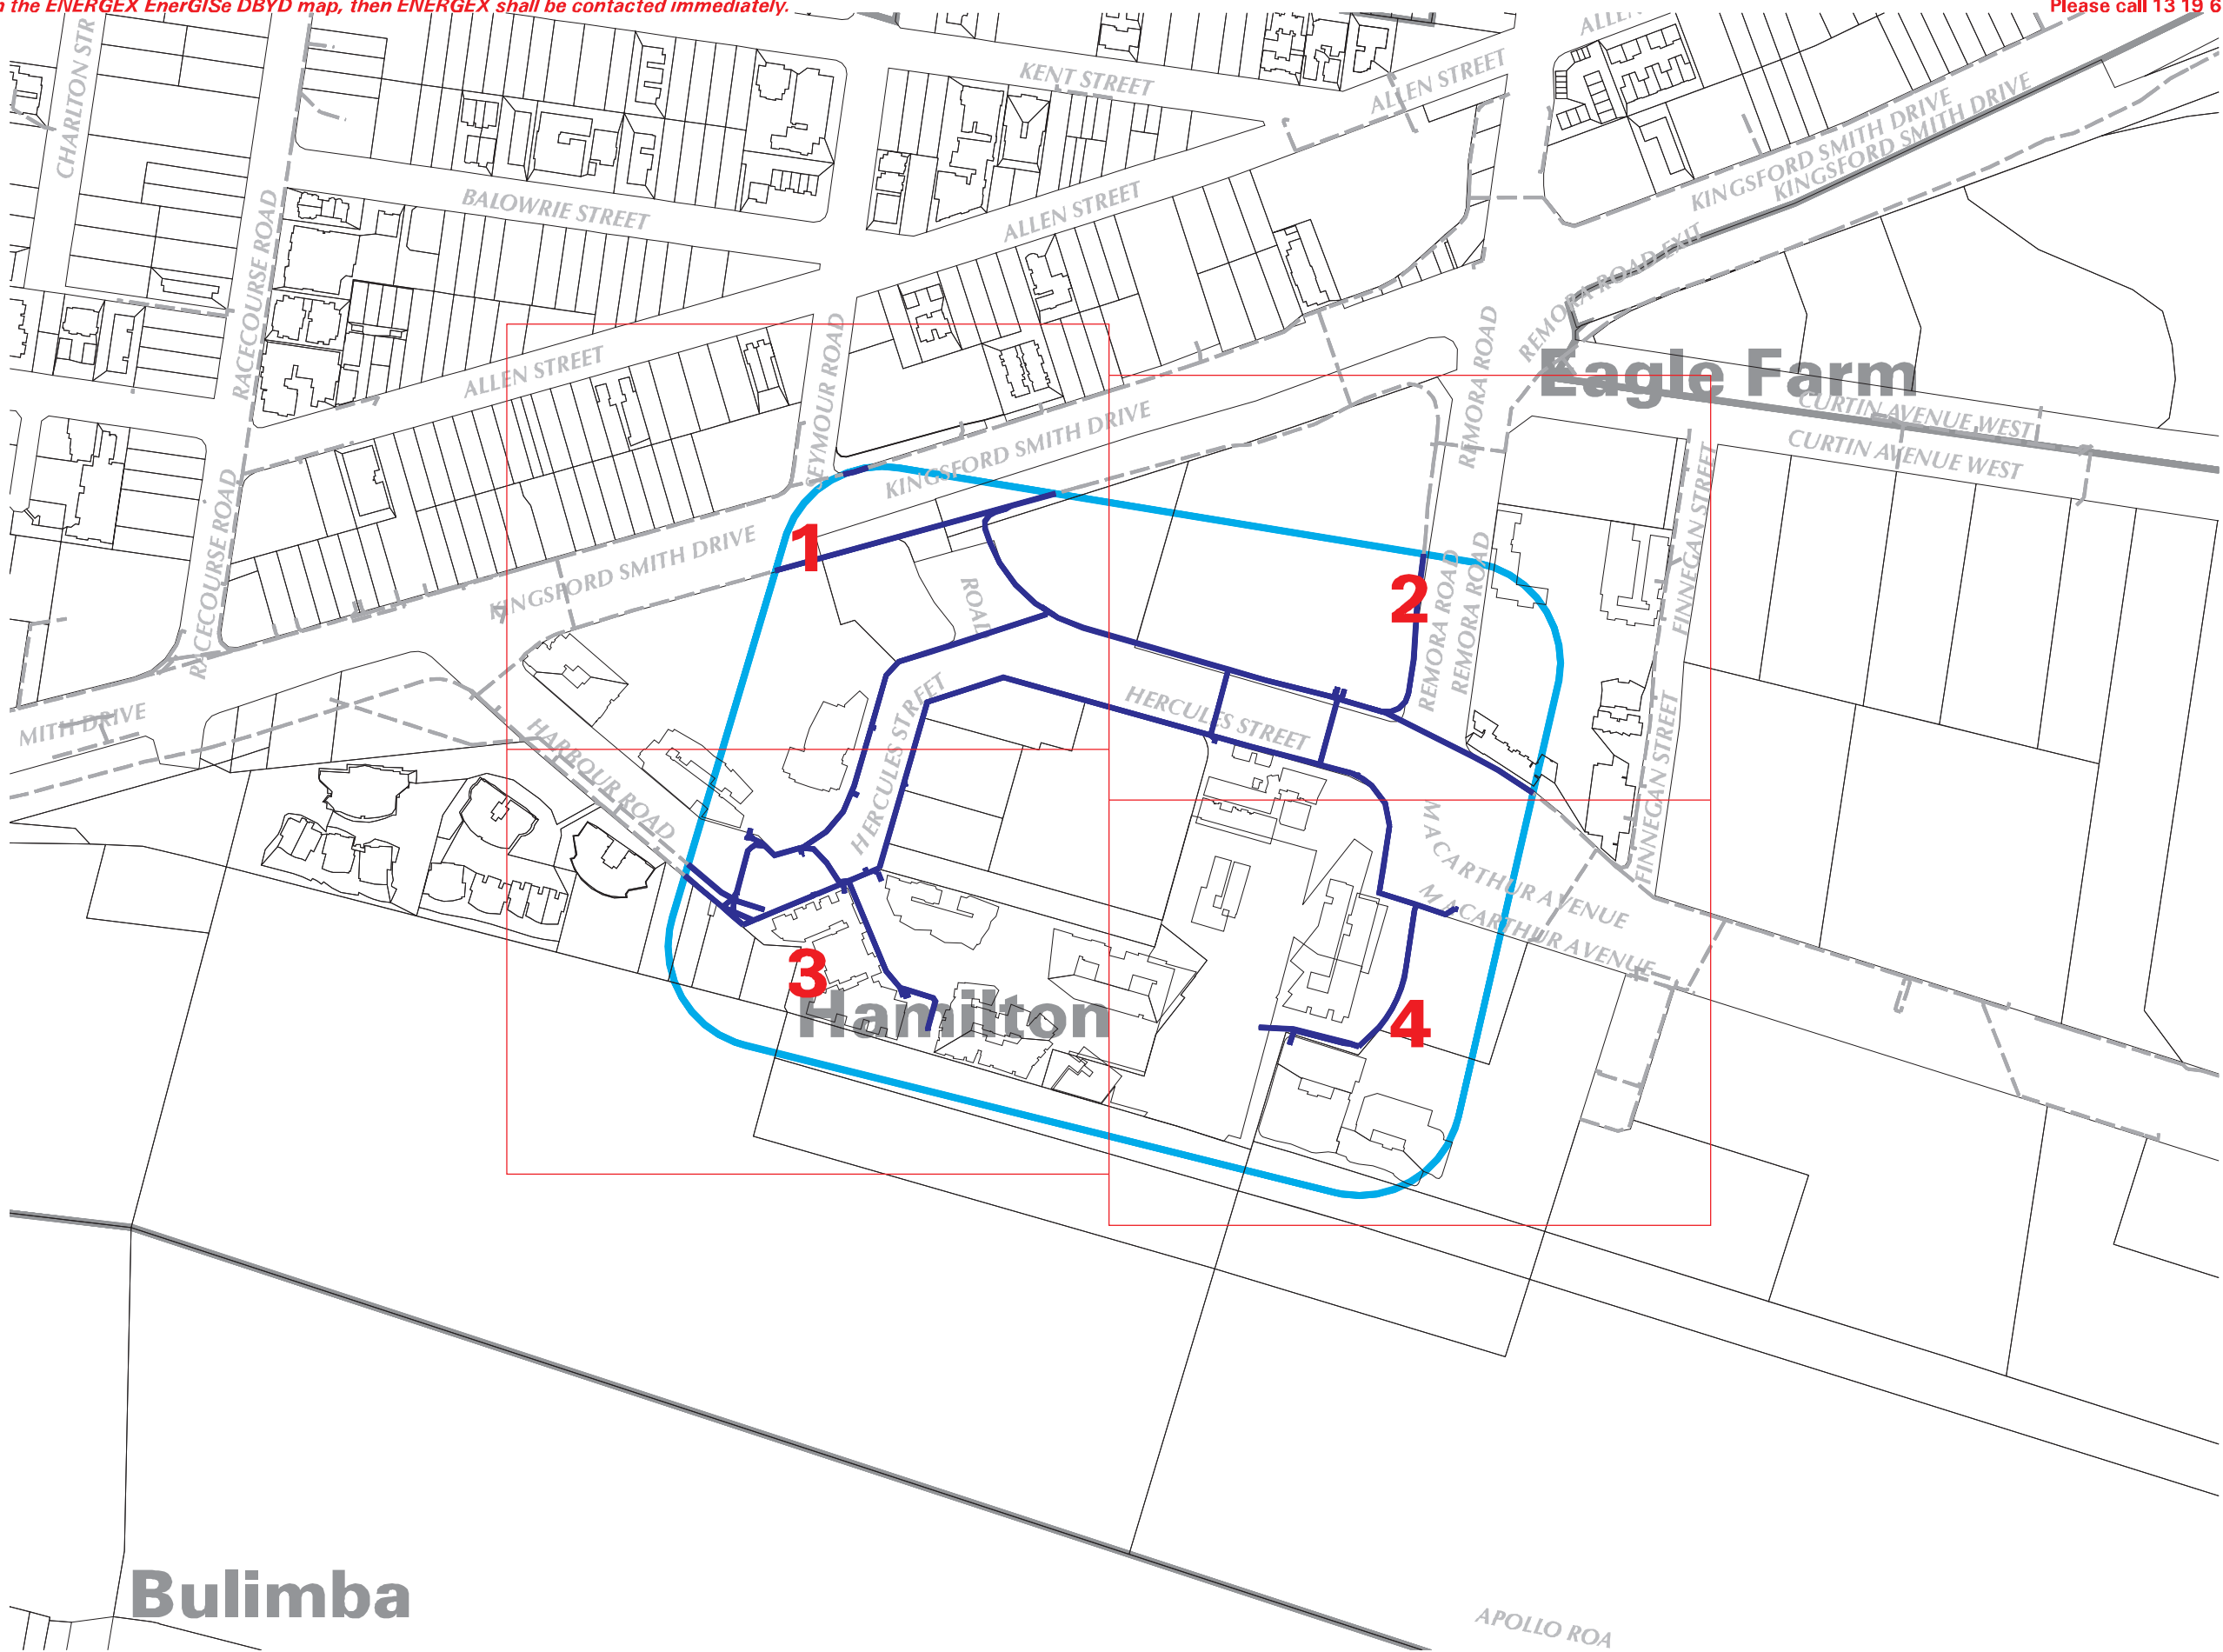


Bulimba

This output provides details of the ENERGEX electrical network. As variations may exist no responsibility is incurred by ENERGEX for the accuracy or completeness of the information provided. Exact positions of cables and electrical connectivity should be confirmed on site.

UNCONTROLLED COPY

LOCALITY DIAGRAM

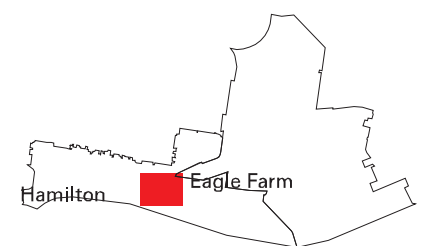

All underground cables shall be treated as being energised. Where a cable is located that is not represented on the ENERGEX EnerGISE DBYD map, then ENERGEX shall be contacted immediately.

For Emergency Situations
Please call 13 19 62



**EnerGISE
DBYD**

Date: 16 Nov 20 Time: 12.12.23
Requested By: DBYD

SCALE 1:1000




Enquiry No: 103924029

STRIP No: 2


- | | | | |
|--|-------------------------------------|--|------------------------------|
| | Ground Transformer | | Cable Voltage Less Than 33kV |
| | Cubicle Transformer | | Cable Voltage 33kV or Higher |
| | Ring Main Unit | | Direct-Lay Cable |
| | Metering Unit | | Conduit |
| | Link Pillar | | Multi-Section Duct |
| | Service Pillar | | Trench |
| | Junction Pillar | | Cable Tray |
| | Pit | | Tunnel |
| | Cable Joint | | |
| | Cable Termination | | |
| | Cable Marker | | |
| | Street Light Pole | | |
| | Earth | | |
| | Planned Work labelled by Work Order | | |



INDEX TO SHEETS

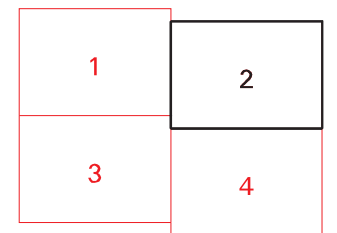

LOCALITY DIAGRAM

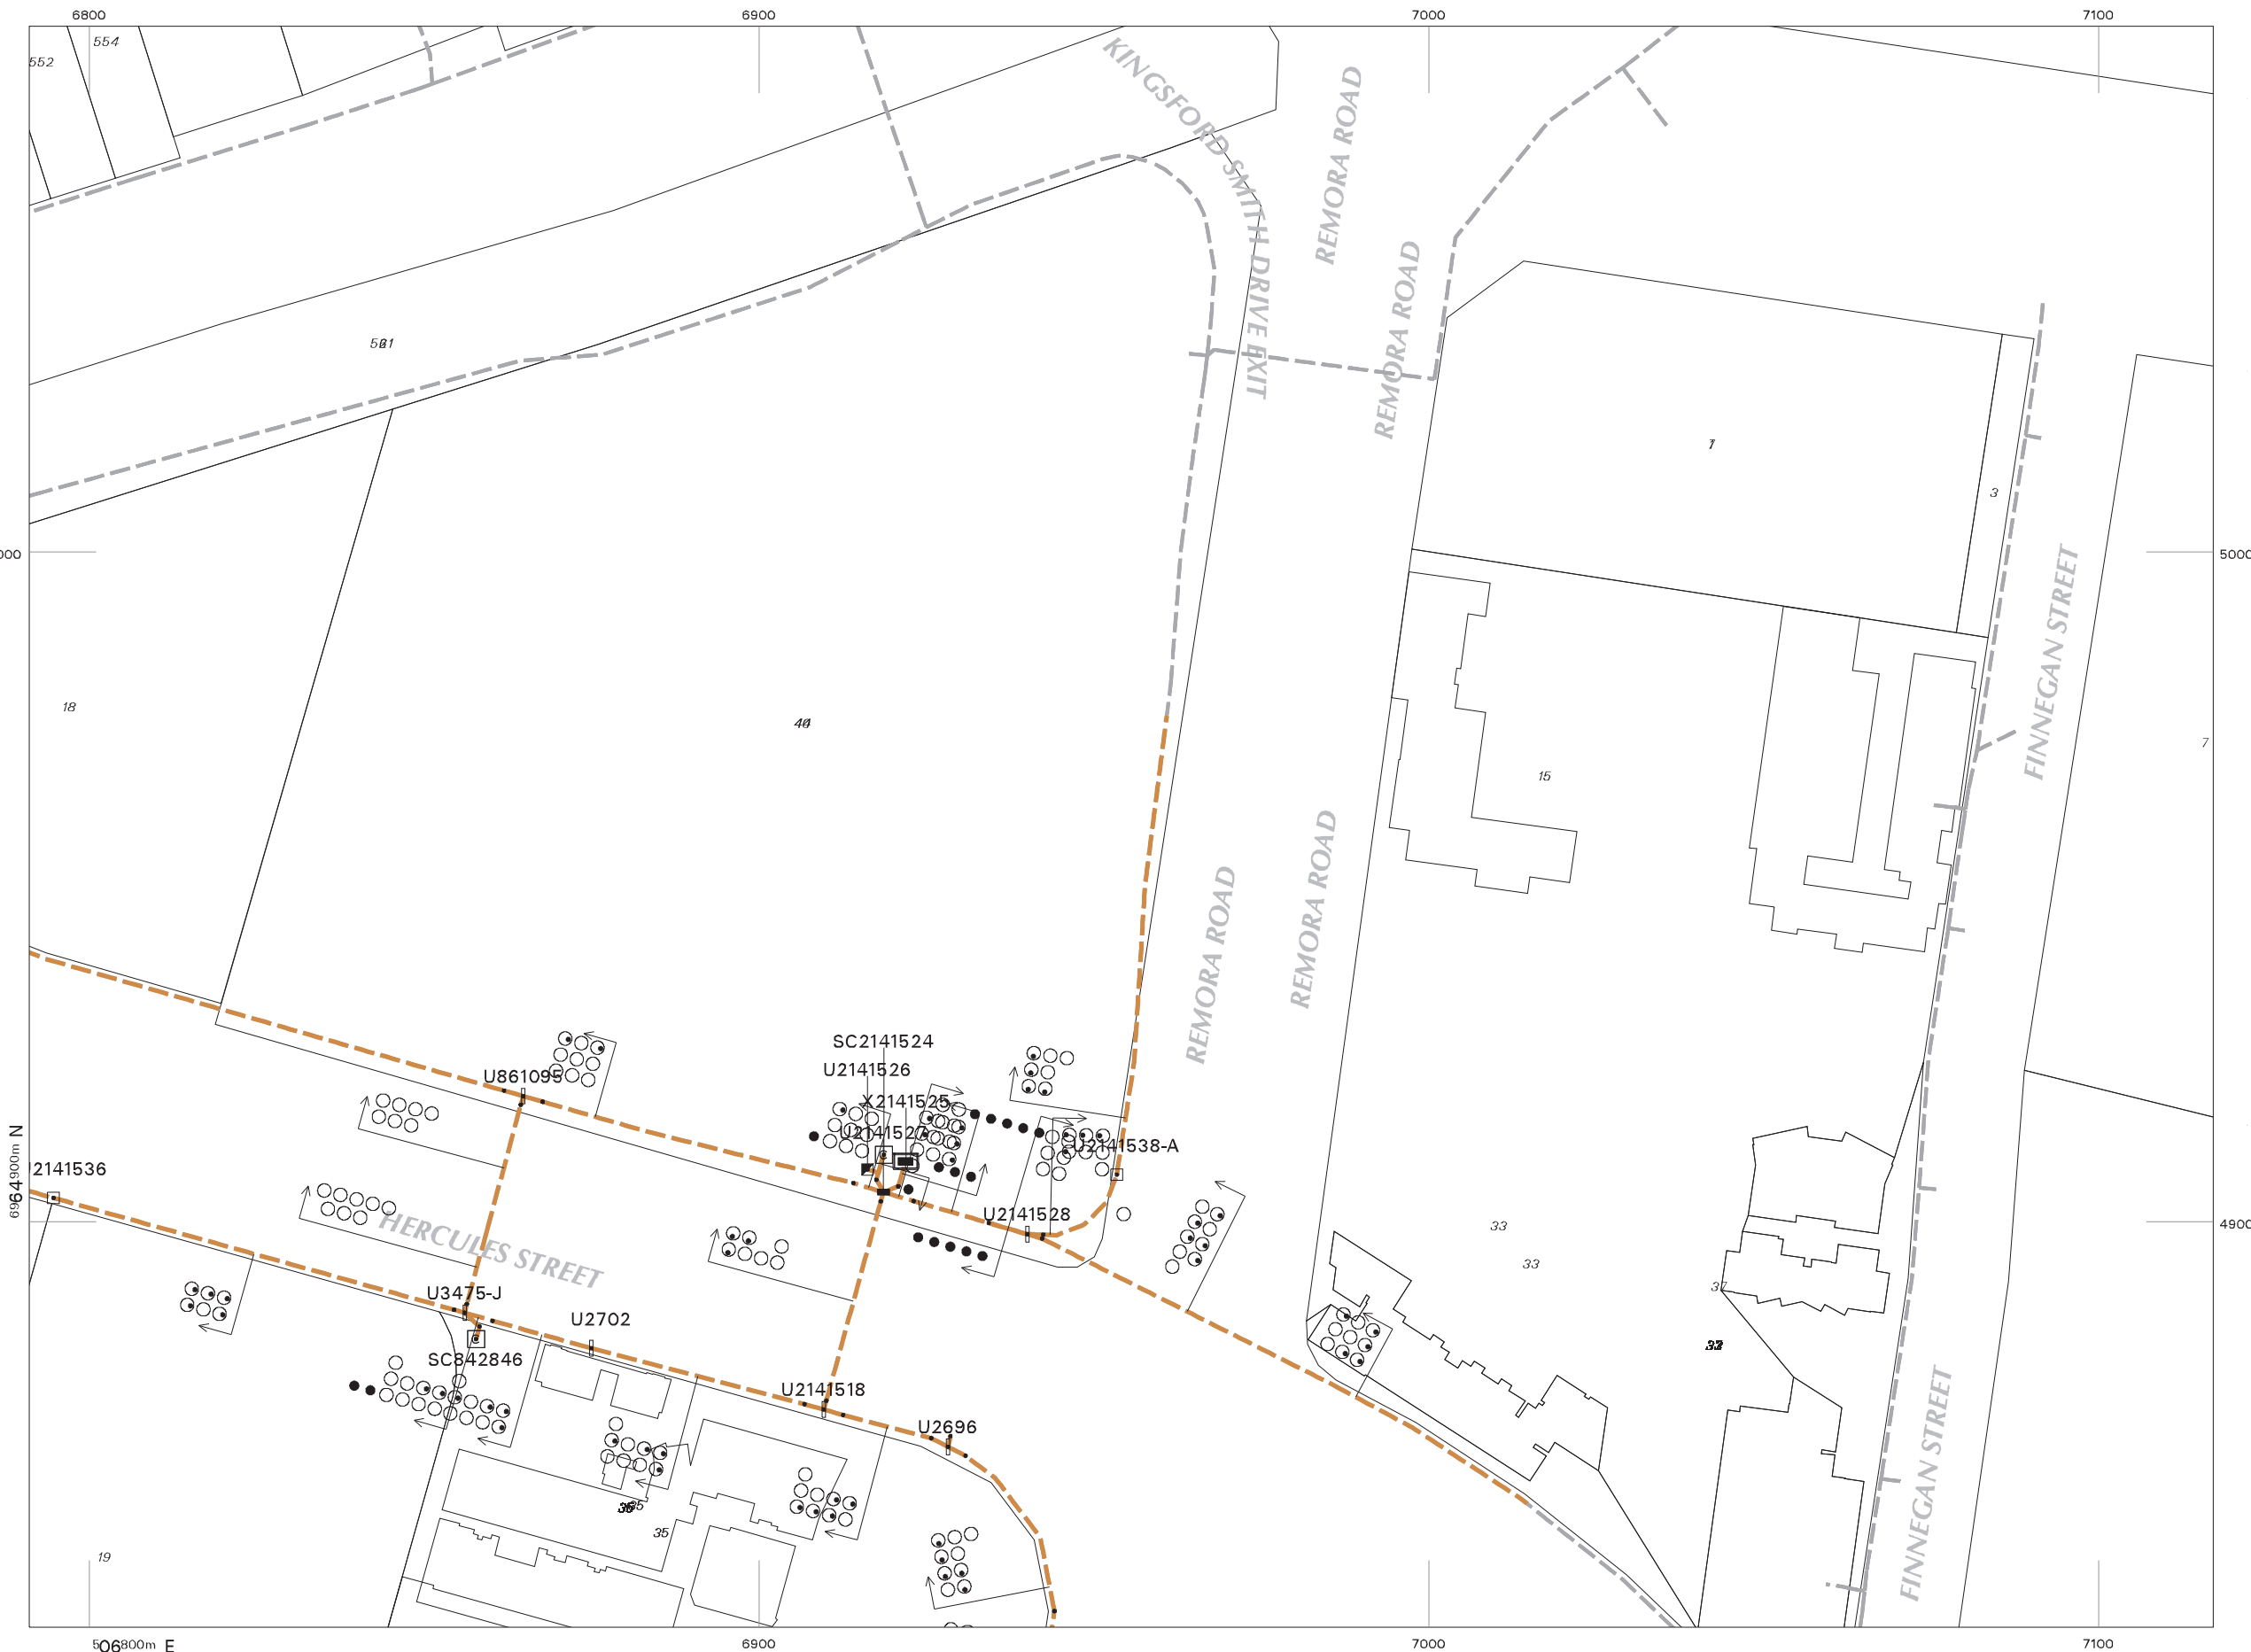


This output provides details of the ENERGEX electrical network. As variations may exist no responsibility is incurred by ENERGEX for the accuracy or completeness of the information provided. Exact positions of cables and electrical connectivity should be confirmed on site.

UNCONTROLLED COPY

Cable Plan



SPORT AREA

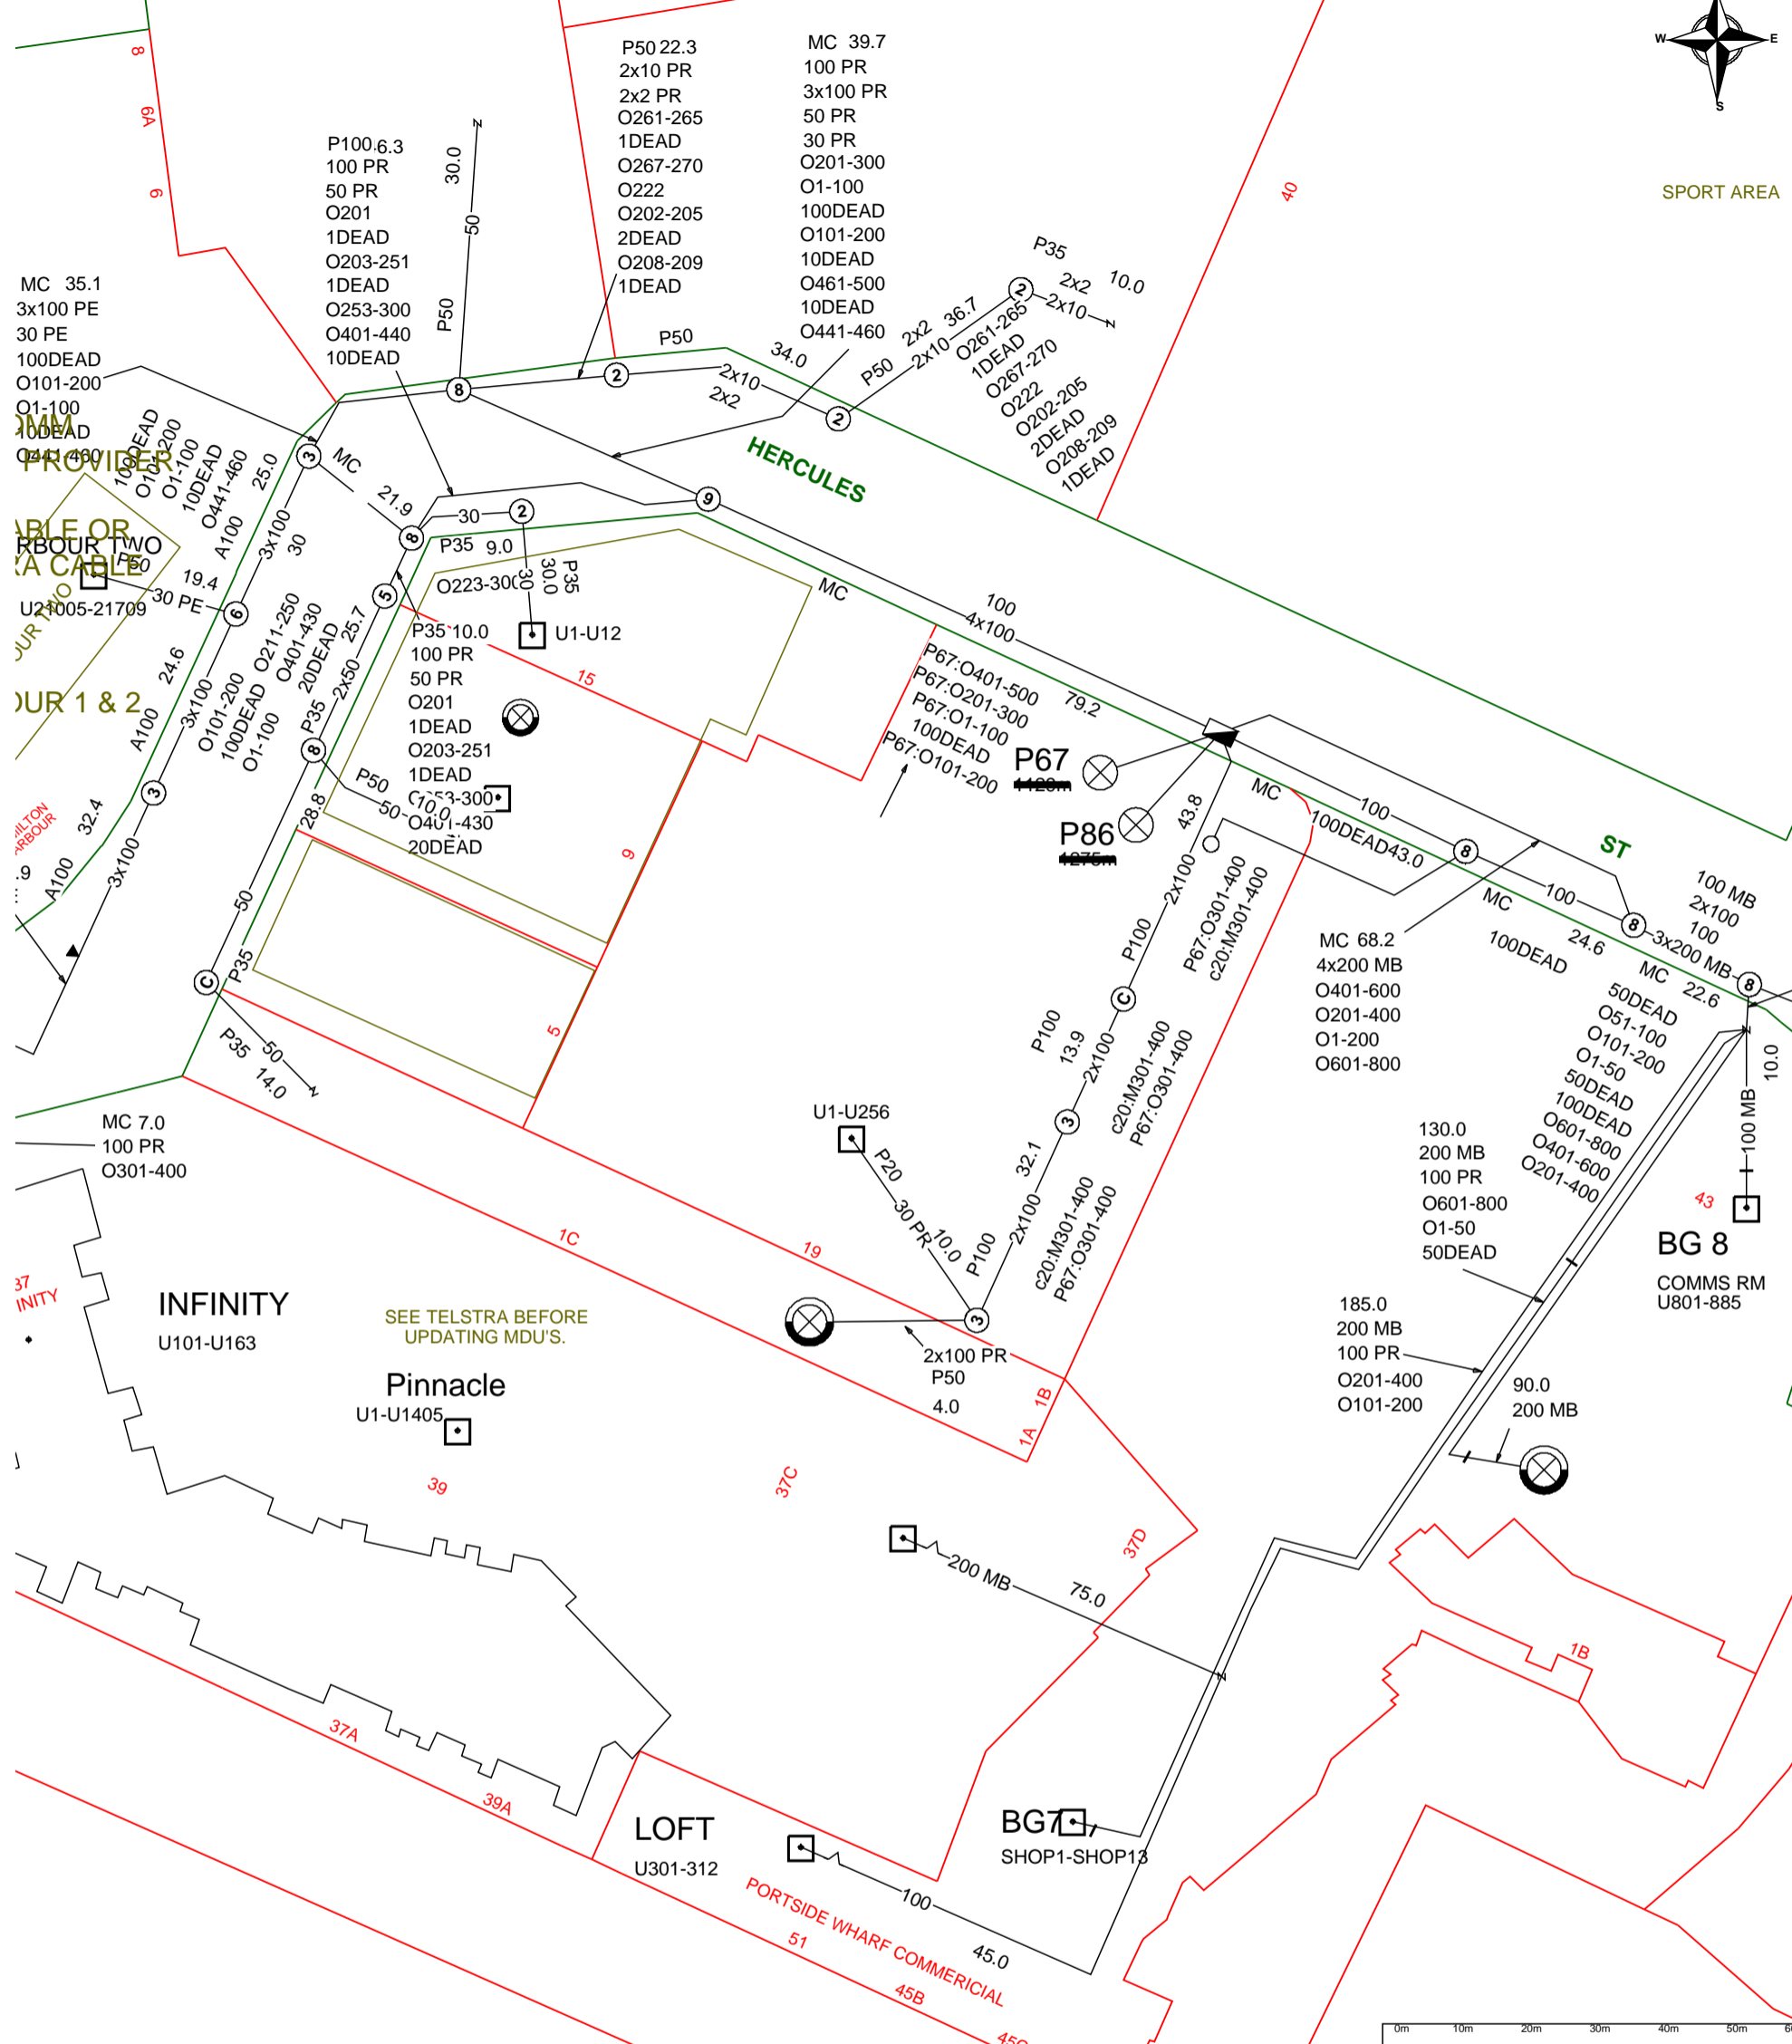

For all Telstra DBYD plan enquiries - email - Telstra.Plans@team.telstra.com
For urgent onsite contact only - ph 1800 653 935 (bus hrs)

Sequence Number: 34383544

CAUTION: Fibre optic and/ or major network present in plot area. Please read the Duty of Care and contact Telstra Plan Services should you require any assistance.

TELSTRA CORPORATION LIMITED A.C.N. 051 775 556

Generated On 06/06/2014 09:37:20

The above plan must be viewed in conjunction with the Mains Cable Plan on the following page


WARNING - Due to the nature of Telstra underground plant and the age of some cables and records, it is impossible to ascertain the precise location of all Telstra plant from Telstra's plans. The accuracy and/or completeness of the information supplied can not be guaranteed as property boundaries, depths and other natural landscape features may change over time, and accordingly the plans are indicative only. Telstra does not warrant or hold out that its plans are accurate and accepts no responsibility for any inaccuracy shown on the plans.

It is your responsibility to locate Telstra's underground plant by careful hand pot-holing prior to any excavation in the vicinity and to exercise due care during that excavation.

Please read and understand the information supplied in the duty of care statement attached with the Telstra plans. TELSTRA WILL SEEK COMPENSATION FOR LOSS CAUSED BY DAMAGE TO ITS PLANT.

Telstra plans and information supplied are valid for 60 days from the date of issue. If this timeframe has elapsed, please reapply for plans.

Mains Cable Plan

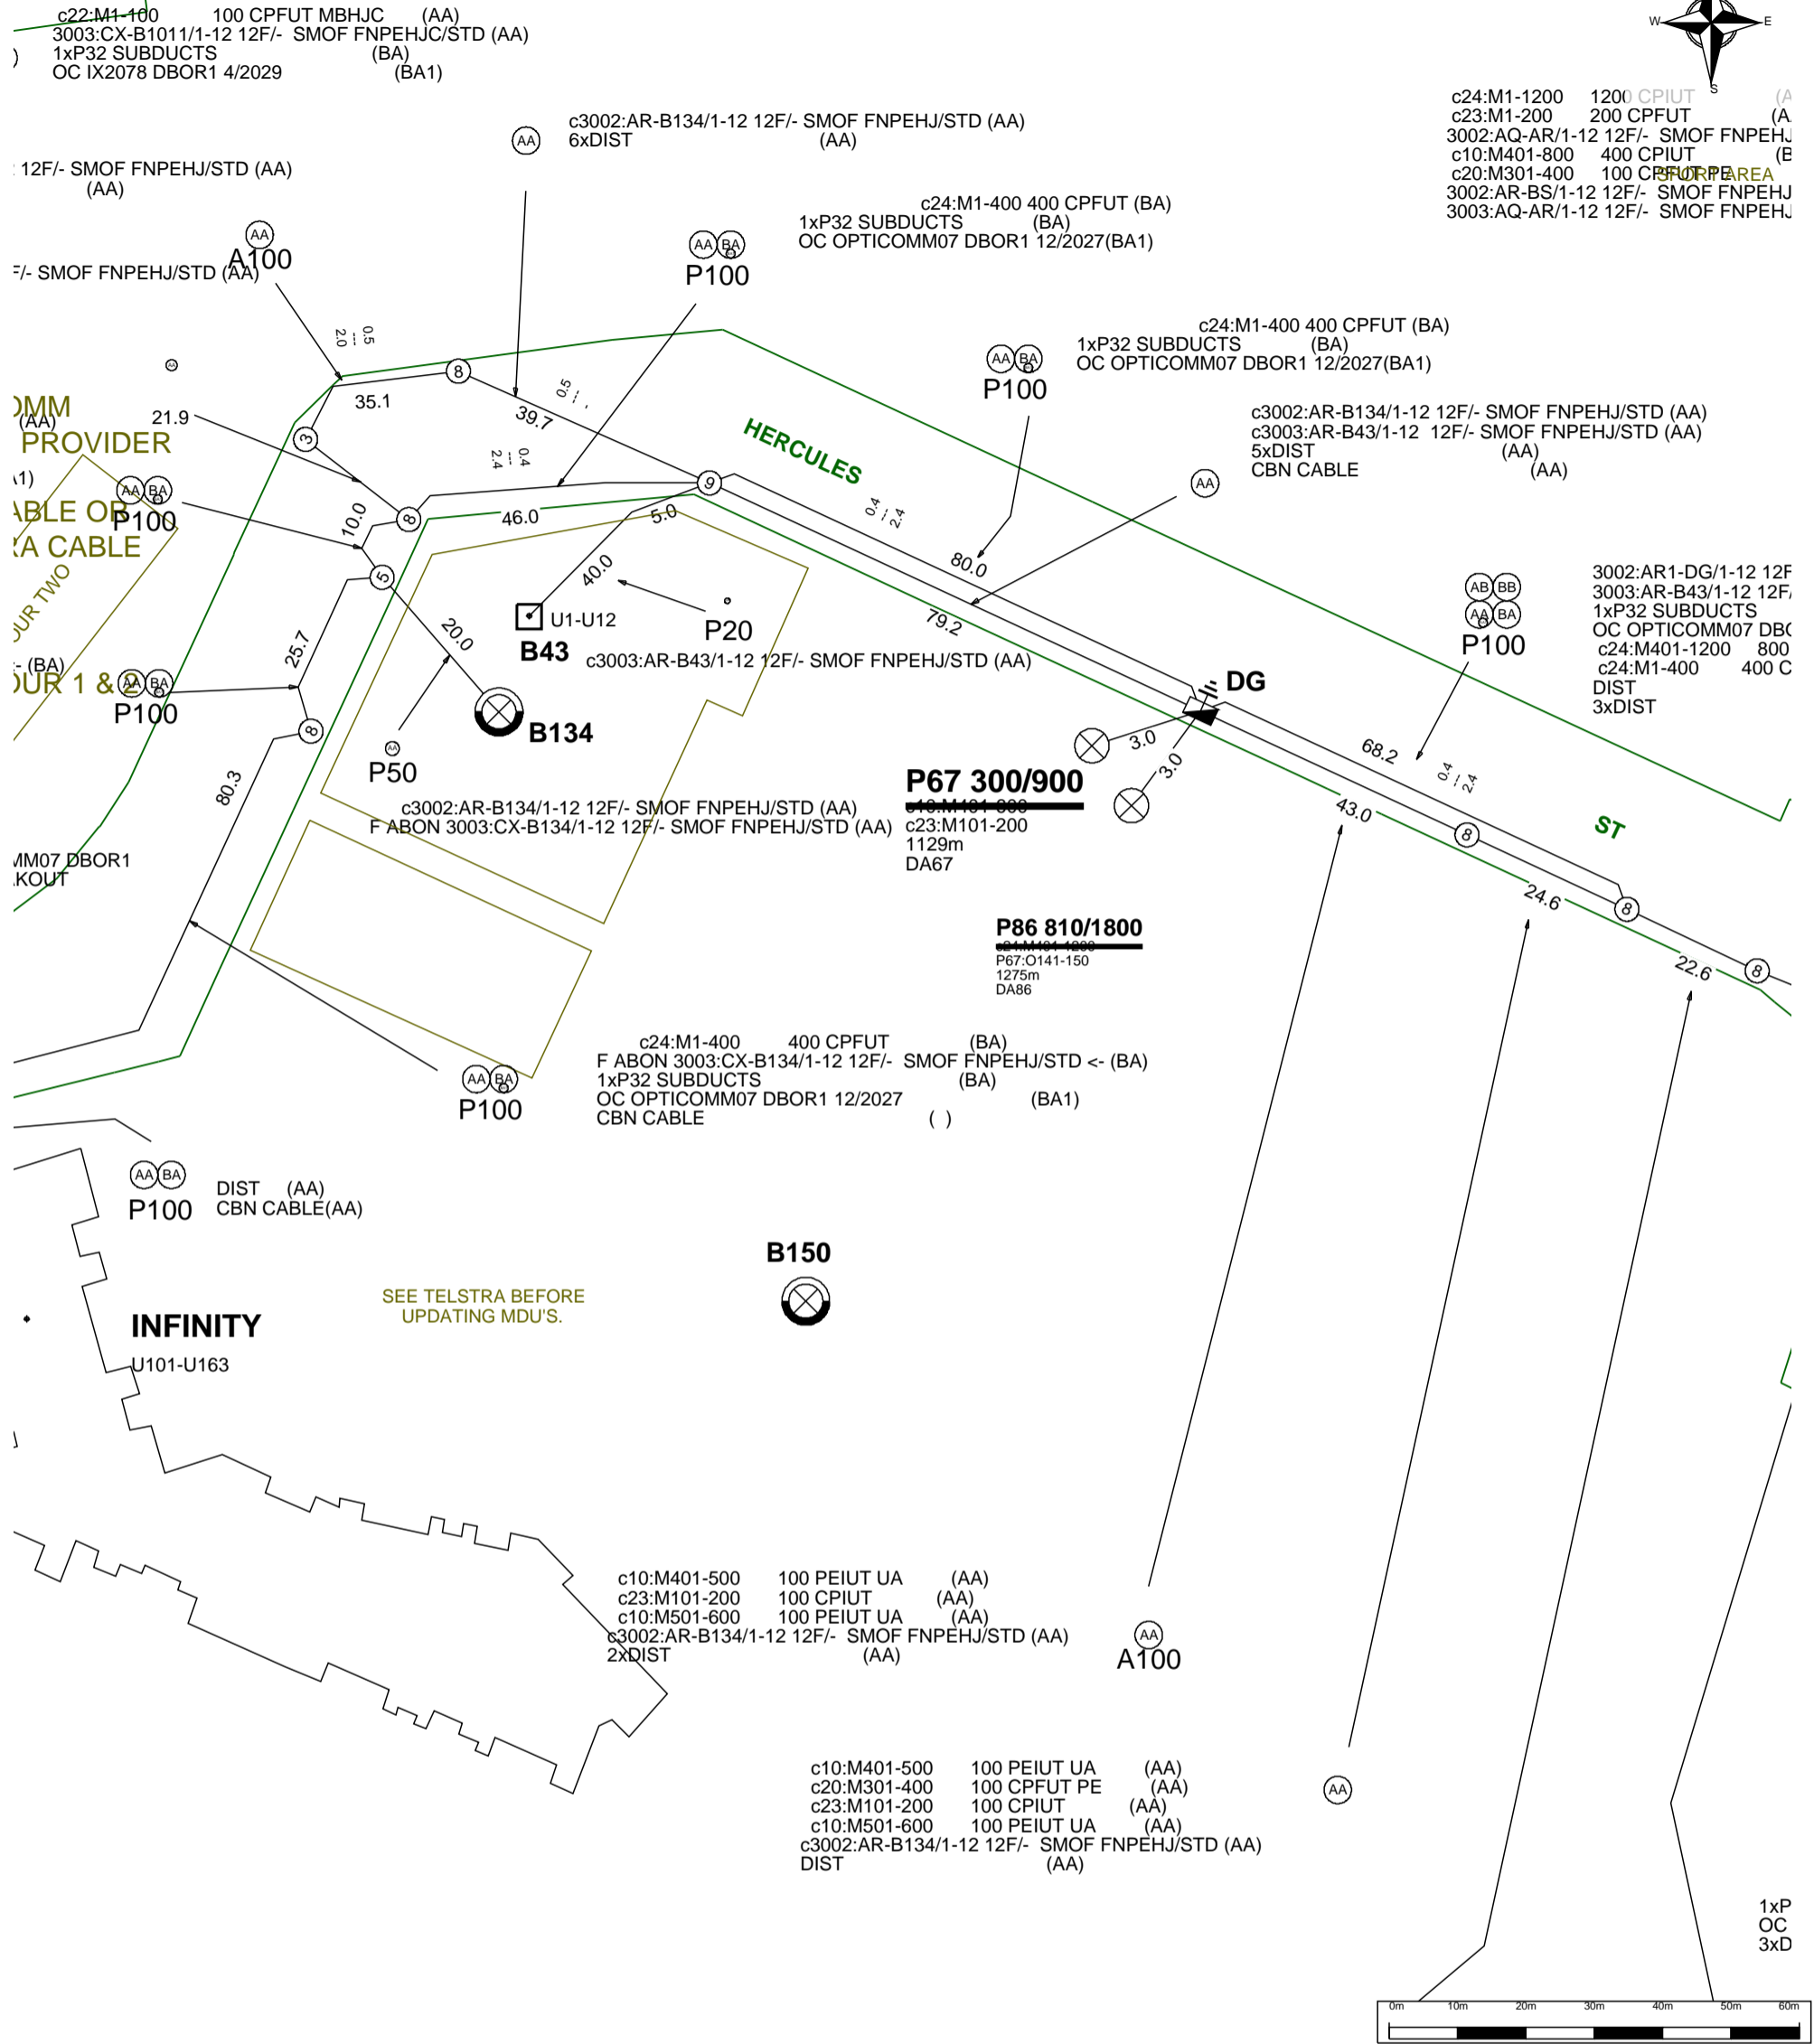

For all Telstra DBYD plan enquiries - email - Telstra.Plans@team.telstra.com
For urgent onsite contact only - ph 1800 653 935 (bus hrs)

Sequence Number: 34383544

CAUTION: Fibre optic and/ or major network present in plot area. Please read the Duty of Care and contact Telstra Plan Services should you require any assistance.

TELSTRA CORPORATION LIMITED A.C.N. 051 775 556


Generated On 06/06/2014 09:37:31

WARNING - Due to the nature of Telstra underground plant and the age of some cables and records, it is impossible to ascertain the precise location of all Telstra plant from Telstra's plans. The accuracy and/or completeness of the information supplied can not be guaranteed as property boundaries, depths and other natural landscape features may change over time, and accordingly the plans are indicative only. Telstra does not warrant or hold out that its plans are accurate and accepts no responsibility for any inaccuracy shown on the plans.

It is your responsibility to locate Telstra's underground plant by careful hand pot-holing prior to any excavation in the vicinity and to exercise due care during that excavation.

Please read and understand the information supplied in the duty of care statement attached with the Telstra plans. TELSTRA WILL SEEK COMPENSATION FOR LOSS CAUSED BY DAMAGE TO ITS PLANT.

Telstra plans and information supplied are valid for 60 days from the date of issue. If this timeframe has elapsed, please reapply for plans.

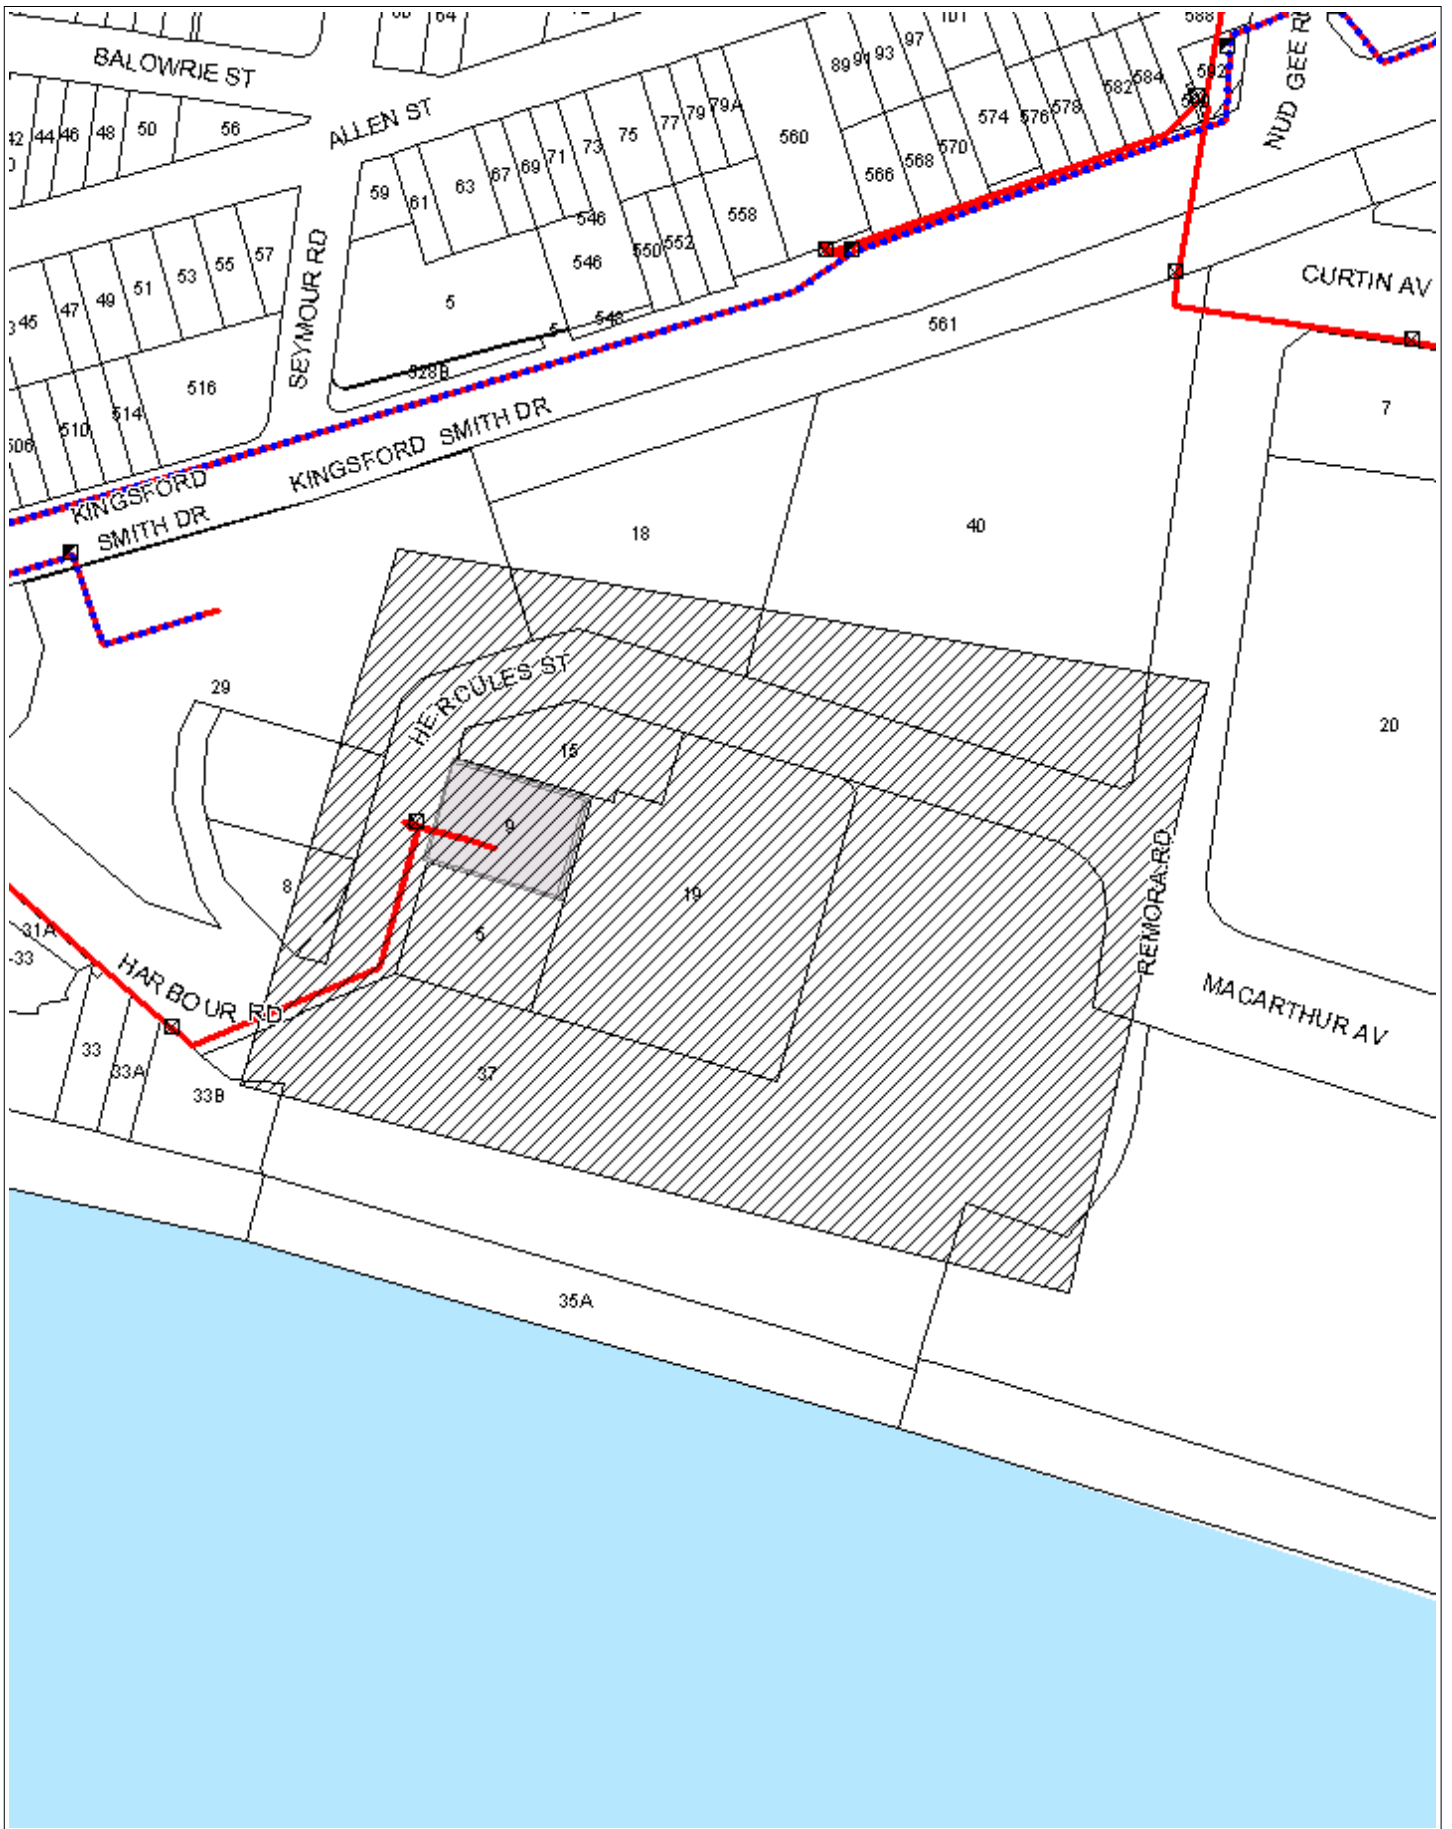

WARNING: This document is confidential and may also be privileged. Confidentiality nor privilege is not waived or destroyed by virtue of it being transmitted to an incorrect addressee. Unauthorised use of the contents is therefore strictly prohibited. Any information contained in this document that has been extracted from our records is believed to be accurate, but no responsibility is assumed for any error or omission. Optus Plans and information supplied are valid for 30 days from the date of issue. If this timeline has elapsed please raise a new enquiry.


Sequence Number: 103924031


Date Generated: 16/11/2020



For all Optus DBYD plan enquiries –
 Email: Fibre.Locations@optus.net.au
 For urgent onsite assistance contact 1800 505 777
 Optus Limited ACN 052 833 208



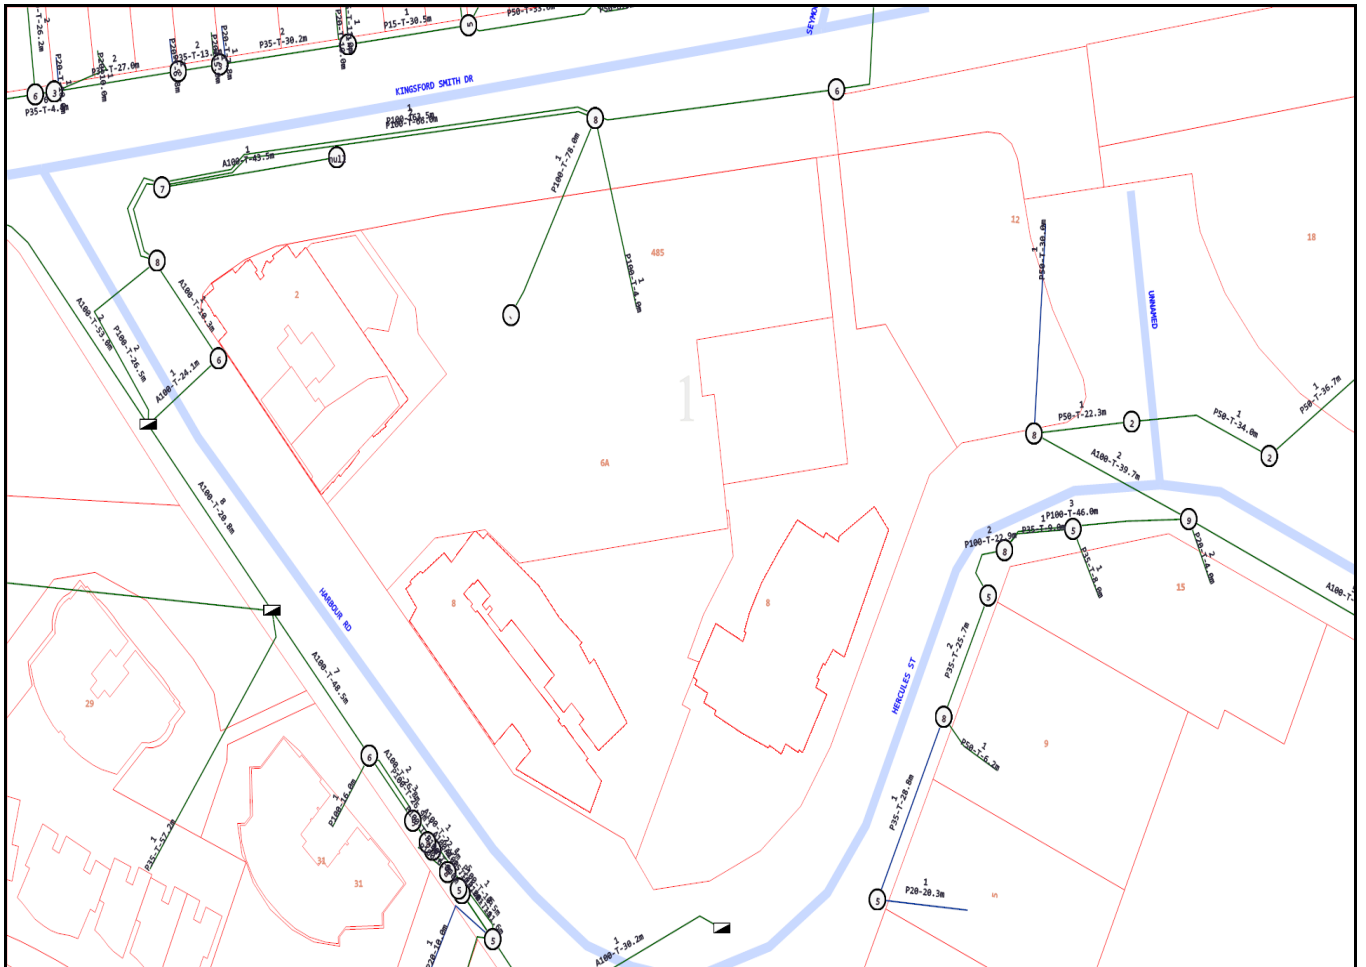

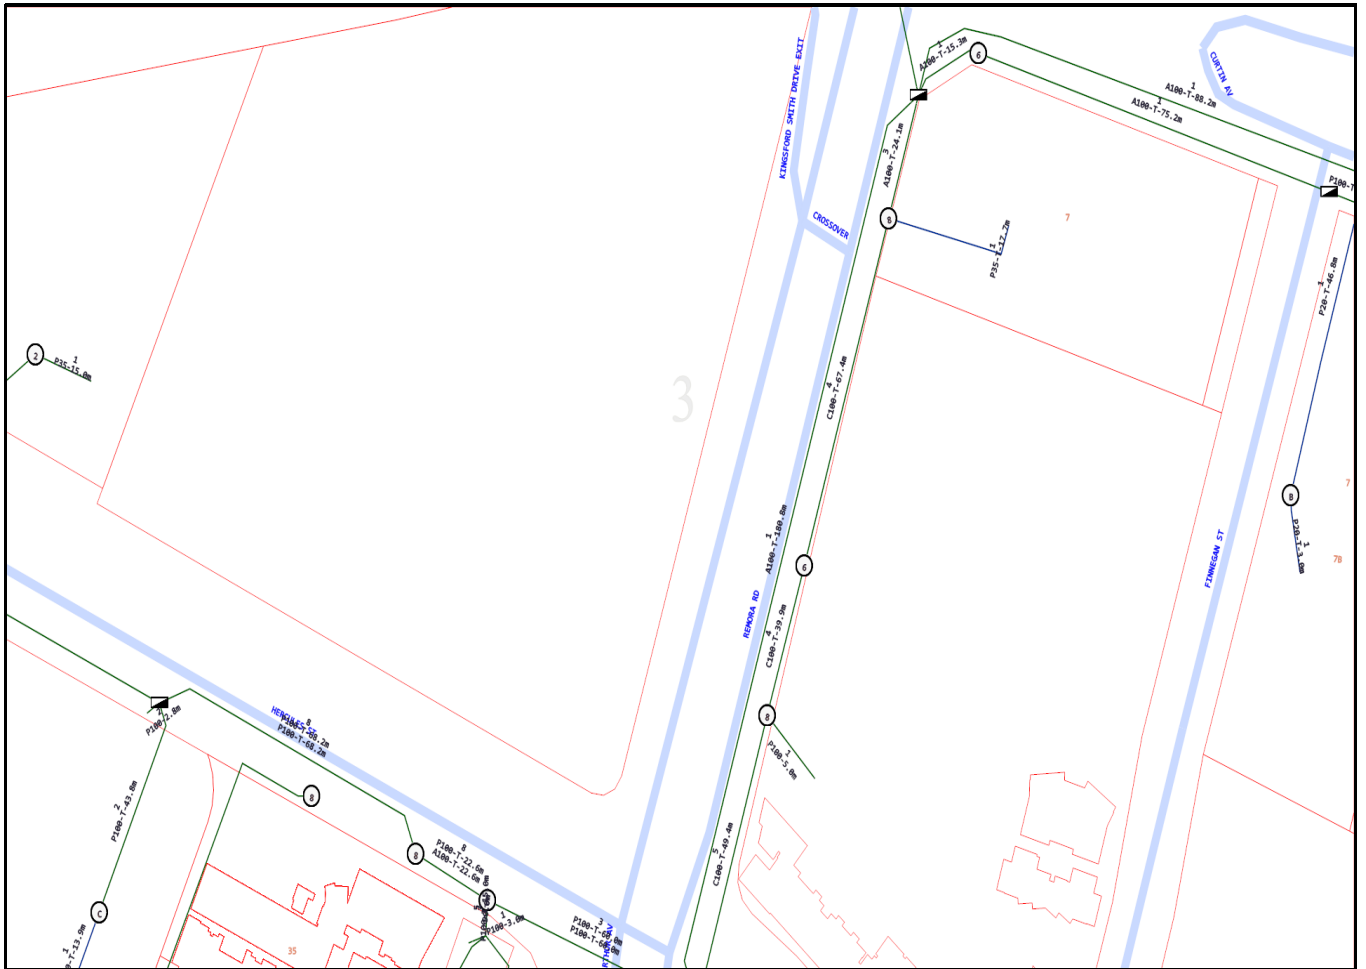



Date: 16/11/2020

Enquirer Name: Miss Marnie Stollznow
Enquirer Address: Level 4, 67 Astor Terrace
Email: m.stollznow@bornhorstward.com.au
Phone: 0730134699

Dear Miss Marnie Stollznow

The following is our response on behalf of each of the TPG carriers (listed below) to your Dial Before You Dig enquiry – Sequence 103924027. It is provided to you on a confidential basis under the following conditions and must be shredded or securely disposed of after use.

Assets Affected:

Carriers (each a “TPG carrier”) and assets affected:

PIPE Networks

Location: 19 Hercules Street

According to our records, the underground assets in the vicinity of the location stated in your enquiry are **AFFECTED**. Please read the below information and disclaimers in addition to the any attached plans provided prior to any construction activities.

IMPORTANT INFORMATION

- The information provided is valid for 30 days from the date of this response. If your work site area changes or your construction activity is beyond 30 days please contact Dial Before You Dig on 1100 or www.1100.com.au to re-submit a new enquiry.
- Due to the nature of underground assets and the age of some assets and records, our plans are indicative of the general location only and may not show all assets in the location. You should not solely rely on these plans when undertaking construction works. It is also inaccurate to assume depth or that underground network conduit and cables follow straight lines, and careful on-site investigations are essential to locate an asset's exact position prior to excavation. It is your responsibility to locate and confirm the exact location of our infrastructure using non-destructive techniques. We make no warranty or guarantee that our plans are complete, current or error free, and to the maximum extent permitted by law we exclude all liability to you, your employees, agents and contractors for any loss, damage or claim arising out of or in connection with using our plans.
- Please note that some of our conduits carry electrical cables and gas pipes. Please exercise extreme care when working within the vicinity of these conduit and take into account the minimum clearance distances under Duty Of Care below.
- You (and your employee and contractors) must not open, move, interfere, alter or relocate any of our assets without our prior approval.
- **Note** It is a criminal offence under the *Criminal Code Act 1995 (Cth)* to tamper or interfere with communication facilities owned by a carrier. Heavy penalties may apply for breach of this prohibition, and any damages suffered, or costs incurred by us as a result of such unauthorised works may be claimed against you.

DAMAGE

- You must report immediately any damage to our network on **1800 786 306** (24hrs). We will hold you liable and seek compensation for any loss or damage to our network, our property and our customers that is caused by or arises out of your activities.

DUTY OF CARE

You have a duty of care to carefully locate, validate and protect our assets when carrying out works near our infrastructure. For construction activities that may impact on or interfere with our network, you will need to call us on **1800 786 306** to discuss a suitable engineering solution, lead time and cost involved. The below precautions must be taken when working in the vicinity of our network:

- Contact us on **1800 786 306** to discuss and obtain relevant information and plans on our infrastructure in a particular location if the information provided in this response is insufficient.
- Physically locate and mark on-site our network infrastructure using non-destructive techniques i.e. pot holing or hand digging every 5 metres prior to commencing any construction activities. Assets located must be marked to AS5488 standard. **NO CONSTRUCTION WORK IS ALLOWED UNTIL THIS STEP IS COMPLETED.** You must use an approved telecommunications accredited locator, or we can provide a locator for you at your expense. If we provide you with a locator, and this locator attended the site and is proven to be grossly negligent in physically locating and marking our infrastructure, then to the extent any TPG carrier is liable for this locator's negligence, acts and omissions, the total liability aggregated for all TPG carriers is limited, at our option, to attend the site and re-mark the infrastructure or to pay for a third party to re-mark the infrastructure.
- If you require us to locate or monitor our infrastructure, please allow five business days' notice for us to respond.
- Ensure all information, including our network requirements and any associated plans provided by us are kept confidential and remain on-site throughout your construction works.


- Use suitably qualified and supervised professionals, particularly if you are working near assets that contain electricity cables or gas pipes.
- Ensure the below minimum clearance distances between the construction activities and the actual location of our assets are met. If you need clearance distances for our above ground assets, or if the below distances cannot be met, call **1800 786 306** to discuss.

Minimum assets clearance distances.

- 300mm when laying asset inline, horizontal or vertical.
 - 1000mm when operating vibrating equipment. Eg: vibrating plates. No vibrating equipment on top of asset.
 - 1000mm when operating mechanical excavators or jackhammers/pneumatic breakers.
 - 2000mm when performing directional bore in-line, horizontal and vertical.
 - No heavy vehicle over 3 tonnes to be driven over asset with less than 600mm of cover.
- Reinstate exposed TPG network infrastructure back to original state.

PRIVACY & CONFIDENTIALITY

- Privacy Notice – Your information has been provided to us by Dial Before You Dig to respond to your Dial Before You Dig enquiry. We will keep your personal information in accordance with TPG’s privacy policy, see www.tpg.com.au/about/privacy.
- Confidentiality – The information we have provided to you is confidential and is to be used only for planning and designing purposes in connection with your Dial Before You Dig enquiry. Please dispose of the information by shredding or other secure disposal method after use. We retain all intellectual property rights (including copyrights) in all our documents and plans.

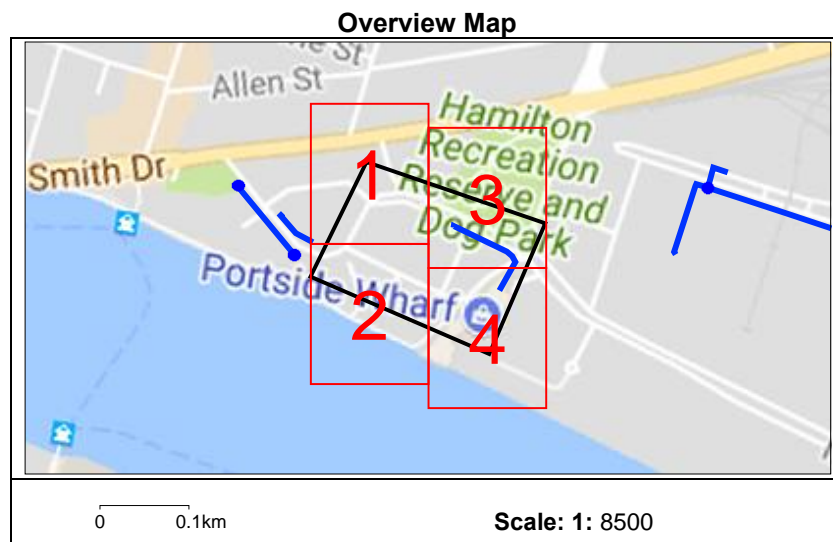

TPG Corporation Limited

3



Enquiry Number: 103924027

Map Sheet: 3

Scale: 1: 750

0 0.008km



LEGEND

DBYD Work Area



AAPT/PowerTel Pit



TransACT Pit



AAPT/PowerTel Duct



TransACT Duct



DDA Pit



SOUL Pattinson Telecoms Pit



DDA Duct



SOUL Pattinson Telecoms Duct



Agile/Adam Pit



PIPE Networks Pit




Agile/Adam Duct



PIPE Networks Duct



DISCLAIMER: No responsibility/liability is taken by TPG Corporation Limited for any inaccuracy, error, omission or action based on the information supplied in this correspondence. © 2020 TPG Corporation Limited.

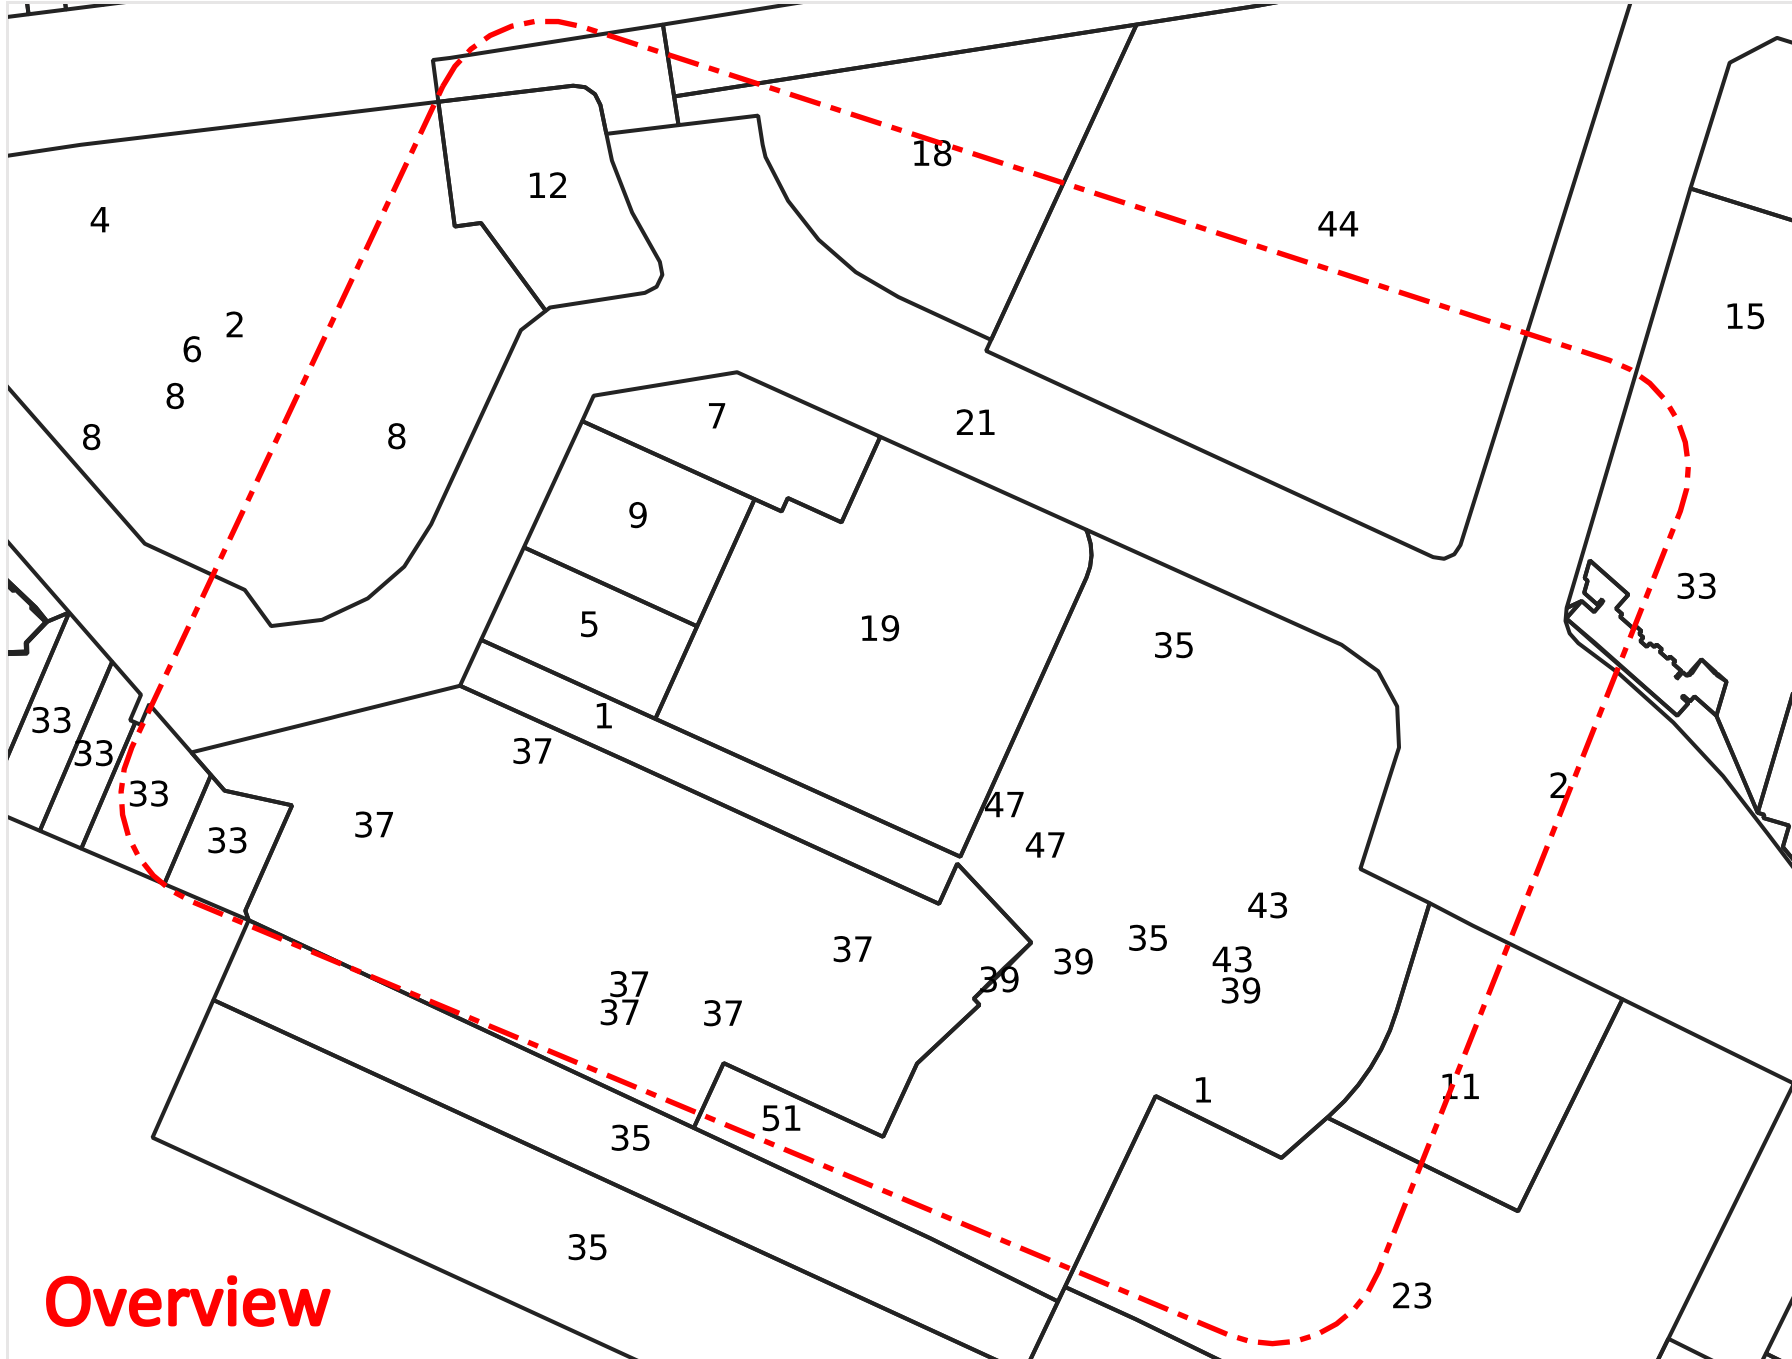

Legend


- Pipes
- Pits




Scale: 1:1986
Expires: 14 Dec 2020

DISCLAIMER: While reasonable measures have been taken to ensure the accuracy of the information contained in this plan response, neither OptiComm nor PelicanCorp shall have any liability whatsoever in relation to any loss, damage, cost or expense arising from the use of this plan response or the information contained in it or the completeness or accuracy of such information. Use of such information is subject to and constitutes acceptance of these terms.


Overview

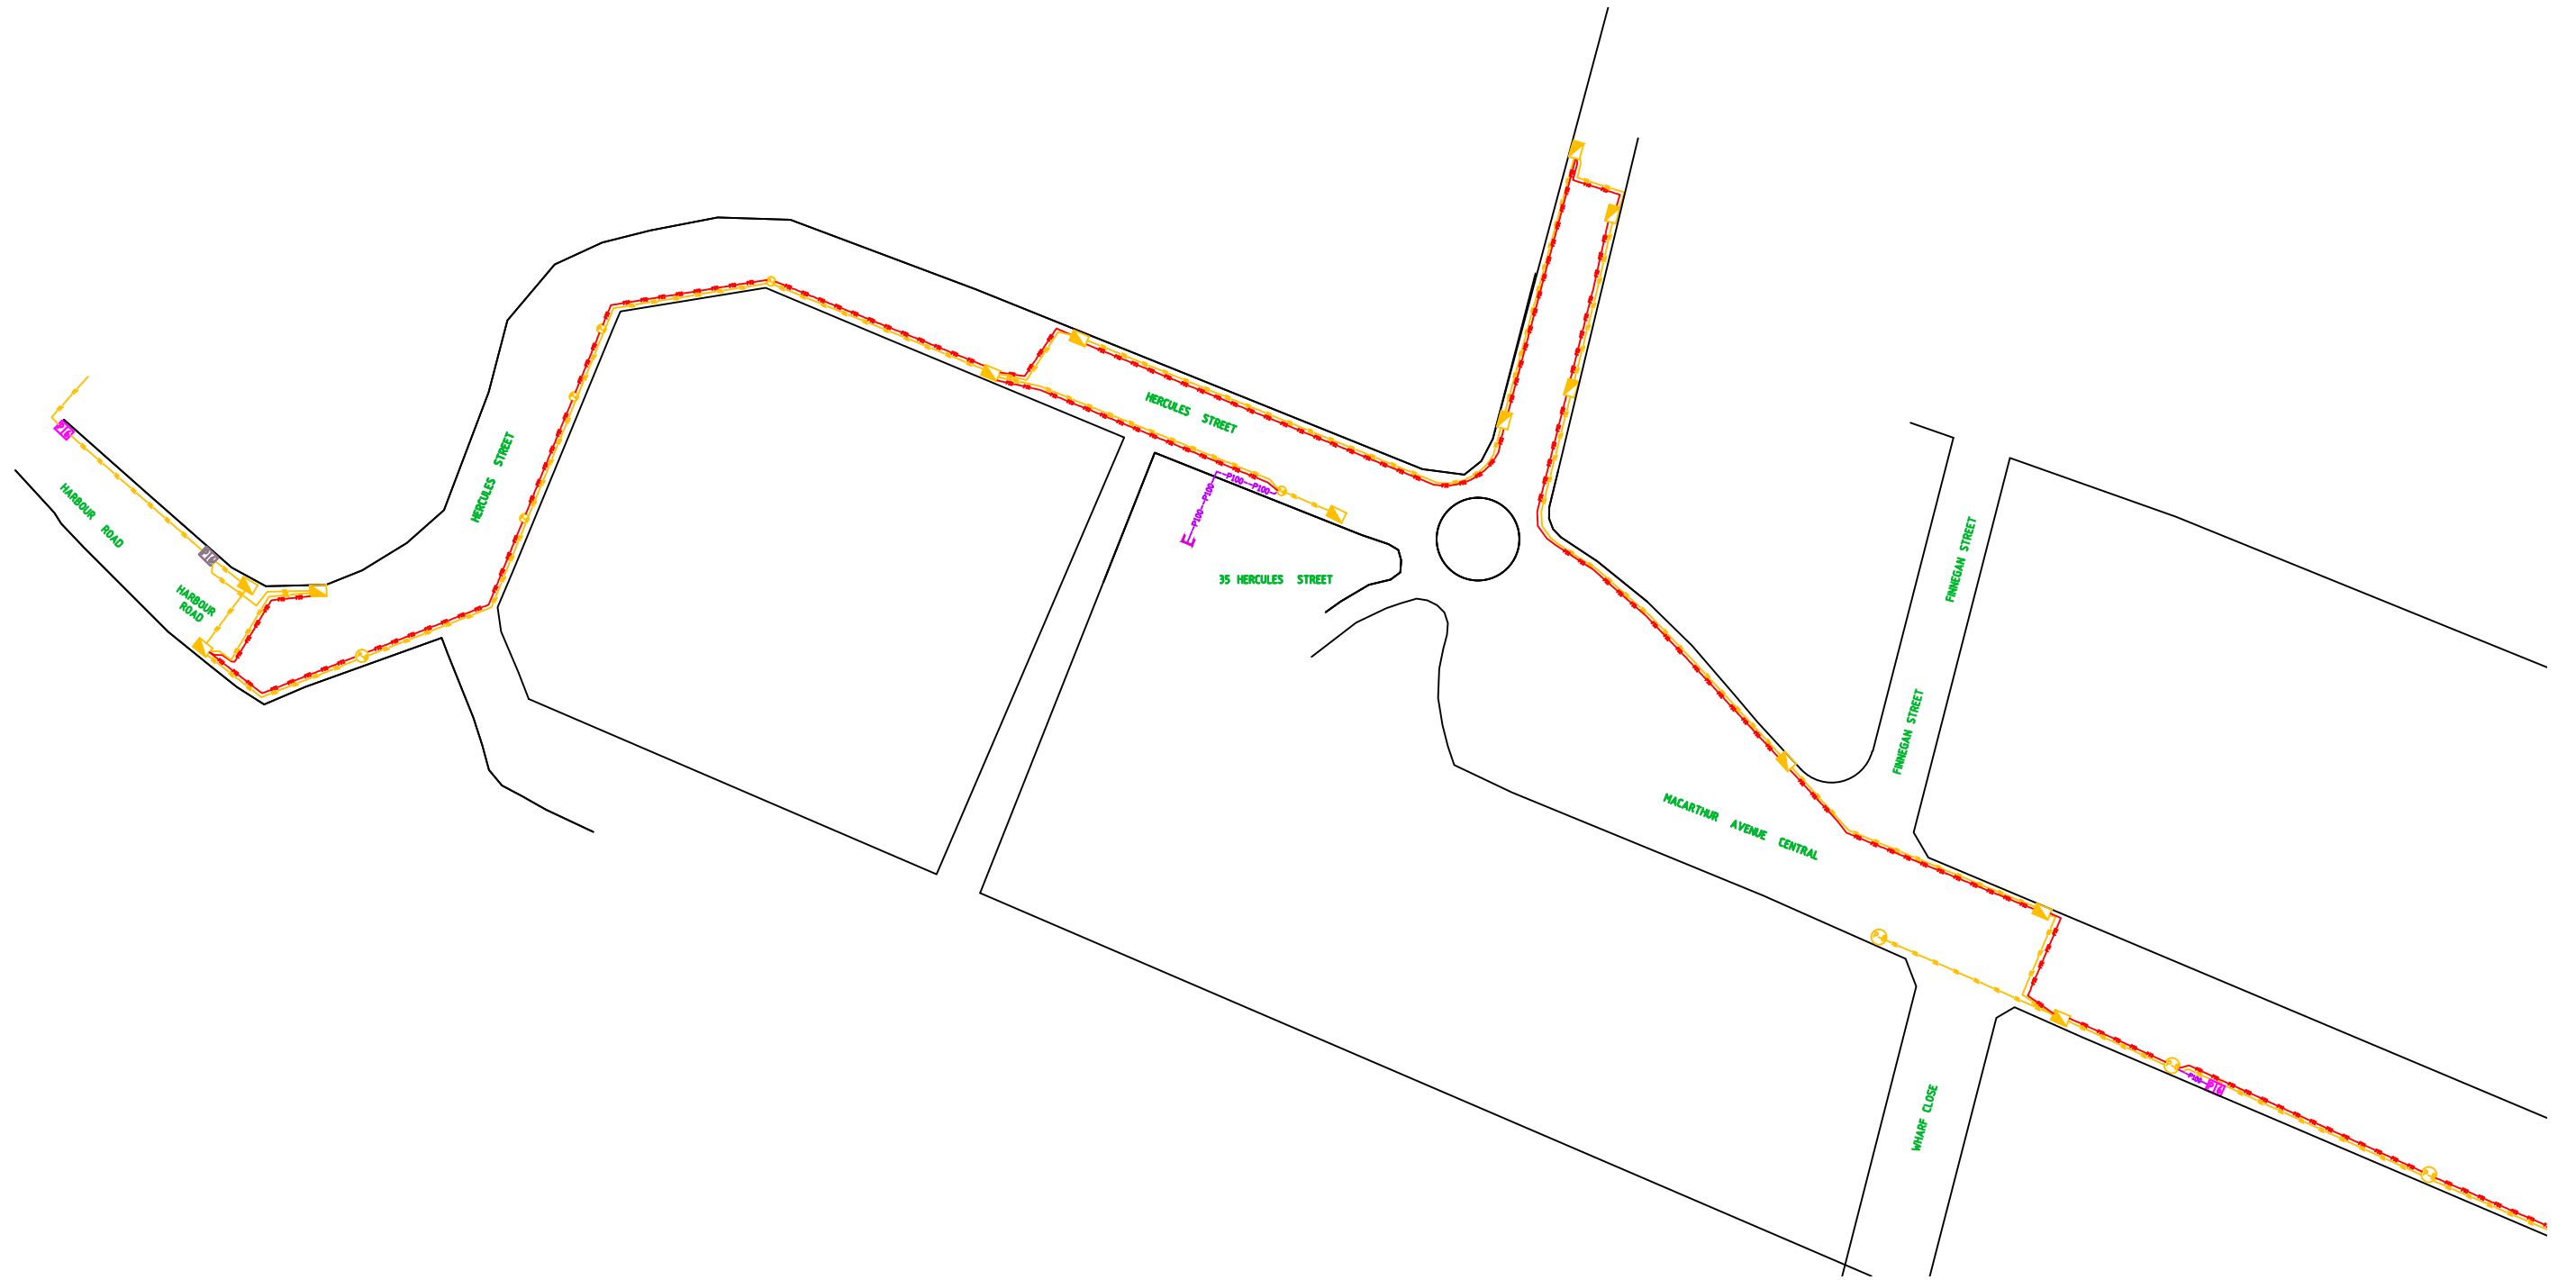

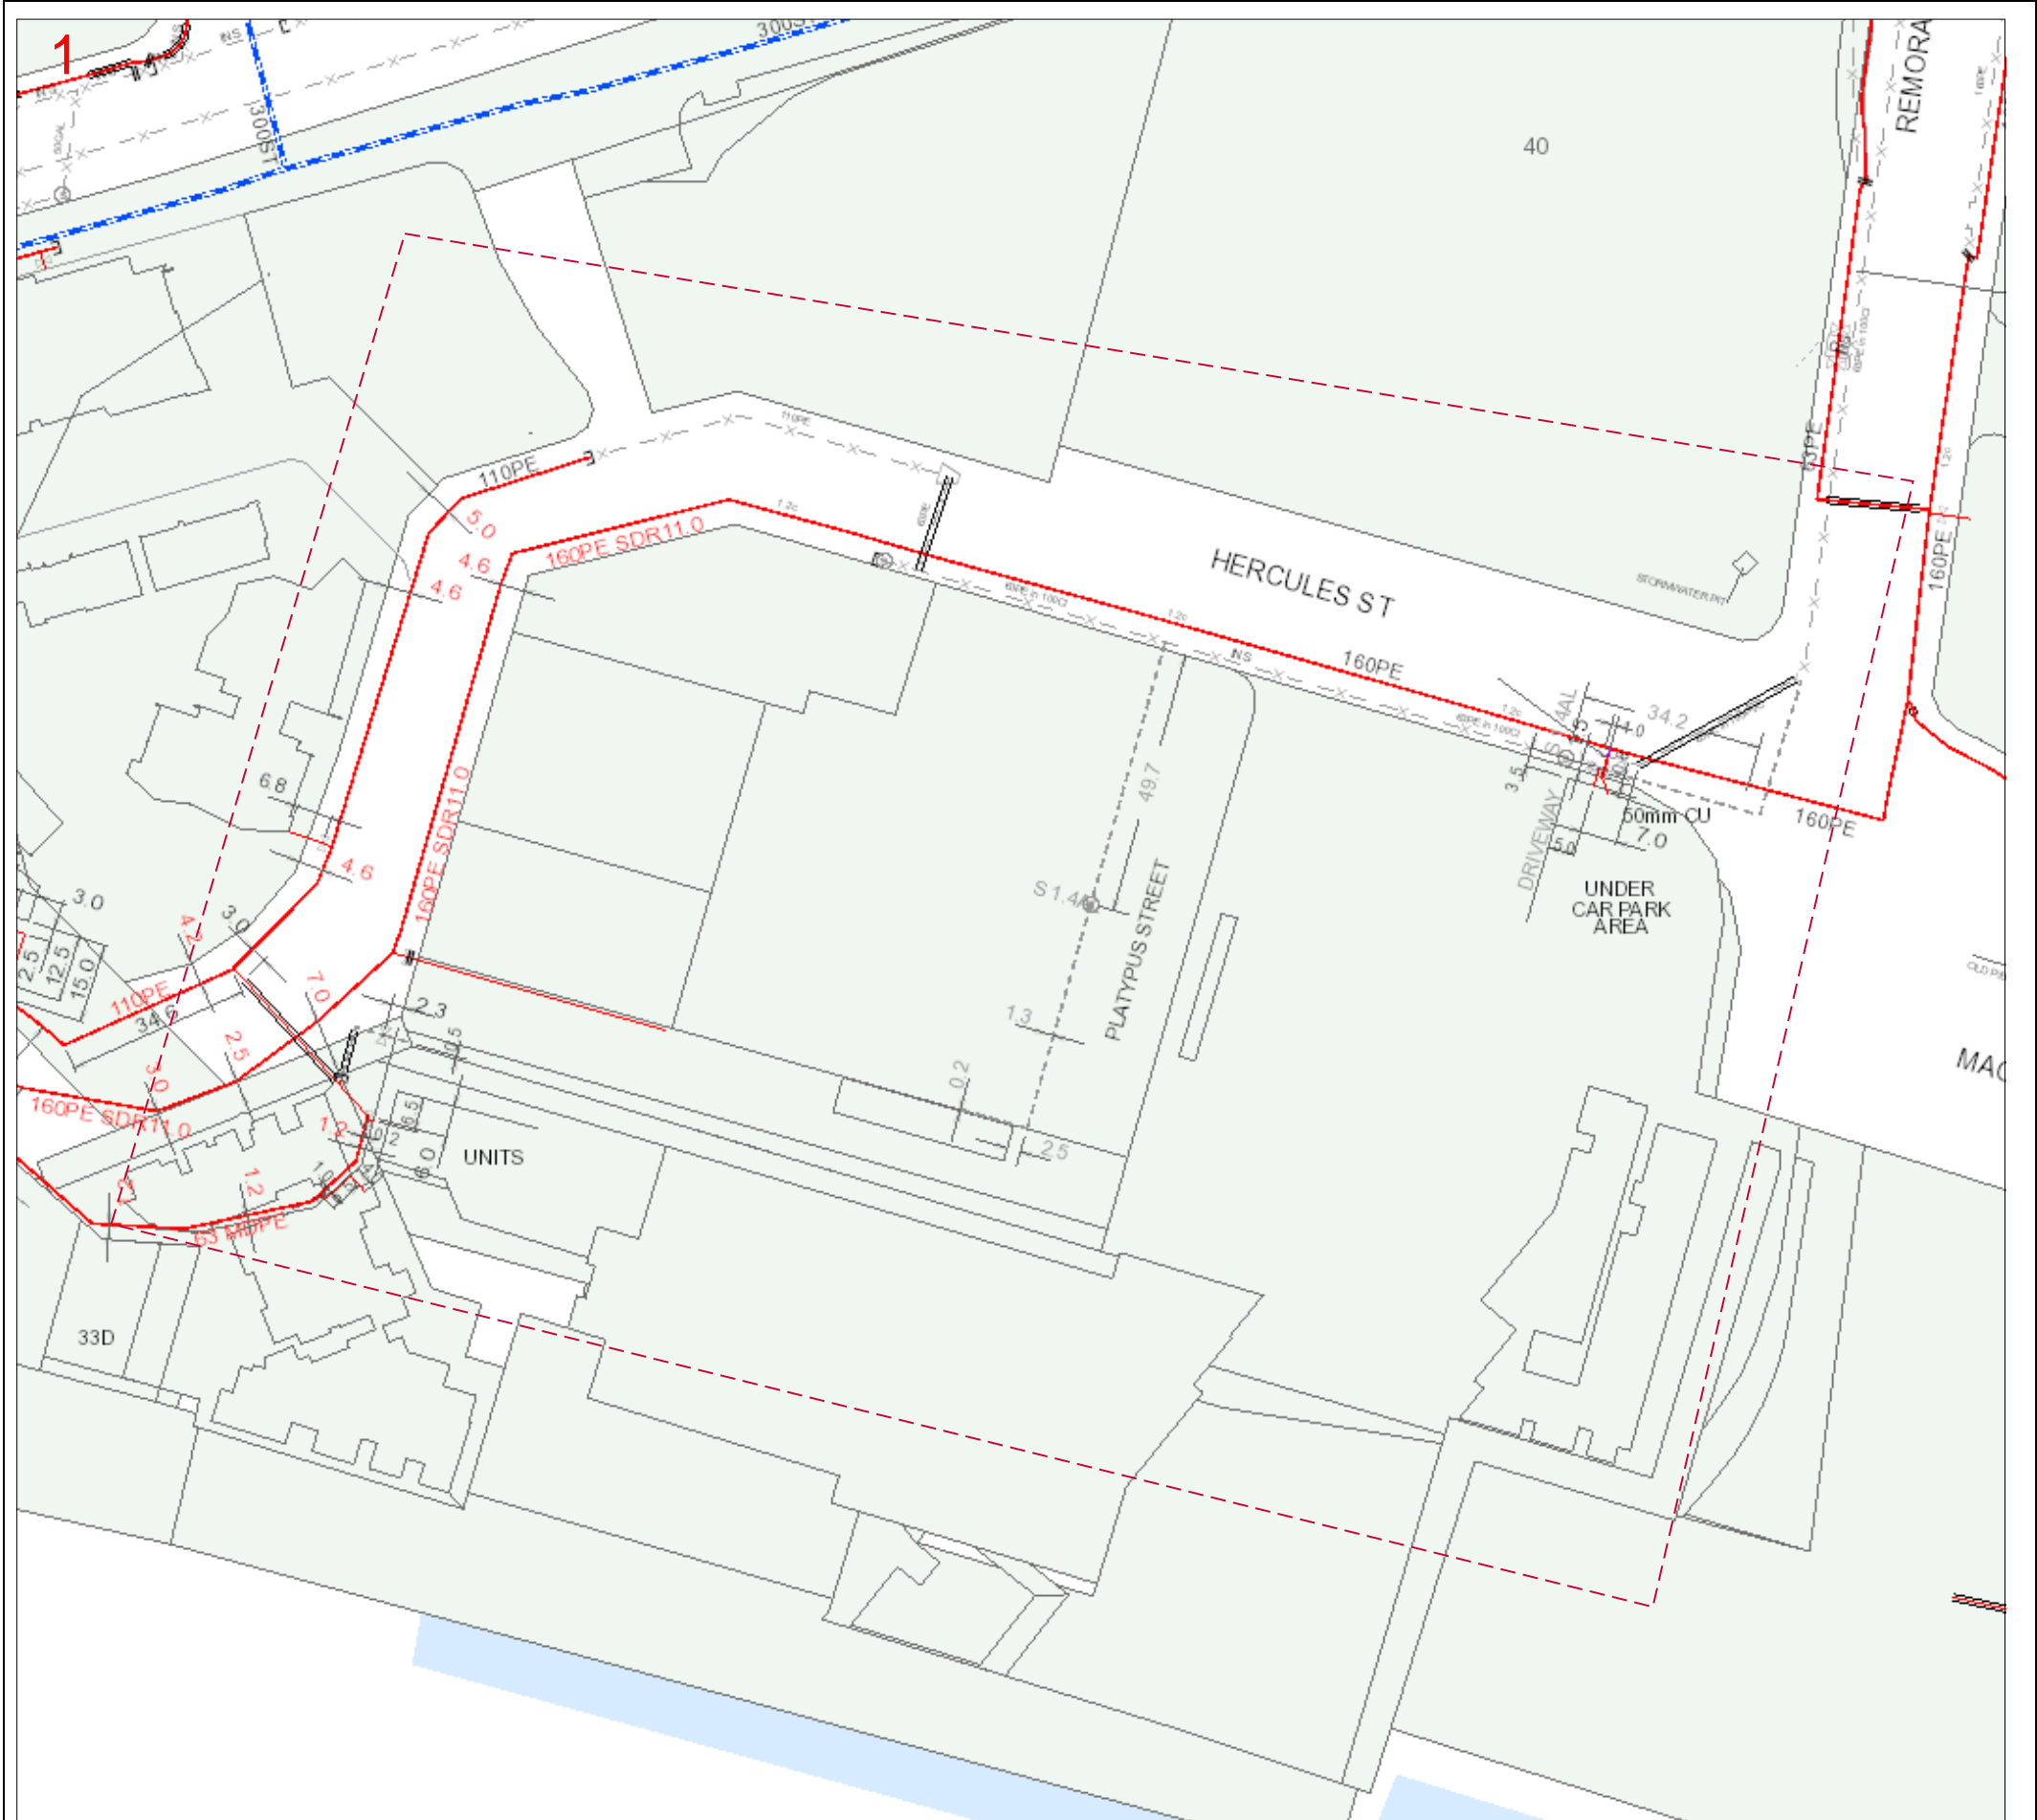

103924032 Map Sheet: 1

Scale: 1: 1000

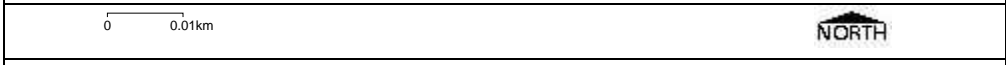

Map Key:

1

Legend

Distribution Main	Gas Assets and Fittings	Pipe Materials
Class 900 Transmission	Gate Station	CI Cast Iron
Class 600 Transmission	Regulator Station	CU Copper
Class 300 Transmission	Block/ Emergency Valve	GAL Wrought Galvanised Iron
High Pressure Steel	Isolation Valve	PGAL Poly Coated Wrought Galvanised Iron
High Pressure PE Trunk	Test Point	ST Steel
High Pressure/ Class 500	Syphon	NY/ NY11 Nylon
Medium Pressure PE/ Nylon	Anode	PE Polyethylene
Medium Pressure (Allgas)	Pipeline Marker	MDPE Medium Density Polyethylene
Low Pressure	Trace Wire Point	HDPE High Density Polyethylene
LPG	Reducer	DN Nominal Diameter
TLP	Pipe Connector/ Tee	OD Outside Diameter
Proposed/ Under Construction	Pipe Connector	
Idle Gas Pipe	End Cap	
Abandoned Gas Pipe		
Sleeve		

Examples: 40PE in DN80 CI 40mm Polyethylene in an 80mm (Nominal Diameter) Cast Iron Sleeve
63PE INS 63mm Polyethylene inserted in another pipe

Line/ Polygon Request

Data Source
Pipeline Data Copyright APA Group, Property Parcels Copyright QLD Government, UBD Imagery - Copyright Sensis, DBYD Dig Location provided by DBYD.

This map is created in colour and shall be printed in colour

APA Group does not guarantee the accuracy or completeness of the map and does not make any warranty about the data. APA Group is not under any liability to the user for any loss or damage (including consequential loss or damage) which the user may suffer resulting from the use of this map

APPENDIX D

**BCC POTENTIAL AND ACTUAL ACID
SULPHATE SOIL OVERLAY MAP**



Map Tools +

Legend -

City Plan 2014 — Potential and actual acid sulfate soils

- Potential and actual acid sulfate soils

City Plan 2014 — Potential and actual acid sulfate soils - land at or below 5m AHD

- Land at or below 5m AHD

City Plan 2014 — Potential and actual acid sulfate soils - land above 5m AHD and below 20m AHD

- Land above 5m AHD and below 20m AHD

Local Government Authorities

- LGA boundary

property_boundaries_holding

- Property Holding

**BORNHORST
+WARD**


+61 (7) 3013 4699 www.bornhorstward.com.au

PROJECT

SUBJECT

PROJECT No.

DRAWING No. REVISION

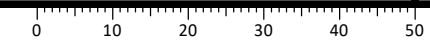

ORIGINAL SIZE A3