



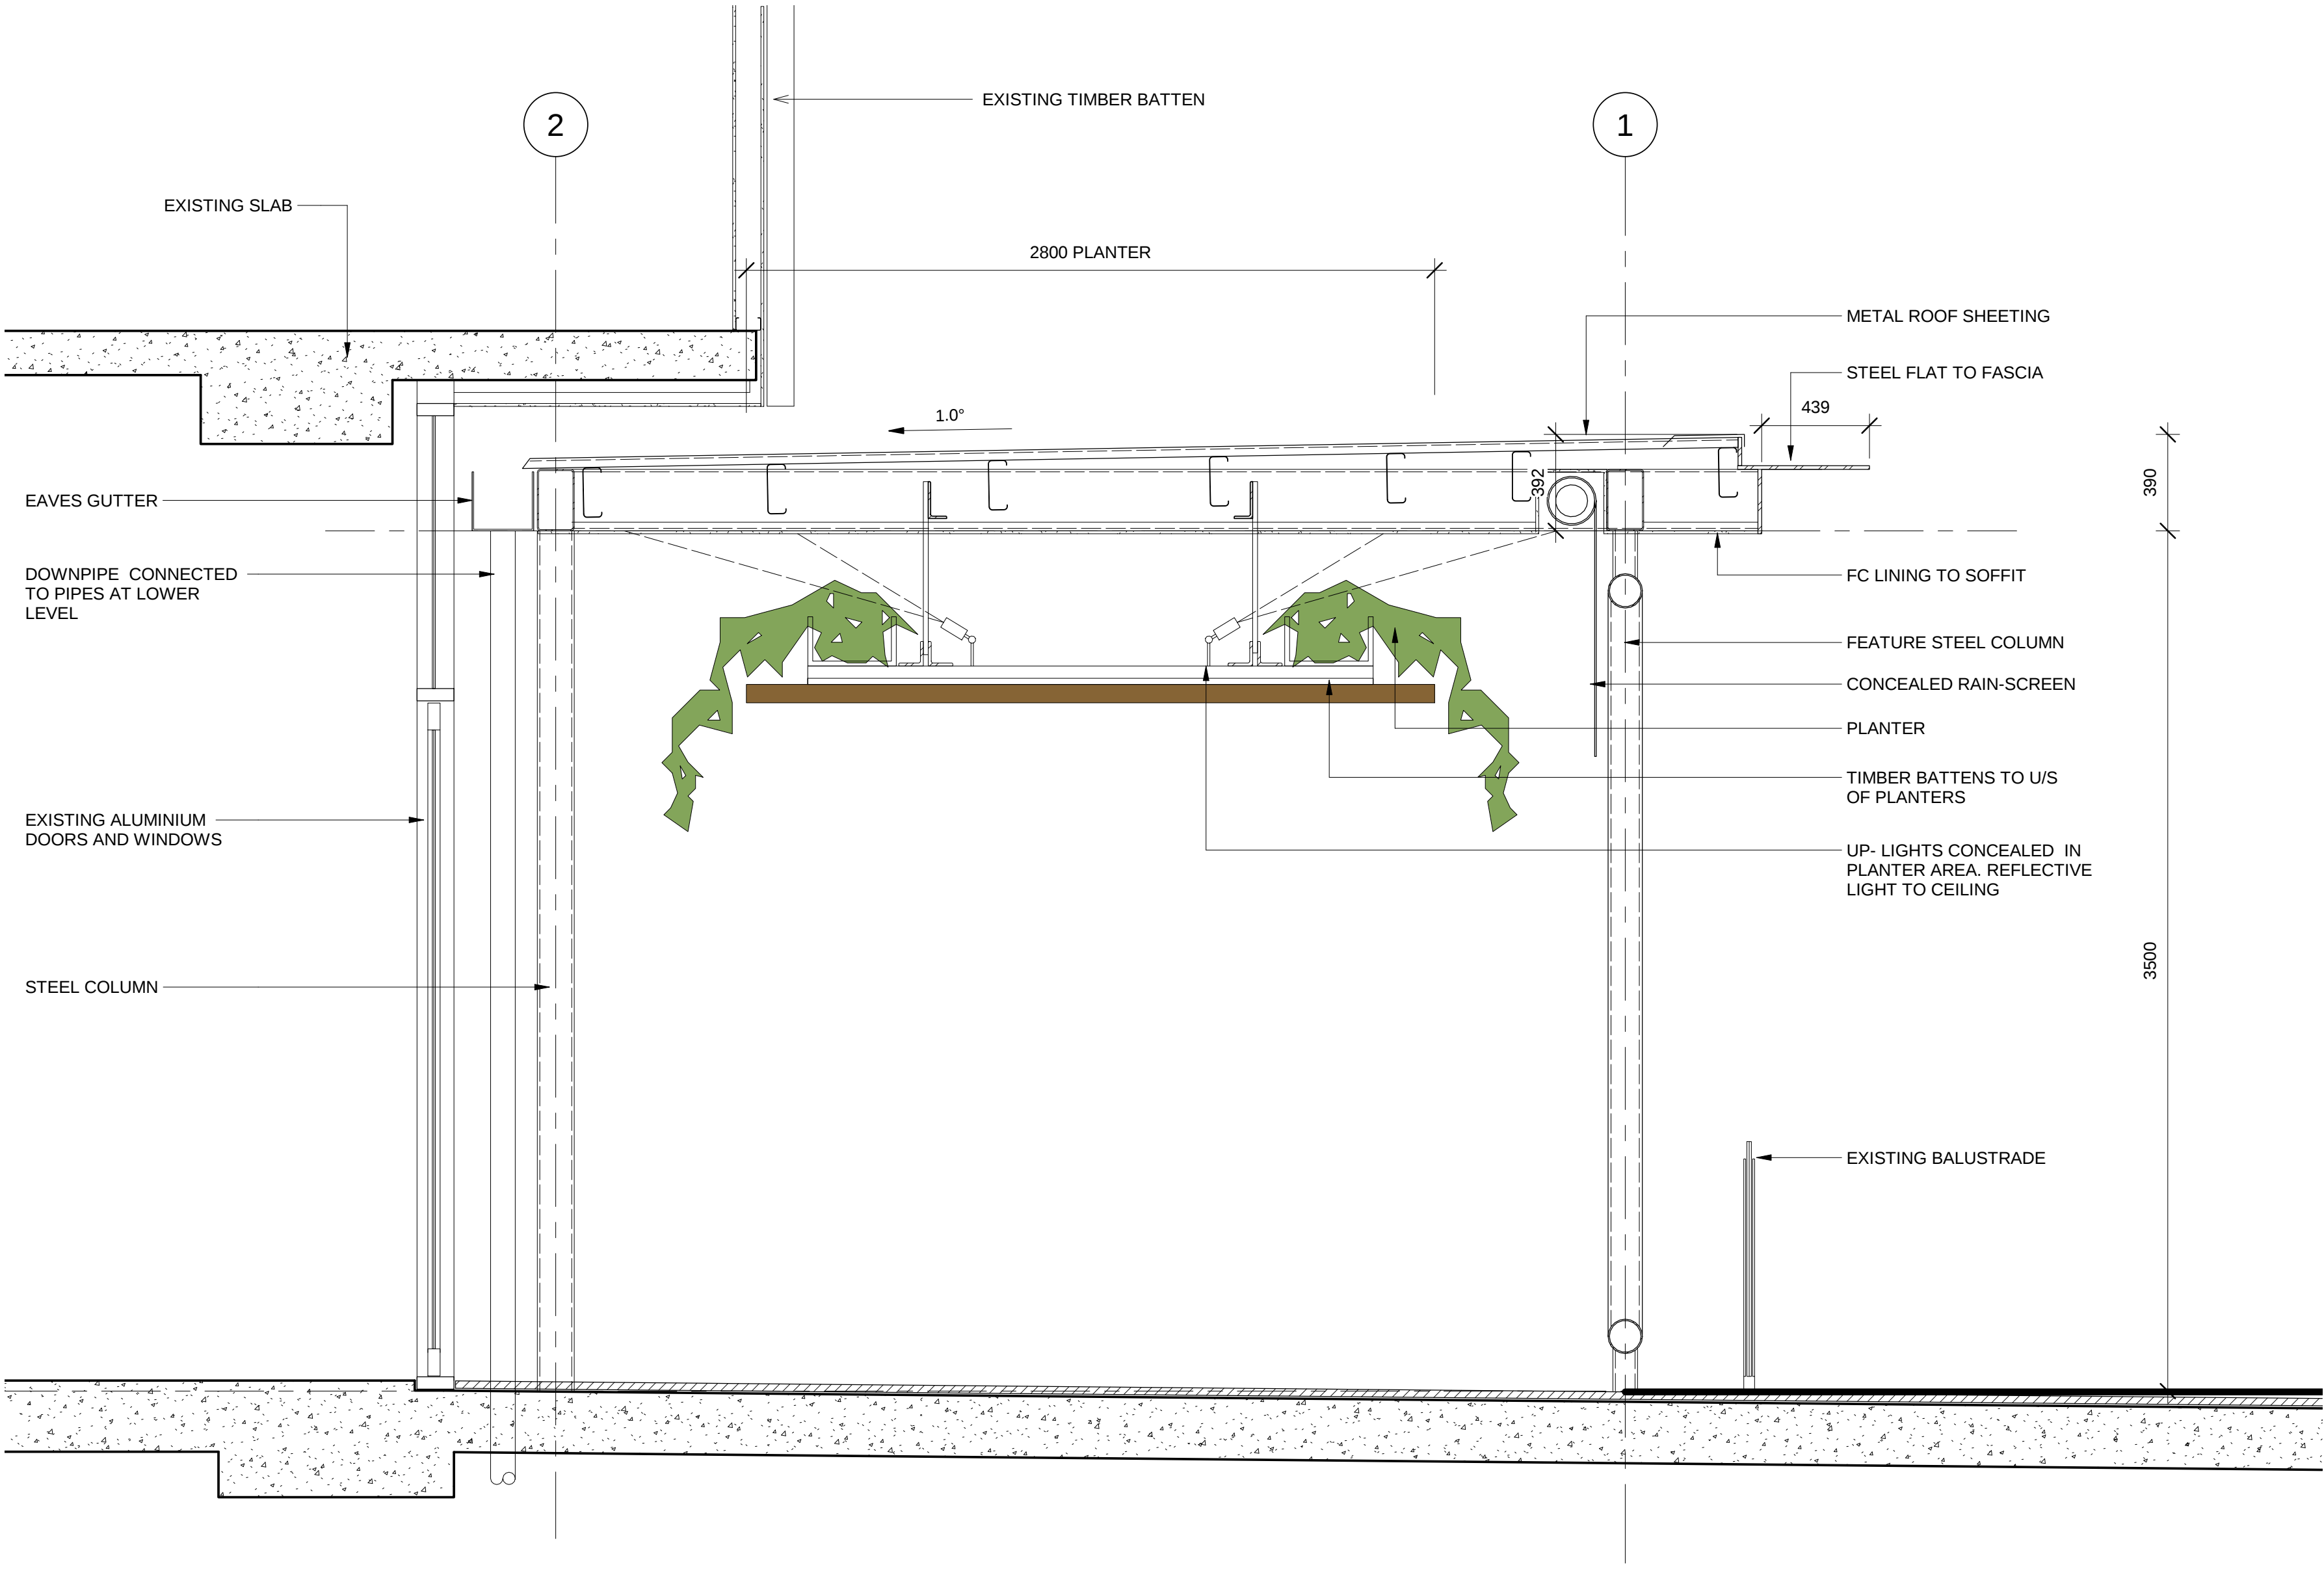


TYPICAL SECTION

Section
SCALE 1 : 20

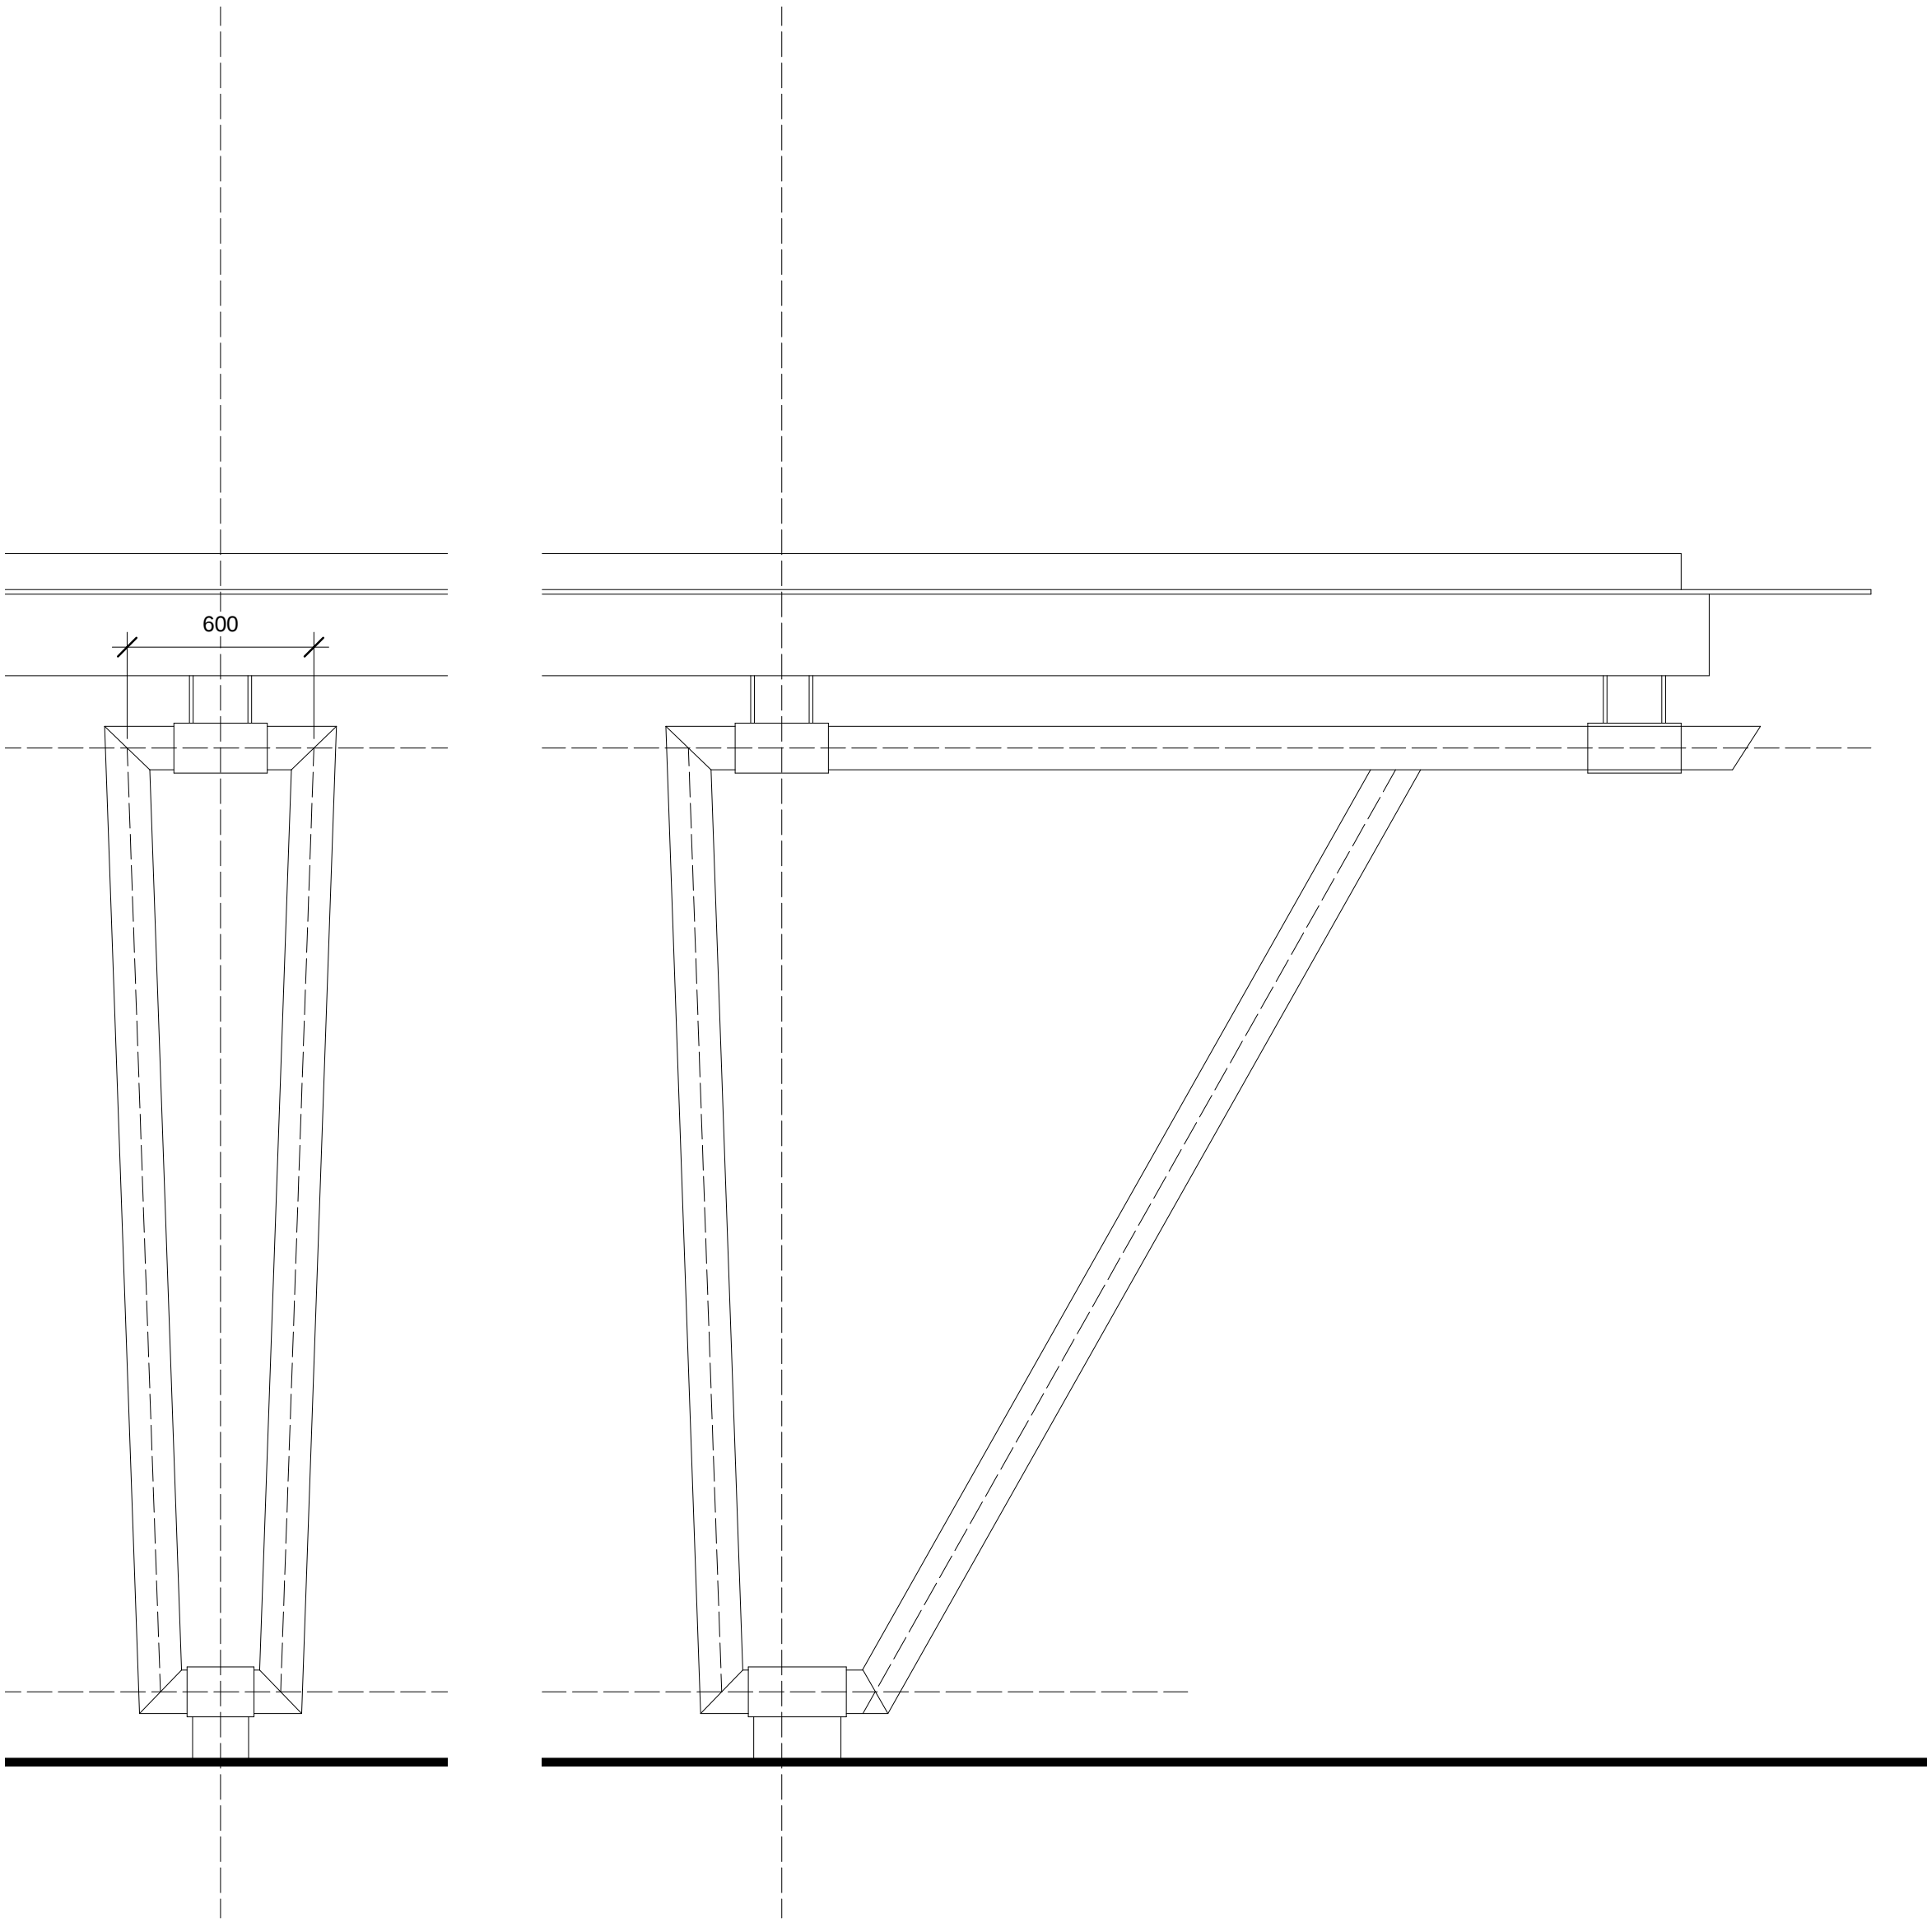

TYPICAL COLUMN ELEVATIONS

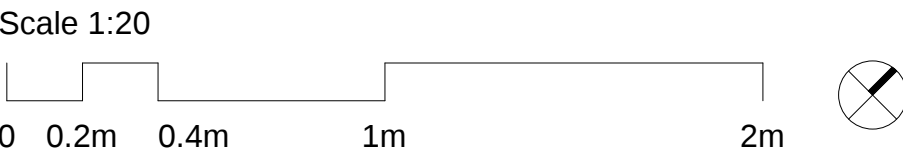


COX


Cox Architecture
Level 2, 2 Edward Street,
Brisbane, QLD 4000, Australia
T + 61 7 3210 0844
F + 61 7 3210 0541
www.coxarchitecture.com.au

© COPYRIGHT COX ARCHITECTURE PTY LTD ACN 002 535 891			
ANY FORM OF REPRODUCTION OF THIS DRAWING IN FULL OR IN PART WITHOUT THE WRITTEN PERMISSION OF COX ARCHITECTURE PTY LTD CONSTITUTES AN INFRINGEMENT OF COPYRIGHT			
Rev	Description	By	Date

Client		Owner		Project		Co-ordinated:		Drawn:	
Project No.		419088		Gianni Awning		Checker		Author	
Document Control Status:				Portside		Project Architect:		Scale:	
				Detail Section & Elevations		Designer		1 : 20 @ A1	
						Project Director:		Date:	
						Approver		02/08/21	
						Drawing Number:		Revision:	
								A105	

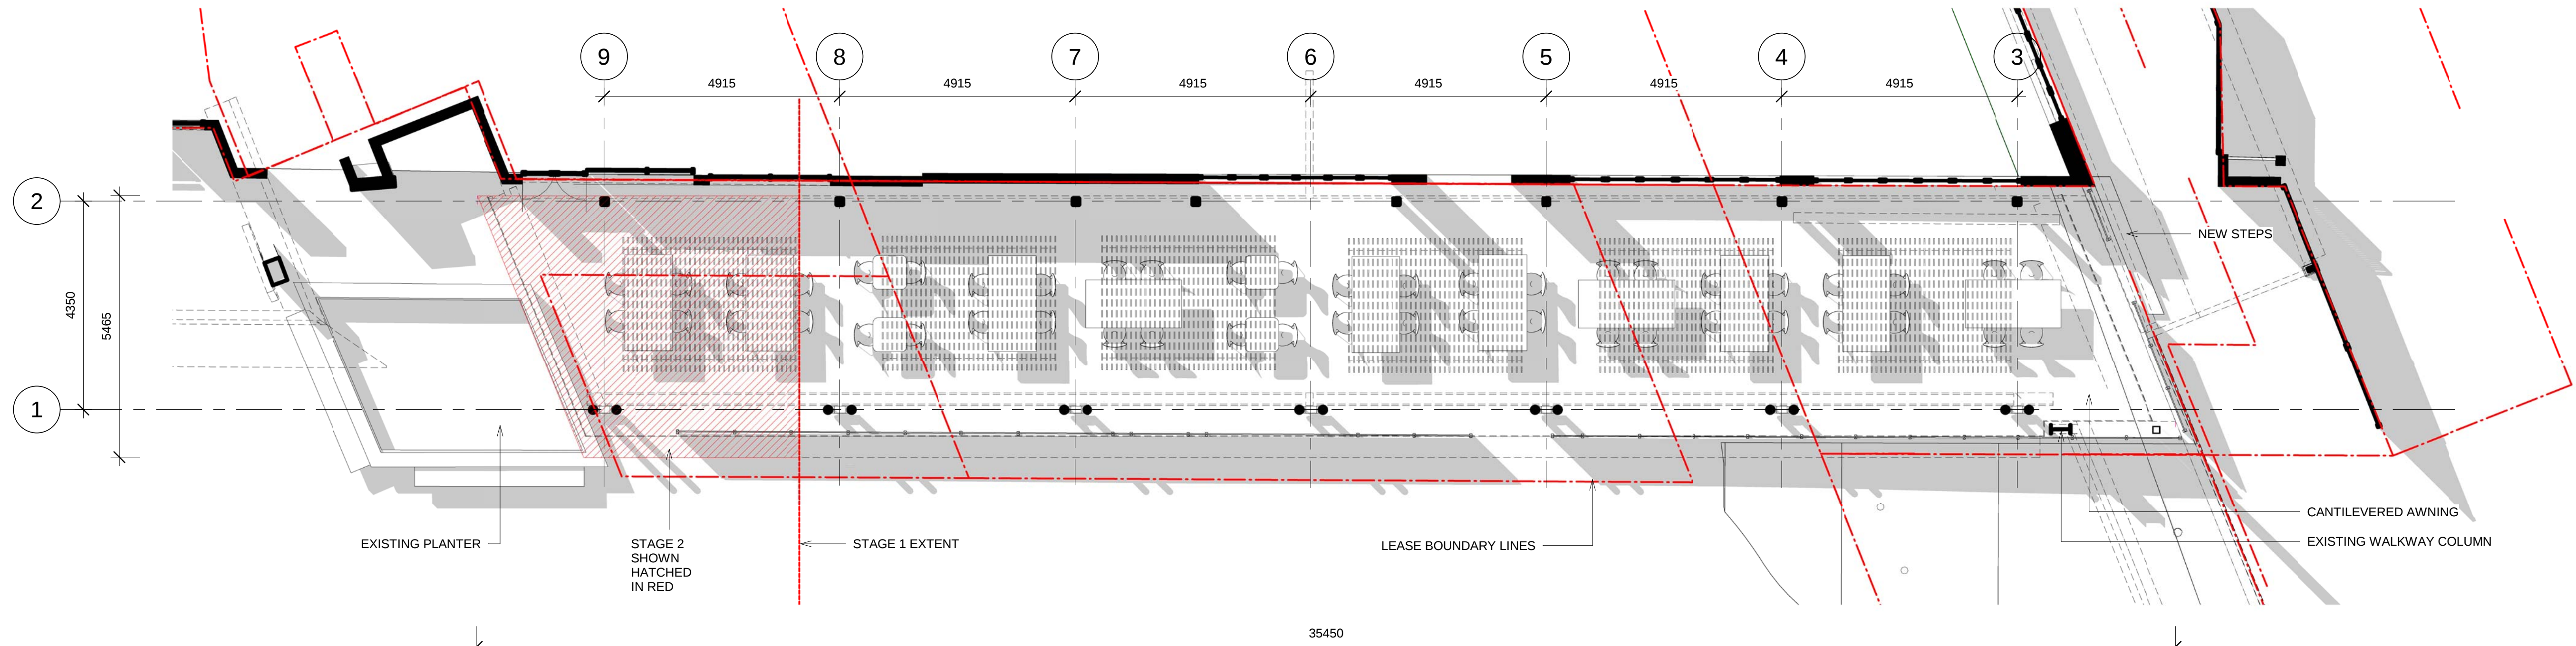

Plan
SCALE 1 : 75

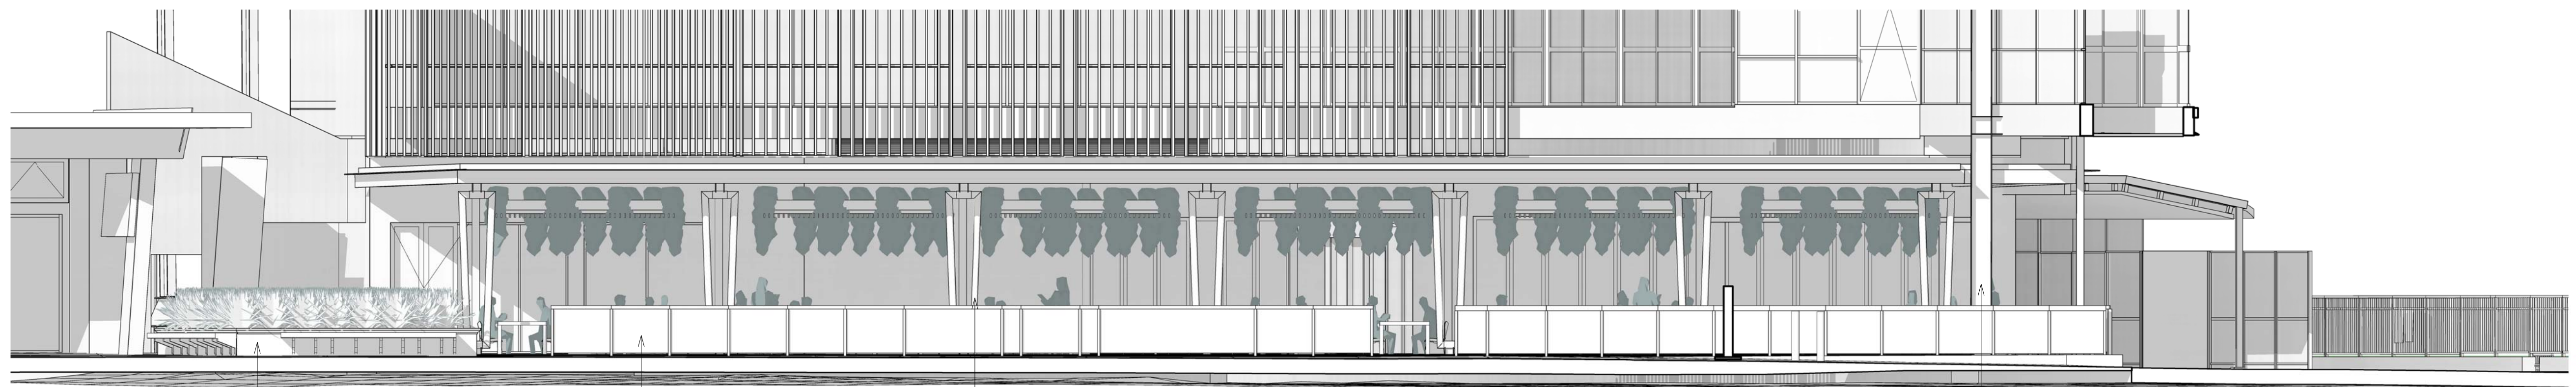

Elevation - Existing Balustrade
SCALE 1 : 75

Scale 1:75

0 0.75m 1.5m 3.75m 7.5m



COX

Cox Architecture

Level 2, 2 Edward Street,
Brisbane, QLD 4000, Australia
T + 61 7 3210 0844
F + 61 7 3210 0541

www.coxarchitecture.com.au

© COPYRIGHT COX ARCHITECTURE PTY LTD ACN 002 535 891
ANY FORM OF REPRODUCTION OF THIS DRAWING IN FULL OR IN PART WITHOUT THE WRITTEN
PERMISSION OF COX ARCHITECTURE PTY LTD CONSTITUTES AN INFRINGEMENT OF COPYRIGHT

Rev	Description	By	Date

Client

Project No.

Document Control Status:

Owner

419088

Project

Drawing Title

Gianni Awning

Portside

Plan - Option 1 - Existing
Balustrade

Co-ordinated:

Project Architect:

Project Director:

Drawing Number:

Drawn:

Checker

Author

Scale:

1 : 75 @ A1

Date:

02/08/21

Revision:

A104

Option 1 - Existing Balustrade

Ref: Perspective 1

AMENDED IN RED

By: Jake Pitt

Date: 26/07/2022


Queensland
Government

PLANS AND DOCUMENTS
referred to in the PDA
DEVELOPMENT APPROVAL

Approval no: DEV2022/1299

Date: 3 August 2022


Queensland
Government

Development approval limited to
proposed awning structure at
Shop 7, as shown in red.





Option 1 - Existing Balustrade

Ref: Perspective 2

AMENDED IN RED

By: Jake Pitt
Date: 26/07/2022



PLANS AND DOCUMENTS
referred to in the PDA
DEVELOPMENT APPROVAL

Approval no: DEV2022/1299
Date: 3 August 2022



Development approval limited to
proposed awning structure at
Shop 7, as shown in red.