

LOT YIELD BY LOT TYPE							
LOT TYPE	No.	No. %	AREA	AREA%	MINIMUM	MAXIMUM	AVERAGE
TCY1	8	100.00%	3164.00m ²	100.00%	375.00m ²	416.00m ²	395.50m ²
TOTALS	8	100%	3164.00m ²	100%	375.00m ²	416.00m ²	395.50m ²

LEGEND

 RECONFIGURATION OF A LOT APPLICATION NINE

MINIMUM RESIDENTIAL DENSITY 0.4464 ha
8 du
17.9 du/ha

MAXIMUM RESIDENTIAL DENSITY 0.4464 ha
8 du
17.9 du/ha

LAND USE BUDGET

RESIDENTIAL NEW ROAD - LOCAL 0.3164 ha
0.1300 ha

TOTAL ROL APPLICATION 9 AREA 0.4464 ha

PLANS AND DOCUMENTS referred to in the PDA DEVELOPMENT APPROVAL

Approval no: DEV2023/1369

Date: 18 April 2023



NOTE:
MINIMUM DWELLINGS is based on the development of one dwelling on each single family lot, two dwellings on each multi family strata (MFS) lot, and one dwelling on each multi family freehold (MFF).


MAXIMUM DWELLINGS for terrace (TCE) and multi family strata (MFS) lots is based on forzi flats on rear loaded terraces and the development of the maximum number of dwellings on 2014 lots.

DENSITY calculations include the area of residential lots, local roads and local parks.

The boundaries, roads and pathways shown hereon are subject to detailed engineering design, final survey and approval of subsequent development applications by the relevant authorities.

PRECINCT TWO - VILLAGE 4A (APPLICATION NINE) RECONFIGURATION OF A LOT

NOTE: This plan is indicative only, and specific uses, road alignment, boundaries, setbacks, and building layout shown may vary due to detailed design consideration. © 2022 Lendlease Communities (Australia). All rights reserved. Except as permitted by Lendlease, no part of this publication may be reproduced or distributed in any form or by any means, or stored in a database or retrieval system, without the permission of Lendlease.

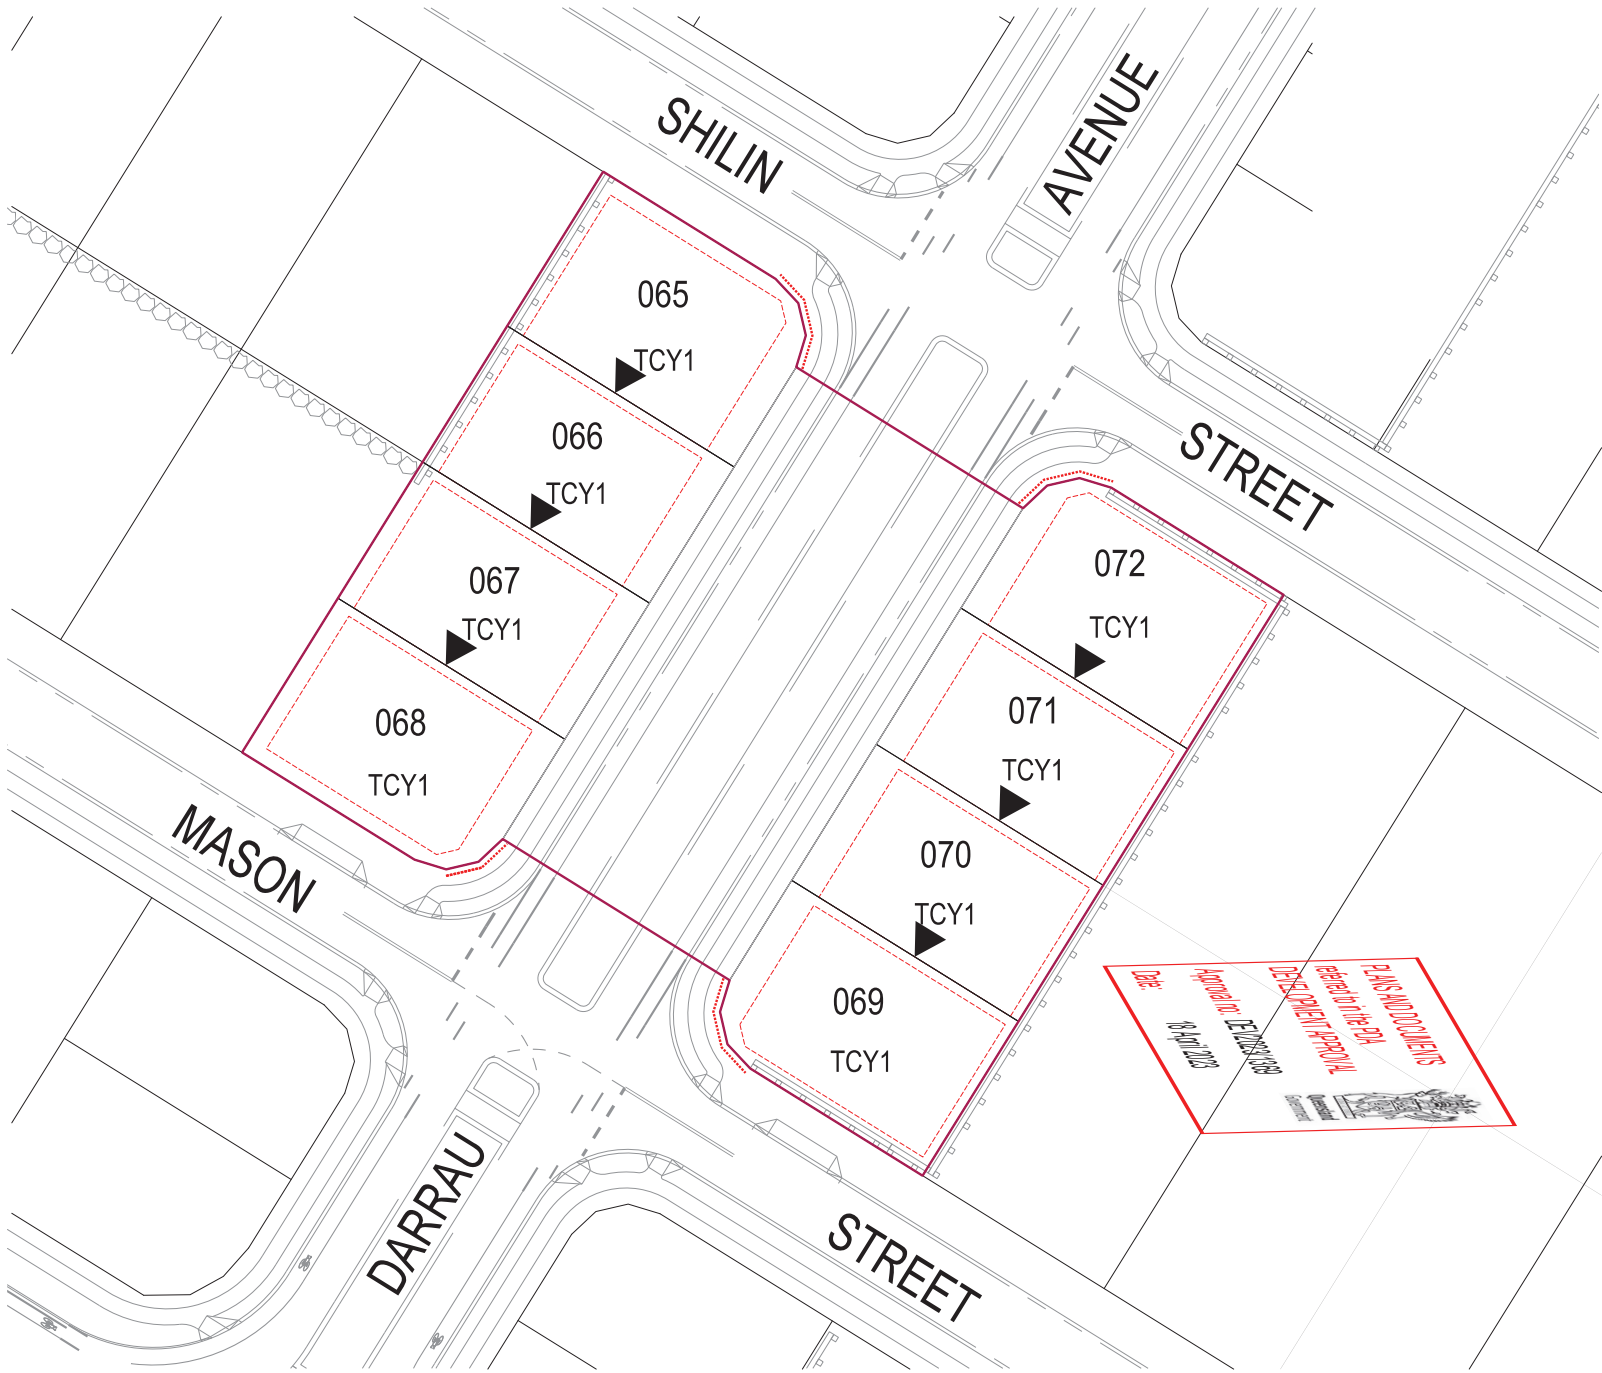

LEGEND

BUILD TO BOUNDARY LINE

MANDATORY BUILD TO BOUNDARY LINE NO VEHICULAR ACCESS

PROPOSED STAGE BOUNDARY

BUILDING ENVELOPE

MANDATORY PRIMARY STREET FRONTAGE

ACOUSTIC ATTENUATION REQUIRED IN DWELLING IN ACCORDANCE WITH THE RECOMMENDATIONS OF THE APPROVED TRAFFIC NOISE ADDENDUM PRECINCT 2, VILLAGE 4A PREPARED BY VIPAC

SETBACK TABLE

LOT TYPE	FRONT - PRIMARY FRONTAGE	REAR AND SIDE (to wall)	BUILD TO BOUNDARY	FIRST FLOOR SIDE	CORNER LOTS - SECONDARY FRONTAGE
(T1) TRADITIONAL 1	Ground floor 3.0	0.9	N/A	2.0	1.5
(T2) TRADITIONAL 2	Ground floor 3.0	0.9	N/A	1.5	1.5
(C1) COURTYARD 1	Ground floor 3.0	0.9	0.0	1.5	1.5
(C2) COURTYARD 2	Ground floor 3.0	0.9	0.0	1.5	1.5
(TCY1) TOWN COURTYARD 1	Ground floor 3.0	0.9	0.0	1.5	1.5
(TCY2) TOWN COURTYARD 2	Ground floor 3.0	0.9	0.0	1.5	1.5
(PV) PREMIUM VILLA	Ground floor 3.0	0.9	0.0	1.5	1.5
(TPV) TOWN PREMIUM VILLA	Ground floor 3.0	0.9	0.0	1.5	1.5
(V) VILLA	Ground floor 3.0	0.9	0.0	1.5	1.5
(TV) TOWN VILLA	Ground floor 3.0	0.9	0.0	1.5	1.5
(TC) TOWN COTTAGE	Ground floor 3.0	0.9	0.0	1.5	1.5
(TCF) TERRACE (FRONT LOADED)	Ground floor 2.4	0.9	0.0	0.0	1.0
(TCD) TERRACE (DUAL LOADED)	Ground floor 2.4	0.9	0.0	0.0	1.0
(MFS) MULTIFAMILY STRATA *	Ground floor 3.0	0.9	0.0	1.5	1.5
(MFF) MULTIFAMILY FREEHOLD	Ground floor 2.0	0.9	0.0	1.5	1.5
(SM) SMART LOT	Ground floor 3.0	0.9	0.0	1.5	1.5

* INCLUDES GARAGES


* CONSTITUTES MULTIPLE RESIDENTIAL DEVELOPMENT

NOTE: ALL GARAGES MUST BE SETBACK 5.0M TO THE FRONT WALL AT THE GARAGE AND A FURTHER 240mm TO THE GARAGE DOOR.

RETAINING WALL HEIGHT TABLE

LOT TYPE	Traditional	Town Courtyard	Premium Villa Town Premium Villa Town Cottage	Villa Town Villa	Terrace	MFF (Multi Family Freehold) MFS (Multi Family Strata)	Maximum Retaining Height
Front Boundaries	1.5	1.4	1.25	1.0	0.5	0.5	1.8
Side Boundaries	1.2	0.7	1.0 (Maximum height of 1.0 m)				1.0
Rear Boundaries	1.2	0.7	0.8	0.5	0.5	0.5	1.0
Road Boundaries	1.5	1.5	1.5	1.5	1.5	1.5	1.8

* Maximum height of 1.0 m

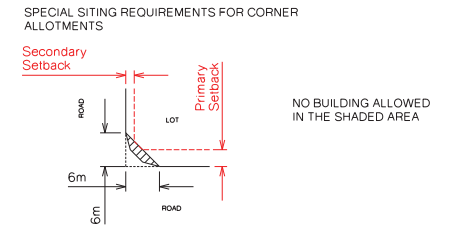

THESE CRITERIA MUST BE READ IN CONJUNCTION WITH RESIDENTIAL PLAN OF DEVELOPMENT SHEET 2 OF 2 [DGN No P02V04A-ROL9-POD230329] - DESIGN CRITERIA FOR RESIDENTIAL DEVELOPMENT

- 1. General:**
- Easements over infrastructure have not been shown which may affect setbacks. Eaves must not protrude into easements.
 - The maximum height of unattached buildings shall not exceed 8.5m above natural ground level. For attached buildings on lots greater than 450sqm a building height of 10.5m may be permitted as measured from the natural ground level.
 - It is assumed that the pad level of each block will be the average of the four corners of the block.
 - Buildings will be built to this pad level unless the consent of property owners on both sides of the block is obtained to vary the pad level.
 - ~~Acoustic treatment may be required for some lots, refer to report prepared by MWA Environmental.~~
 - Construction standards/setbacks may be affected by bushfire risk. Refer to the Sub-Precinct Specific Bushfire Hazard Assessment and Mitigation Plan for Sub-Precinct 4E Yarrabilba, prepared by Bushfire Protection Systems Pty Ltd.
- 2. Setbacks:**
- Setbacks are as per the Setback Table included on the Plan of Development unless otherwise specified.
 - All setbacks are measured to the wall. No projection will be closer to a side boundary than 450mm including gutter or fascia, with the exception of any eave returning to a build to boundary wall.
 - Front verandah and covered areas to the front door are permitted to extend into the front setback on the condition that the roofed area is not enclosed. For front setbacks, this roofed area can extend to 1.0m from the front property line.
 - The build to boundary line is nominated on this plan. The length of wall built to this boundary is not to exceed 15.0m (excluding the terrace product) unless specified otherwise in a Plan of Development. Parapets are considered to be a wall and are to comply with the Setback table included on the Plan of Development.
 - Buildings to be sited in accordance with the Special Siting Requirements for Corner Allotments.
 - Front setbacks on corner lots are determined by the frontage that the primary facade is addressing. The primary frontage is taken to be the frontage where the front door and letterbox is located.
 - Allotments containing or adjoining the lower face of a rear retaining wall exceeding 2.0 metres in height are required to have a minimum rear setback of 2.5m to the rear property boundary from the ground and second floor of the dwelling.
- 3. Site Cover and Amenity:**
- Site cover for each lot is not to exceed the following:
 - 80% for dual attached lots;
 - 65% for build to the boundary lots;
 - 60% for lots that do not use a build to boundary;
 - Total outdoor private open space accessible from the ground floor dwelling, either covered or uncovered, should be generally flat without any fall exceeding 70mm vertical or every 1.0 m horizontally. Private outdoor space excludes area for driveways and must include an area with a minimum dimension of 2.4m. The total outdoor space should equal at least 15% of the total site area.
- 4. Parking, Garages and Carports:**
- Each allotment must provide one covered car parking space.
 - Carports must include a roof design, design features and materials which are consistent with the form and materials of the home.
 - Carports must include either a garage door at the front or screening to the rear.
 - Any column or wall provided to support a carport must be set back a minimum of 5.0m from the front boundary of the property.
- ~~For garages on front loaded lots less than 10m in width the following criteria must be met:~~
- ~~Single storey homes must have a single or tandem garage.~~
 - ~~Double storey homes can have a double garage provided the 2nd floor front wall or balcony is a minimum of 500mm forward of the garage wall.~~
- 5. Driveways:**
- The driveway must be laid at the grade of the adjacent verge area. No grade change to the verge for the construction of a driveway will be allowed.
 - Where there is a footpath within the verge, the driveway prevails, i.e. the portion of the footpath where the driveway crosses is removed.
 - Maximum driveway grades within lots must not exceed 1:5 or 1:4 with transitions at both ends of the driveway.
 - Driveways must be offset at least 300mm from the side property boundary.
 - Driveways must be completed prior to occupation and be located as shown on the approved Functional Layout Roadworks Plan, unless otherwise agreed by DSDMP.
 - Driveways across the verge cannot exceed 3.0m for a single garage or 5.0m for a double garage.
 - Driveways, unless varied by a provision above, shall accord with Logan City Council's standards (except for the driveway siting requirements in relation to intersections which is as per the approved POD). Prior to construction, approval from Logan City Council for Vehicular Access to Residential Premises is required.
- 6. Retaining Walls, Earthworks and Sloping Land (where occurring following construction by Lendlease):**
- Retaining wall heights must not exceed those nominated in the Retaining Wall Heights table included on the Residential Plan of Development.
 - If these requirements are not able to be achieved, construction methods other than slab on ground construction are to be used.
 - If elevated construction is to be used, under floor services must be located or screened to minimise their appearance to adjoining properties and public spaces.
 - Retaining walls along street or park frontages cannot exceed 1.0 m in height. A planted strip of a minimum width of 500mm must exist between any terraced retaining walls.
 - Retaining walls to side boundaries between lots cannot exceed 1.8 metres high at the front wall of the house and must taper down to natural ground level forward of the house.
 - Retaining walls over 900mm high require a 1 metre high fence above the wall and adequate landscape screening.
 - Where the block allows for build to the boundary, the build to the boundary wall must be projected to 150mm below the likely pad level of the adjacent block. The pad level can be assumed to be the average of the four corners of the adjacent block using the As Built levels. The build down or the build to boundary wall must be in a material consistent with the wall above it.
 - The front wall of the home must not be more than 50% below the midpoint level of the front boundary.
- 7. External Building Materials:**
- No raw, unfinished or untreated materials are permitted for external building works. This includes galvanised iron, zinc or aluminium coated steel, corrugated or unpainted fibre cement sheeting and bare, painted or uncoloured concrete block work or commons brickwork.
- 8. Front Facade Articulation:**
- Facades of the home fronting the street must include a highly visible entry and include a substantial verandah or include two materials or finishes to the entry.
 - Homes must include articulation between the alignment of the front wall and the garage on the primary frontage. The minimum acceptable alignment variation is 560mm. Garages are permitted to be a maximum 1.0m forward of the front building wall where the roof of the entry is positioned forward of the roof of the garage.
 - Double storey homes which incorporate a verandah or balcony to the first floor to at least 40% of the front elevation width, do not require articulation between the alignment of the front wall and the garage.
- 9. Homes with more than one Visible Facade (Corner Homes/Homes with frontage to park):**
- Homes on corners or with park frontage must provide feature windows and detailing to match the front elevation along the secondary frontage or extend the detailing of the priority street facade to the front four metres of the secondary frontage.
- 10. Fencing:**
- Any fencing on the primary street frontage is to be a maximum of 1.2 metres in height and decorative in style, except for regulation fencing required around pools.
 - Fencing up to 1.5 m in height will be permitted on primary street frontages if it is:
 - a open style fence that is 50% transparent; or
 - is a courtyard wall constructed of face brickwork or masonry piers with coloured render or textured finish
 - Fencing provided to a secondary street frontage can be up to 1.8 metres in height and must be decorative fencing.
 - All side fencing must either return to the house a minimum of 1.0 metre behind the front building line or continue forward of the front building line as decorative fencing.
 - Decorative fencing is to be constructed of rendered and painted masonry piers or painted or stained posts, with infill panels of coloured metal tube, painted or stained timber palings or horizontal battens. Timber paling fences will only be accepted if they are painted and treated with decorative capping or trims and provided with pronounced posts.
 - Secondary street frontage fencing must finish 4 metres behind the front wall of your home.
 - Untreated or coloured metal sheeting or fibrous cement is not acceptable as a decorative fence.
 - Fencing and retaining walls erected by Lendlease must not be altered, removed or modified in any way, without the prior written approval from Lendlease.
- 11. Landscaping:**
- At least 50% of your front yard is landscaped with grass and/or garden beds. 25% of the front yard must be planted garden beds with trees and/or shrubs capable of growing to 3 metres tall and at least 600mm high at the time of planting. Refer to the preferred Yarrabilba plant species list for guidance.
- 12. Outdoor Structure and Services**
- All outdoor structures visible from the street or public spaces including but not limited to, roof or wall mounted air-conditioning units, satellite dishes, antennas, sheds, water tanks and clotheslines must be suitably screened and located to minimise detrimental visual impact.
 - Solar panels and collectors for hot water units are the exception to this standard when orientated to maximise their effectiveness.

- 13. Houses on Narrow Residential Lots (10m-12.49m in width):**
- ~~Houses on Lots 10m-12.49m in width must adhere to the following design criteria:~~
- ~~The front facing building wall, which comprises the garage door must not exceed an external width of 5.7m.~~
 - ~~The garage door:

 - Width must not exceed 4.8m;
 - Must have a minimum 450mm eave above it;
 - Must be setback a minimum of 240mm behind the garage door; and
 - Must have a sectional, tilt or a roller door.~~
 - ~~The front facade of the dwelling must be forward of the alignment of the garage wall and must include the following:

 - A front entrance door and windows and a side light;
 - A front verandah, portico or porch located over the front entrance, which extends a minimum of 1600mm forward of the entrance door;
 - The verandah, portico or porch is to include front piers with distinct materials and / or colours.~~
- 14. Residential Lots with Park Frontage:**
- ~~Fencing along park frontages must be:

 - 1.2m high solid; or
 - Up to 1.8m high if containing openings that make it more than 50% transparent.~~
 - ~~Dwellings are designed to include habitable rooms that face the park.~~
- 15. Secondary Dwellings**
- | | |
|---|--|
| Minimum Lot Size | Secondary dwellings are not permitted on lots less than 400sqm in size. |
| Floor Area of Secondary Dwelling | Maximum 60sqm GFA |
| Design and Siting of buildings and structures | The dwelling / secondary dwelling must have the design effect of one (1) single dwelling from the road / street frontage or within public view. |
| Materials and Detailing | Materials, detailing, colours and roof forms and consistent with those of the primary house. |
| Outdoor Living Space | Minimum 9sqm with a minimum dimension of 3m and directly accessible from a main living area. |
| Driveway | The secondary dwelling must share the driveway of the primary dwelling. |
| Car Parking and Garaging | Minimum one space in addition to the primary dwelling requirement – with minimum dimensions of 5m x 3m. |
| Street Surveillance | On a single street frontage, the secondary dwelling entry must be hidden from view from the street, so as to give the effect that the home is one (1) single residential dwelling. |
| Letterboxes | Any secondary dwelling is not permitted its own letterbox and must be shared with the primary dwelling. |
| Titling | Any secondary dwelling is unable to be separately titled to the primary dwelling. |
| Separate Services | No separate infrastructure servicing to the secondary dwelling is permitted (i.e., water, gas, electricity). |

- 16. Criteria for Variations to an approved plan assessed via compliance assessment:**
- Applications for compliance assessment to vary the layout must be in accordance with the criteria outlined below. Changes that are not in accordance with these criteria will require lodgement of a change application, pursuant to Section 99 of the Economic Development Act 2012.
- ~~Minor variation to the boundaries of parks subject to achieving the following:

 - The size of the park does not vary by +/- 5%;
 - The boundary of a park does not vary by more than 10m in any direction; and
 - No change to the location and classification of the proposed park are made; and
 - Minimum park size and embellishments under Community Greenspace IMP and EDQ Park Planning and Design Guideline 12 and met; and if it is required to accommodate a pad mount transformer with a maximum area of 5m x 5m.~~
 - ~~Minor variations to the road network subject to achieving the following:

 - The classification of the road is not varied;
 - The location of a road is moved by not more than 10m in any direction;
 - Any change to a road location does not result in a new intersection within 50m of another intersection; and
 - The change of the road does not result in a block length of more than 200m; and
 - Retains grid or modified grid responsive to site characteristics; and
 - Does not result in an additional cut-de-sac; and
 - Demonstrate the variation accords with provisions within Guidelines 5, 6 and 13.~~
 - ~~Variation to lots subject to achieving the following:

 - The total number of lots is within +/- 5% of the number of lots already approved; and
 - The footprint of the lots is within the existing residential lot footprint (with the exception being where a road is moved in accordance with the provisions in Item b(i) above); and
 - It can be demonstrated where a lot increase is proposed that adequate on-street parking exists for visitors to the lots; and
 - Where a paramount transformer is required max 5m x 5m.~~
 - ~~Variation to the approved POD where:

 - To amend setbacks as a result of a lot change; or
 - To change the location of a built to boundary wall or driveway;
 - It is noted a compliance assessment process cannot be used once any lot in the stage subject to the change has been sold.~~
 - ~~Variations to staging or creation of sub-stages:

 - Permitted when not resulting in a park being created in a stand-alone stage or where a park is in the final stage with less than 10 residential lots associated with it.~~
- Where a variation is proposed, the applicant must submit to EDQ for compliance assessment:**
- ~~A statement demonstrating compliance with the criteria above and relevant section of PDA Guidelines and Practice Notes.~~
 - ~~Where minor variations are required due to detailed engineering design a statement outlining the~~
 - ~~Reason for the variation and how the variation responds to Guidelines 13 Engineering Standards.~~
 - ~~Updated ROL and POD plans as applicable.~~
 - ~~Updated Functional Layout Plans (if applicable).~~

- 17. Electrical Supply:**
- Each dwelling is to include a separate dedicated electrical circuit (conduit and wiring) into the garage or carport to enable the installation of Electric Vehicle Supply Equipment. Where Not used for Electric Vehicle Supply Equipment, the circuit is to be fitted with a minimum 15amp GPO outlet.

PLANS AND DOCUMENTS referred to in the PDA DEVELOPMENT APPROVAL

Approval no: DEV2023/1369

Date: 18 April 2023



AMENDED IN RED

By: Matthew Buchanan

Date: 22 March 2023




THESE CRITERIA MUST BE READ IN CONJUNCTION WITH RESIDENTIAL PLAN OF DEVELOPMENT SHEET 1 [Dgn No. P02V04A-ROL9-POD230125]

PRECINCT TWO - VILLAGE 4A (APPLICATION NINE) RECONFIGURATION OF A LOT PLAN OF DEVELOPMENT

NOTE: This plan is indicative only, and specific uses, road alignment, boundaries, setbacks, and building layout shown may vary due to detailed design consideration. © 2023 Lendlease Communities (Australia). All rights reserved. Except as permitted by Lendlease, no part of this publication may be reproduced or distributed in any form or by any means, or stored in a database or retrieval system, without the permission of Lendlease.



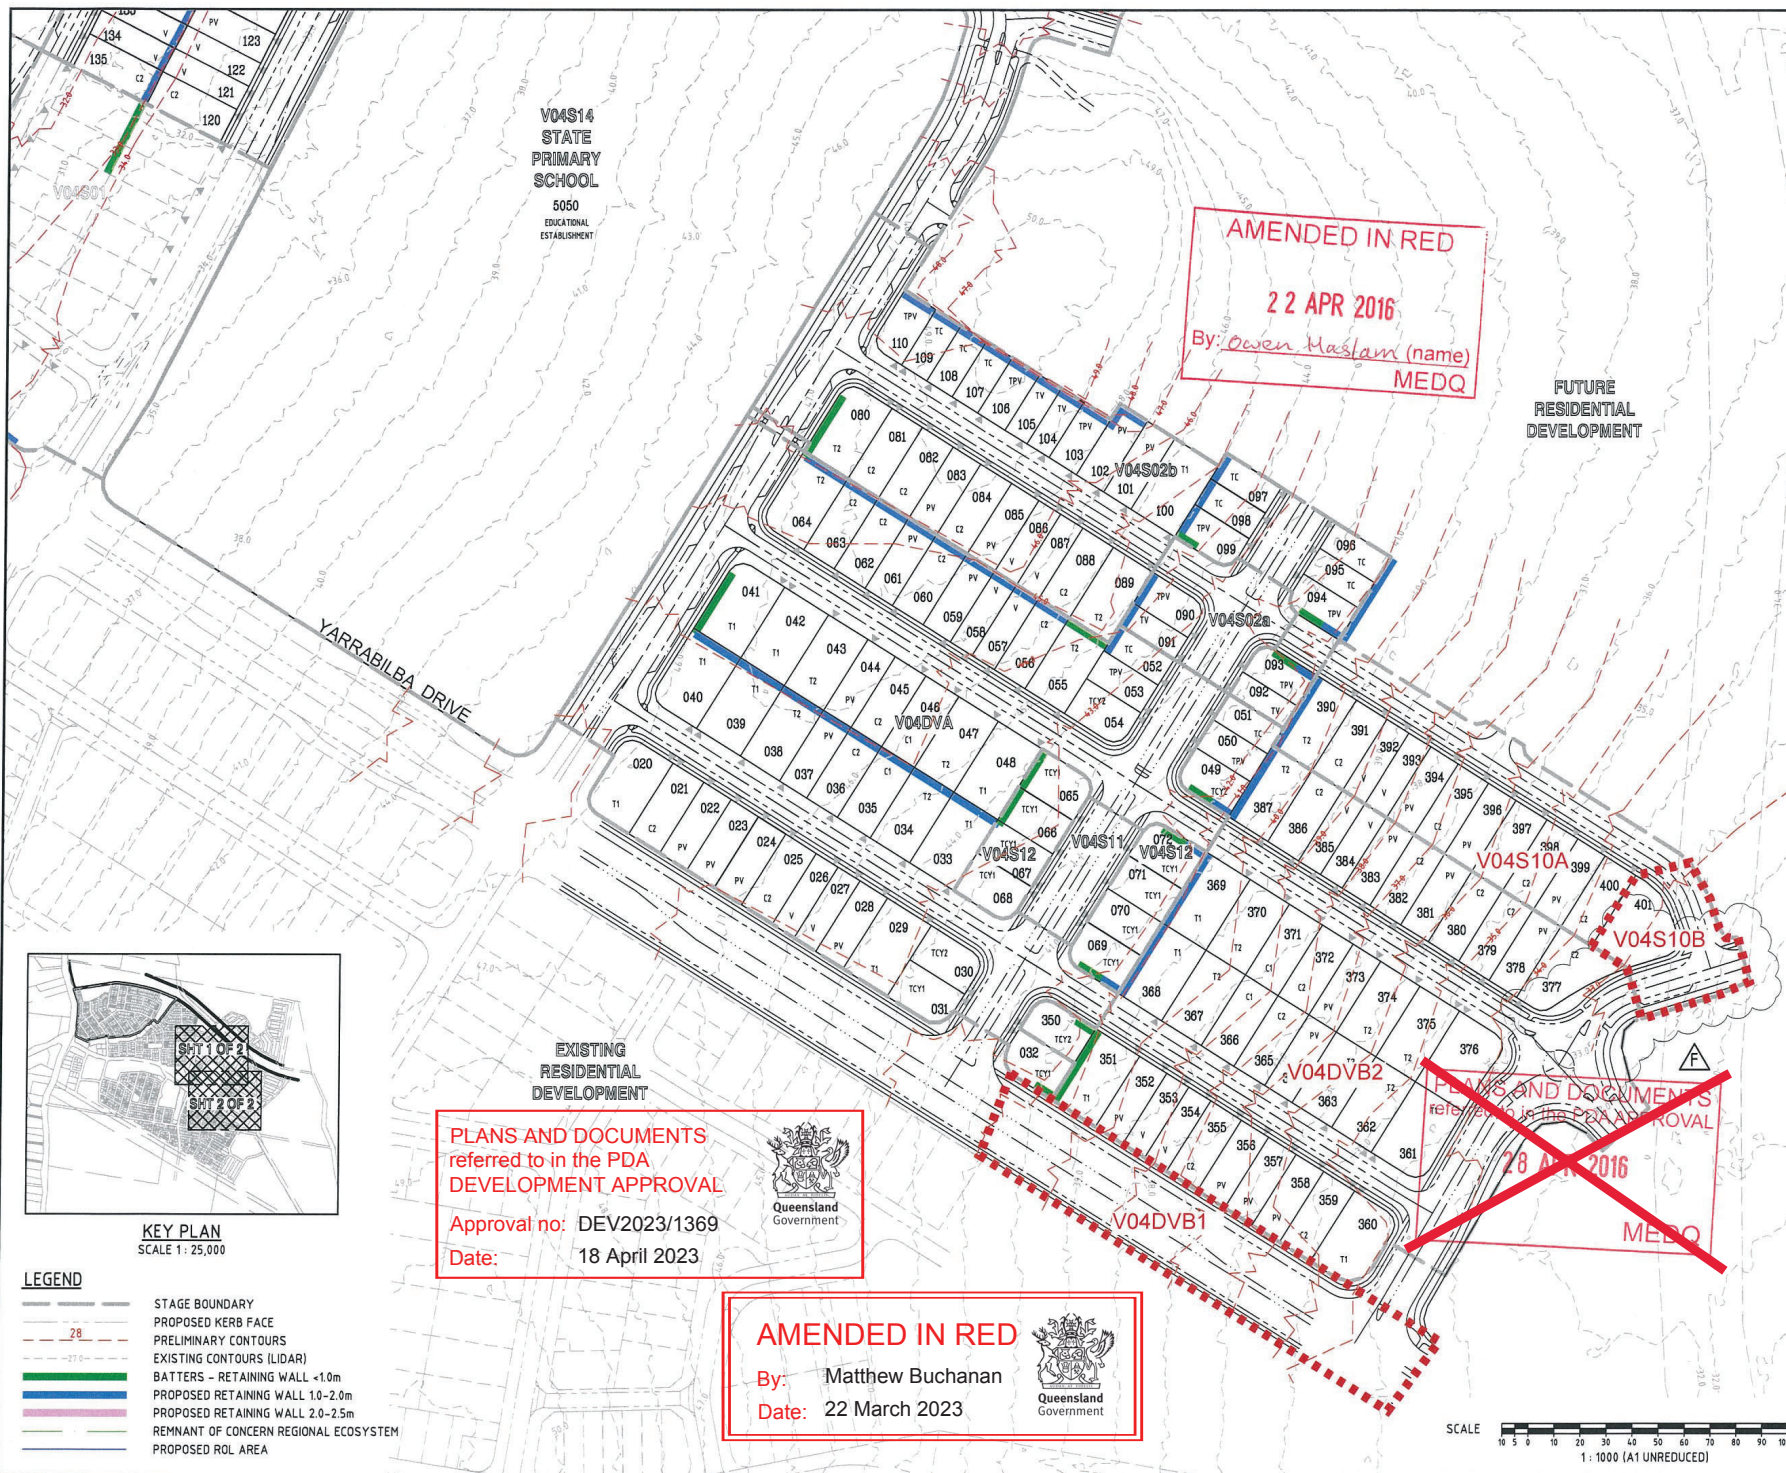

DO NOT SCALE THIS DRAWING
IF IN DOUBT - ASK!

LOCALITY PLAN

YARRABILBA PRECINCT 2

YARRABILBA

REVISIONS

No.	Description	Date	By
A	APPROVAL	04/12/14	I.O.C.
B	EDQ COMMENTS	19/02/15	I.O.C.
C	EDQ COMMENTS	06/03/15	I.O.C.
D	ROUNDABOUT AND LOTS AMENDED	26/04/15	BL
E	PATHS AND BOUNDARY AMENDED	13/07/15	JAS
F	ROAD RESERVE WIDENED	29/02/16	IOC

Associated Consultants:

RPS
RPS Australia East Pty Ltd
ACN 143 292 712
ABN 141 142 292 712
Suite 4, Robina East Quay Corporate Park,
North Building 34-38 Sherbourne Drive, Robina
PO Box 1048 Robina QLD 4225
T +61 7 555 36000
F +61 7 555 36009
W rpsgroup.com.au

Client:

Lend Lease

Project:

YARRABILBA
PRECINCT 2
PRELIMINARY PLANNING
FUNCTIONAL DRAWING

KN GROUP PTY LTD
CONSULTING ENGINEERS

LEVEL 2 - 71 GREY STREET
SOUTH BRISBANE
QUEENSLAND 4101
PHONE 07 3017 1900
FAX 07 3017 1911
EMAIL kn@knpl.com.au
ABN 35 112 053 611


Approved - RPEQ 12805

Drawing Title:

**V04 FUNCTIONAL LAYOUT
EARTHWORKS PLAN
SHEET 2 OF 2**

Drawn	Designed	Checked	Date
JS/EL	I.O.C.	GBG	DEC '14


Scale	Drawing No.	Revision
1:1000 (A1 UNREDUCED)	13-106-SK108	F

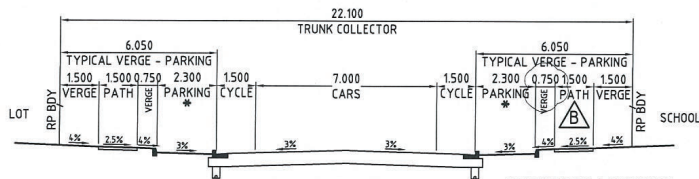

TRUNK COLLECTOR


J SECTION
101 SCALE 1:100

* DENOTES CAR PARKING NOT CONTINUOUS ALONG STREET. VERGE WIDTH ADJUSTS WITH/WITHOUT CAR PARKING

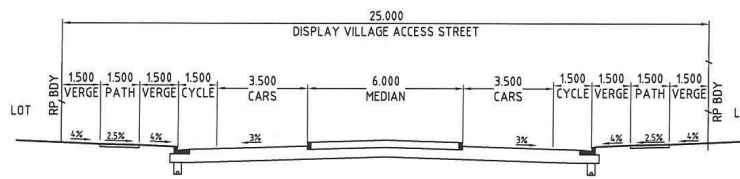

DISPLAY VILLAGE ACCESS STREET


K SECTION
101 SCALE 1:100

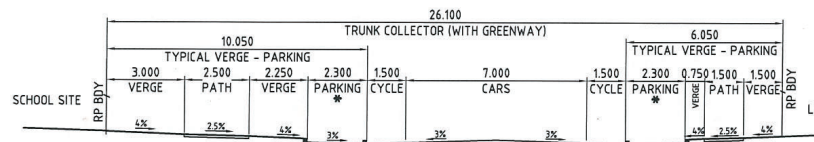

TRUNK COLLECTOR

L SECTION
102 SCALE 1:100


* DENOTES CAR PARKING NOT CONTINUOUS ALONG STREET. VERGE WIDTH ADJUSTS WITH/WITHOUT CAR PARKING

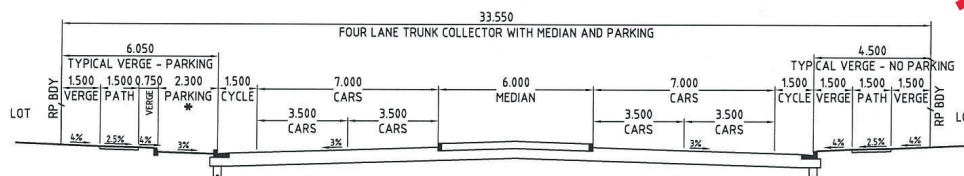

FOUR LANE TRUNK COLLECTOR WITH MEDIAN AND PARKING


M SECTION
102 SCALE 1:100

* DENOTES CAR PARKING NOT CONTINUOUS ALONG STREET. VERGE WIDTH ADJUSTS WITH/WITHOUT CAR PARKING

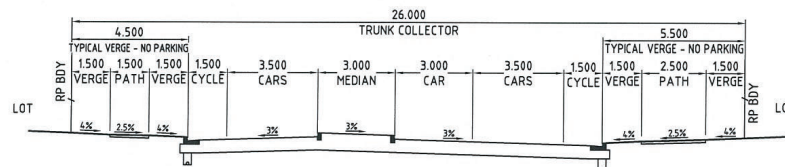


TRUNK COLLECTOR

N2 SECTION
102 SCALE 1:100

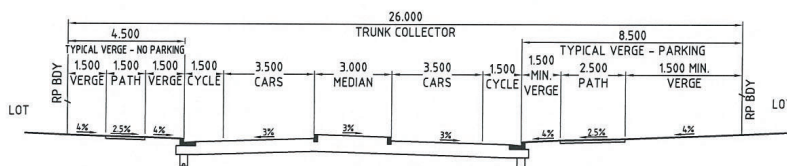

TRUNK COLLECTOR

N SECTION
102 SCALE 1:100

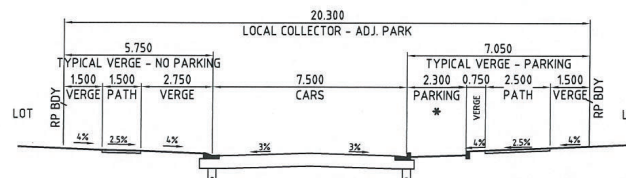

LOCAL COLLECTOR

N1 SECTION
102 SCALE 1:100

* DENOTES CAR PARKING NOT CONTINUOUS ALONG STREET. VERGE WIDTH ADJUSTS WITH/WITHOUT CAR PARKING

PLANS AND DOCUMENTS referred to in the PDA APPROVAL

28 APR 2016

MEDD

AMENDED IN RED

By: Matthew Buchanan

Date: 22 March 2023




NB
KERB TYPES TO BE CONFIRMED
DURING DETAILED DESIGN

PLANS AND DOCUMENTS referred to in the PDA DEVELOPMENT APPROVAL

Approval no: DEV2023/1369


Date: 18 April 2023

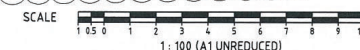

DO NOT SCALE THIS DRAWING
IF IN DOUBT - ASK!



LOCALITY PLAN

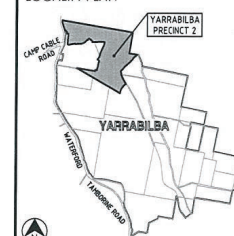

REVISIONS

No	Description	Date	By
B	WIDTH AMENDED	06/02/16	LOF
C	SECTION NAME/SECTION NO ADDED	13/02/16	JAS
D	ROAD RESERVE WIDENED	29/02/16	IOC

Associated Consultants



Client



Project

YARRABILBA
PRECINCT 2
PRELIMINARY PLANNING
FUNCTIONAL DRAWING



LEVEL 2 - 71 GREY STREET
SOUTH BRISBANE
QUEENSLAND 4101
PHONE 07 3017 1900
FAX 07 3017 1911
EMAIL kn@knpl.com.au
ABN 35 112 053 611

Approved - RPEG 12803

Drawing Title

**V04 FUNCTIONAL LAYOUT
TYPICAL SECTIONS
SHEET 2 OF 2**

Drawn	Designed	Checked	Date
AS SHOWN		GBG	DEC '14
Scale	Drawing No	Revision	
A1	13-106-SK104	D	

