




DRAWING NO.	DRAWING TITLE
24-277-01	GENERAL - LOCALITY PLAN, DRAWING INDEX AND NOTES
24-277-02	GENERAL - SETOUT PLAN
24-277-03	GENERAL - LAYOUT PLAN
24-277-04	GENERAL - PAVEMENT PLAN
24-277-05	EARTHWORKS - CONTOUR PLAN
24-277-06	EARTHWORKS - SPOT LEVELS PLAN
24-277-07	ROADWORKS - LONG AND CROSS SECTIONS - NEW ROAD 3
24-277-08	ROADWORKS - LONG AND CROSS SECTIONS - NEW ROAD 4 & 5
24-277-09	ROADWORKS - INTERSECTION DETAILS
24-277-10	ROADWORKS - LINEMARKING PLAN
24-277-11	STORMWATER - CATCHMENT PLAN
24-277-12	STORMWATER - LONG SECTIONS
24-277-13	STORMWATER - LONG SECTIONS
24-277-14	STORMWATER - MANHOLE DETAILS
24-277-15	STORMWATER - CALCULATION TABLE - SHEET 1
24-277-16	STORMWATER - CALCULATION TABLE - SHEET 2
24-277-17	SEDIMENT AND EROSION - CONTOUR PLAN - POST CONSTRUCTION
24-277-18	SEDIMENT BASIN NOTES
24-277-19	PREFERRED BENCHING PLAN
24-277-20	SAFETY AND DESIGN

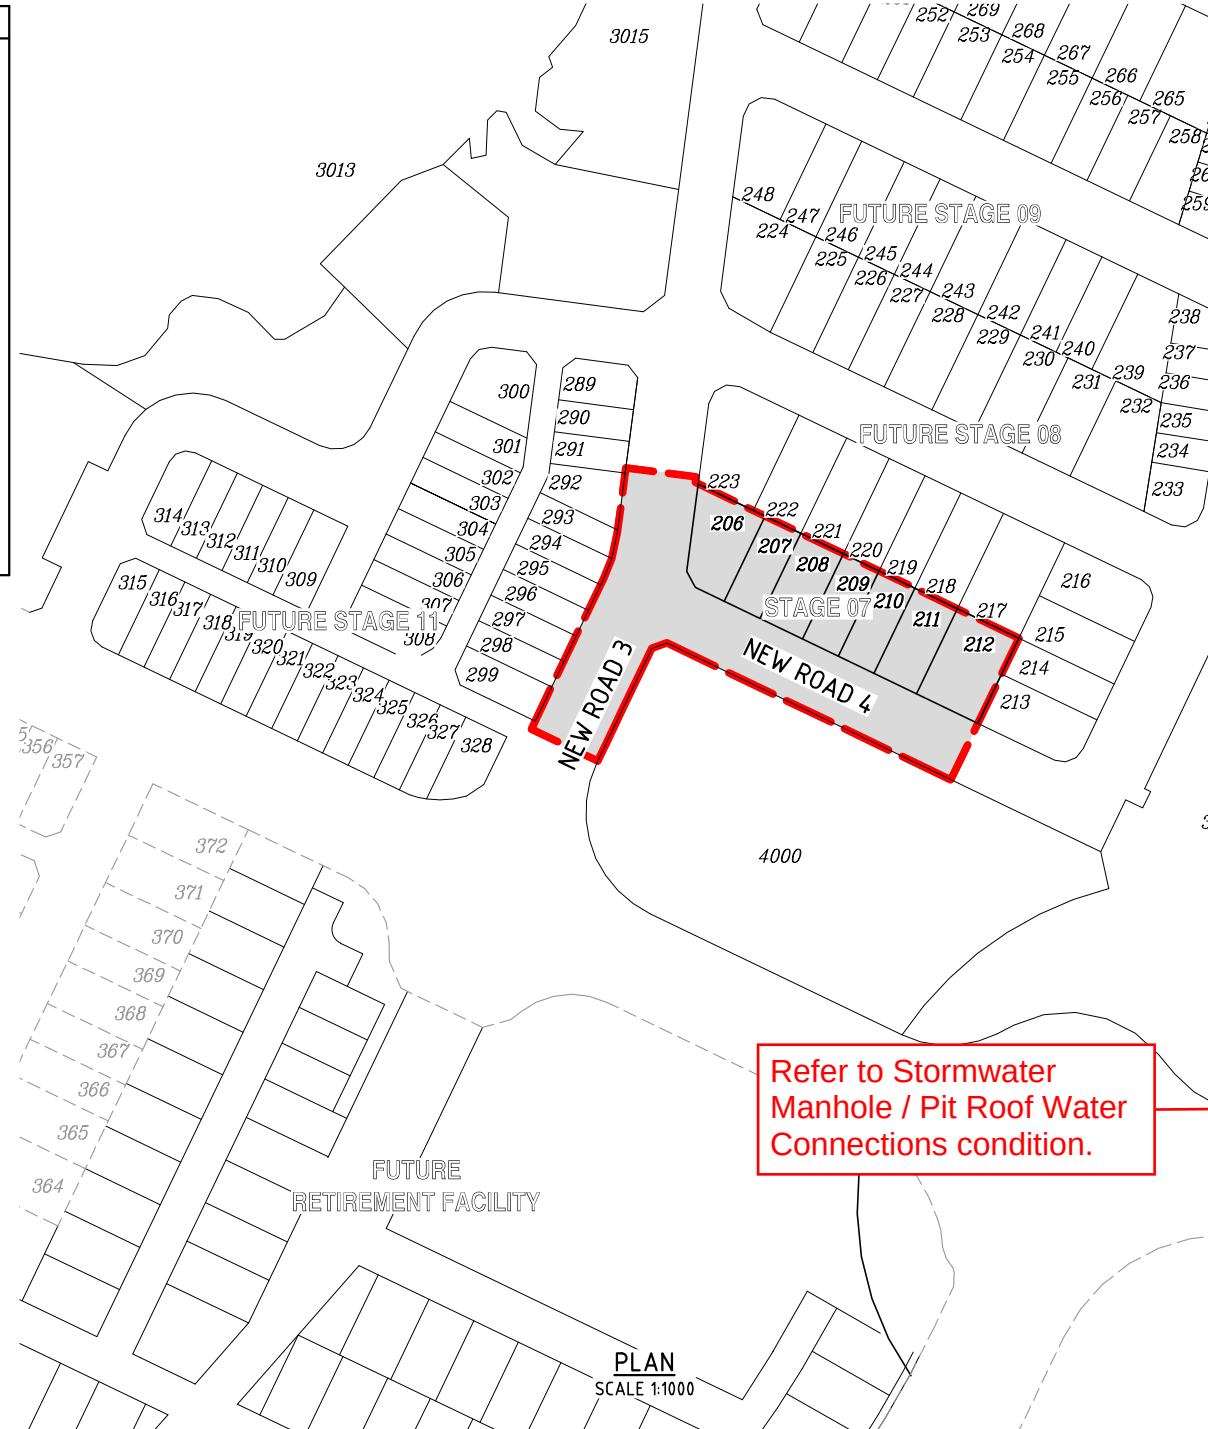

1. ALL WORK SHALL BE JOINED NEATLY TO EXISTING CONSTRUCTION.
2. WHERE REFERENCE IS MADE ON THESE DRAWINGS TO A KERB LINE, IT SHALL BE TAKEN TO MEAN THE KERB INVERT LINE.
3. LEVELS FOR KERB AND CHANNEL CONSTRUCTION ARE SHOWN AT LIP OF CHANNEL UNLESS SHOWN OTHERWISE.
4. KERB AND CHANNEL AND SPOON DRAINS SHALL BE CONSTRUCTED IN ACCORDANCE WITH INSTITUTE OF PUBLIC WORKS ENGINEERING AUSTRALIA STANDARD DWG NO SEQ R-080. SPOON DRAINS ACROSS ROAD INTERSECTIONS SHALL BE IN ACCORDANCE WITH INSTITUTE OF PUBLIC WORKS ENGINEERING AUSTRALIA STD DWG NO SEQ R-080. THE CONCRETE SHALL BE CLASS N32 AND THE DEPTH INCREASED BY 50mm TO 175mm AT INVERT. FLUSH KERB TO BE INCREASED IN DEPTH BY 50mm TO 280mm.
5. IF MACHINE MADE KERB AND CHANNEL IS USED, EXTRA FINES AND 20mm SLUMP IS REQUIRED.
6. ALL DRAINAGE CENTRE LINES ARE TO BE 1.5m FROM INVERT OF KERB FOR 6.0m WIDE ROADS AND 2.0m OFF THE INVERT OF THE KERB FOR ALL OTHERS, UNLESS OTHERWISE SHOWN.
7. GULLY CONNECTIONS AND STORM WATER PIPES SHALL BE 375mm DIAMETER CLASS '3' R.C. PIPES UNLESS SHOWN OTHERWISE.
8. THE CONTRACTOR SHALL INITIALLY EXCAVATE THE PAVEMENT BOX TO 225mm BELOW THE FINISHED PAVEMENT LEVEL SHOWN ON THE DRAWINGS. HE SHALL THEN NOTIFY THE ENGINEER WHO WILL FIX THE PAVEMENT THICKNESS TO BE CONSTRUCTED FOLLOWING THE RESULTS OF SUB-GRADE TESTING.
9. NOTWITHSTANDING THE LIMITS OF CUTTING AND FILLING SHOWN ON THE DRAWINGS, THE ACTUAL LIMITS SHALL BE DETERMINED ON SITE BY THE ENGINEER AND SIMILARLY THE FINISHED SURFACE CONTOURS MAY BE ADJUSTED BY WRITTEN DIRECTION OF THE ENGINEER DURING CONSTRUCTION.
10. THE MINIMUM CLEARANCE BETWEEN OUTER WALLS OF PIPES IN MANHOLES SHALL BE 150mm.
11. SUBSURFACE DRAIN CLEANING POINTS SHALL BE INSTALLED IN ACCORDANCE WITH IPWEAQ STD DWG NO SEQ R-140.
12. CONSTRUCTION LOAD CONTROL ON THE INSTALLATION OF REINFORCED CONCRETE STORMWATER PIPE WORK SHALL BE UNDERTAKEN IN ACCORDANCE WITH THE RECOMMENDATIONS DEFINED IN THE CONCRETE PIPE ASSOCIATIONS OF AUSTRALASIA'S "THE INSTALLATIONS OF STEEL REINFORCED CONCRETE PIPES - MINIMUM PIPE COVER REQUIRED FOR VARIOUS COMPACTORS".
13. PRIOR TO COMMENCEMENT OF CONSTRUCTION, THE CONTRACTOR SHALL ERECT A STARPICKET AND 2 STRAND WIRE FENCE TO THE PERIMETER OF VEGETATION TO BE RETAINED.

1. uP.V.C. SEWER PIPES TO BE USED SHALL BE :-
(a) PIPES - CLASS SH (TO AS 1260)
(b) FITTINGS - CLASS M (TO AS 1260)
2. THE MINIMUM COVER TO ALL ROOFWATER DRAINAGE LINES SHALL BE 300mm FOR FRC AND 450mm FOR uPVC. EXCEPT IN THE CASE OF 100mm DIAMETER LINES DISCHARGING THROUGH KERB INTO CHANNEL.
3. THE ENDS OF 100mm ROOFWATER CONNECTIONS FROM LOT DIRECTLY TO GULLY PIT SHALL BE CAPPED AND LOCATED WITH NOT LESS THAN 300mm AND NOT MORE THAN 450mm COVER UNLESS OTHERWISE APPROVED.
4. ALL ROOFWATER LINES TERMINATING IN THE KERB AND CHANNEL SHALL BE LAID AT A MINIMUM GRADE 1 IN 50 AND SHALL HAVE A 'KACEY' CAST ALUMINIUM KERB ADAPTOR OR EQUIVALENT.
5. THE ENDS OF ALL LINES SHALL BE PLUGGED WITH APPROVED FITTINGS.
6. PROVIDE 2 KERB ADAPTORS FOR ALL LOTS. ALL KERB ADAPTORS SHALL BE CAST INTO KERB AND CHANNEL UNLESS PIPED CONNECTION TO SW STRUCTURE PROVIDED.
7. WHERE THE COVER IS LESS THAN 400mm FOR ROOFWATER THE PIPE CLASS SHALL BE SEH uPVC.
8. THE KERB ADAPTOR SHALL BE LOCATED SO THAT ITS CENTRE LINE IS 300mm FROM THE PROJECTION OF THE SIDE BOUNDARY AT THE KERB LINE.

Refer to Stormwater
Manhole / Pit Roof Water
Connections condition.



Queensland
Government

[illegible]

Stockland

RIVERMONT
PRECINCT 2
STAGE 7



kn group

Approved Director - RPEQ 17544
M. Shaw
 Digitally signed by Mark Shaw RPEQ 17544
 Date: 2026.06.08 14:42:45+10'00'

Drawing Title

GENERAL
LOCALITY PLAN,
DRAWING INDEX AND NOTES

Drawn DF	Designed JB	Checked MAS	Date MAY' 26
Scale AS SHOWN			Sheet 01 of 20
A1	Drawing No 24-277-01		Revision B


SCALE 
1 : 1000 (A1 UNREDUCED)



NEW ROAD 4 CONTROL LINE DETAILS								
PT	CHAINAGE	EASTING	NORTHING	HEIGHT	BEARING	RAD/SPIRAL	A.LENGTH	DEFL.ANGLE
IP 1	0.00	8656.769	11860.680	25.519	115°40'00.00"	R = -10.000	15.708	90°00'00.00"
TC	121.170	8765.983	11808.197	27.072	115°40'00.00"			
IP 2	129.024	8774.996	11803.866	27.111				
CT	136.878	8779.328	11812.879	27.151	25°40'00.00"			
TC	186.378	8800.768	11857.495	27.387	25°40'00.00"	R = -10.000	15.708	90°00'00.00"
IP 3	194.232	8805.099	11866.508	27.382				
CT	202.086	8796.086	11870.839	27.344	295°40'00.00"			
TC	326.372	8684.064	11924.672	25.184	295°40'00.00"			
IP 4	331.128	8679.741	11926.749	25.181		R = -30.000	9.512	18°10'00.00"
CT	335.884	8674.985	11927.375	25.205	277°30'00.00"			
IP 5	343.294	8667.638	11928.343	25.321	277°30'00.00"			




SCALE 

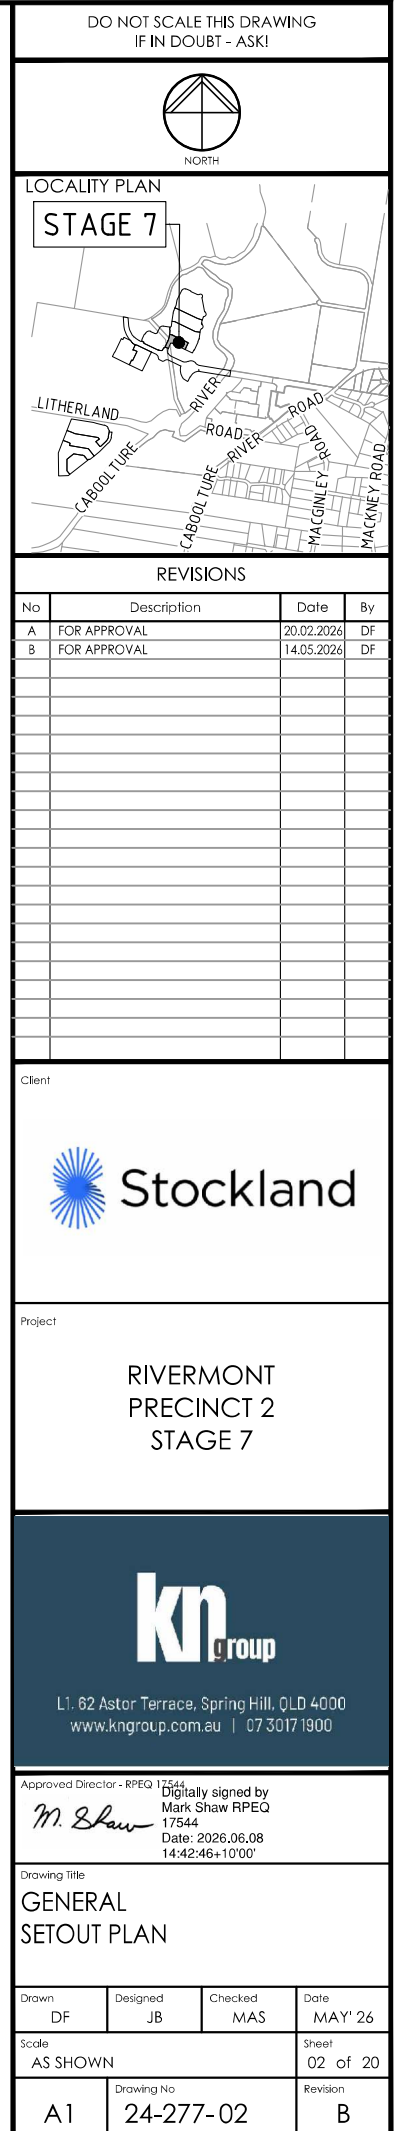




PROPOSED WORKS ARE NEAR EXISTING SERVICES. CONTRACTOR TO COMPLETE DBYD AND LOCATE ALL EXISTING SERVICES PRIOR TO COMMENCING CONSTRUCTION.
POST SERVICE LOCATION, CONTRACTOR TO SUPPLY SURVEY INFORMATION TO SUPERINTENDENT'S REPRESENTATIVE PRIOR TO THE COMMENCEMENT OF WORK.

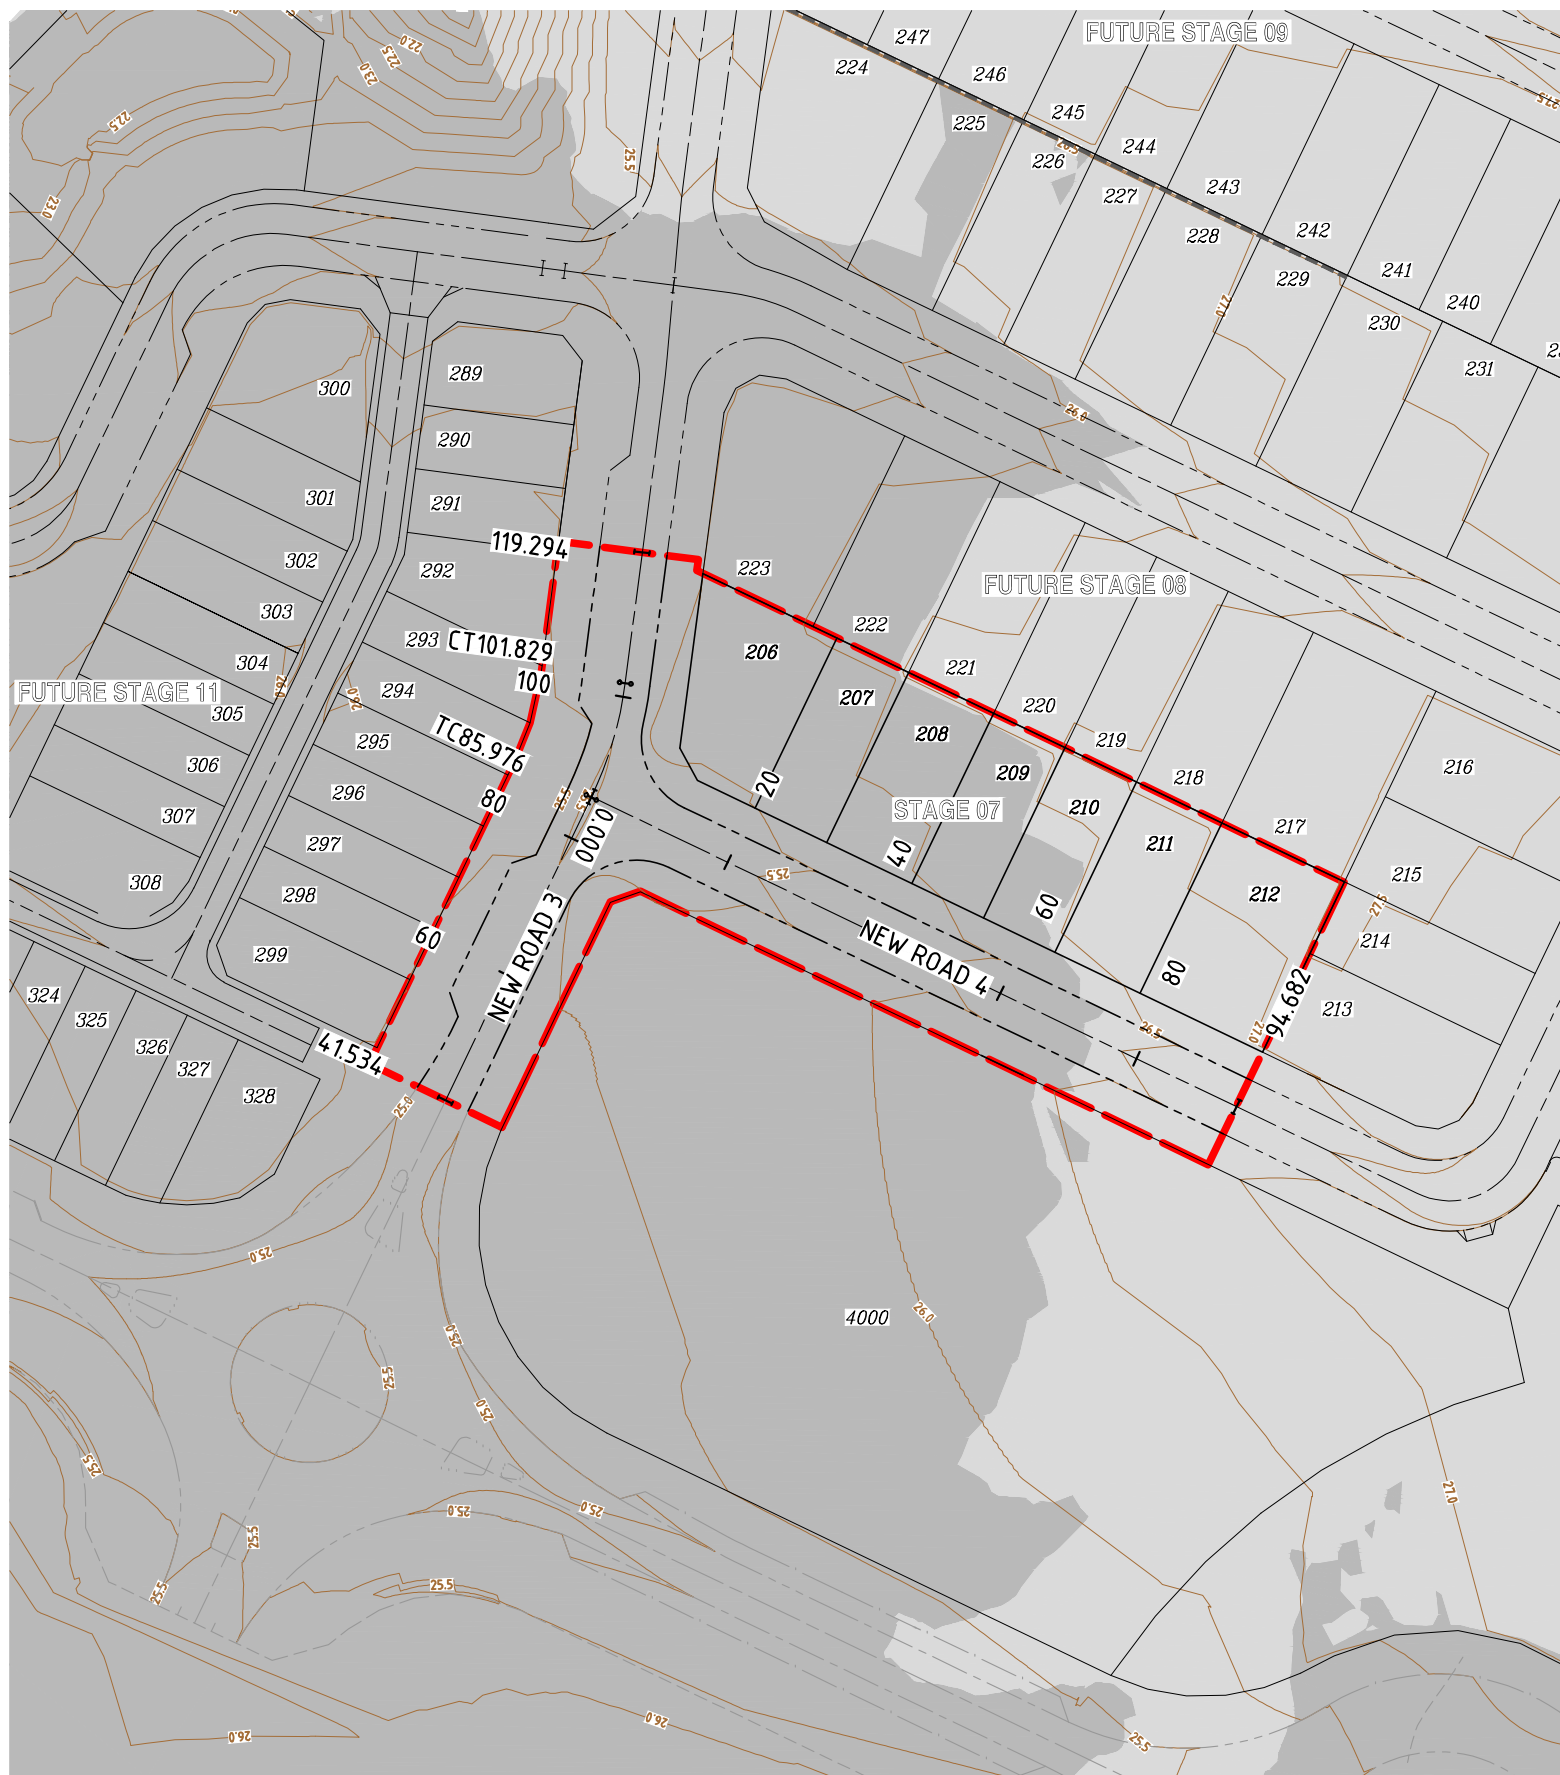

EARTHWORKS CONTOUR PLAN

SCALE 1:500

 LEGEND

- | | |
|---|-----------------------------------|
|  | STAGE BOUNDARY |
|  | PROPOSED ROAD CENTRELINE |
|  | M3 MOUNTABLE KERB AND CHANNEL |
|  | B1 BARRIER KERB AND CHANNEL (300) |
|  | B2 BARRIER KERB |
|  | FINISHED SURFACE CONTOURS |
|  | NATURAL SURFACE CONTOURS |
|  | FUTURE RETAINING WALL |
|  | EXTENT OF CUT |
|  | EXTENT OF FILL |

DO NOT SCALE THIS DRAWING
IF IN DOUBT - ASK!



LOCALITY PLAN

STAGE 7



REVISIONS

[illegible]

Client



PLANS AND DOCUMENTS
referred to in the PDA
DEVELOPMENT APPROVAL

Approval no: DEV-2026-WAR-4914

Date: 10/07/2026

Project

RIVERMONT
PRECINCT 2
STAGE 7



L1, 62 Astor Terrace, Spring Hill, QLD 4000
www.kngroup.com.au | 07 3017 1900


Approved Director - RPEQ 17544
M. Shaw
 Digitally signed by Mark Shaw RPEQ 17544
 Date: 2026.06.08 14:42:47+10'00'

Drawing Title

EARTHWORKS
CONTOUR PLAN

Drawn DF	Designed JB	Checked MAS	Date MAY' 26
Scale AS SHOWN			Sheet 05 of 20
A1	Drawing No 24-277-05		Revision B

SCALE 
1: 500 (A1 UNREDUCED)

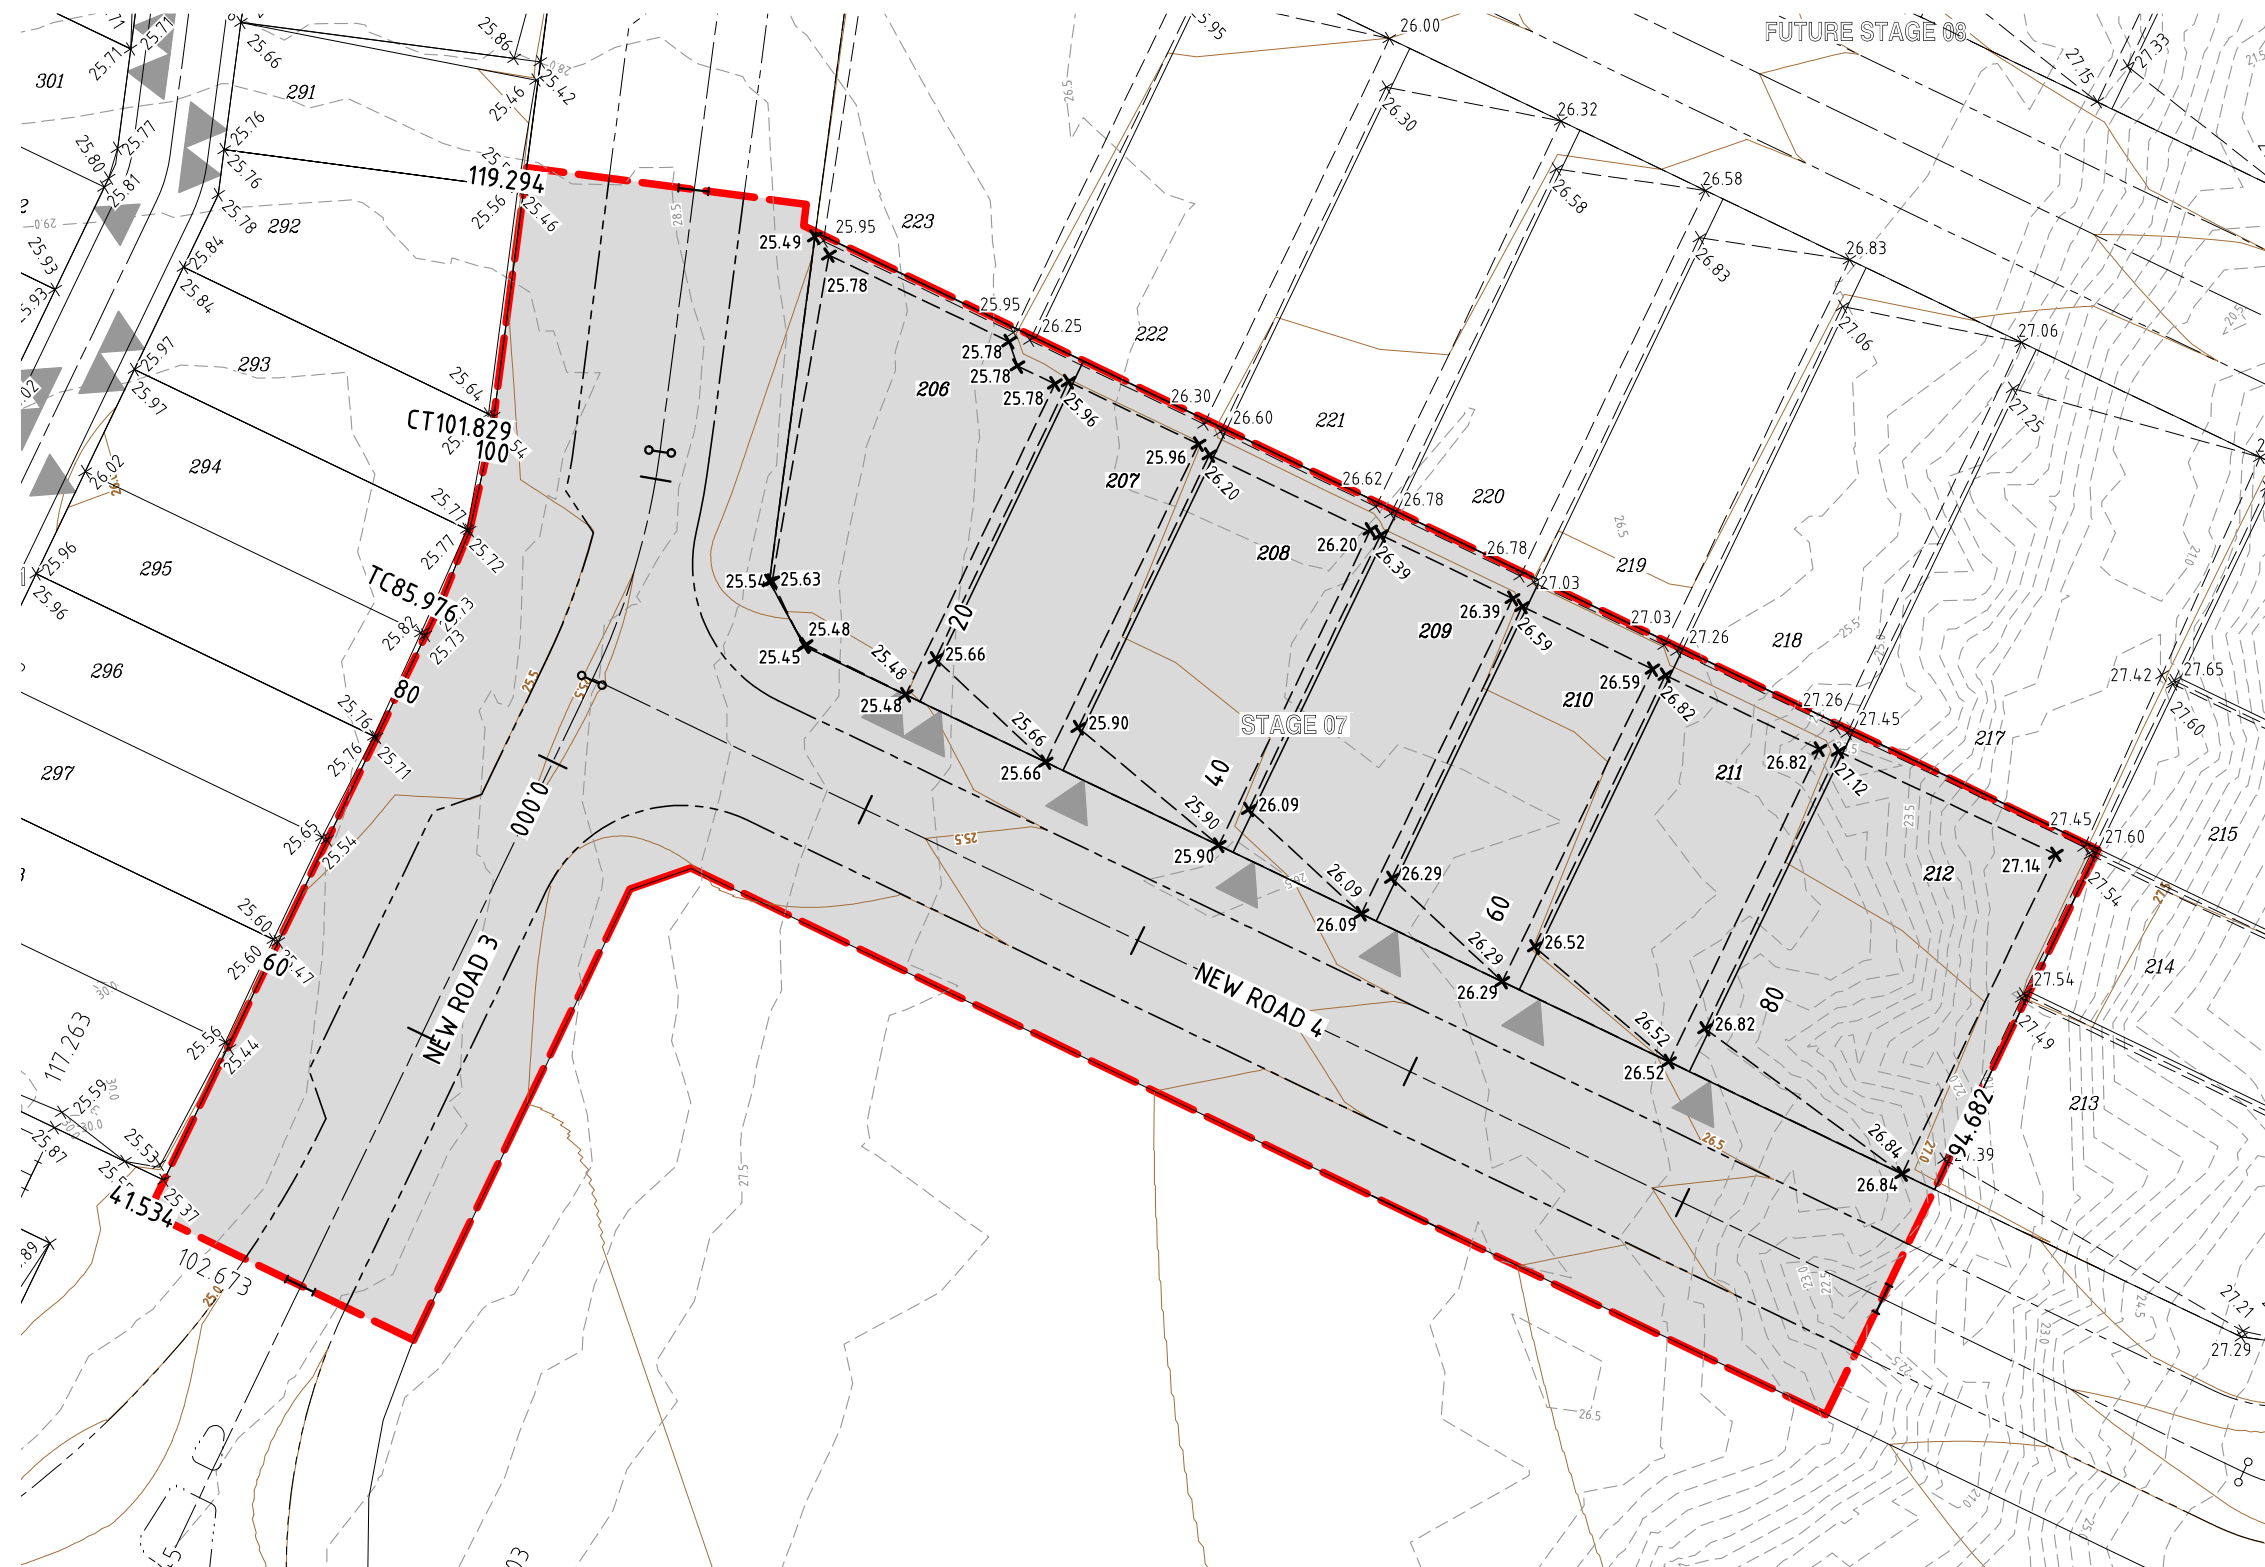

EARTHWORKS SPOT LEVELS PLAN

SCALE 1:250


PLANS AND DOCUMENTS
referred to in the PDA
DEVELOPMENT APPROVAL

Approval no: DEV-2026-WAR-4914

Date: 10/07/2026



-
- The diagram illustrates a cross-section of a road layout with the following features from top to bottom:
- STAGE BOUNDARY**: Indicated by a thick red line.
 - PROPOSED ROAD CENTRELINE**: Indicated by a dashed line.
 - M3 MOUNTABLE KERB AND CHANNEL**: Indicated by a dashed line.
 - B1 BARRIER KERB AND CHANNEL (300)**: Indicated by a dashed line.
 - B2 BARRIER KERB**: Indicated by a dashed line.
 - FINISHED SURFACE CONTOURS**: Indicated by a brown line with a label **-35.0**.
 - NATURAL SURFACE CONTOURS**: Indicated by a grey line with a label **-36.0**.
 - BATTER LINE**: Indicated by a dashed line.
 - EXISTING RETAINING WALL**: Indicated by a dashed line.
 - CONCRETE RETAINING WALL**: Indicated by a purple line.
 - FUTURE RETAINING WALL**: Indicated by a dashed line.
 - DRIVEWAY POSITION**: Indicated by a dashed line.
 - FINISHED SURFACE LEVELS**: Indicated by a dashed line.
- At the bottom, a triangle symbol is labeled **× 23.300**.

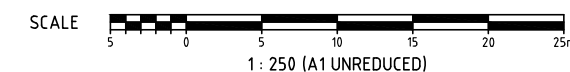

CONTEMPORARY RESIDENTIAL

- 40mm ASPHALTIC CONCRETE
- 5mm PRIMER SEAL
- 100mm BASE COURSE (TYPE 2.1, CBR 80)
- 100mm UPPER SUB-BASE COURSE (TYPE 2.3, CBR 45)
- 200mm LOWER SUB-BASE COURSE (TYPE 2.5, CBR 15)
- SUBGRADE REPLACEMENT 300mm (TYPE 2.5, CBR 15)

DESIGN ESA = 3×10^3

PLANS AND DOCUMENTS referred to in the PDA DEVELOPMENT APPROVAL

Date: 10/07/2026



By: Mahima Reshamwala

Date: 10/07/2026



DO NOT SCALE THIS DRAWING
IF IN DOUBT - ASK!

STAGE 7



REVISIONS

[illegible]

Client



Project

RIVERMONT
PRECINCT 2
STAGE 7



L1, 62 Astor Terrace, Spring Hill, QLD 4000
www.kngroup.com.au | 07 3017 1900

Approved Director - RPEQ 17544
M. Shaw
 Digitally signed by Mark Shaw RPEQ 17544
 Date: 2026.06.08 14:42:48+10'00'


Drawing Title

ROADWORKS

LONG AND CROSS SECTIONS

NEW ROAD 3

Drawn DF	Designed JB	Checked MAS	Date MAY '26
Scale AS SHOWN			Sheet 07 of 2
A1	Drawing No 24-277-07		Revision B

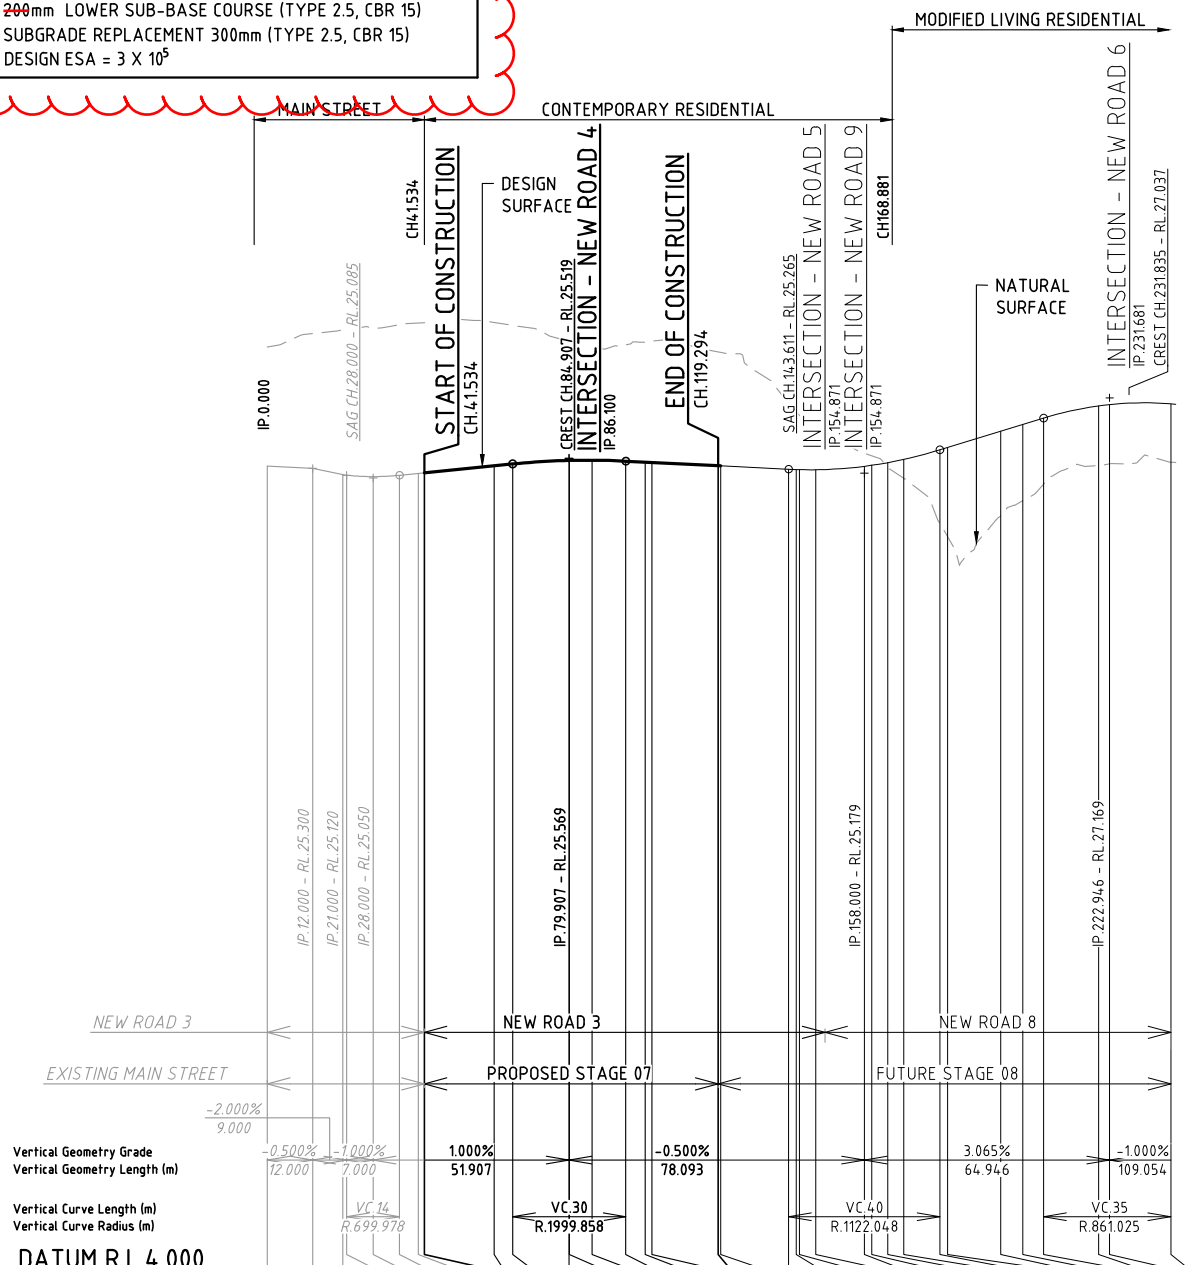

EXISTING		EXISTING INTERSECTION		FUTURE INTERSECTION	
LIP OF KERB LHS	LIP OF KERB RHS	EXISTING INTERSECTION		FUTURE INTERSECTION	
NATURAL SURFACE	CUT/FILL DEPTH	DESIGN SURFACE	PEGGED CHAINAGE		
0.000	25.360	28.516	-3.156	-3.789	-3.667
12.000	25.300	28.870	-3.570	-3.155	-3.022
20.000	25.140	28.961	-3.820	-3.352	-3.077
21.000	25.120	28.975	-3.855	-3.452	-3.176
28.000	25.085	29.010	-3.925	-3.528	-3.204
35.000	25.120	29.104	-3.984	-3.602	-3.012
40.000	25.170	29.145	-3.975	-3.002	-1.732
41.534	25.185	29.152	-3.966	-1.512	-1.439
60.000	25.370	29.159	-3.789	-1.117	-1.117
64.907	25.419	29.087	-3.667	-1.066	-1.066
79.907	25.513	28.668	-3.155	-0.977	-0.977
80.000	25.513	28.665	-3.152	-0.977	-0.977
85.976	25.519	28.541	-3.022	-0.977	-0.977
94.907	25.494	28.571	-3.077	-0.977	-0.977
100.000	25.469	28.645	-3.176	-0.977	-0.977
101.829	25.460	28.664	-3.204	-0.977	-0.977
119.294	25.372	28.384	-3.012	-0.977	-0.977
120.000	25.369	28.371	-3.002	-0.977	-0.977
138.000	25.279	27.010	-1.732	-0.977	-0.977
140.000	25.270	26.782	-1.512	-0.977	-0.977
140.861	25.268	26.707	-1.439	-0.977	-0.977
145.153	25.266	26.383	-1.117	-0.977	-0.977
158.000	25.357	25.700	-0.343	-0.977	-0.977
160.000	25.384	25.633	-0.248	-0.977	-0.977
164.164	25.453	25.339	0.104	-0.977	-0.977
168.456	25.540	25.038	0.501	-0.977	-0.977
178.000	25.792	23.844	1.947	-0.977	-0.977
180.000	25.853	23.502	2.351	-0.977	-0.977
194.147	26.287	24.041	2.245	-0.977	-0.977
200.000	26.466	24.447	2.019	-0.977	-0.977
205.446	26.633	24.879	1.753	-0.977	-0.977
220.000	26.956	25.382	1.574	-0.977	-0.977
222.946	26.991	25.421	1.571	-0.977	-0.977
239.177	27.006	25.464	1.542	-0.977	-0.977

Horiz Curve Data

R.-50
15.853

$$\begin{array}{r} \text{R.}-100 \\ 4.292 \end{array} \quad \begin{array}{r} \text{R.100} \\ 4.292 \end{array}$$

LONGITUDINAL SECTION - NEW ROAD 3

SCALE - 1:1000 (H)
1:100 (V)


REFER
INTERSECTION DETAILS ON
KN DWG 24-277-09

CROSS SECTIONS - NEW ROAD 3

SCALE A 1:1000
(Horiz.)



B 1:100
(Vert.)

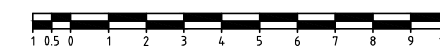

(A1 UNREDUCED)


30mm ASPHALTIC CONCRETE
5mm PRIMER SEAL
100mm BASE COURSE (TYPE 2.1, CBR 80)
100mm UPPER SUB-BASE COURSE (TYPE 2.3, CBR 45)
200mm LOWER SUB-BASE COURSE (TYPE 2.5, CBR 15)
SUBGRADE REPLACEMENT 300mm (TYPE 2.5, CBR 15)
DESIGN ESA = 1.2×10^5

300 SUBGRADE REPLACEMENT (CBR 15 MIN.)


100 BASE (TYPE 2.1)

100 SUB-BASE (TYPE 2.3)


200 LOWER SUB-BASE (TYPE 2.5)

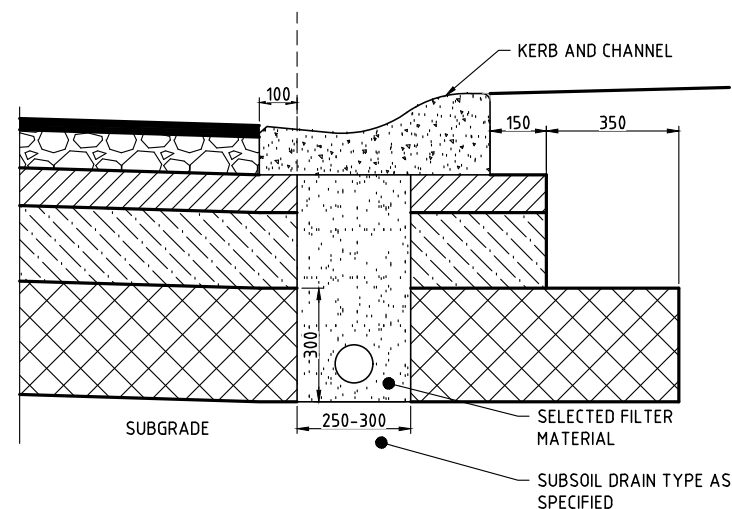

TYPICAL SECTION ROADS ESA 1.2x10⁵
LESS THAN INSITU CBR 3, SWELLS >5%
SCALE 1:10

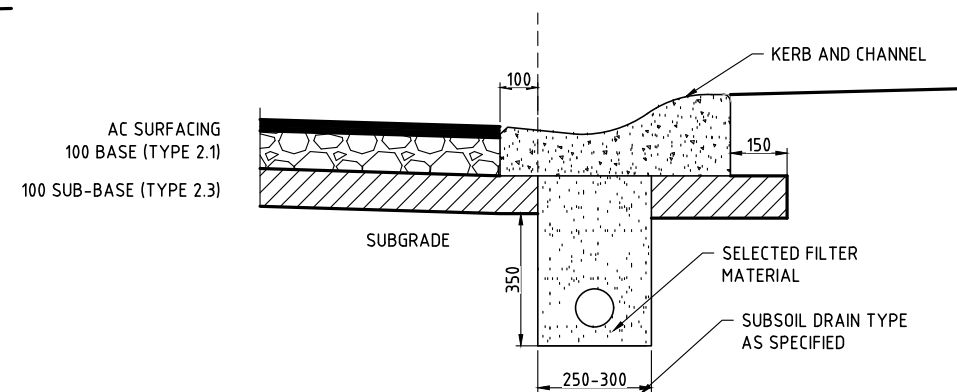

TYPICAL DETAIL SUB-SOIL DRAINAGE
GRATER THAN INSITU CBR 3
SCALE 1:10

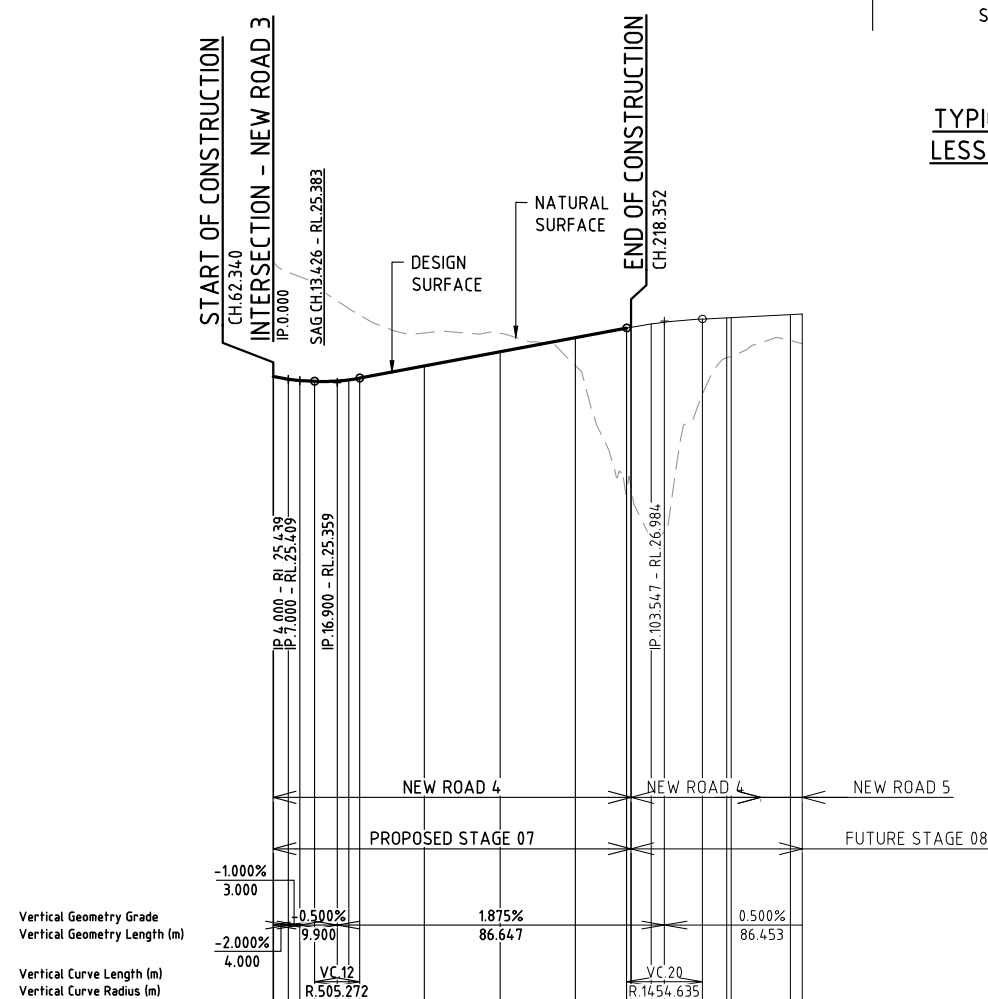

DATUM R.L.8.000

[illegible]

Horiz Curve Data

LONGITUDINAL SECTION - NEW ROAD 4

SCALE - 1:1000 (H)
1:100 (V)


PLANS AND DOCUMENTS
referred to in the PDA
DEVELOPMENT APPROVAL

Approval no: DEV-2026-WAR-4914

Date: 10/07/2026



Queensland
Government

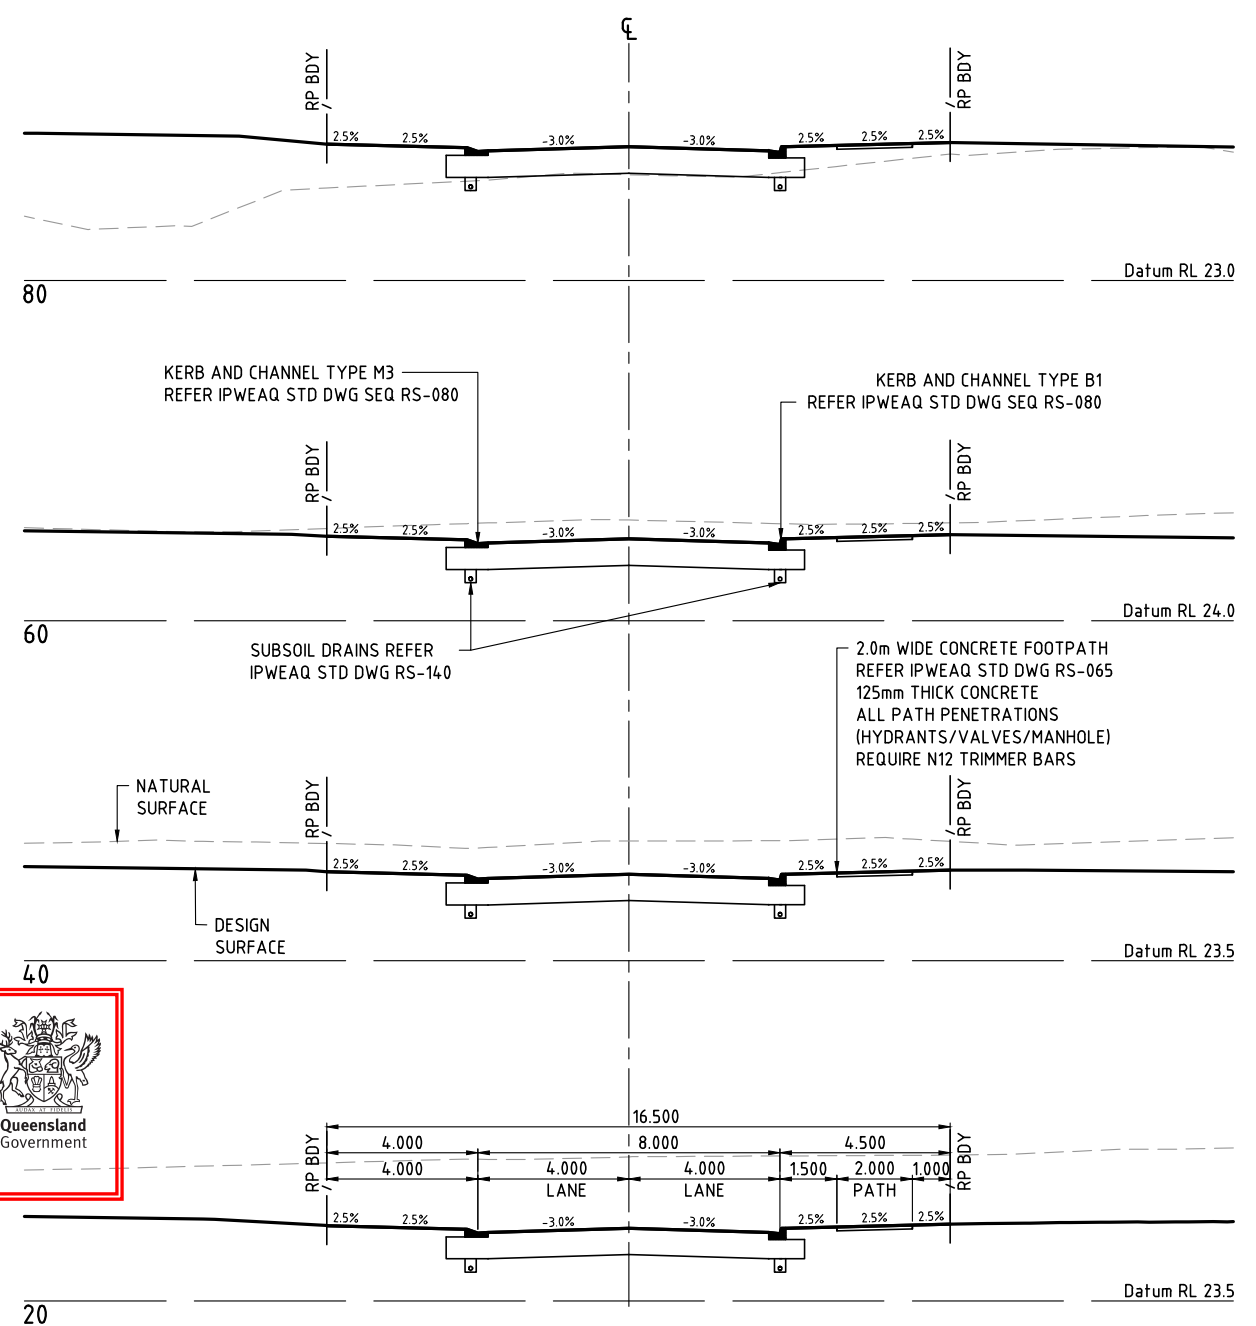

CROSS SECTIONS - NEW ROAD 4

SCALE A 1:1000
(Horiz.)

SCALE

ROAD 4 1 : 10 (A1 UNREDUCED)

B 1:100
(Vert.)

DO NOT SCALE THIS DRAWING
IF IN DOUBT - ASK!

LOCALITY PLAN

STAGE 7



REVISIONS

[illegible]

Client



Project

RIVERMONT
PRECINCT 2
STAGE 7



L1, 62 Astor Terrace, Spring Hill, QLD 4000
www.knigroup.com.au | 07 3017 1900

Approved Director - RPEQ 17544
Digitally signed by
Mark Shaw RPEQ
17544
Date: 2026.06.08
14:42:48+10'00'

Drawing Title


ROADWORKS

LONG AND CROSS SECTIONS

NEW ROAD 4 & 5

Drawn DF	Designed JB	Checked MAS	Date MAY'78
Scale AS SHOWN			Sheet 08 of 2
A1	Drawing No 24-277-08		Revision B


M:\2024\24277 Rivermont P2 Stage 7\Engineering\A\cd\24-277-09-10-00-DETAILS.dwg Plotted by: AL on 8/06/2026 11:26:48 AM

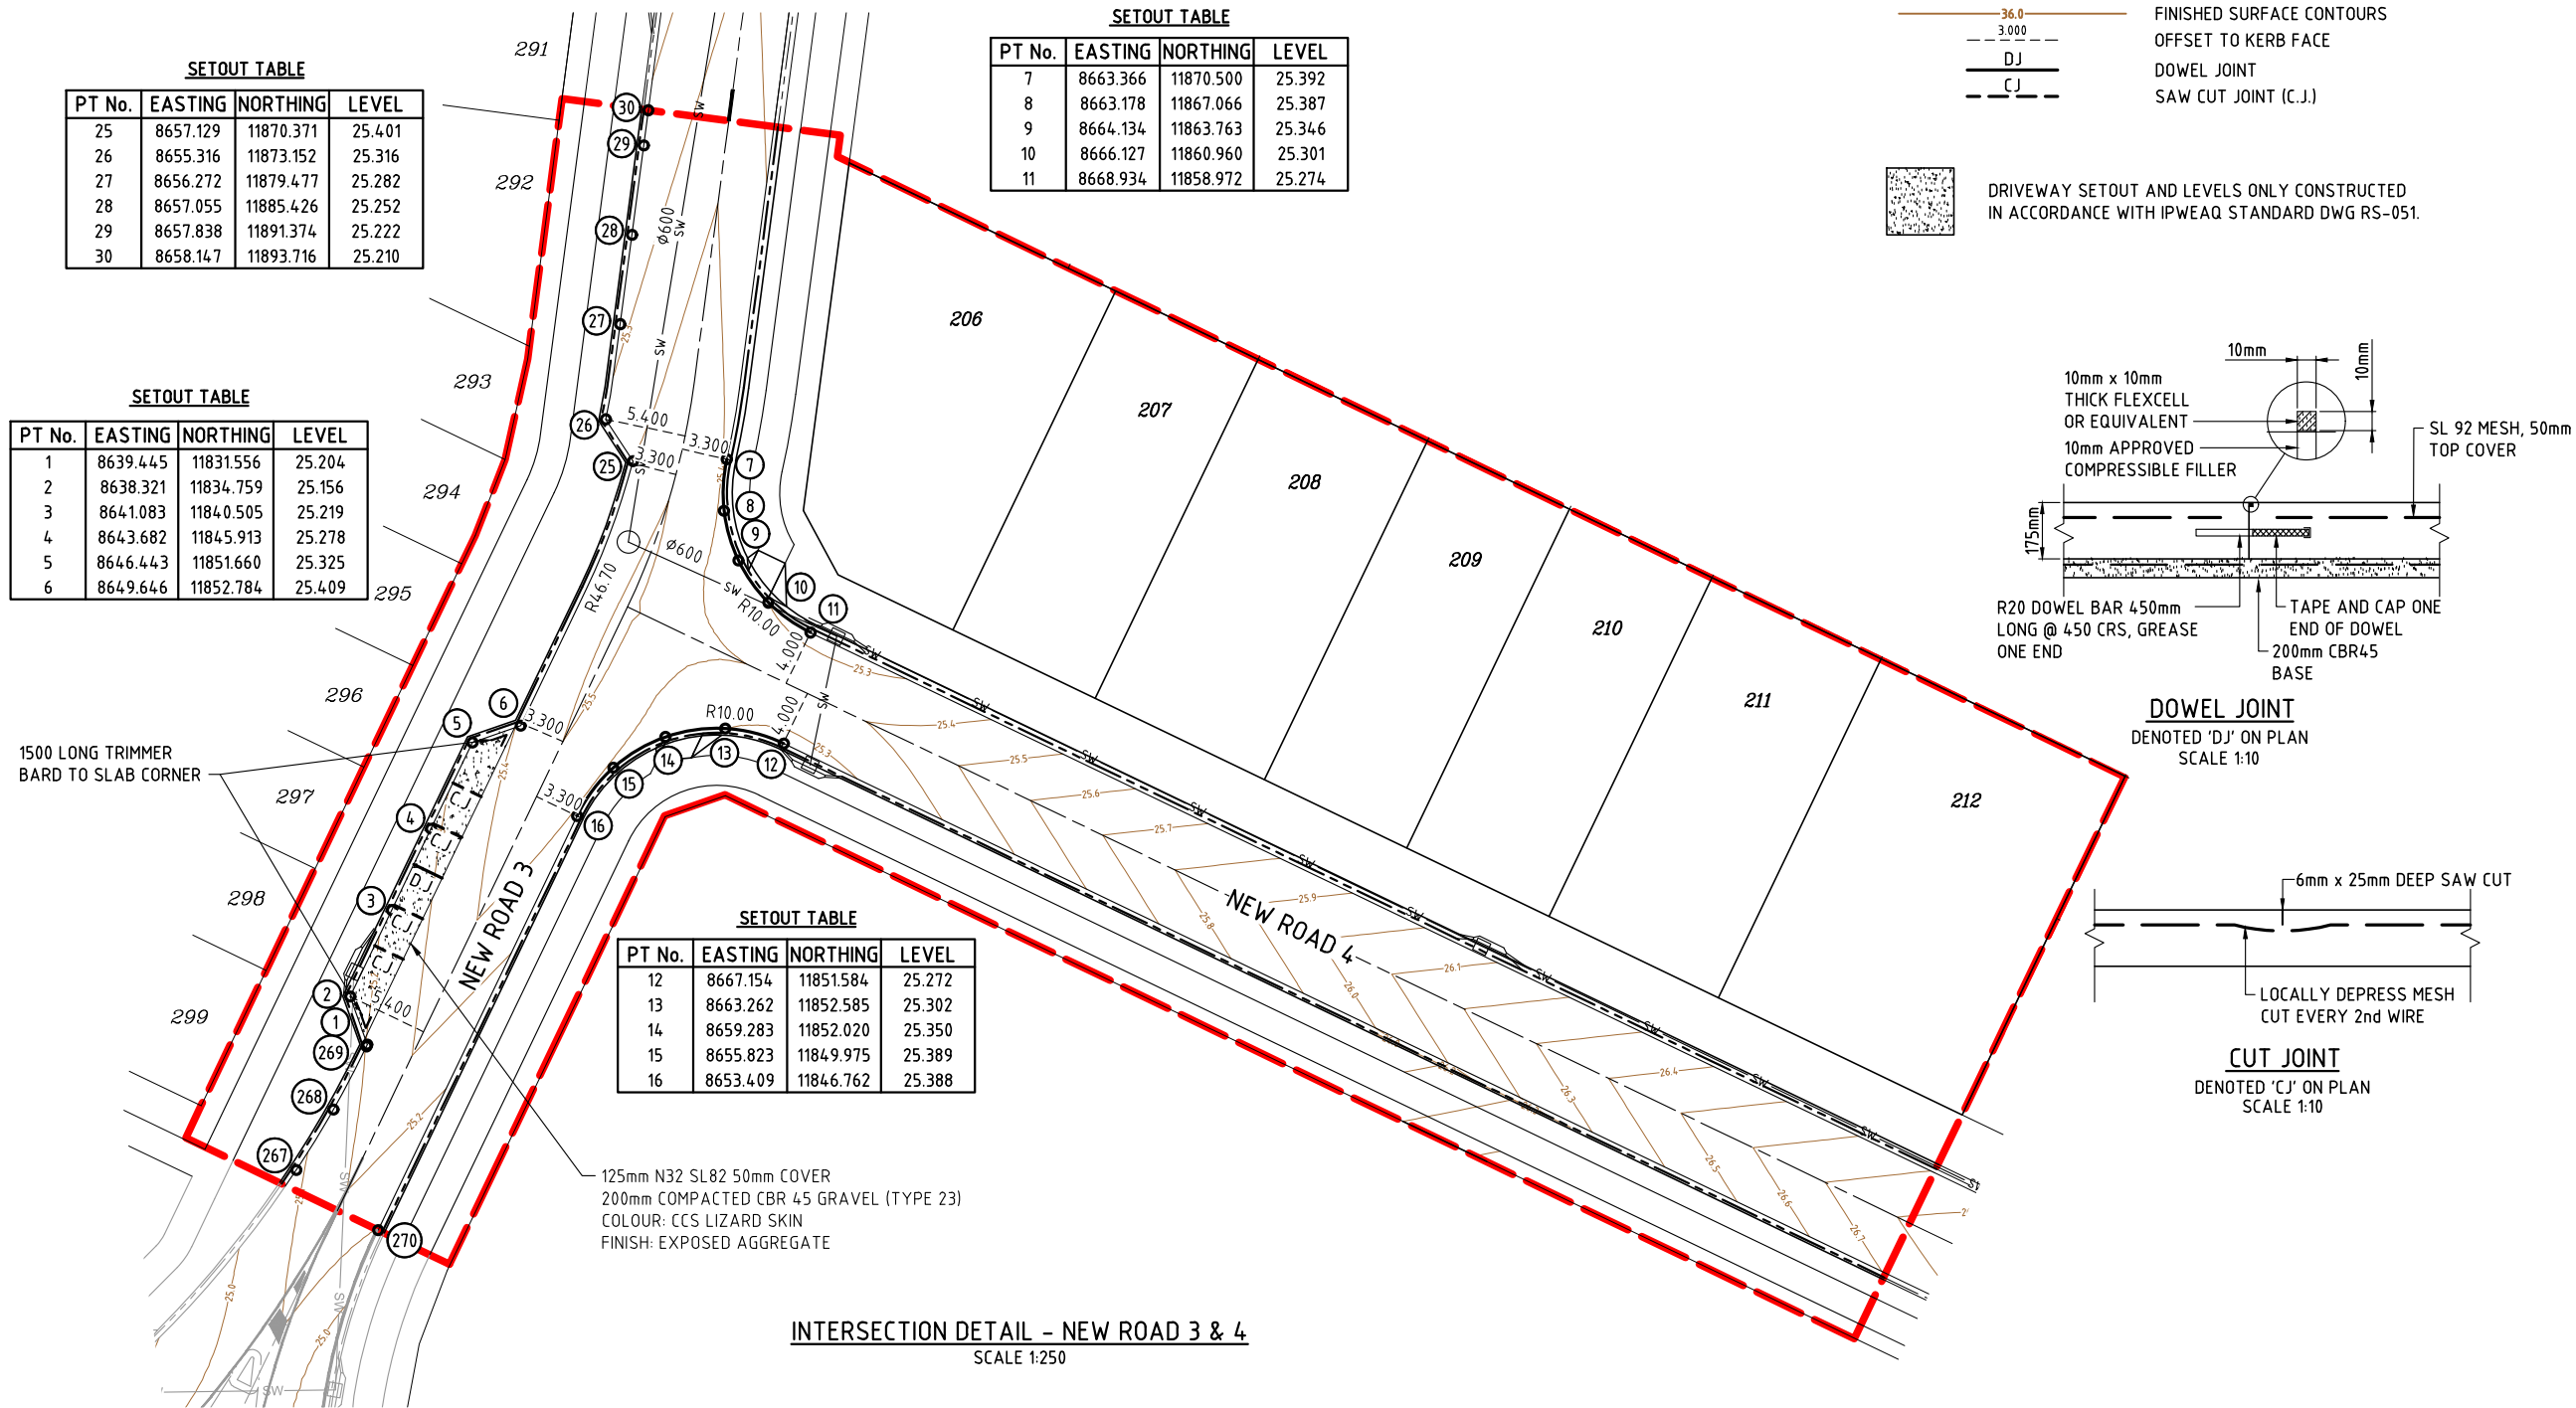

PLANS AND DOCUMENTS referred to in the PDA
DEVELOPMENT APPROVAL

Approval no: DEV-2026-WAR-4914
Date: 10/07/2026

Queensland Government

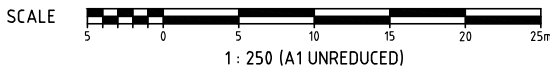

DO NOT SCALE THIS DRAWING IF IN DOUBT - ASK!

LOCALITY PLAN
STAGE 7

REVISIONS

No	Description	Date	By
A	FOR APPROVAL	20.02.2026	DF
B	FOR APPROVAL	14.05.2026	DF

Client
Stockland

Project
RIVERMONT PRECINCT 2
STAGE 7

kn group
L1, 62 Astor Terrace, Spring Hill, QLD 4000
www.kngroup.com.au | 07 3017 1900

Approved Director - RPEQ 17544
Digitally signed by Mark Shaw RPEQ 17544
Date: 2026.06.08 14:42:48+10'00'

Drawing Title
ROADWORKS INTERSECTION DETAILS

Drawn	Designed	Checked	Date
DF	JB	MAS	MAY '26

Scale	Drawing No	Revision
AS SHOWN	24-277-09	B

STAGE 7

[illegible]

Stockland

RIVERMONT
PRECINCT 2
STAGE 7



L1, 62 Astor Terrace, Spring Hill, QLD 4000
www.kngroup.com.au | 07 30171900

Approved Director - RPEQ 17544
M. Shaw
 Digitally signed by Mark Shaw RPEQ 17544
 Date: 2026.06.08 14:42:49+10'00'

ROADWORKS LINEMARKING PLAN

Drawn DF	Designed JB	Checked MAS	Date MAY' 26
Scale AS SHOWN			Sheet 10 of 20
A1	Drawing No 24-277- 10		Revision B

 STAGE BOUNDARY
 PROPOSED ROAD CENTRELINE
 M3 MOUNTABLE KERB AND CHANNEL
 B1 BARRIER KERB AND CHANNEL (300)
 B2 BARRIER KERB

EDGE LINE (EL) 150mm

GIVE WAY LINE (GWL) 600mm STRIPE AND GAP 300mm


BARRIER LINE (BL) RRPM MIN 4m MAX 12m 100mm

UNBROKEN YELLOW NO STOPPING LINE (LLCY) 100mm

LANE LINE BROKEN (LLB) 100mm

TYPICAL PARKING LINE (TPL) 0.6m 1.2m 100mm

NOTE- RETROREFLECTIVE RAISED PAVEMENT MARKERS (RRPM'S) REQUIRED TO ALL LANE LANES AND ALL PERIMETER OF CHEVRONS AS PER MAIN ROADS 'MANUAL OF UNIFORM TRAFFIC CONTROL DEVICES' (MUTCD).

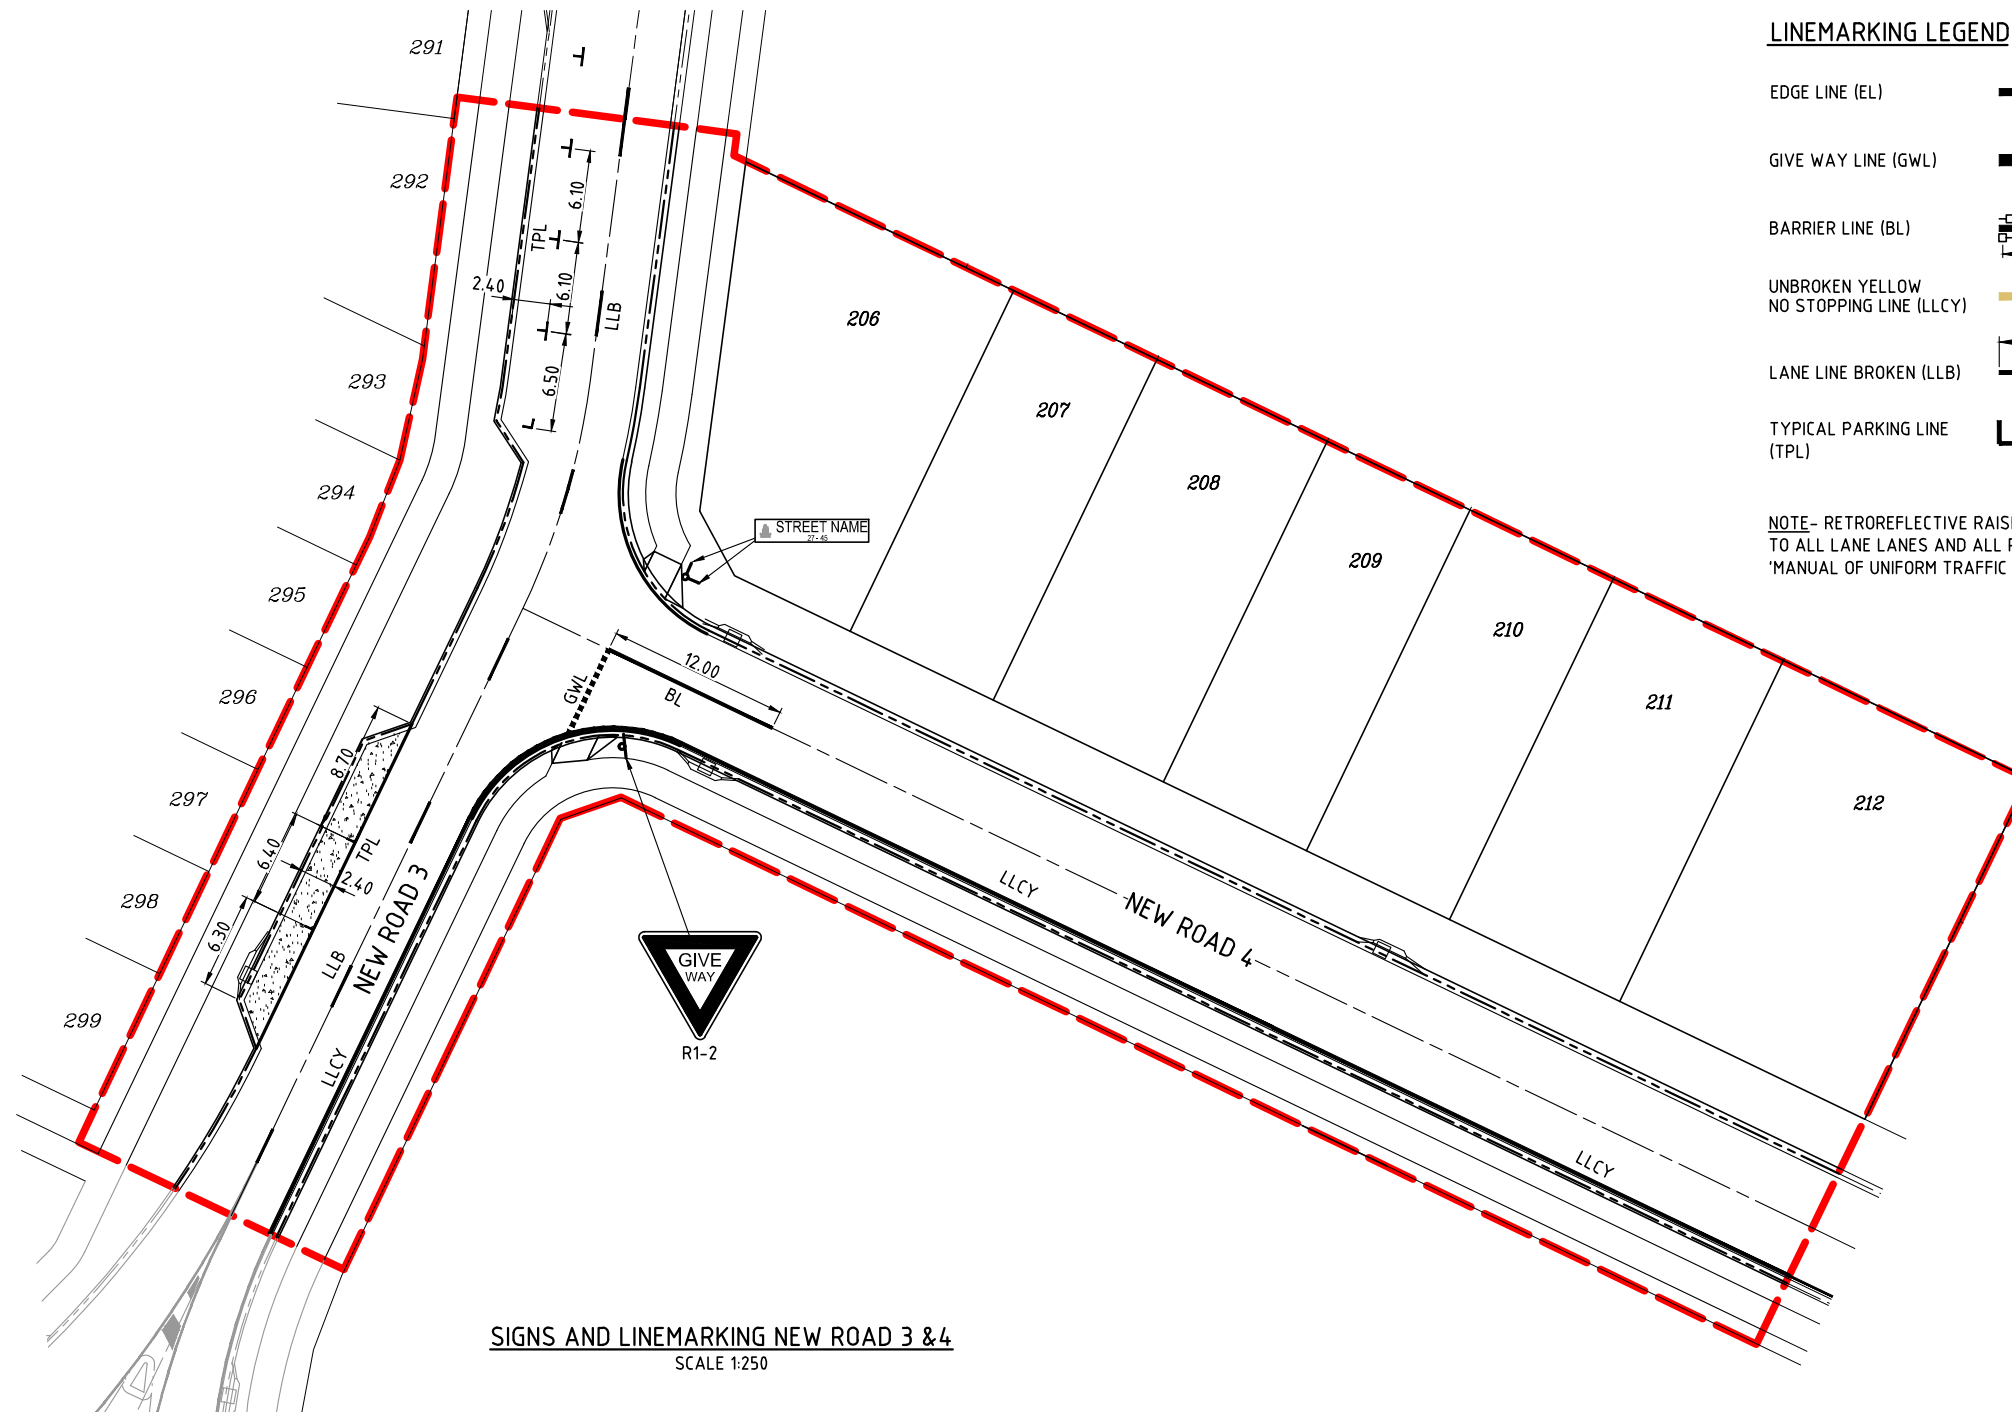

SIGNS AND LINEMARKING NEW ROAD 3 & 4
SCALE 1:250

PLANS AND DOCUMENTS
referred to in the PDA
DEVELOPMENT APPROVAL

Approval no: DEV-2026-WAR-4914

Date: 10/07/2026



SCALE 
1 : 250 (A1 UNREDUCED)

CATCHMENT NO.	AREA (ha)	CATCHMENT NO.	AREA (ha)	CATCHMENT NO.	AREA (ha)	CATCHMENT NO.	AREA (ha)	CATCHMENT NO.	AREA (ha)
F114-1	0.021	G01-19	0.251	G05-35	0.158	G05-56	0.036	F104-77	0.050
F113-1	0.037	G06-20	0.188	G04-35	0.042	G04-56	0.037	F103-77	0.017
G11-1	0.050	G05-20	0.052	G01-36	0.062	G03-56	0.037	F102-77	0.019
G10-1	0.117	G04-20	0.134	G01-38	0.136	G02-56	0.034	G01-50	0.081
G09-1	0.133	G03-20	0.202	F104-39	0.027	F101-56	0.051	G01-78	0.025
G08-1	0.162	G01-21	0.145	F103-39	0.058	G05-57	0.021	G01-79	0.032
F105-2	0.021	G06-14	0.181	F102-39	0.069	G04-57	0.016	G01-80	0.116
F104-2	0.038	G01-22	0.029	F101-39	0.038	G03-57	0.019	G01-81	0.014
F102-2	0.133	G01-23	0.127	G03-40	0.129	G02-57	0.019	G01-82	0.450
F101-2	0.057	G01-24	0.123	G02-40	0.107	G01-57	0.019	F101-65	0.018
G05-3	0.056	G03-20	0.202	G01-40	0.110	F104-58	3.159	G01-86	0.037
G04-3	0.048	G26-25	0.018	G03-41	0.059	G07-59	0.023	G04-27	0.134
G03-3	0.146	G25-25	0.016	G02-41	0.044	G06-59	0.037	F102-83	0.150
G02-3	0.147	G24-25	0.017	G01-41	0.051	G05-59	0.036	F102-84	0.492
G01-3	0.122	G23-25	0.016	G02-42	0.061	G04-59	0.036	F103-85	0.205
G01-4	0.164	G22-25	0.016	G01-42	0.108	G03-59	0.036	G01-70	0.128
G01-5	0.050	G21-25	0.016	G01-43	0.112	G02-59	0.037	G02-3	0.147
G01-6	0.034	G20-25	0.016	G02-42	0.061	F101-59	0.037	G01-71	0.197
G01-7	0.119	G19-25	0.016	F101-44	2.559	F101-61	0.052	G03-3	0.146
G01-3	0.122	G18-25	0.012	G01-45	0.082	G25-25	0.016	G01-72	0.040
G01-8	0.040	F114-26	0.070	G01-46	0.132	G01-62	0.190	G11-1	0.050
G01-9	0.024	F113-26	0.052	F101-47	0.312	G01-27	0.021	G01-73	0.099
G01-10	0.161	G12-26	0.156	G01-48	0.137	F102-63	9.038	G07-14	0.025
G08-1	0.162	F110-26	0.051	G01-49	0.106	F103-64	0.101	G02-74	0.206
G01-11	0.177	F109-26	0.048	IN4-50	0.134	F102-64	0.019	G01-74	0.144
G10-1	0.117	F108-26	0.056	3.5	0.326	F101-64	0.023	G01-75	0.185
F102-12	0.032	F107-26	0.006	G01-50	0.081	F103-65	0.111	G01-76	0.029
F101-12	0.033	F105-26	0.056	IN2-51	0.135	F102-65	0.014		
G01-13	0.128	F104-26	0.038	G01-51	0.030	F101-65	0.018		
G09-1	0.133	F103-26	0.054	G04-52	0.017	G01-66	0.075		
F110-14	0.032	G06-27	0.104	G03-52	0.034	G01-67	0.127		
F109-14	0.052	G04-27	0.134	G02-52	0.036	G01-69	0.039		
G08-14	0.012	G03-27	0.181	F101-52	0.052	G03-27	0.181		
G07-14	0.025	G02-27	0.112	G04-53	0.035				
G06-14	0.181	G01-27	0.021	G03-53	0.025				
G05-14	0.197	G02-28	0.039	G02-53	0.034				
G02-14	0.038	G01-28	0.039	G01-53	0.030				
G02-15	0.180	G02-29	0.145	G04-54	0.016				
G01-15	0.036	G01-29	0.150	G03-54	0.034				
G02-14	0.038	G02-30	0.147	G02-54	0.031				
G01-16	0.088	G01-30	0.070	F101-54	0.051				
G02-14	0.038	G01-31	0.099	G04-55	0.033				
F101-17	0.066	G01-32	0.048	G03-55	0.035				
G02-18	0.025	G01-33	0.058	G02-55	0.034				
G01-18	0.044	G01-34	0.053	G01-55	0.034				

LEGEND	
	PROPOSED CATCHMENT BOUNDARY
	EXTERNAL CONTRIBUTING CATCHMENT BOUNDARY
	CATCHMENT NUMBER
	M3 MOUNTABLE KERB AND CHANNEL
	B1 BARRIER KERB AND CHANNEL (300)
	B2 BARRIER KERB
	PROPOSED STORMWATER DRAINAGE
	FINISHED SURFACE CONTOURS
	NATURAL SURFACE CONTOURS


PLANS AND DOCUMENTS
referred to in the PDA
DEVELOPMENT APPROVAL

Approval no: DEV-2026-WAR-4914
Date: 10/07/2026



AMENDED IN RED

By: Mahima Reshamwala
Date: 10/07/2026

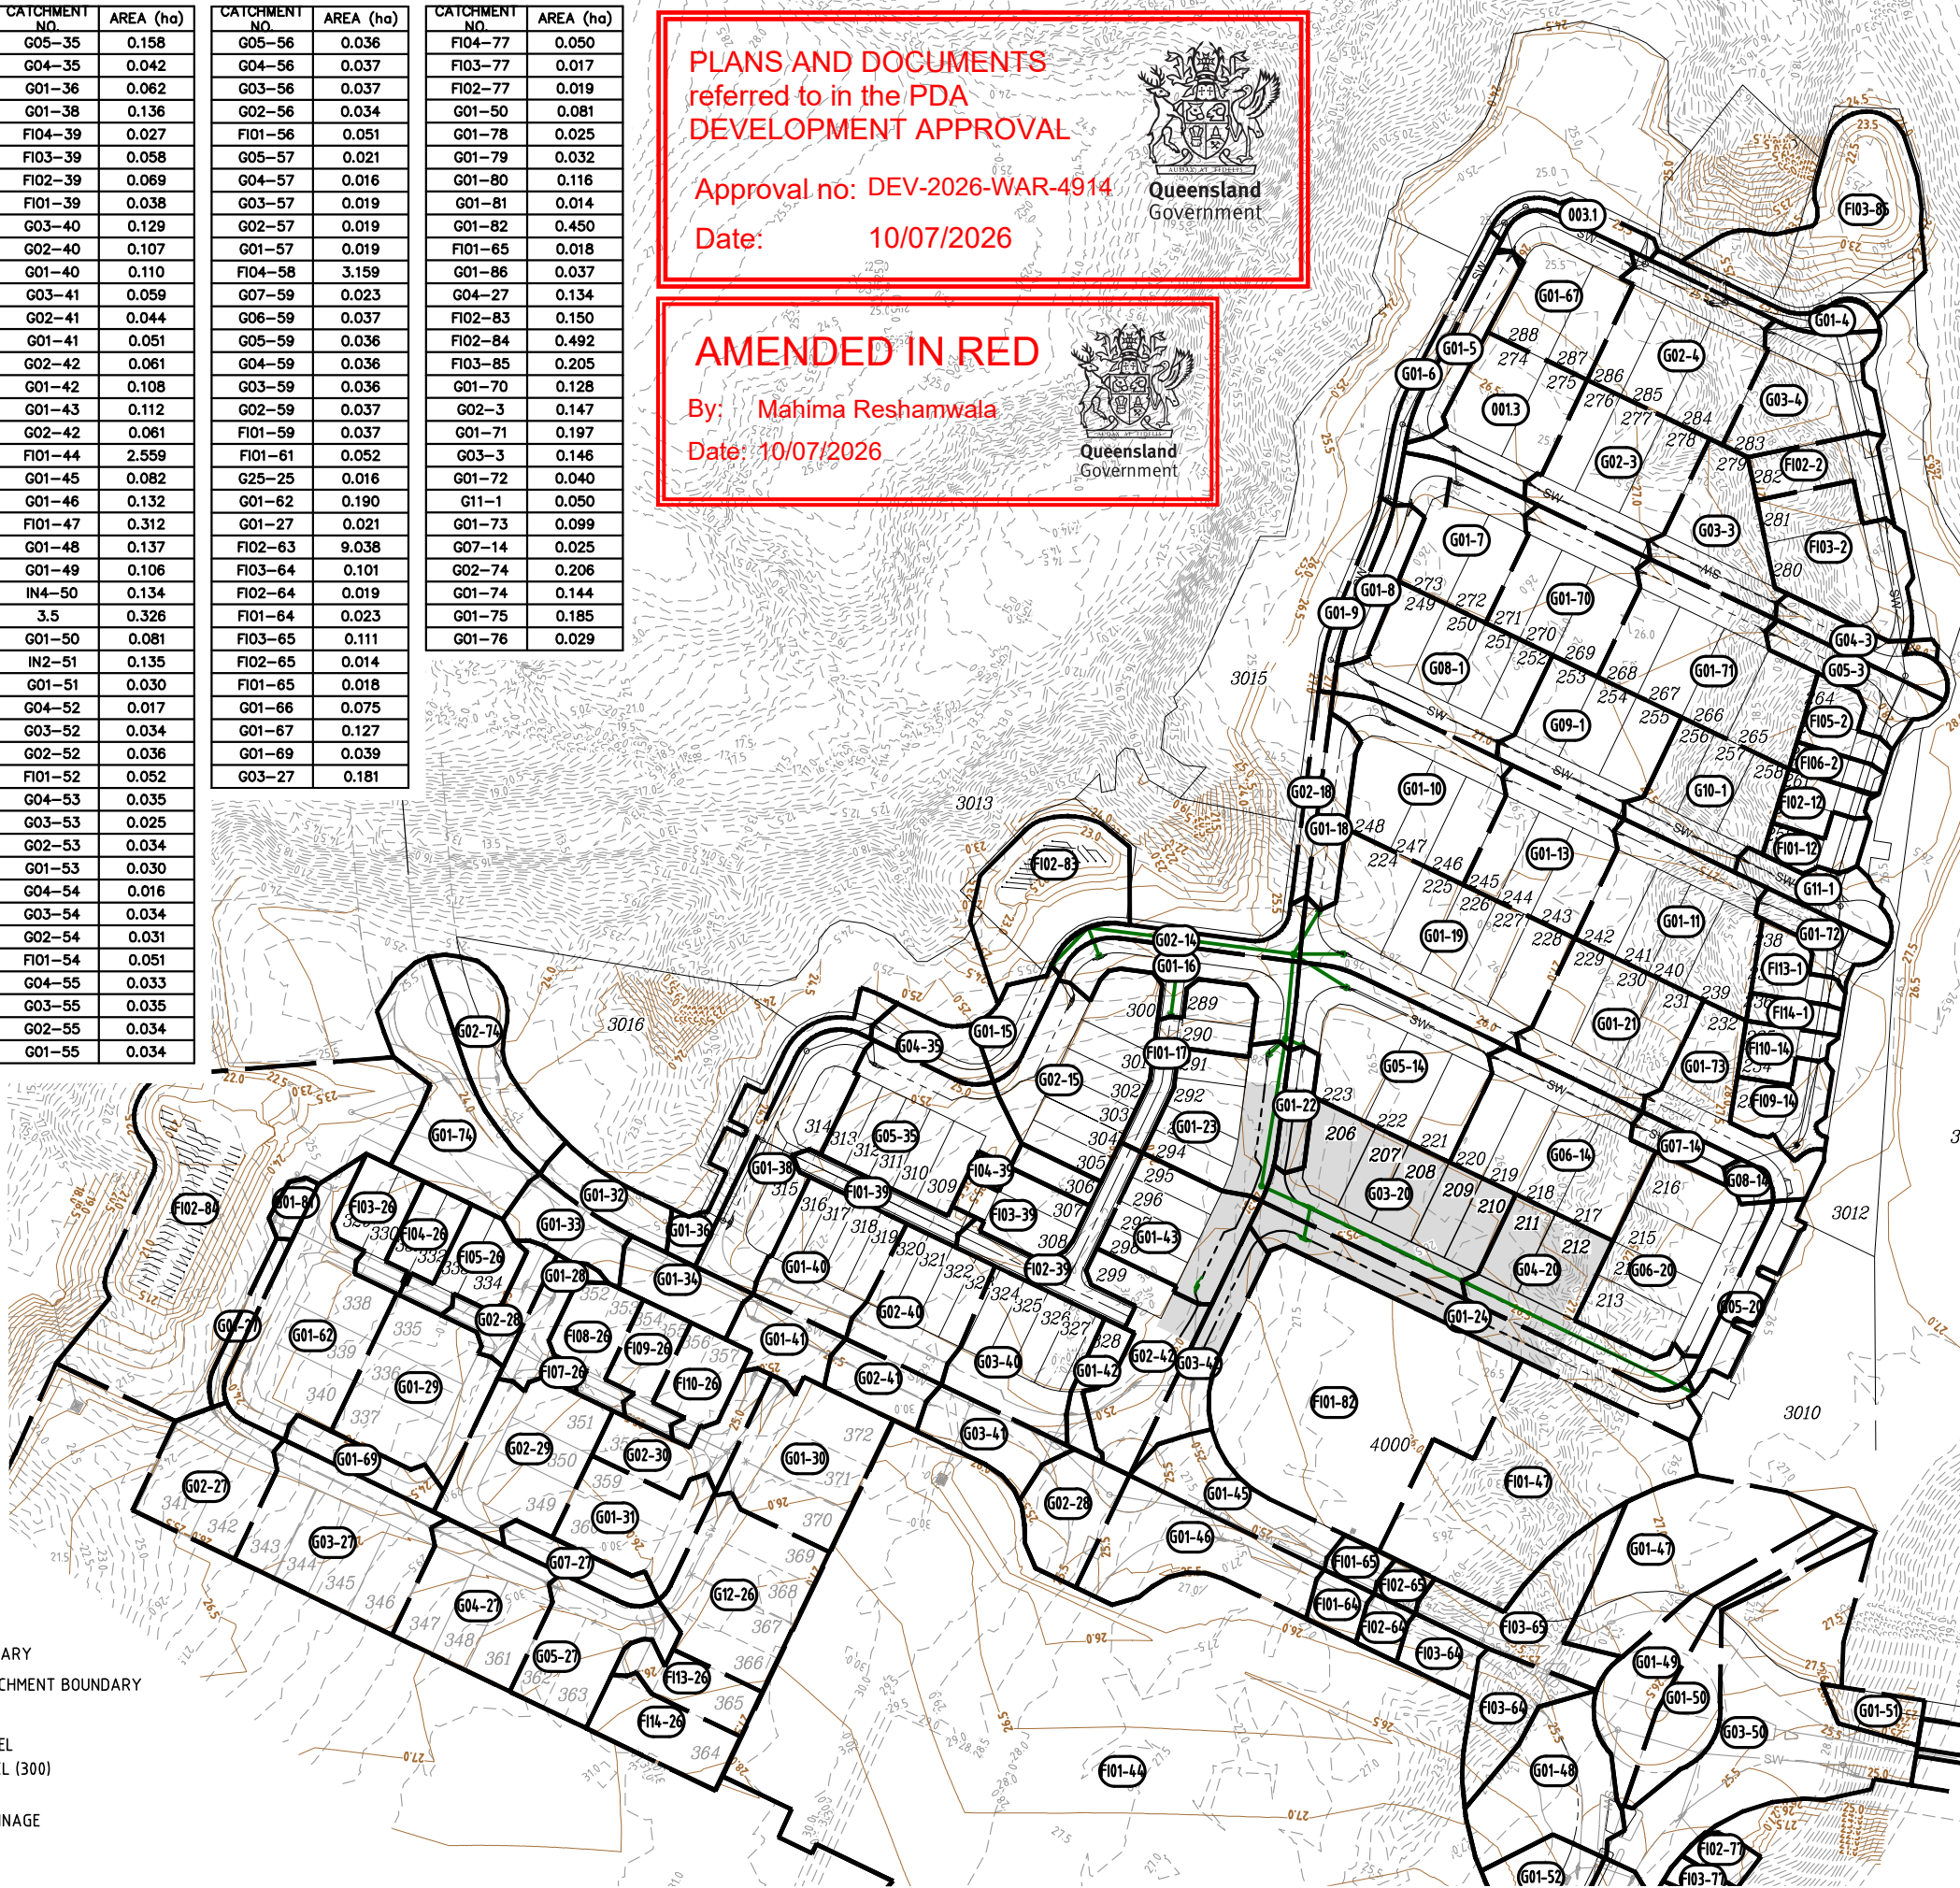

CATCHMENT PLAN
SCALE 1:1000

SCALE
10 5 0 10 20 30 40 50 60 70 80 90 100m
1: 1000 (A1 UNREDUCED)

DO NOT SCALE THIS DRAWING
IF IN DOUBT - ASK!



LOCALITY PLAN

STAGE 7



REVISIONS

No	Description	Date	By
A	FOR APPROVAL	20.02.2026	DF
B	FOR APPROVAL	14.05.2026	DF

Client



Project

RIVERMONT
PRECINCT 2
STAGE 7



L1, 62 Astor Terrace, Spring Hill, QLD 4000
www.kngroup.com.au | 07 3017 1900

Approved Director - RPEQ 17544
Digitally signed by
Mark Shaw RPEQ
17544
Date: 2026.06.08
14:42:49+10'00'

Drawing Title
STORMWATER
CATCHMENT PLAN

Drawn DF	Designed AL	Checked MAS	Date MAY '26
Scale AS SHOWN	Drawing No 24-277-11	Sheet 11 of 20	Revision B

STRUCTURE NAME

STRUCTURE DESCRIPTION

PLANS AND DOCUMENTS referred to in the PDA DEVELOPMENT APPROVAL

Approval no: DEV-2026-WAR-4914


Date: 10/07/2026




NOTE:
F1512 CONTRACTOR TO PROVIDE FORM 15 AND 12 FOR ALL MAINTENANCE HOLES GREATER THAN 3m DEPTH.

PIPE SIZE (mm)
PIPE CLASS
PIPE GRADE %
PIPE SLOPE 1 in X
FULL PIPE FLOW VELOCITY (m/s)
PART FULL FLOW VELOCITY (m/s)
DATUM RL.


WATER LEVEL IN STRUCTURE
HYDRAULIC GRADE LEVEL
PIPE FLOW (Cumecs)
PIPE CAPACITY AT GRADE (Cumecs)
DEPTH TO INVERT
INVERT LEVEL OF DRAIN
DESIGN SURFACE LEVEL
SETOUT CO-ORDINATE
RUNNING CHAINAGE

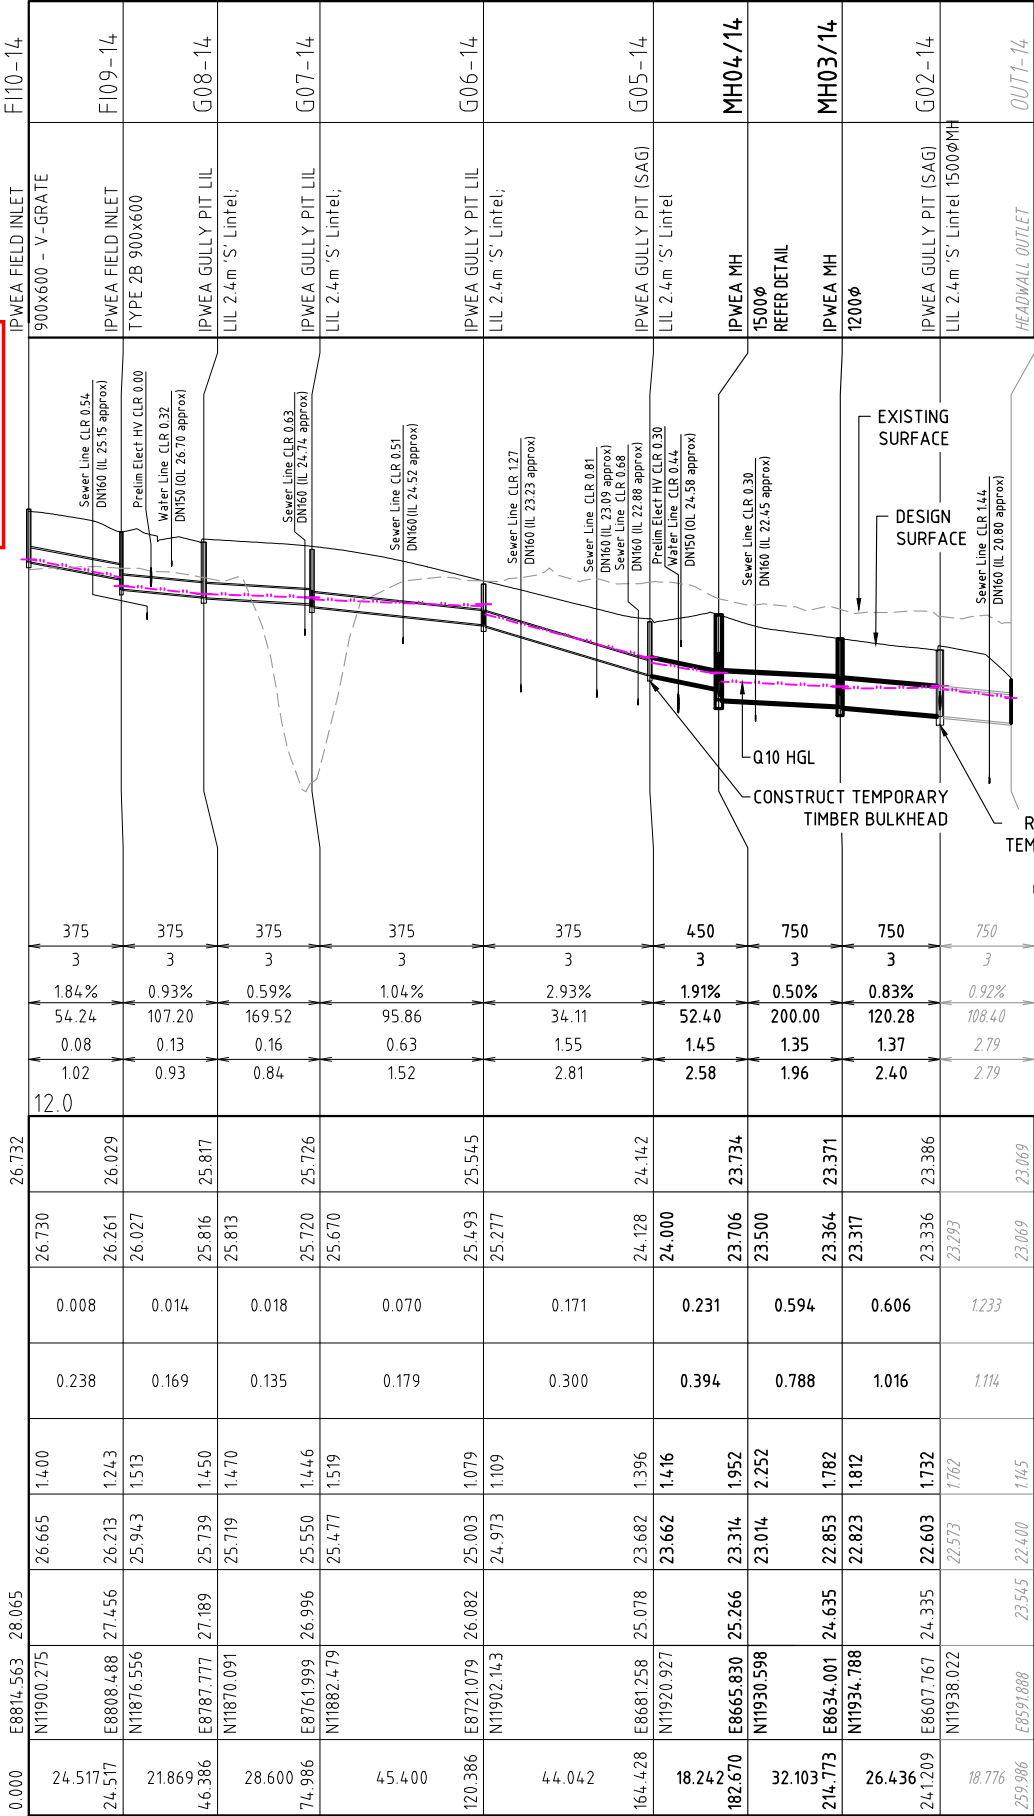


14

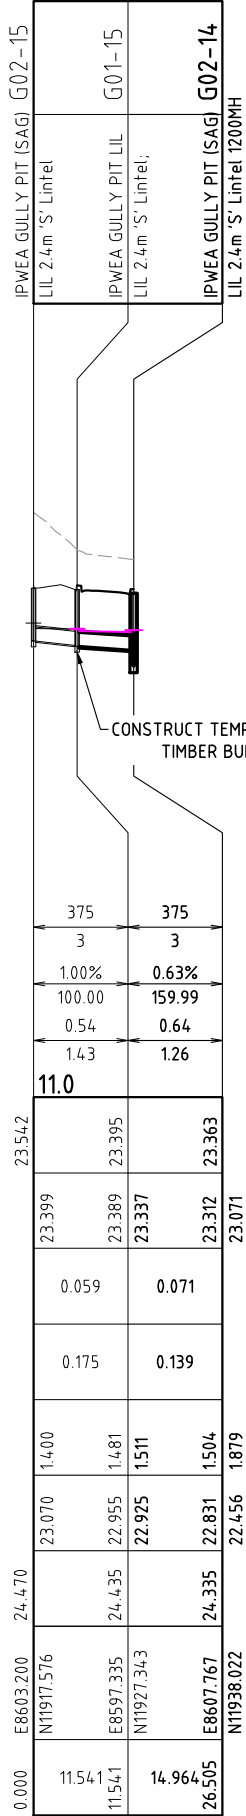


15

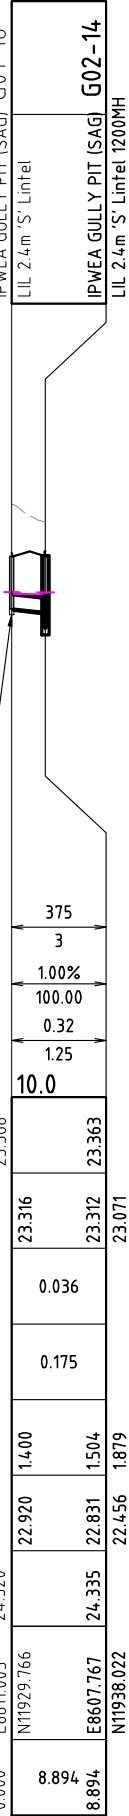


16

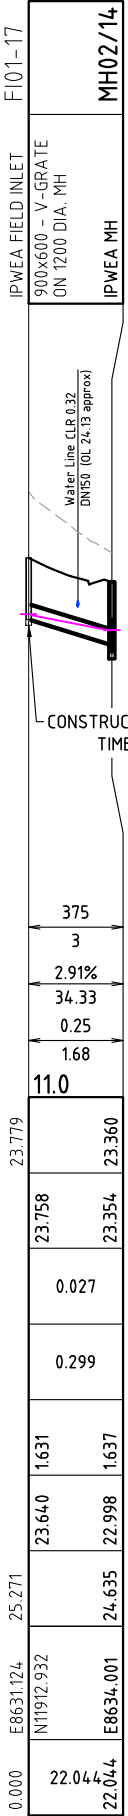

17

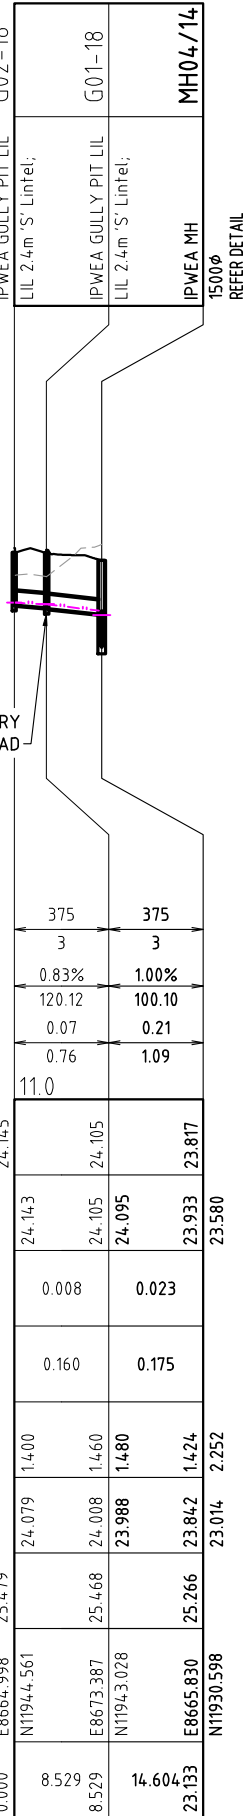

18

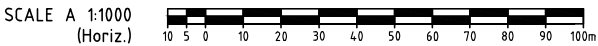

DO NOT SCALE THIS DRAWING IF IN DOUBT - ASK!

NORTH

LOCALITY PLAN

STAGE 7

REVISIONS

No	Description	Date	By
A	FOR APPROVAL	20.02.2026	DF
B	FOR APPROVAL	14.05.2026	DF

Client

Stockland

Project

RIVERMONT PRECINCT 2 STAGE 7

kn group

L1, 62 Astor Terrace, Spring Hill, QLD 4000
www.kngroup.com.au | 07 3017 1900

Approved Director - RPEQ 17544
Mark Shaw RPEQ 17544
Date: 2026.06.08
14:42:49+10'00'

Drawing Title

STORMWATER LONG SECTIONS

Drawn	Designed	Checked	Date
DF	AL	MAS	MAY' 26

Scale	Sheet
AS SHOWN	12 of 20

A1	Drawing No	Revision
	24-277-12	B



STRUCTURE DESCRIPTION

F1512 CONTRACTOR TO PROVIDE FORM 15 AND 12 FOR ALL MAINTENANCE HOLES GREATER THAN 3m DEPTH.

WATER LEVEL IN STRUCTURE
HYDRAULIC GRADE LEVEL
PIPE FLOW (Cumecs)
PIPE CAPACITY AT GRADE (Cumecs)
DEPTH TO INVERT
INVERT LEVEL OF DRAIN
DESIGN SURFACE LEVEL
SETOUT CO-ORDINATE
RUNNING CHAINAGE




- REMOVE TEMPORARY
TIMBER BULKHEAD AND
CONSTRUCT NEW GULLY

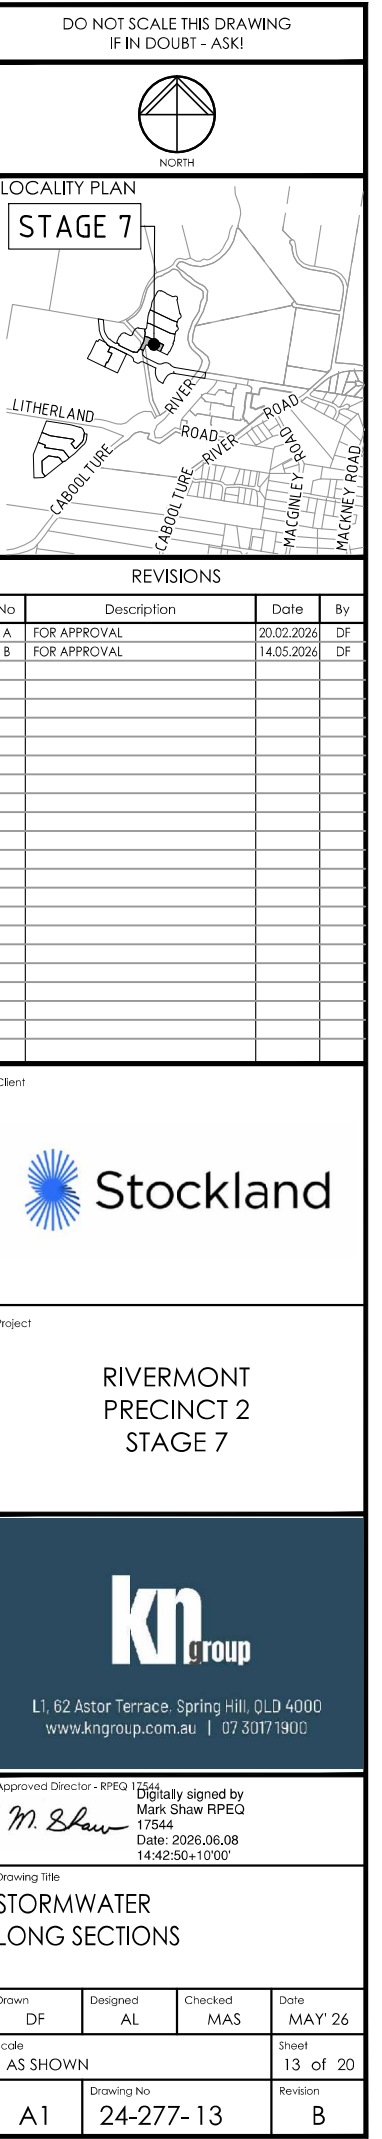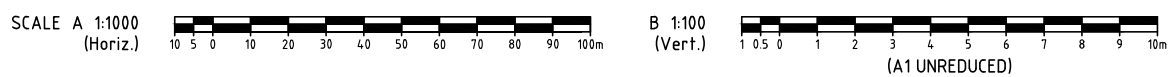

M:\2024\24277 Rivermont P2 Stage 7\Engineering\Acad\24-277-15-16-SW-CALCS.dwg Plotted by: AL on 8/06/2026 4:19:48 PM

Drawing Title			
STORMWATER CALCULATION TABLE SHEET 1			
Drawn DF	Designed AL	Checked MAS	Date
Scale AS SHOWN			Sheet 15 of
A1	Drawing No 24-277- 15	Revision B	

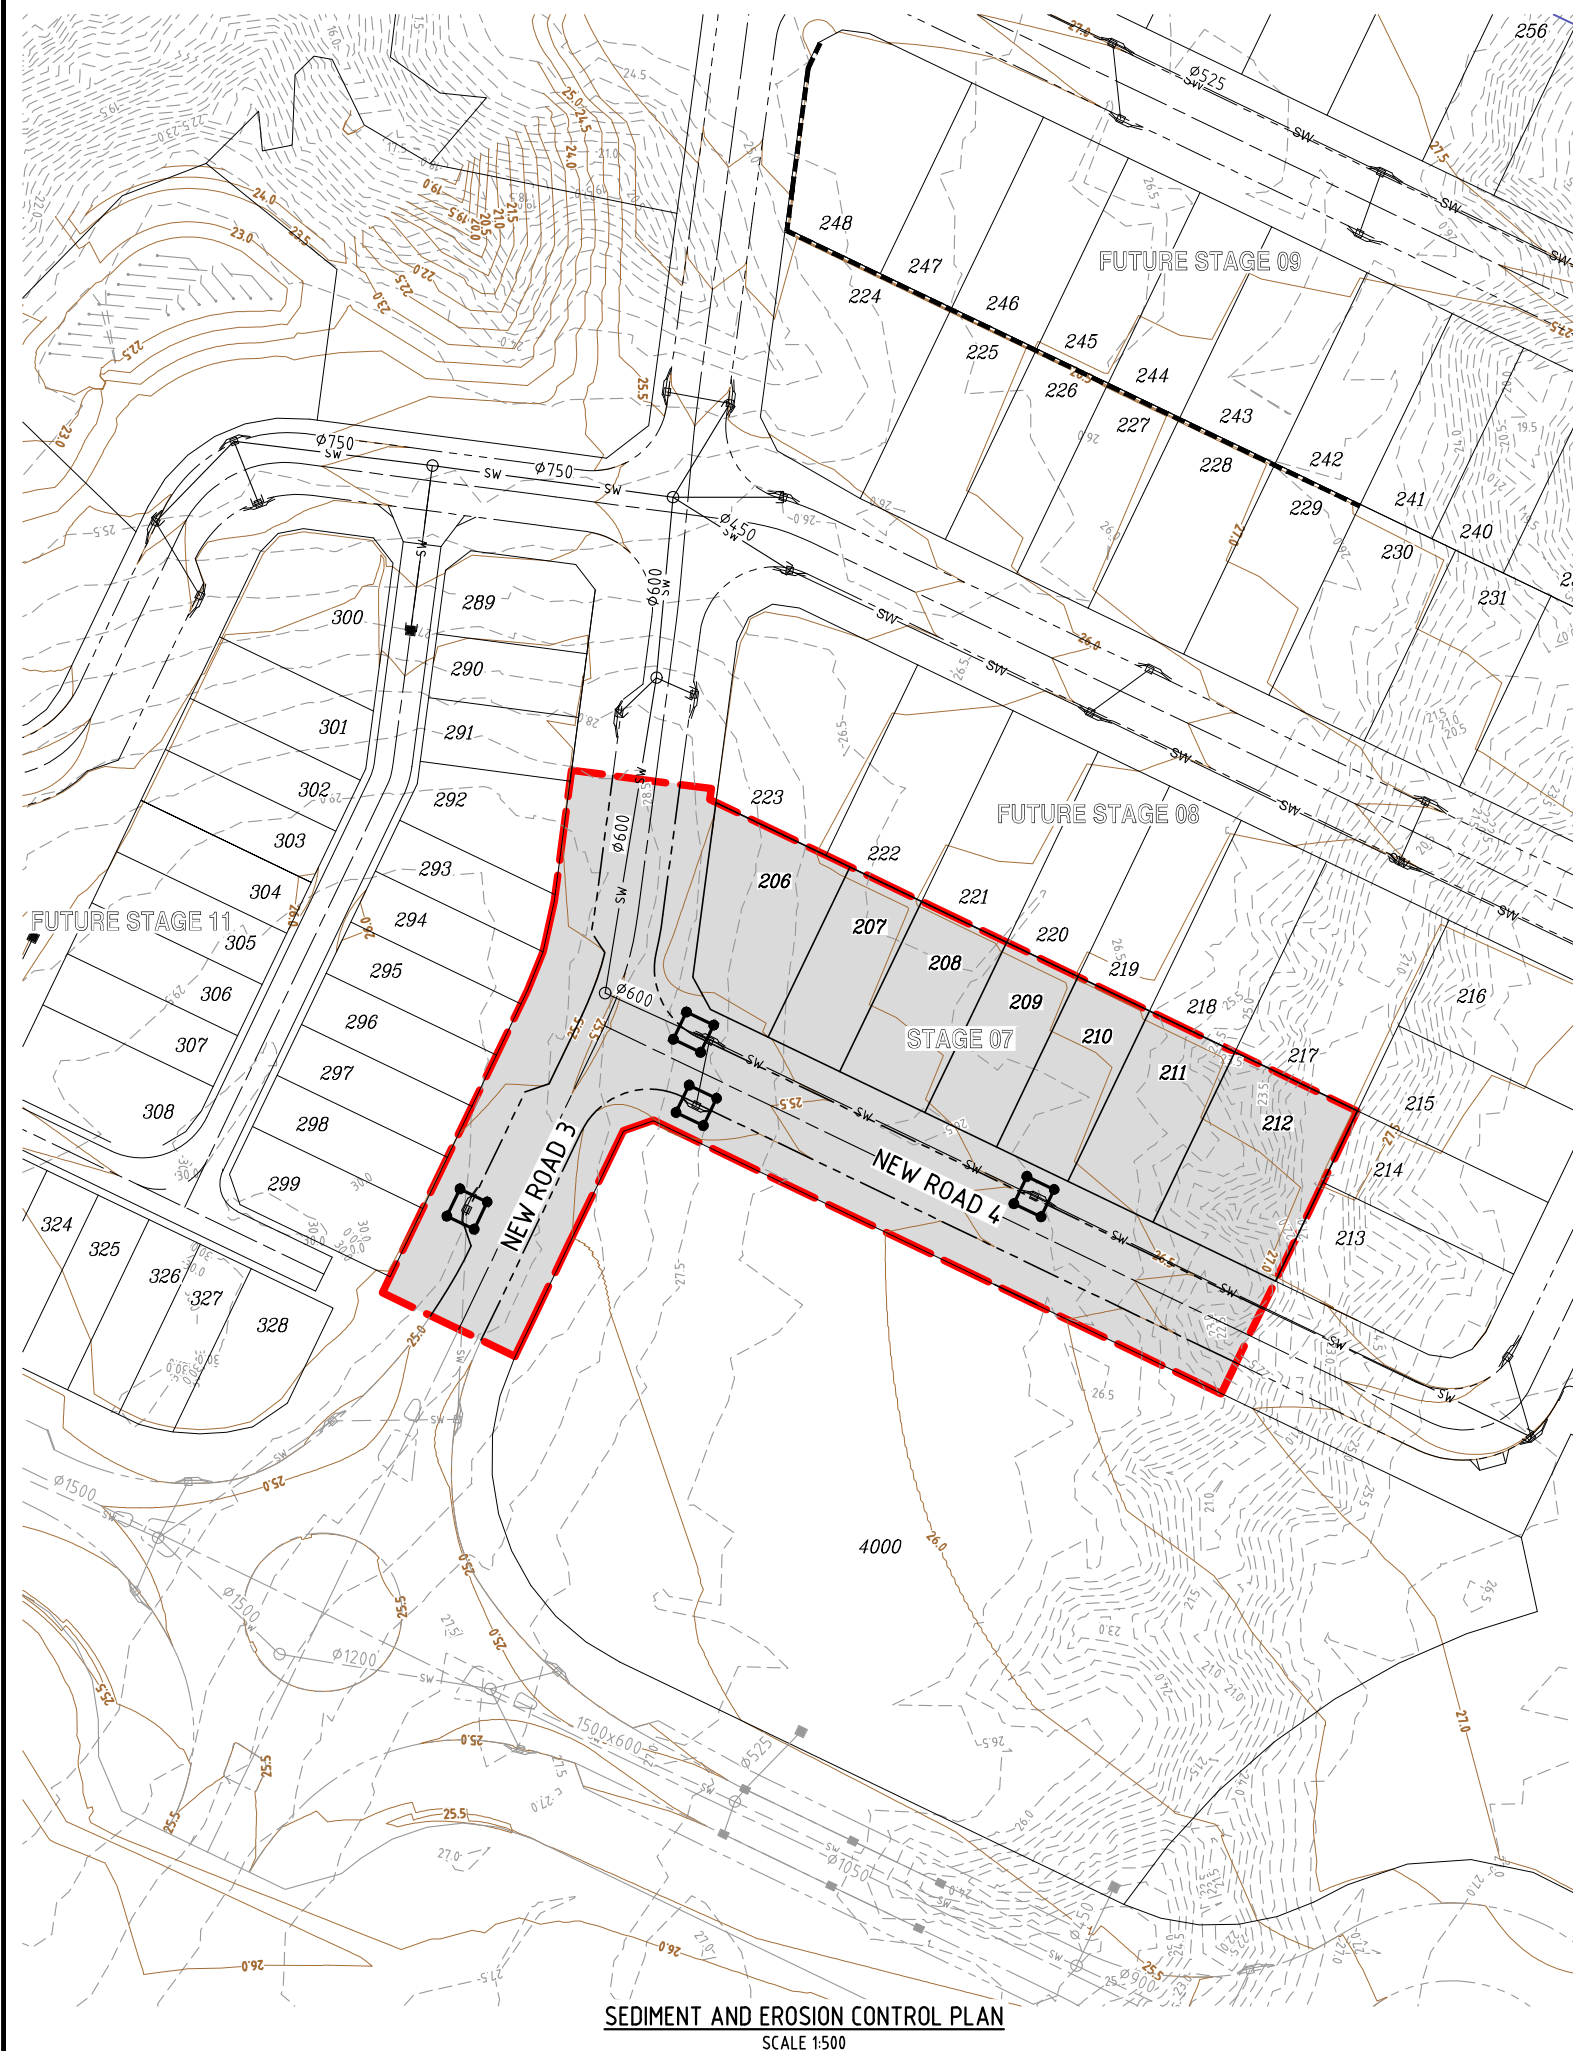

SCALE 
1 : 500 (A1 UNREDUCED)

1. AN APPROPRIATELY MARKED (E.G. PAINTED) DE-SILTING MARKER POST MUST BE INSTALLED IN THE BASIN TO INDICATE THE TOP OF THE SEDIMENT STORAGE ZONE. THE BASIN MUST BE DE-SILTED IF THE NEXT STORM IS LIKELY TO CAUSE SEDIMENT TO SETTLE ABOVE THIS MARKER POINT, OR IF THE SEDIMENT IS ALREADY ABOVE THIS MARKER POINT.
2. PRIOR TO DISCHARGE OF WATER FROM A SEDIMENT BASIN, IT IS ESSENTIAL FOR THE WATER QUALITY TO COMPLY WITH ALL SPECIFIED WATER QUALITY OBJECTIVES (WQOS) (E.G. WATER PH IN THE RANGE OF 6.5 - 8.5).
3. THE RECOMMENDED WATER QUALITY STANDARD FOR SEDIMENT BASINS IS PRESENTED IN TABLE B18.

SITE CONDITIONS	DISCHARGE WATER QUALITY STANDARD
POST-STORM DE-WATERING OF SEDIMENT BASINS (E.G. TYPE F AND D BASINS, AND TYPE C BASINS OPERATING AS WET-BASINS).	90 PERCENTILE TOTAL SUSPENDED SOLIDS (TSS) CONCENTRATION NOT EXCEEDING 50mg/L.

1. PLACE REQUIRED GYPSUM QUANTITY (SAY 32kg/100m³ OF WATER) IN APPROXIMATELY 50L DRUM PERFORATED WITH 25mm HOLES AT 150mm SPACING.
2. SUSPEND THE SCREENED, RECIRCULATING PUMP INTAKE INTO THE DRUM.
3. LIFT THE DRUM INTO THE BASIN SUCH THAT BASIN WATER CAN ENTER AND CIRCULATE THROUGH THE DRUM.
4. USING THE PUMP, SPRAY THE GYPSUM-RICH SOLUTION EVENLY OVER THE SURFACE OF THE BASIN UNTIL THE GYPSUM IS FULLY REMOVED FROM THE DRUM. THE PUMP OUTLET MUST SPRAY THE MIXTURE OVER A WIDE AREA RATHER THAN JUST DISCHARGING AS A CONFINED "JET".
5. ALTERNATIVELY, IF TWO PUMPS ARE AVAILABLE, USE THE TWO PUMPS TO CIRCULATE BASIN WATER FIRST TO THE ON-SHORE TANK, AND THEN FROM THE TANK OVER THE SURFACE OF THE BASIN. A LARGE MIXING TANK WILL USUALLY BE REQUIRED.

- EARTH FILL: CLEAN SOIL WITH EMERSON CLASS 2(1), 3, 4, OR 5, AND FREE OF ROOTS, WOODY VEGETATION, ROCKS AND OTHER UNSUITABLE MATERIAL. SOIL WITH EMERSON CLASS 4 AND 5 MAY NOT BE SUITABLE DEPENDING ON PARTICLE SIZE AND DISTRIBUTION AND DEGREE OF DISPERSION. CLASS 2(1) SHOULD ONLY BE USED UPON RECOMMENDATION FROM GEOTECHNICAL SPECIALIST. [ALTERNATIVELY, SET A STANDARD BASED ON EXCHANGEABLE SODIUM PERCENTAGE – SEEK EXPERT ADVICE.]
- RISER PIPE: MINIMUM 250mm DIAMETER.
- SPILLWAY ROCK: HARD, ANGULAR, DURABLE, WEATHER RESISTANT AND EVENLY GRADED ROCK WITH 50% BY WEIGHT LARGER THAN THE SPECIFIED NOMINAL (D50) ROCK SIZE. LARGER ROCK SHOULD DOMINATE, WITH SUFFICIENT SMALL ROCK TO FILL THE VOIDS BETWEEN THE LARGER ROCK. THE DIAMETER OF THE LARGEST ROCK SIZE SHOULD BE NO LARGER THAN 1.5 TIMES THE NOMINAL ROCK SIZE. THE SPECIFIC GRAVITY SHOULD BE AT LEAST 2.5.
- GEOTEXTILE FABRIC: HEAVY-DUTY, NEEDLE-PUNCHED, NON-WOVEN FILTER CLOTH, MINIMUM RIDIM A24 OR EQUIVALENT.

1. NOTWITHSTANDING ANY DESCRIPTION CONTAINED WITHIN THE APPROVED PLANS OR SPECIFICATIONS, THE CONTRACTOR SHALL BE RESPONSIBLE FOR SATISFYING THEMSELVES AS TO THE NATURE AND EXTENT OF THE SPECIFIED WORKS AND THE PHYSICAL AND LEGAL CONDITIONS UNDER WHICH THE WORKS WILL BE CARRIED OUT. THIS SHALL INCLUDE MEANS OF ACCESS, EXTENT OF CLEARING, NATURE OF MATERIAL TO BE EXCAVATED, TYPE AND SIZE OF MECHANICAL PLAN REQUIRED, LOCATION AND SUITABILITY OF WATER SUPPLY FOR CONSTRUCTION AND TESTING PURPOSES, AND ANY OTHER LIKE MATTERS AFFECTING THE CONSTRUCTION OF THE WORKS.
2. REFER TO APPROVED PLANS FOR LOCATION, DIMENSIONS, AND CONSTRUCTION DETAILS. IF THERE ARE QUESTIONS OR PROBLEMS WITH THE LOCATION, DIMENSIONS, OR METHOD OF INSTALLATION, CONTACT THE ENGINEER OR RESPONSIBLE ON-SITE OFFICER FOR ASSISTANCE.
3. BEFORE STARTING ANY CLEARING OR CONSTRUCTION, ENSURE ALL THE NECESSARY MATERIALS AND COMPONENTS ARE ON THE SITE TO AVOID DELAYS IN COMPLETING THE POND ONCE WORKS BEGIN.
4. INSTALL REQUIRED SHORT-TERM SEDIMENT CONTROL MEASURES DOWNSTREAM OF THE PROPOSED EARTHWORKS TO CONTROL SEDIMENT RUNOFF DURING CONSTRUCTION OF THE BASIN.
5. THE AREA TO BE COVERED BY THE EMBANKMENT, BORROW PITS AND INCIDENTAL WORKS, TOGETHER WITH AN AREA EXTENDING BEYOND THE LIMITS OF EACH FOR A DISTANCE NOT EXCEEDING FIVE (5) METRES ALL AROUND MUST BE CLEARED OF ALL TREES, SCRUB, STUMPS, ROOTS, DEAD TIMBER AND RUBBISH AND DISPOSED OF IN A SUITABLE MANNER, DELAY CLEARING THE MAIN POND AREA UNTIL THE EMBANKMENT IS COMPLETE. [MODIFY AS NECESSARY TO LIMIT TOTAL AREA OF DISTURBANCE AND ANY DAMAGE TO PROTECTED VEGETATION].
6. ENSURE ALL HOLES MADE BY GRUBBING WITHIN THE EMBANKMENT FOOTPRINT ARE FILLED WITH SOUND MATERIAL, ADEQUATELY COMPACTED, AND FINISHED FLUSH WITH THE NATURAL SURFACE.
7. IS SUITABLE AND IT IS PLACED IN THE CORRECT ZONE ACCORDING TO ITS CLASSIFICATION.

1. BEFORE CONSTRUCTION OF THE CUT-OFF TRENCH OR ANY ANCILLARY WORKS WITHIN THE EMBANKMENT FOOTPRINT, ALL GRASS GROWTH AND TOPSOIL MUST BE REMOVED FROM THE AREA TO BE OCCUPIED BY THE EMBANKMENT AND MUST BE DEPOSITED CLEAR OF THIS AREA AND RESERVED FOR TOPDRESSING THE COMPLETING EMBANKMENT.
2. EXCAVATE A CUT-OFF TRENCH ALONG THE CENTRE LINE OF THE EARTH FILL EMBANKMENT. CUT THE TRENCH TO STABLE SOIL MATERIAL, BUT IN NO CASE MAKE IT LESS THAN 600MM DEEP. THE CUT-OFF TRENCH MUST EXTEND INTO BOTH ABUTMENTS TO AT LEAST THE ELEVATION OF THE RISER PIPE CREST. MAKE THE MINIMUM BOTTOM WIDTH WIDE ENOUGH TO PERMIT OPERATION OF EXCAVATION AND COMPACTION EQUIPMENT, BUT IN NO CASE LESS THAN 600mm. MAKE THE SIDE SLOPES OF THE TRENCH NO STEEPER THAN 1:1 (H/V).
3. ENSURE ALL WATER, LOOSE SOIL, AND ROCK ARE REMOVED FROM THE TRENCH BEFORE BACKFILLING COMMENCES. THE CUT-OFF TRENCH MUST BE BACKFILLED WITH SELECTED EARTH-FILL OF THE TYPE SPECIFIED FOR THE EMBANKMENT, AND THIS SOIL MUST HAVE A MOISTURE CONTENT AND DEGREE OF COMPACTION THE SAME AS THAT SPECIFIED FOR THE SELECTED CORE ZONE.
4. MATERIAL EXCAVATED FROM THE CUT-OFF TRENCH MAY BE USED IN CONSTRUCTION OF THE EMBANKMENT PROVIDED IT IS SUITABLE AND IT IS PLACED IN THE CORRECT ZONE ACCORDING TO ITS CLASSIFICATION.

1. SCARIFY AREAS ON WHICH FILL IS TO BE PLACED BEFORE PLACING THE FILL.
2. ENSURE ALL FILL MATERIAL USED TO FORM THE EMBANKMENT MEETING THE SPECIFICATIONS CERTIFIED BY A SOIL SCIENTIST OR GEOTECHNICAL SPECIALIST.
3. THE FILL MATERIAL MUST CONTAIN SUFFICIENT MOISTURE SO IT CAN BE FORMED BY HAND INTO A BALL WITHOUT CRUMBLING. IF WATER CAN BE SQUEEZED OUT OF THE BALL, IT IS TOO WET FOR PROPER COMPACTION. PLACE FILL MATERIAL IN 150 TO 250mm CONTINUOUS LAYERS OVER THE ENTIRE LENGTH OF THE FILL AREA THEN COMPACT BEFORE PLACEMENT OF FURTHER FILL.
4. PLACE RISER PIPE OUTLET SYSTEM, IF SPECIFIED, IN APPROPRIATE SEQUENCE WITH THE EMBANKMENT FILLING. REFER TO SPECIFICATIONS SUPPLIED BELOW.
5. UNLESS OTHERWISE SPECIFIED ON THE APPROVED PLANS, COMPACT THE SOIL AT ABOUT 1% TO 2% WET OF OPTIMUM AND TO 95% MODIFIED OR 100% STANDARD COMPACTION.
6. WHERE BOTH DISPERSIVE AND NON-DISPERSIVE CLASSIFIED EARTH-FILL MATERIALS ARE AVAILABLE, NON-DISPERSIVE EARTH-FILL MUST BE USED IN THE CORE ZONE. THE REMAINING CLASSIFIED EARTH-FILL MATERIALS MUST ONLY BE USED AS DIRECTED BY [INSERT TITLE].
7. WHERE SPECIFIED, ALLOW THE EMBANKMENT TO AN ELEVATION 10% HIGHER THAN THE DESIGN HEIGHT TO ALLOW FOR SETTLING. OTHERWISE FINISHED DIMENSIONS OF THE EMBANKMENT AFTER SPREADING OF TOPSOIL MUST CONFORM TO THE DRAWING WITH A TOLERANCE OF 75mm FROM THE SPECIFIED DIMENSIONS.
8. ENSURE DEBRIS AND OTHER UNSUITABLE BUILDING WASTE IN NOT PLACED WITHIN THE EARTH EMBANKMENT.
9. AFTER COMPLETION OF THE EMBANKMENT ALL LOOSE UNCOMPACTED EARTH-FILL MATERIAL OF THE UPSTREAM AND DOWNSTREAM BATTER MUST BE REMOVED PRIOR TO SPREADING OF TOPSOIL.
10. TOPSOIL AND REVEGETATE/STABILISED ALL EXPOSED EARTH AS DIRECTED WITHIN THE APPROVED PLANS.


1. THE AREA TO BE COVERED BY THE STORED WATER OUTSIDE THE LIMITS OF THE BORROW PITS MUST BE CLEARED OF ALL SCRUB AND RUBBISH. TREES MUST BE CUT DOWN STUMP HIGH AND REMOVED FROM THE IMMEDIATE VICINITY OF THE WORK.
2. ESTABLISH ALL REQUIRED INFLOW CHUTES AND INLET BAFFLES, IF SPECIFIED, TO ENABLE WATER TO DISCHARGE INTO THE BASIN IN A MANNER THAT WILL NOT CAUSE SOIL EROSION NOR THE RE-SUSPENSION OF SETTLED SEDIMENT.
3. INSTALL A SEDIMENT STORAGE LEVEL MARKER POST WITH A CROSS MEMBER SET JUST BELOW THE TOP OF THE SEDIMENT STORAGE ZONE (AS SPECIFIED ON THE APPROVED PLANS). USE AT LEAST A 75mm WIDE POST FIRMLY SET INTO THE BASIN FLOOR.
4. IF SPECIFIED, INSTALL INTERNAL SETTLING POND BAFFLES. ENSURE THE CREST OF THESE BAFFLES IS SET LEVEL WITH OR JUST BELOW, THE ELEVATION OF THE EMERGENCY SPILLWAY CREST.
5. INSTALL ALL APPROPRIATE MEASURE TO MINIMISE SAFETY RISK TO ON-SITE PERSONNEL AND THE PUBLIC CAUSED BY THE PRESENCE OF THE SETTLING POND. AVOID STEEP, SMOOTH INTERNAL SLOPES. APPROPRIATELY FENCE THE SETTLING POND AND POST WARNING SIGNS IF UNSUPERVISED ACCESS IS LIKELY OR THERE IS CONSIDERED TO BE AN UNACCEPTABLE RISK TO THE PUBLIC.

1. THE SPILLWAY MUST BE EXCAVATED AS SHOWN ON THE PLANS, AND THE EXCAVATED MATERIAL IF CLASSIFIED AS SUITABLE, MUST BE USED IN THE EMBANKMENT, AND IF NOT SUITABLE IT MUST BE DISPOSED OF INTO SPOIL HEAPS.
2. ENSURE EXCAVATED DIMENSIONS ALLOW ADEQUATE BOXING-OUT SUCH THAT THE SPECIFIED ELEVATIONS, GRADES, CHUTE WIDTH, AND ENTRANCE AND EXIT SLOPES FOR THE EMERGENCY SPILLWAY WILL BE ACHIEVED AFTER PLACEMENT OF THE ROCK OR OTHER SCOUR PROTECTION MEASURES AS SPECIFIED IN THE PLANS.
3. PLACE SPECIFIED SCOUR PROTECTION MEASURES ON THE EMERGENCY SPILLWAY. ENSURE THE FINISHED GRADE BLENDS WITH THE SURROUNDING AREA TO ALLOW A SMOOTH FLOW TRANSITION FROM SPILLWAY TO DOWNSTREAM CHANNEL.
4. IF A SYNTHETIC FILTER FABRIC UNDERLAY IS SPECIFIED, PLACE THE FILTER FABRIC DIRECTLY ON TOP OF PREPARED FOUNDATION. IF MORE THAN 1 SHEET OF FILTER FABRIC IS REQUIRED, OVERLAP THE EDGES BY AT LEAST 300mm AND PLACE ANCHOR PINS AT A MINIMUM 1m SPACING ALONG THE OVERLAP. BURY THE UPSTREAM END OF THE FABRIC A MINIMUM 300mm BELOW GROUND AND WHERE NECESSARY, BURY THE LOWER END OF THE FABRIC OR OVERLAP A MINIMUM 300mm OVER THE NEXT DOWNSTREAM SECTION AS REQUIRED. ENSURE THE FILTER FABRIC EXTENDS AT LEAST 1000mm UPSTREAM OF THE SPILLWAY CREST.
5. TAKE CARE NOT TO DAMAGE THE FABRIC DURING OR AFTER PLACEMENT. IF DAMAGE OCCURS, REMOVE THE ROCK AND REPAIR THE SHEET BY ADDING ANOTHER LAYER OF FABRIC WITH A MINIMUM OVERLAP OF 300mm AROUND THE DAMAGED AREA. IF EXTENSIVE DAMAGE IS SUSPECTED, REMOVE AND REPLACE THE ENTIRE SHEET.
6. WHERE LARGE ROCK IS USED, OR MACHINE PLACEMENT IS DIFFICULT, A MINIMUM 100mm LAYER OF FINE GRAVEL, AGGREGATE, OR SAND MAY BE NEEDED TO PROTECT THE FABRIC.
7. PLACEMENT OF ROCK SHOULD FOLLOW IMMEDIATELY AFTER PLACEMENT OF THE FILTER FABRIC. PLACE ROCK SO THAT IT FORMS A DENSE, WELL-GRADED MASS OF ROCK WITH A MINIMUM OF VOIDS. THE DESIRED DISTRIBUTION OF ROCK THROUGHOUT THE MASS MAY BE OBTAINED BY SELECTIVE LOADING AT THE QUARRY AND CONTROLLED DUMPING DURING FINAL PLACEMENT.
8. THE FINISHED SLOPE SHOULD BE FREE OF POCKETS OF SMALL ROCK OR CLUSTERS OF LARGE ROCKS. HAND PLACING MAY BE NECESSARY TO ACHIEVE THE PROPER DISTRIBUTION OF ROCK SIZES TO PRODUCE A RELATIVELY SMOOTH, UNIFORM SURFACE. THE FINISHED GRADE OF THE ROCK SHOULD BLEND WITH THE SURROUNDING AREA. NO OVERFALL OR PROTRUSION OF ROCK SHOULD BE APPARENT.
9. ENSURE THAT THE FINAL ARRANGEMENT OF THE SPILLWAY CREST WILL NOT PROMOTE EXCESSIVE FLOW THROUGH THE ROCK SUCH THAT THE WATER CAN BE RETAINED WITHIN THE SETTLING BASIN AN ELEVATION NO LESS THAN 50m ABOVE OR BELOW THE NOMINATED SPILLWAY CREST ELEVATION.

1. INSPECT THE SEDIMENT BASIN DURING THE FOLLOWING PERIODS:
 - (i) DURING CONSTRUCTION TO DETERMINE WHETHER MACHINERY, FALLING TREES, OR CONSTRUCTION ACTIVITY HAS DAMAGED ANY COMPONENTS OF THE SEDIMENT BASIN. IF DAMAGE HAS OCCURRED, REPAIR IT.
 - (ii) AFTER EACH RUNOFF EVENT. INSPECT THE EROSION DAMAGE AT FLOW ENTRY AND EXIT POINTS. IF DAMAGE HAS OCCURRED, MAKE THE NECESSARY REPAIRS.
 - (iii) AT LEAST WEEKLY DURING THE NOMINATED WET SEASON (IF ANY) OTHERWISE AT LEAST FORTNIGHTLY.
 - (i) PRIOR TO, AND IMMEDIATELY AFTER, PERIOD OF "STOP WORK" OR SITE "SHUTDOWN".
2. CLEAN OUT ACCUMULATED SEDIMENT WHEN IT REACHES THE MARKER BOARD/POST, AND RESTORE THE ORIGINAL STORAGE VOLUME. PLACE SEDIMENT IN A DISPOSABLE AREA OR, IF APPROPRIATE, MIX WITH DRY SOIL ON THE SITE.
3. DO NOT DISPOSE OF SEDIMENT IN A MANNER THAT WILL CREATE AN EROSION OR POLLUTION HAZARD.
4. CHECK ALL VISIBLE PIPE CONNECTIONS FOR LEAKS, AND REPAIR AS NECESSARY.
5. CHECK FILL MATERIAL IN THE DAM FOR EXCESSIVE SETTLEMENT, SLUMPING OF THE SLOPES OR PIPING BETWEEN THE CONDUIT AND THE EMBANKMENT; MAKE ALL NECESSARY REPAIRS.
6. REMOVE ALL TRASH AND OTHER DEBRIS FROM THE BASIN AND RISER.
7. SUBMERGED INFLOW PIPES MUST BE INSPECTED AND DE-SILTED (AS REQUIRED) AFTER EACH INFLOW EVENT.

1. WHEN GRADING AND CONSTRUCTION IN THE DRAINAGE AREA ABOVE A TEMPORARY SEDIMENT BASIN IS COMPLETED AND THE DISTURBED AREAS ARE ADEQUATELY STABILIZED, THE BASIN MUST BE REMOVED OR OTHERWISE INCORPORATED INTO THE PERMANENT STORMWATER DRAINAGE SYSTEM. IN EITHER CASE, SEDIMENT SHOULD BE CLEARED AND PROPERLY DISPOSED OF AND THE BASIN AREA STABILIZED.
2. BEFORE STARTING ANY MAINTENANCE WORK ON THE BASIN OR SPILLWAY, INSTALL ALL NECESSARY SHORT-TERM SEDIMENT CONTROL MEASURES DOWNSTREAM OF THE SEDIMENT BASIN.
3. ALL WATER AND SEDIMENT MUST BE REMOVED FROM THE BASIN PRIOR TO THE BASIN'S REMOVAL. DISPOSE OF SEDIMENT AND WATER IN A MANNER THAT WILL NOT CREATE AN EROSION OR POLLUTION HAZARD.
4. BRING THE DISTURBED AREA TO A PROPER GRADE, THEN SMOOTH, COMPACT, AND STABILIZE AND/OR REVEGETATE AS REQUIRED TO ESTABLISH A STABLE LAND SURFACE.

Drawn DF	Designed JB	Checked MAS	Date JAN' 26
Scale AS SHOWN			Sheet 18 of 23
A1	Drawing No 24-277-18		Revision A

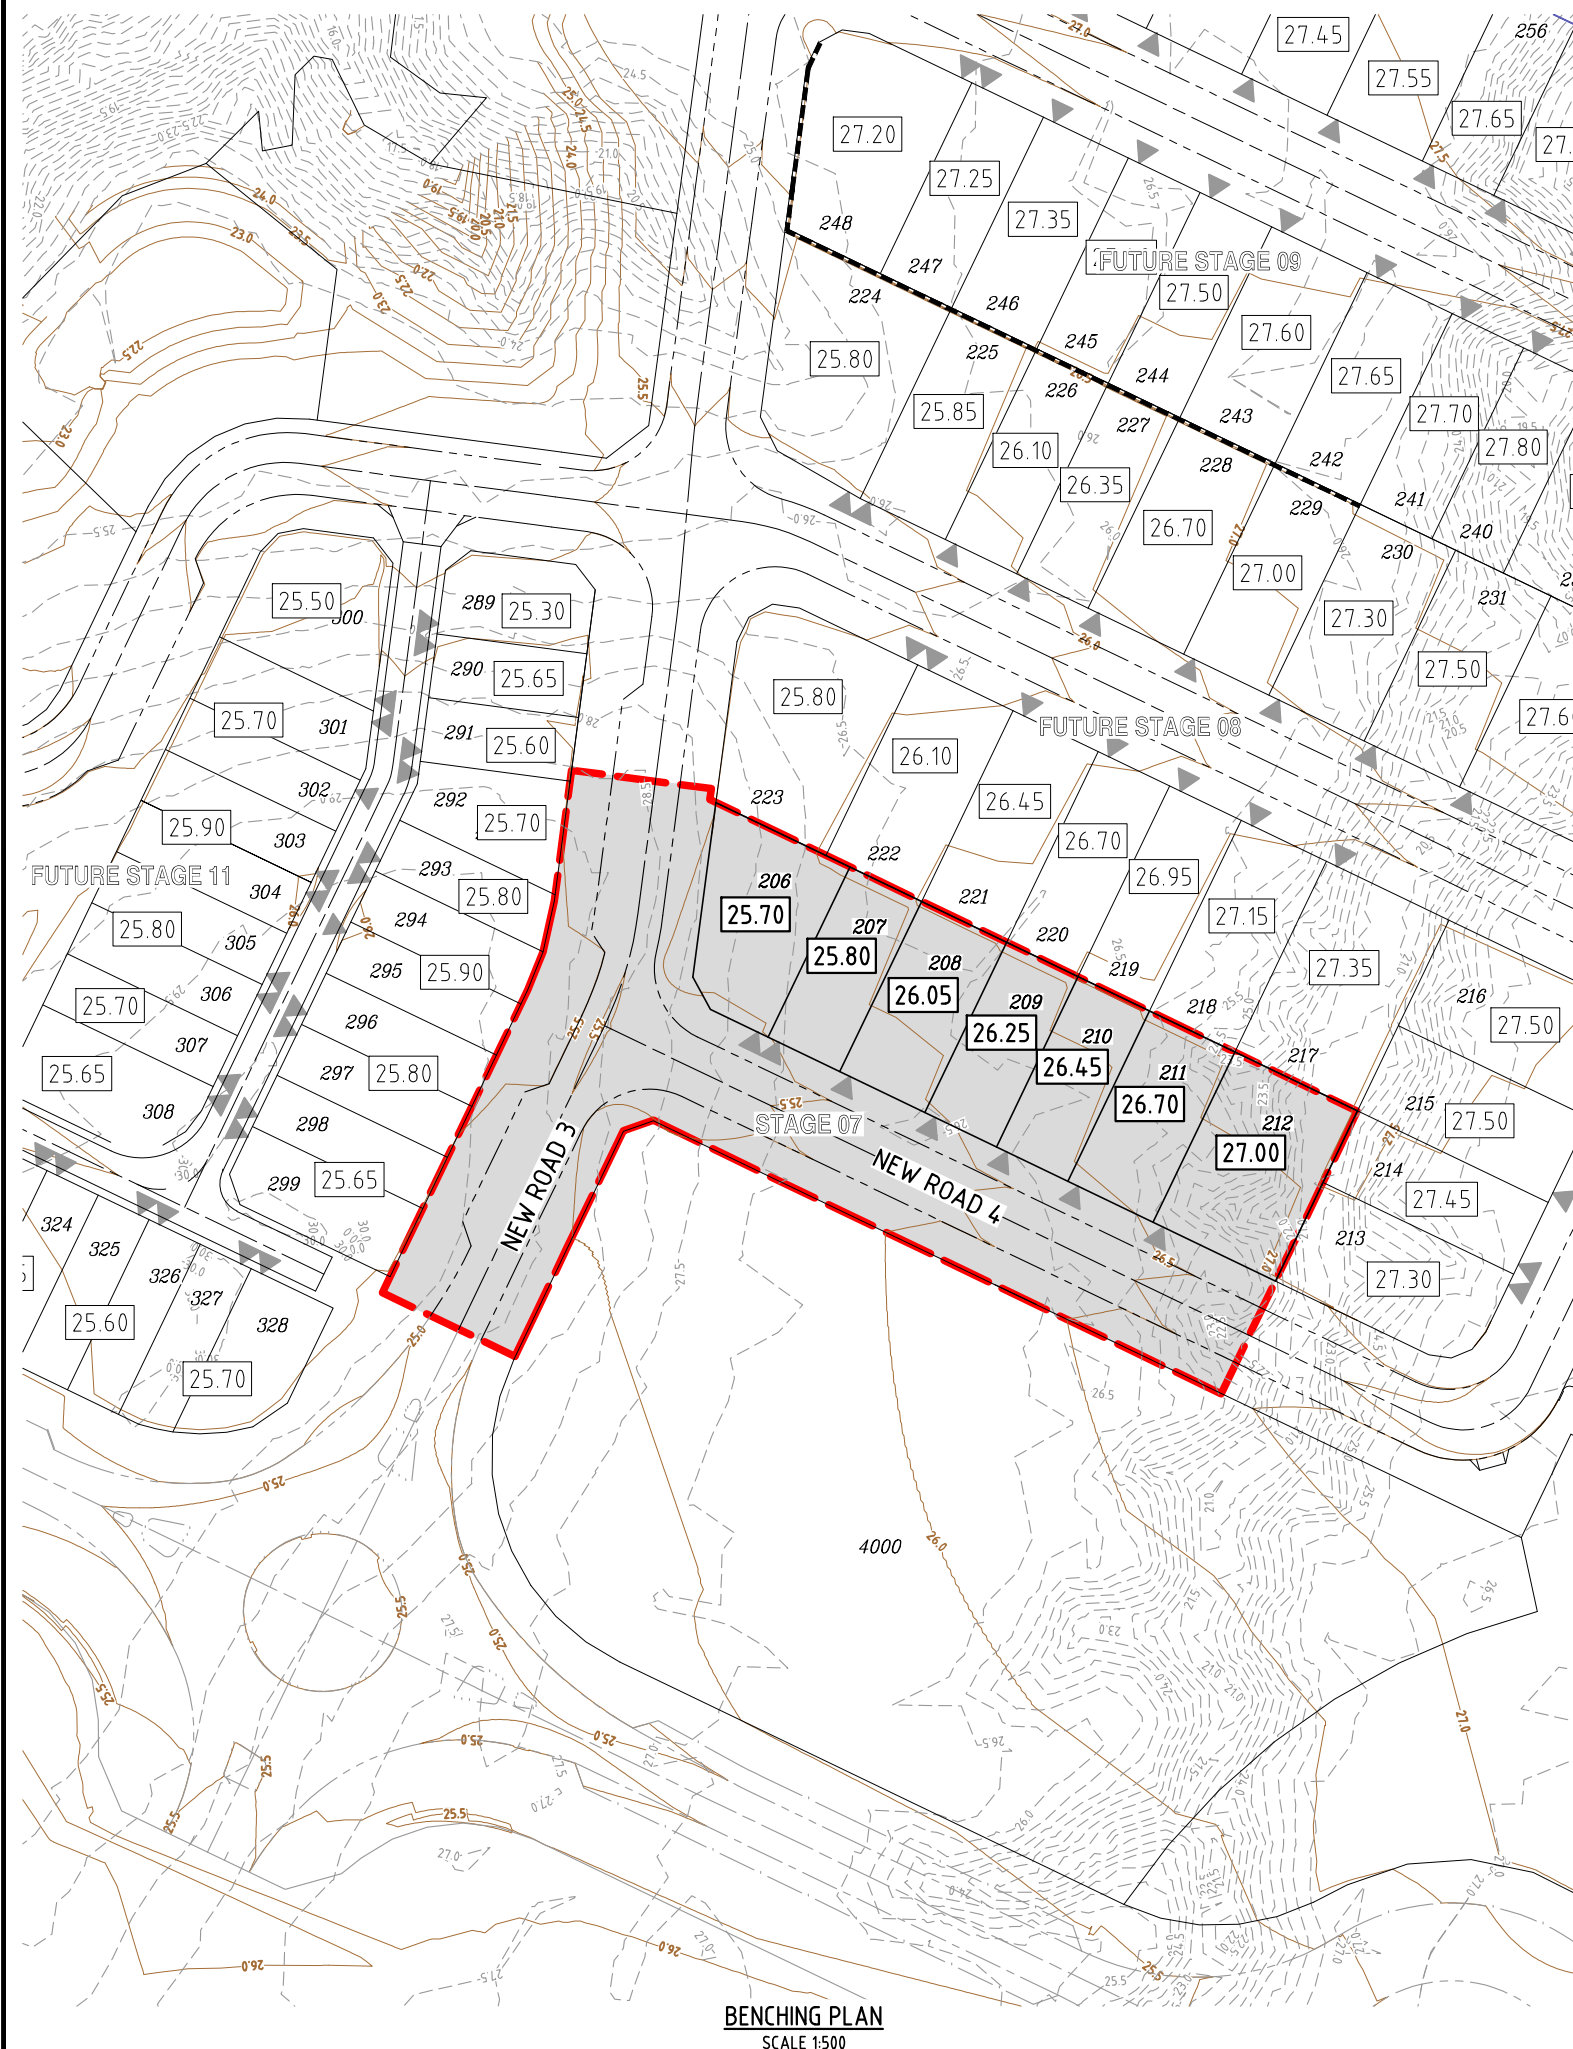

LEGEND

-
- Diagram illustrating the components of a road cross-section, labeled from top to bottom:
- STAGE BOUNDARY
 - PROPOSED ROAD CENTRELINE
 - BARRIER KERB AND CHANNEL (TYPE B1)
 - MOUNTABLE KERB AND CHANNEL (TYPE M1)
 - FINISHED SURFACE CONTOURS
 - NATURAL SURFACE CONTOURS
 - EXISTING CONCRETE RETAINING WALL
 - CONCRETE RETAINING WALL
 - FUTURE RETAINING WALL
 - PREFERRED BENCH LEVEL
 - NOMINATED DRIVEWAY LOCATION

DO NOT SCALE THIS DRAWING
IF IN DOUBT - ASK!



LOCALITY PLAN

STAGE 7



REVISIONS

[illegible]

Client



Project

RIVERMONT
PRECINCT 2
STAGE 7



L1, 62 Astor Terrace, Spring Hill, QLD 4000
www.kngroup.com.au | 07 3017 1900

Approved Director - RPEQ 17544
M. Shaw
 Digitally signed by Mark Shaw RPEQ 17544
 Date: 2026.06.08 14:42:51+10'00'

Drawing Title

PREFERRED BENCHING PLAN


Drawn DF	Designed JB	Checked MAS	Date MAY ' 26
Scale AS SHOWN			Sheet 19 of 20
A1	Drawing No 24-277- 19	Revision B	

PLANS AND DOCUMENTS
referred to in the PDA
DEVELOPMENT APPROVAL

Approval no: DEV-2026-WAR-4914

 Date: 10/07/2026



SCALE 
1 : 500 (A1 UNREDUCED)

