


FOR CONTINUATION REFER DWG C2505




LEGEND	
	WATER MAIN, FLUSHING POINT, SLUICE VALVE, FIRE HYDRANT, REDUCER & END CAP
	PROPOSED ROAD CROSSING
	PROPOSED WATER RETICULATION
	100mm uPVC CLASS 16 CONDUIT
	WATER SERVICES
	PROPOSED STORMWATER DRAINAGE
	PROPOSED SEWER RETICULATION
	EXISTING SEWERAGE RETICULATION
	EXISTING STORMWATER RETICULATION
	EXISTING WATER RETICULATION
	NOMINAL KERB LINE
	SITE BOUNDARY

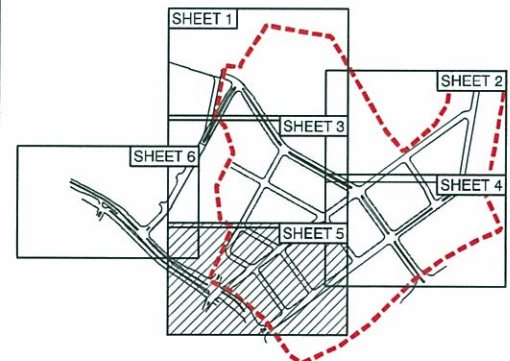

FOR WATER RETICULATION NOTES
REFER DWG C2500-AA005621

Issue	Description	Author	Date
02	G.C.C.C. RFI	TD	07/11/13
01	ISSUE FOR OPW APPROVAL	BD	14/10/13
P3	ISSUE FOR COMMENT	BD	23/08/13
P2	REVISED ISSUE	BD	02/08/13
P1	PRELIMINARY ISSUE	BD	04/07/13

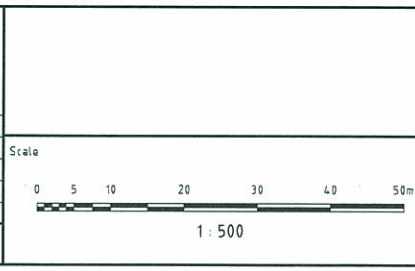

Surveyor

BENNETT • BENNETT
Property Consultants, Surveyors • Town Planners
All mail to: PO Box 5031, COOMERA, Qld. 9728
Email: mail@benettandbenett.com.au
BEN Pty Ltd A.C.N. 010 427 531

COOMERA OFFICE
9 Jowett Street,
COOMERA, 9720
Ph (07) 5573 6177
Fax (07) 5529 4342

Architect

ARCHELAGO

Filename: C2500-C2505-AA005621-WAT LAYOUT.DWG

Queensland Government

DEPARTMENT OF STATE
DEVELOPMENT, INFRASTRUCTURE
& PLANNING

FOR APPROVAL NOT FOR CONSTRUCTION	
Approved	REPQ No. 8677
Scales	1:500
Original Size	A1
Height Datum	AHD
Grid	MGA
Current Issue Signatures	
Author B.DAVEY	
Designer T.DINGLE	
Reviewer B.THOMPSON	
© Copyright reserved	

Project

**GOLD COAST
PARKLANDS REDEVELOPMENT**

TRUNK INFRASTRUCTURE

Title

**WATER RETICULATION
LAYOUT PLAN -
SHEET 5 OF 6**

Hyder

HYDER CONSULTING PTY. LTD
ABN 76 104 485 289
P O Box 1653
Southport, QLD 4215
Australia
Tel: +61 (07) 5532 3933
Fax: +61 (07) 5591 4778
www.hyderconsulting.com

Drawing No.

C2504

Project No.

AA005621

Issue

02

PLANS AND DOCUMENTS
referred to in the PDA APPROVAL


23 DEC 2013

MEDQ


FOR CONTINUATION REFER DWG C2502

FOR CONTINUATION REFER DWG C2503

WARNING : UNDERGROUND SERVICES
UNDERGROUND SERVICES EXIST IN THIS VICINITY.
THE CONTRACTOR IS TO CONTACT THE
RELEVANT AUTHORITIES TO CONFIRM EXACT
LOCATION OF SERVICES ON SITE PRIOR TO ANY
EXCAVATION OR CONSTRUCTION COMMENCING.

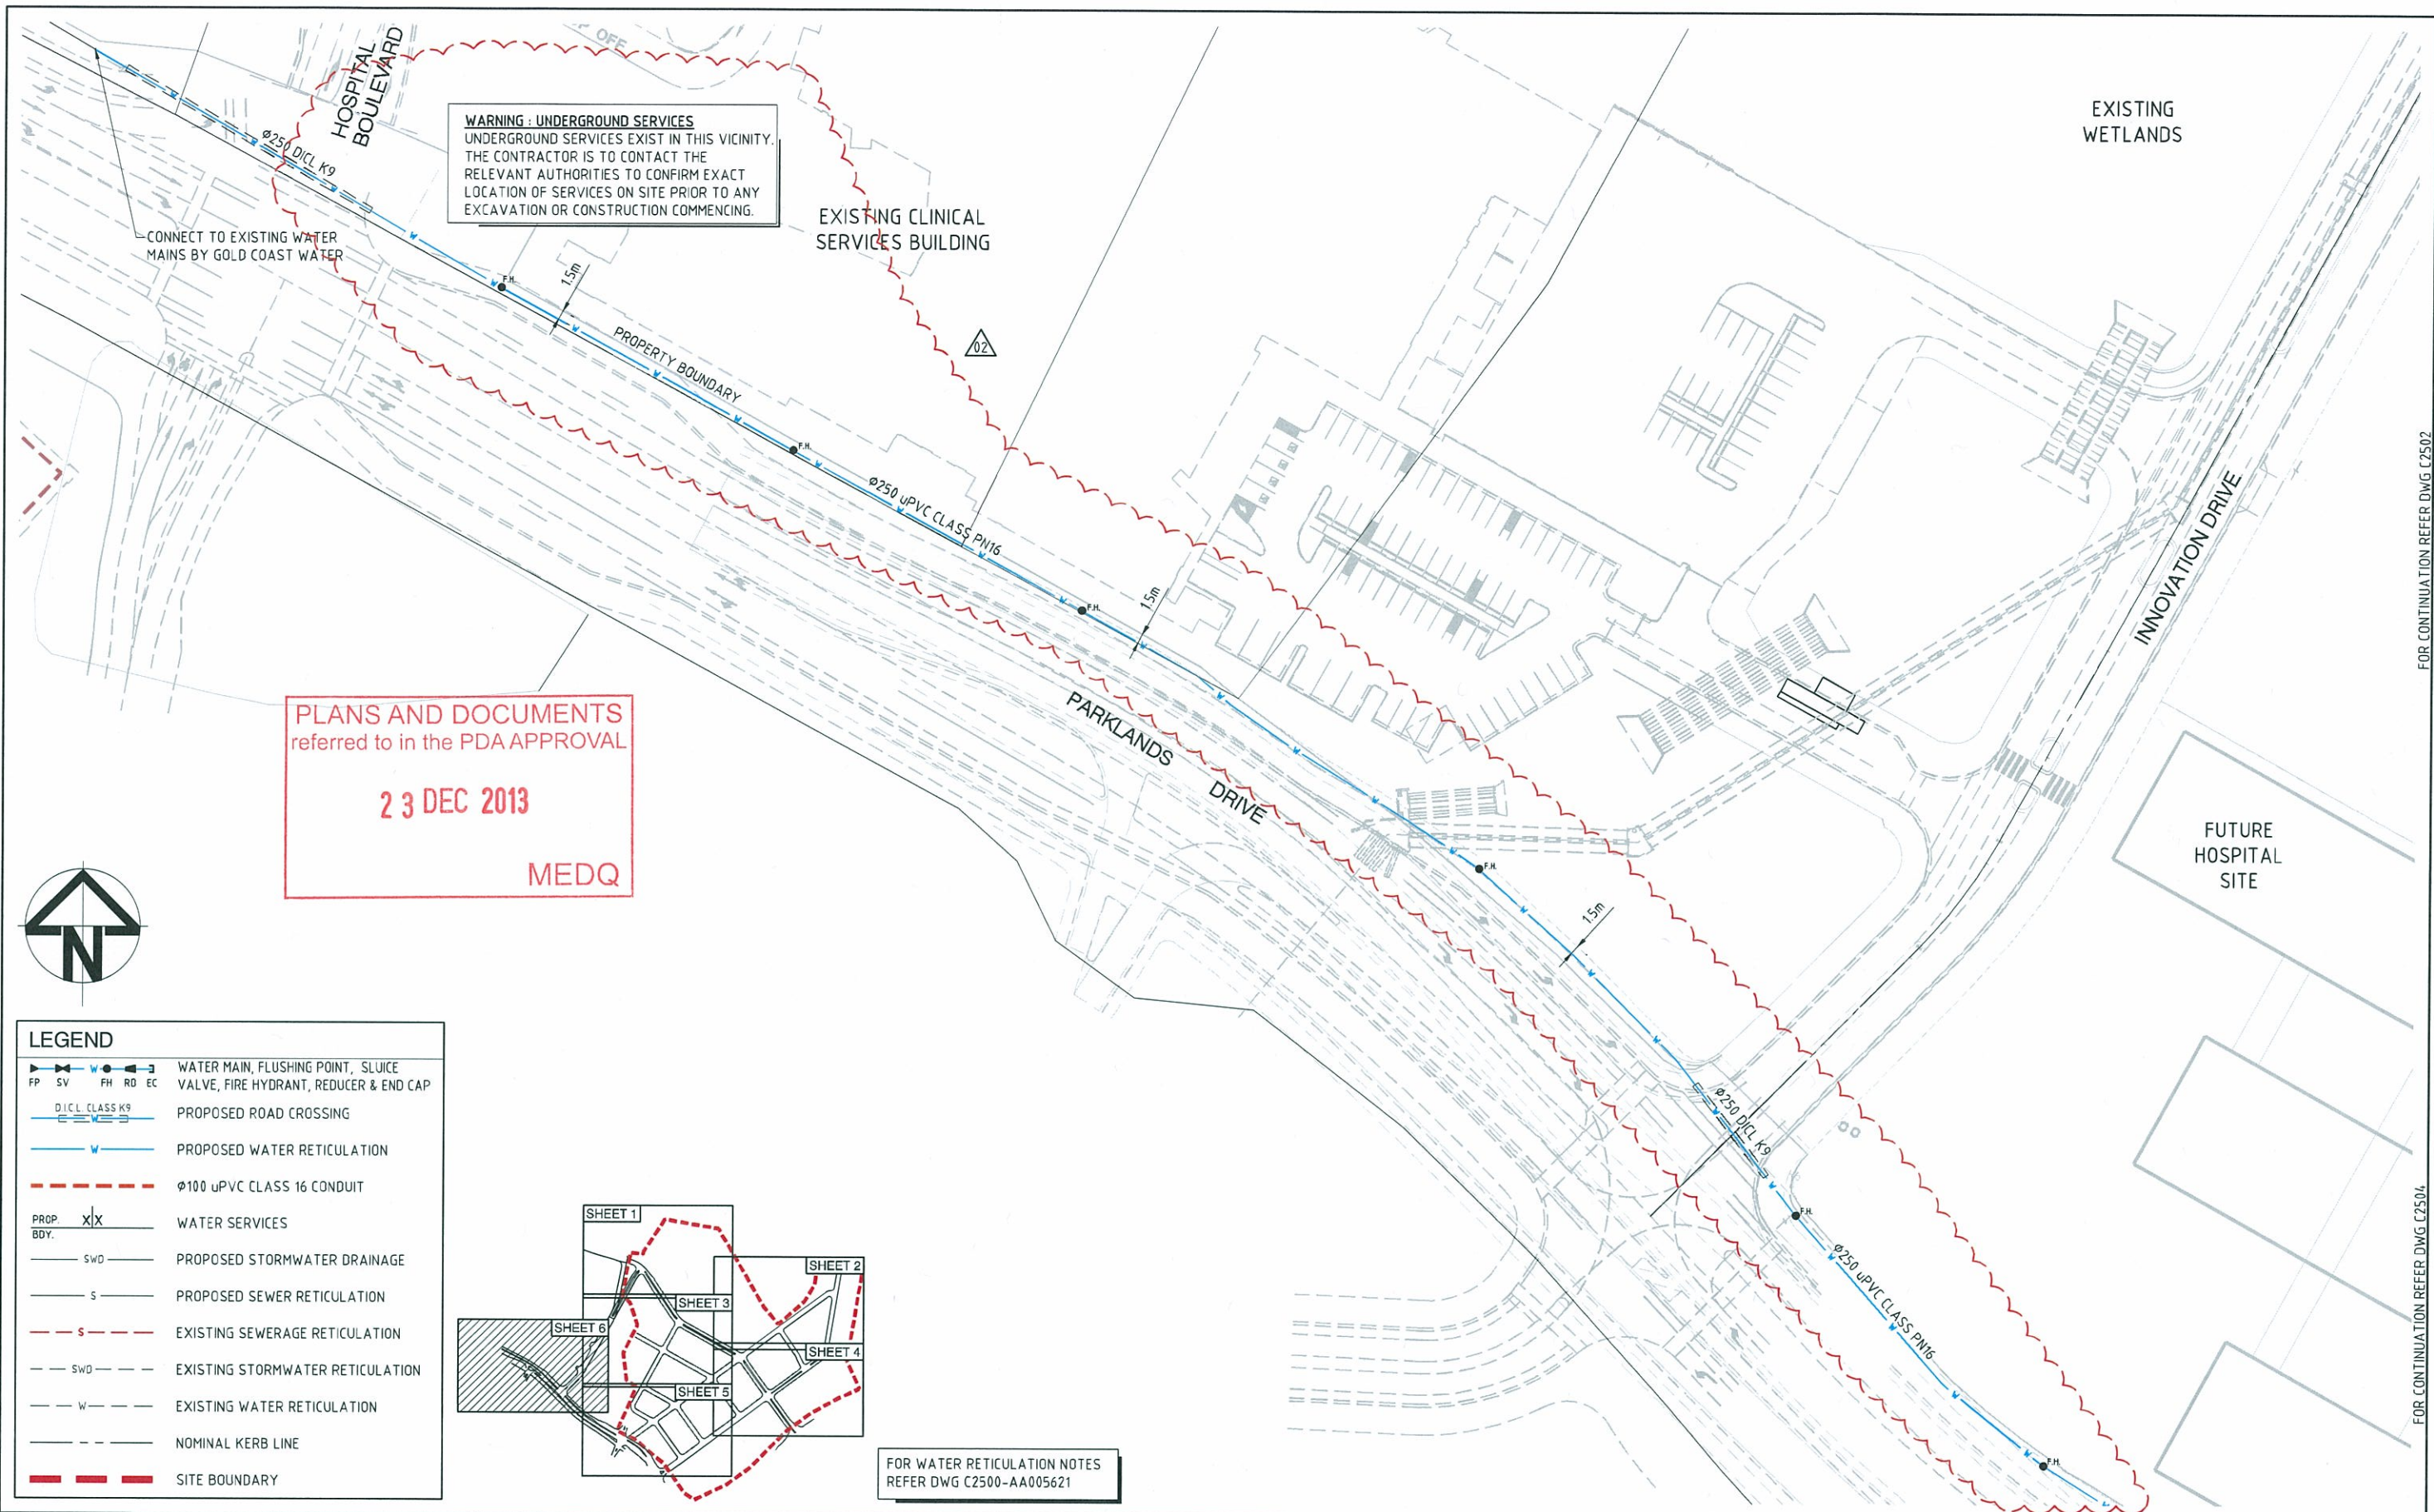

LEGEND	
FP SV FH RD EC	WATER MAIN, FLUSHING POINT, SLUICE VALVE, FIRE HYDRANT, REDUCER & END CAP
DICL CLASS K9	PROPOSED ROAD CROSSING
W	PROPOSED WATER RETICULATION
Ø100 uPVC CLASS 16 CONDUIT	
PROP. X X	WATER SERVICES
SWD	PROPOSED STORMWATER DRAINAGE
S	PROPOSED SEWER RETICULATION
S	EXISTING SEWERAGE RETICULATION
SWD	EXISTING STORMWATER RETICULATION
W	EXISTING WATER RETICULATION
---	NOMINAL KERB LINE
---	SITE BOUNDARY

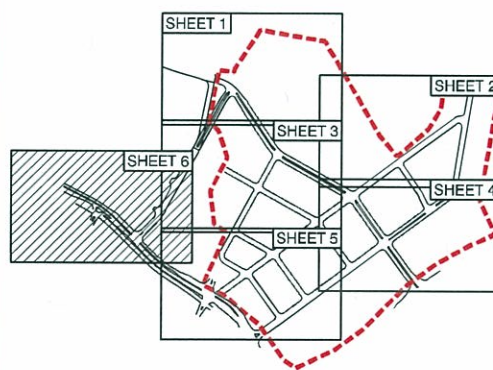

FOR WATER RETICULATION NOTES
REFER DWG C2500-AA005621

02 G.C.C. RFI 01 ISSUE FOR OPW APPROVAL P3 ISSUE FOR COMMENT P2 REVISED ISSUE P1 PRELIMINARY ISSUE Issue Description		TD 07/11/13 BD 14/10/13 BD 23/08/13 BD 02/08/13 BD 04/07/13 Author Date		Scale 0 5 10 20 30 40 50m 1:500		Surveyor BENNETT • BENNETT Property Consultants, Surveyors & Town Planners COOMERA OFFICE 8 Jambell Street Coomera, QLD 4209 All mail to: PO Box 5021, GCMC, Qld 9728 mail@bennettandbenett.com.au BBN Pty Ltd A.C.N. 010 427 531 Ph (07) 5573 6177 Fax (07) 5529 4342		Architect ARCHIPELAGO Filename: C2500-C2505-AA005621-WAT LAYOUT.DWG		Client Queensland Government DEPARTMENT OF STATE DEVELOPMENT, INFRASTRUCTURE & PLANNING		Status FOR APPROVAL NOT FOR CONSTRUCTION Approved REP.Q No: 8677 Scales 1:500 Original Size A1 Height AHD Grid MGA Current Issue Signatures Author B DAVEY Designer T DINGLE Reviewer B THOMPSON © Copyright reserved		Project GOLD COAST PARKLANDS REDEVELOPMENT TRUNK INFRASTRUCTURE Title WATER RETICULATION LAYOUT PLAN - SHEET 6 OF 6		Hyder HYDER CONSULTING PTY. LTD ABN 76 104 485 289 P O Box 1653 Southport, QLD 4215 Australia Tel: +61 (07) 5532 3933 Fax: +61 (07) 5501 4778 www.hyderconsulting.com		Drawing No. C2505 Project No. AA005621 Issue 02	
--	--	---	--	--	--	--	--	---	--	---	--	---	--	--	--	---	--	---	--

FOR CONTINUATION REFER DWG C2502

FOR CONTINUATION REFER DWG C2504

11/Nov/2013 9:34 AM

\\hc-aus-gc-fs-01\jobs\AA005621\E-CAD\Civil\DWG-Final\C2500-C2505-AA005621-WAT LAYOUT.dwg


V1

PLANS AND DOCUMENTS
referred to in the PDA APPROVAL

23 DEC 2013

MEDQ

LEGEND	
	100 LANE LINE (LL).
	200 CONTINUITY LINE (CL).
	100 EDGE LINE (EL). REFER NOTE 4.
	80 CAR PARKING BAYS
	300 STOP LINE (SL).
	300 HOLDING LINE (HL).
	100 TURNING LINE (TL).
	150 PEDESTRIAN LINE (PL).
	CHEVRON
	1200 BIKE LANE

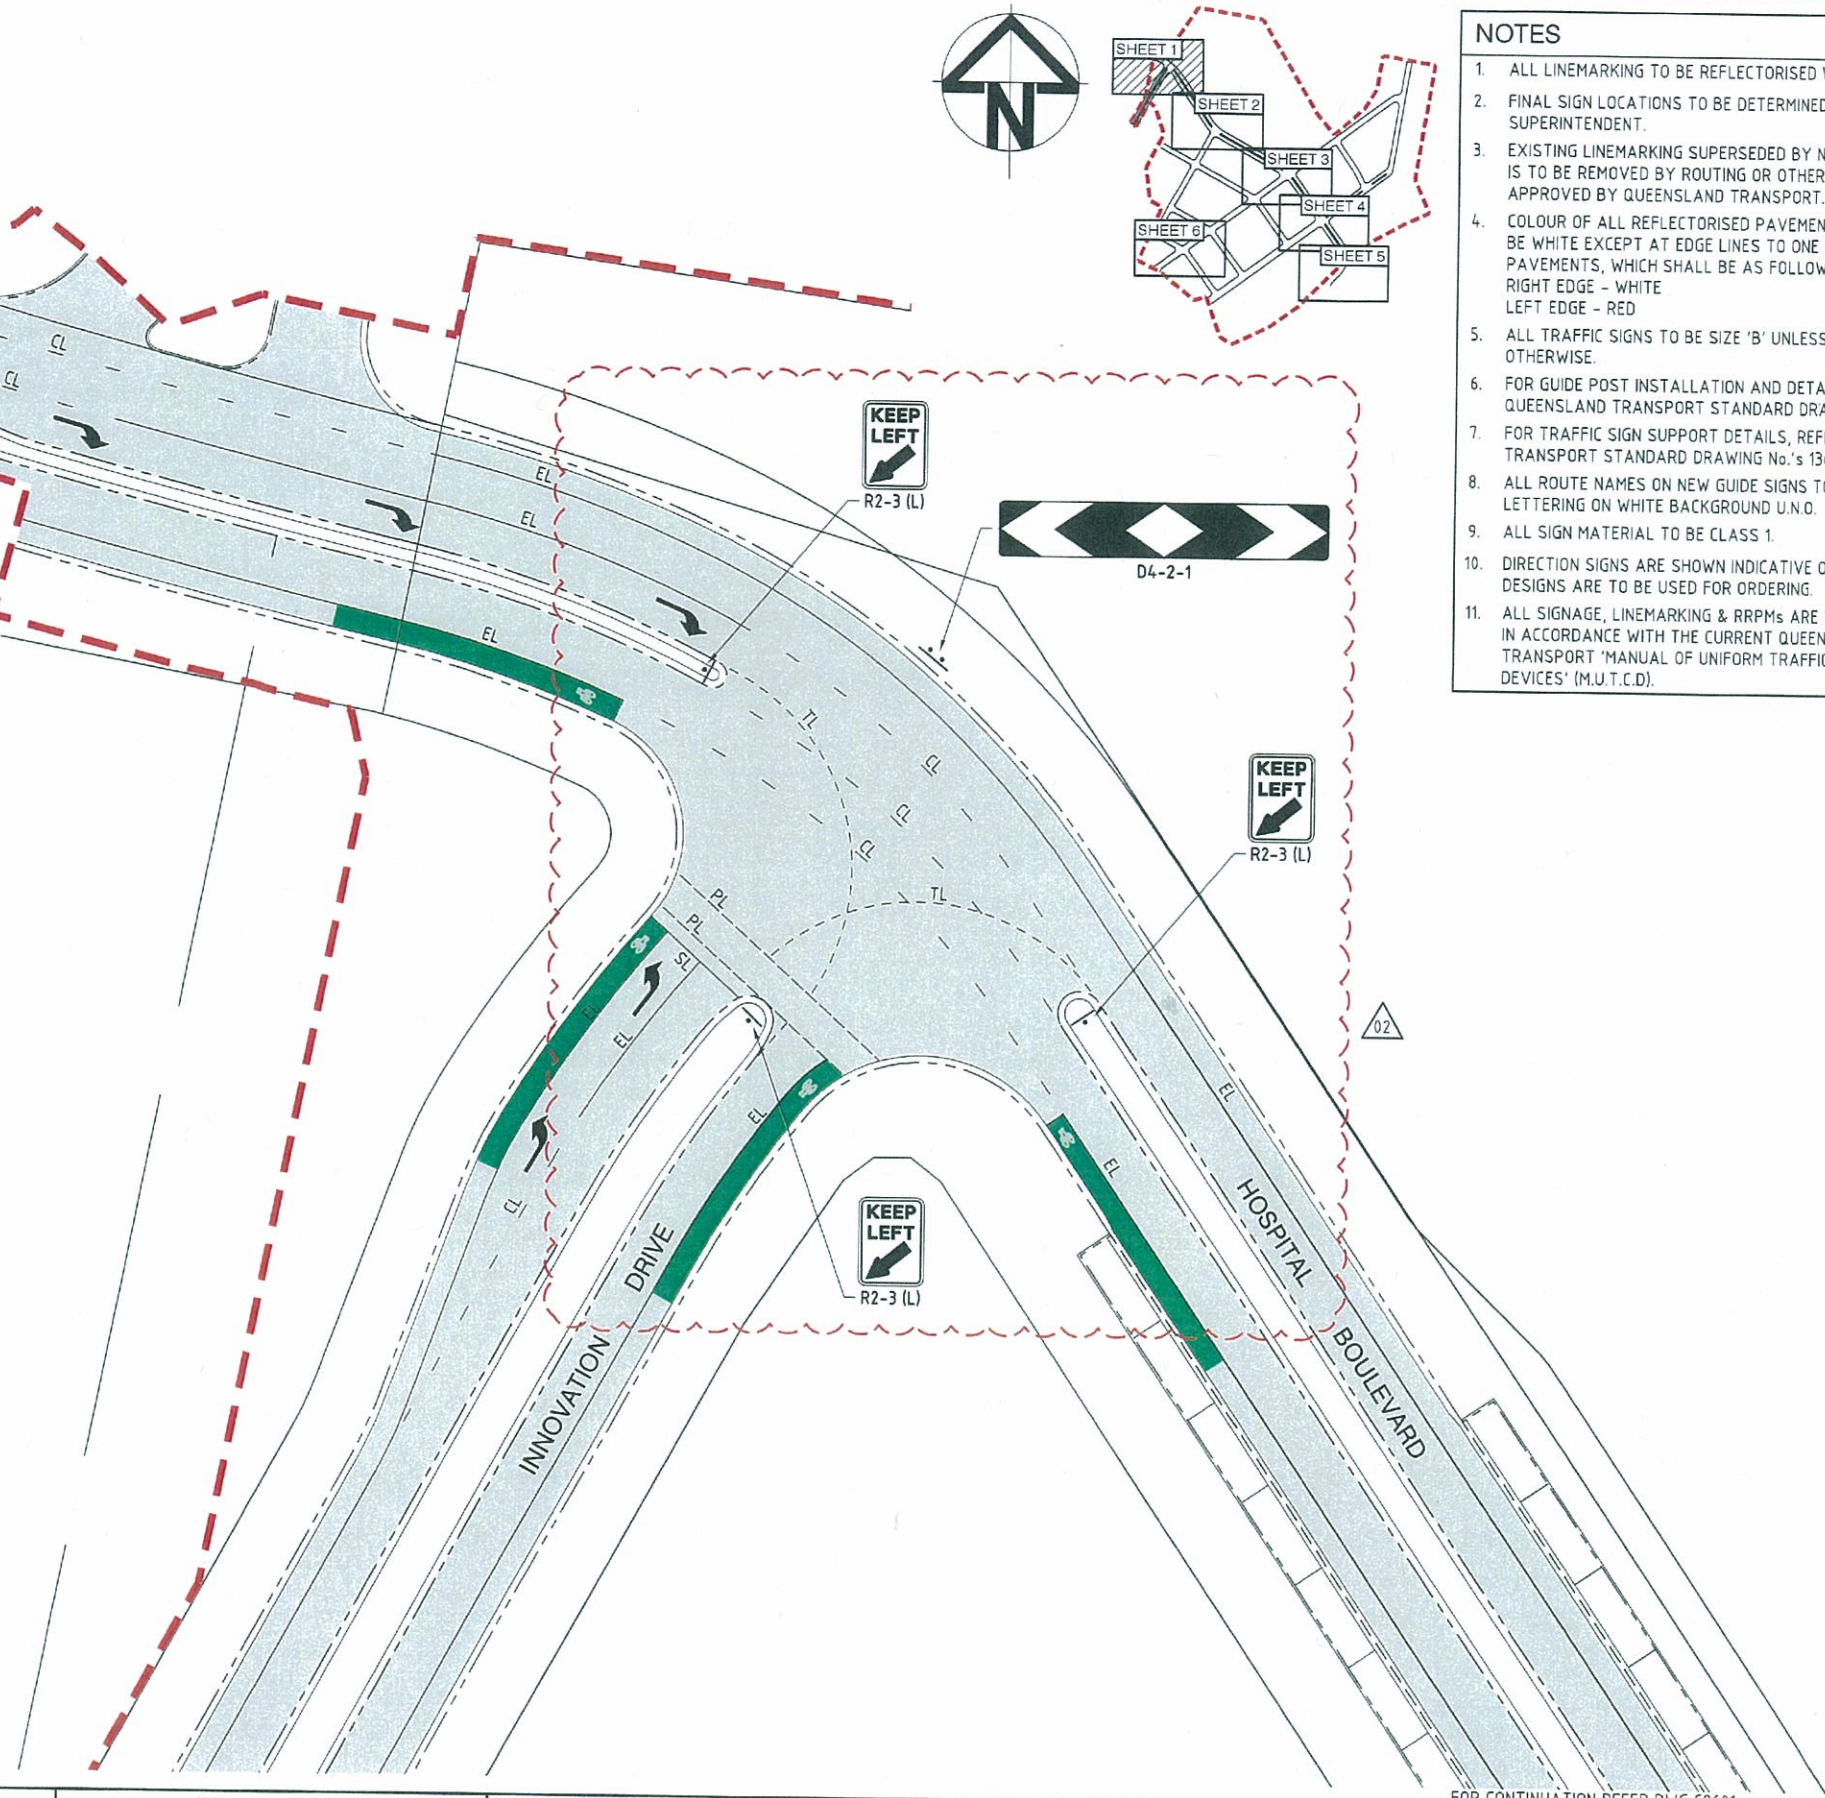


- NOTES
1. ALL LINEMARKING TO BE REFLECTORISED WHITE.
 2. FINAL SIGN LOCATIONS TO BE DETERMINED ON SITE BY THE SUPERINTENDENT.
 3. EXISTING LINEMARKING SUPERSEDED BY NEW LINEMARKING IS TO BE REMOVED BY ROUTING OR OTHER METHOD APPROVED BY QUEENSLAND TRANSPORT.
 4. COLOUR OF ALL REFLECTORISED PAVEMENT MARKERS TO BE WHITE EXCEPT AT EDGE LINES TO ONE WAY PAVEMENTS, WHICH SHALL BE AS FOLLOWS:
RIGHT EDGE - WHITE
LEFT EDGE - RED
 5. ALL TRAFFIC SIGNS TO BE SIZE 'B' UNLESS NOTED OTHERWISE.
 6. FOR GUIDE POST INSTALLATION AND DETAILS, REFER QUEENSLAND TRANSPORT STANDARD DRAWING No.1356
 7. FOR TRAFFIC SIGN SUPPORT DETAILS, REFER QUEENSLAND TRANSPORT STANDARD DRAWING No.'s 1360 & 1362
 8. ALL ROUTE NAMES ON NEW GUIDE SIGNS TO BE BLACK LETTERING ON WHITE BACKGROUND U.N.O.
 9. ALL SIGN MATERIAL TO BE CLASS 1.
 10. DIRECTION SIGNS ARE SHOWN INDICATIVE ONLY. DETAILED DESIGNS ARE TO BE USED FOR ORDERING.
 11. ALL SIGNAGE, LINEMARKING & RRPMS ARE TO BE PREPARED IN ACCORDANCE WITH THE CURRENT QUEENSLAND TRANSPORT 'MANUAL OF UNIFORM TRAFFIC CONTROL DEVICES' (M.U.T.C.D.).

02 GCCC R.F.I. 01 ISSUE FOR DPW APPROVAL Issue Description		BD 15/11/13 BD 16/10/13 Author Date	Scale 0 5 10 15 20 25m 1:250	Surveyor BENNETT + BENNETT Property Consultants, Surveyors - Town Planners All mail to: PO Box 5021, GOVIND, QLD 4220 Tel: (07) 5571 8177 Fax: (07) 5571 8177	Client Queensland Government DEPARTMENT OF STATE DEVELOPMENT, INFRASTRUCTURE & PLANNING	Status FOR APPROVAL NOT FOR CONSTRUCTION Approved <i>[Signature]</i> R.E.P.Q. No. 8677 Scales 1:250 Original Size A1 Height AHD Datum MGA Grid	Project GOLD COAST PARKLANDS REDEVELOPMENT TRUNK INFRASTRUCTURE SIGNAGE & LINEMARKING LAYOUT PLAN - SHEET 1 OF 6	Title Hyder HYDER CONSULTING PTY. LTD ABN 76 104 485 289 P.O. Box 1653 Southport, QLD 4215 Australia Tel: +61 (07) 5532 3933 Fax: +61 (07) 5591 4776 www.hyderconsulting.com
Drawing No. C2600 - AA005621 - 02				Project No. AA005621 - 02				

FOR CONTINUATION REFER DWG C2600




R2-3 (L)

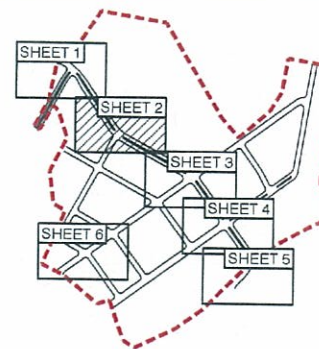

NOTES

1. ALL LINEMARKING TO BE REFLECTORISED WHITE.
2. FINAL SIGN LOCATIONS TO BE DETERMINED ON SITE BY THE SUPERINTENDENT.
3. EXISTING LINEMARKING SUPERSEDED BY NEW LINEMARKING IS TO BE REMOVED BY ROUTING OR OTHER METHOD APPROVED BY QUEENSLAND TRANSPORT.
4. COLOUR OF ALL REFLECTORISED PAVEMENT MARKERS TO BE WHITE EXCEPT AT EDGE LINES TO ONE WAY PAVEMENTS, WHICH SHALL BE AS FOLLOWS:
RIGHT EDGE - WHITE
LEFT EDGE - RED
5. ALL TRAFFIC SIGNS TO BE SIZE 'B' UNLESS NOTED OTHERWISE.
6. FOR GUIDE POST INSTALLATION AND DETAILS, REFER QUEENSLAND TRANSPORT STANDARD DRAWING No.1356
7. FOR TRAFFIC SIGN SUPPORT DETAILS, REFER QUEENSLAND TRANSPORT STANDARD DRAWING No.'s 1360 & 1362.
8. ALL ROUTE NAMES ON NEW GUIDE SIGNS TO BE BLACK LETTERING ON WHITE BACKGROUND U.N.O.
9. ALL SIGN MATERIAL TO BE CLASS 1.
10. DIRECTION SIGNS ARE SHOWN INDICATIVE ONLY. DETAILED DESIGNS ARE TO BE USED FOR ORDERING.
11. ALL SIGNAGE, LINEMARKING & RRPMS ARE TO BE PREPARED IN ACCORDANCE WITH THE CURRENT QUEENSLAND TRANSPORT 'MANUAL OF UNIFORM TRAFFIC CONTROL DEVICES' (M.U.T.C.D.).

LEGEND

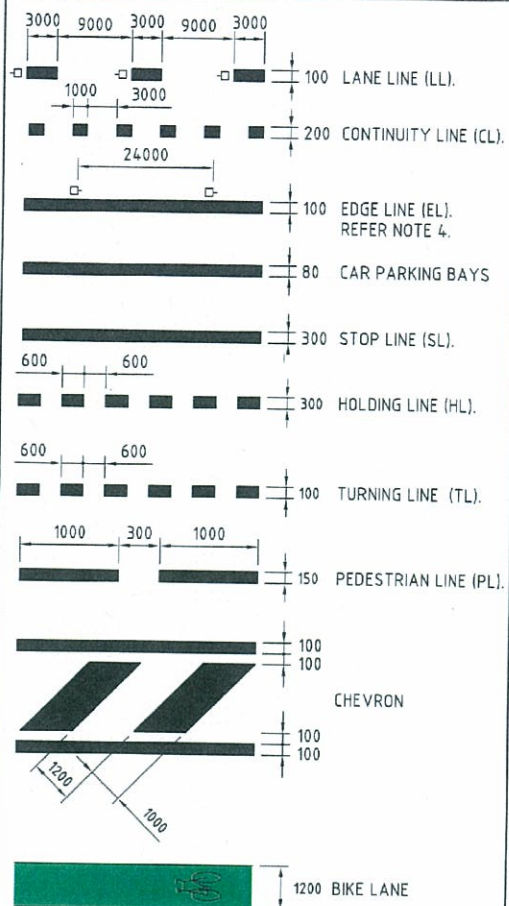

PLANS AND DOCUMENTS
referred to in the PDA APPROVAL

23 DEC 2013

MEDQ



D4-5



D4-2-1



R2-3 (L)

SECOND STREET

HOSPITAL BOULEVARD

FOR CONTINUATION REFER DWG C2602


02 GCCC R.F.I. 01 ISSUE FOR OPW APPROVAL Issue Description		Author Date		Scale 0 5 10 15 20 25m 1:250		Surveyor BENNETT • BENNETT Property Consultants, Surveyors & Town Planners ABN 61 502 502 100 GCMC - Qld 9720 mail@bennettbennett.com.au 180 100 100 100 100 100 180 100 100 100 100 100		Client Queensland Government DEPARTMENT OF STATE DEVELOPMENT, INFRASTRUCTURE & PLANNING		Status FOR APPROVAL NOT FOR CONSTRUCTION Approved <i>[Signature]</i> REP. No. 8677 Scales 1:250 Original Size A1 Height AHD Grid MGA		Project GOLD COAST PARKLANDS REDEVELOPMENT TRUNK INFRASTRUCTURE Signage & Linemarking LAYOUT PLAN - SHEET 2 OF 6		Hyder CONSULTING PTY. LTD ABN 76 104 485 289 P O Box 1653 Southport, QLD 4215 Australia Tel: +61 (07) 5532 3933 Fax: +61 (07) 5591 4778 www.hyderconsulting.com	
02 GCCC R.F.I. 01 ISSUE FOR OPW APPROVAL Issue Description		Author Date		Scale 0 5 10 15 20 25m 1:250		Surveyor BENNETT • BENNETT Property Consultants, Surveyors & Town Planners ABN 61 502 502 100 GCMC - Qld 9720 mail@bennettbennett.com.au 180 100 100 100 100 100 180 100 100 100 100 100		Client Queensland Government DEPARTMENT OF STATE DEVELOPMENT, INFRASTRUCTURE & PLANNING		Status FOR APPROVAL NOT FOR CONSTRUCTION Approved <i>[Signature]</i> REP. No. 8677 Scales 1:250 Original Size A1 Height AHD Grid MGA		Project GOLD COAST PARKLANDS REDEVELOPMENT TRUNK INFRASTRUCTURE Signage & Linemarking LAYOUT PLAN - SHEET 2 OF 6		Hyder CONSULTING PTY. LTD ABN 76 104 485 289 P O Box 1653 Southport, QLD 4215 Australia Tel: +61 (07) 5532 3933 Fax: +61 (07) 5591 4778 www.hyderconsulting.com	

18/Nov/2013 1:06 PM


\\hc-aus-gc-fs-01\jobs\AA005621\E-CAD\Civil\ND-Final\C2600-C2605-AA005621-SIGN & LINE.dwg

V1

FOR CONTINUATION REFER DWG C2601

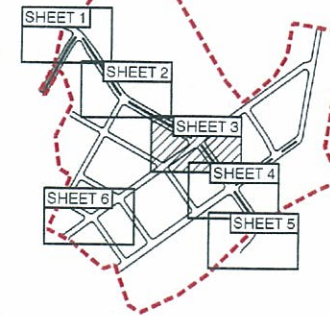

- NOTES**
1. ALL LINEMARKING TO BE REFLECTORISED WHITE.
 2. FINAL SIGN LOCATIONS TO BE DETERMINED ON SITE BY THE SUPERINTENDENT.
 3. EXISTING LINEMARKING SUPERSEDED BY NEW LINEMARKING IS TO BE REMOVED BY ROUTING OR OTHER METHOD APPROVED BY QUEENSLAND TRANSPORT.
 4. COLOUR OF ALL REFLECTORISED PAVEMENT MARKERS TO BE WHITE EXCEPT AT EDGE LINES TO ONE WAY PAVEMENTS, WHICH SHALL BE AS FOLLOWS:
RIGHT EDGE - WHITE
LEFT EDGE - RED
 5. ALL TRAFFIC SIGNS TO BE SIZE 'B' UNLESS NOTED OTHERWISE.
 6. FOR GUIDE POST INSTALLATION AND DETAILS, REFER QUEENSLAND TRANSPORT STANDARD DRAWING No. 1356
 7. FOR TRAFFIC SIGN SUPPORT DETAILS, REFER QUEENSLAND TRANSPORT STANDARD DRAWING No's 1360 & 1362.
 8. ALL ROUTE NAMES ON NEW GUIDE SIGNS TO BE BLACK LETTERING ON WHITE BACKGROUND U.N.O.
 9. ALL SIGN MATERIAL TO BE CLASS 1.
 10. DIRECTION SIGNS ARE SHOWN INDICATIVE ONLY. DETAILED DESIGNS ARE TO BE USED FOR ORDERING.
 11. ALL SIGNAGE, LINEMARKING & RRPMs ARE TO BE PREPARED IN ACCORDANCE WITH THE CURRENT QUEENSLAND TRANSPORT 'MANUAL OF UNIFORM TRAFFIC CONTROL DEVICES' (M.U.T.C.D.).

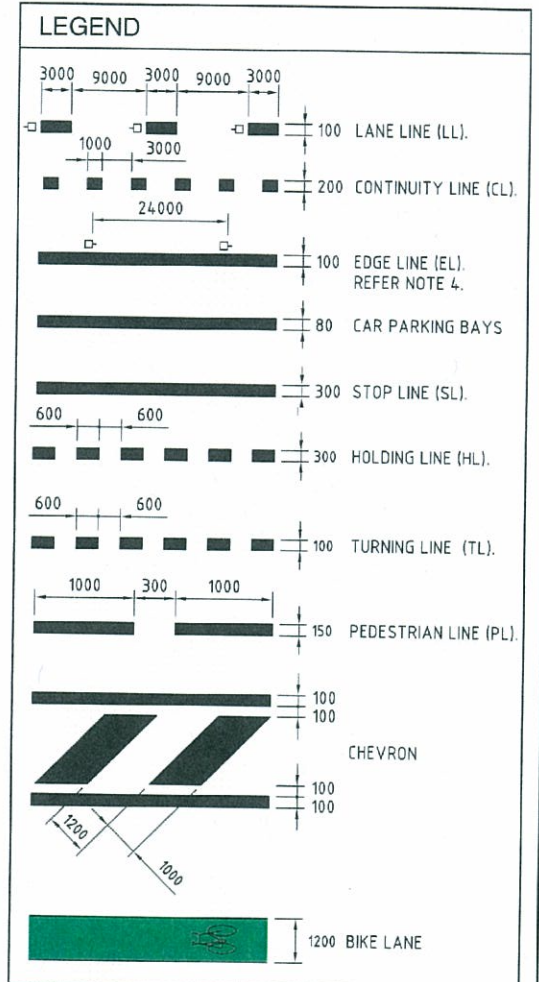


PLANS AND DOCUMENTS
referred to in the PDA APPROVAL

23 DEC 2013

MEDQ

FOR CONTINUATION REFER DWG C2603

02 GCC R.F.I 01 ISSUE FOR OPW APPROVAL Issue Description		BD 15/11/13 BD 14/10/13 Author Date	Scale 0 5 10 15 20 25m 1:250	Surveyor BENNETT • BENNETT Property Consultants, Surveyors & Town Planners All mail to: PO Box 5021, GCMC, QLD 9720 Head Office: 110/111 Sturt Street, GCMC, QLD 9720 Phone: (07) 5575 8177 Fax: (07) 5529 4342	Client Queensland Government DEPARTMENT OF STATE DEVELOPMENT, INFRASTRUCTURE & PLANNING	Status FOR APPROVAL NOT FOR CONSTRUCTION Approved: <i>[Signature]</i> R.L.P. No. 8677 Scales: 1:250 Original Size: A1 Height Datum: AHD Grid: MGA Current Issue Signatures Author: B.DAVEY Designer: T.DINGLE Reviewer: B.THOMPSON Copyright reserved	Project GOLD COAST PARKLANDS REDEVELOPMENT TRUNK INFRASTRUCTURE Title SIGNAGE & LINEMARKING LAYOUT PLAN - SHEET 3 OF 6	Hyder Consulting Pty. Ltd. ABN 76 104 465 289 P.O. Box 1653 Southport, QLD 4215 Australia Tel: +61 (07) 5532 3933 Fax: +61 (07) 5591 4778 www.hyderconsulting.com
Filename: C2600-C2605-AA005621-SIGN & LINE.DWG			Scale 0 5 10 15 20 25m 1:250		18/Nov/2013 1:06 PM \\hc-aus-gc-fs-01\jobs\AA005621\E-CAD\Civil\DWG\C2600-C2605-AA005621-SIGN & LINE.dwg		Drawing No. C2602 Project No. AA005621 Issue 02	

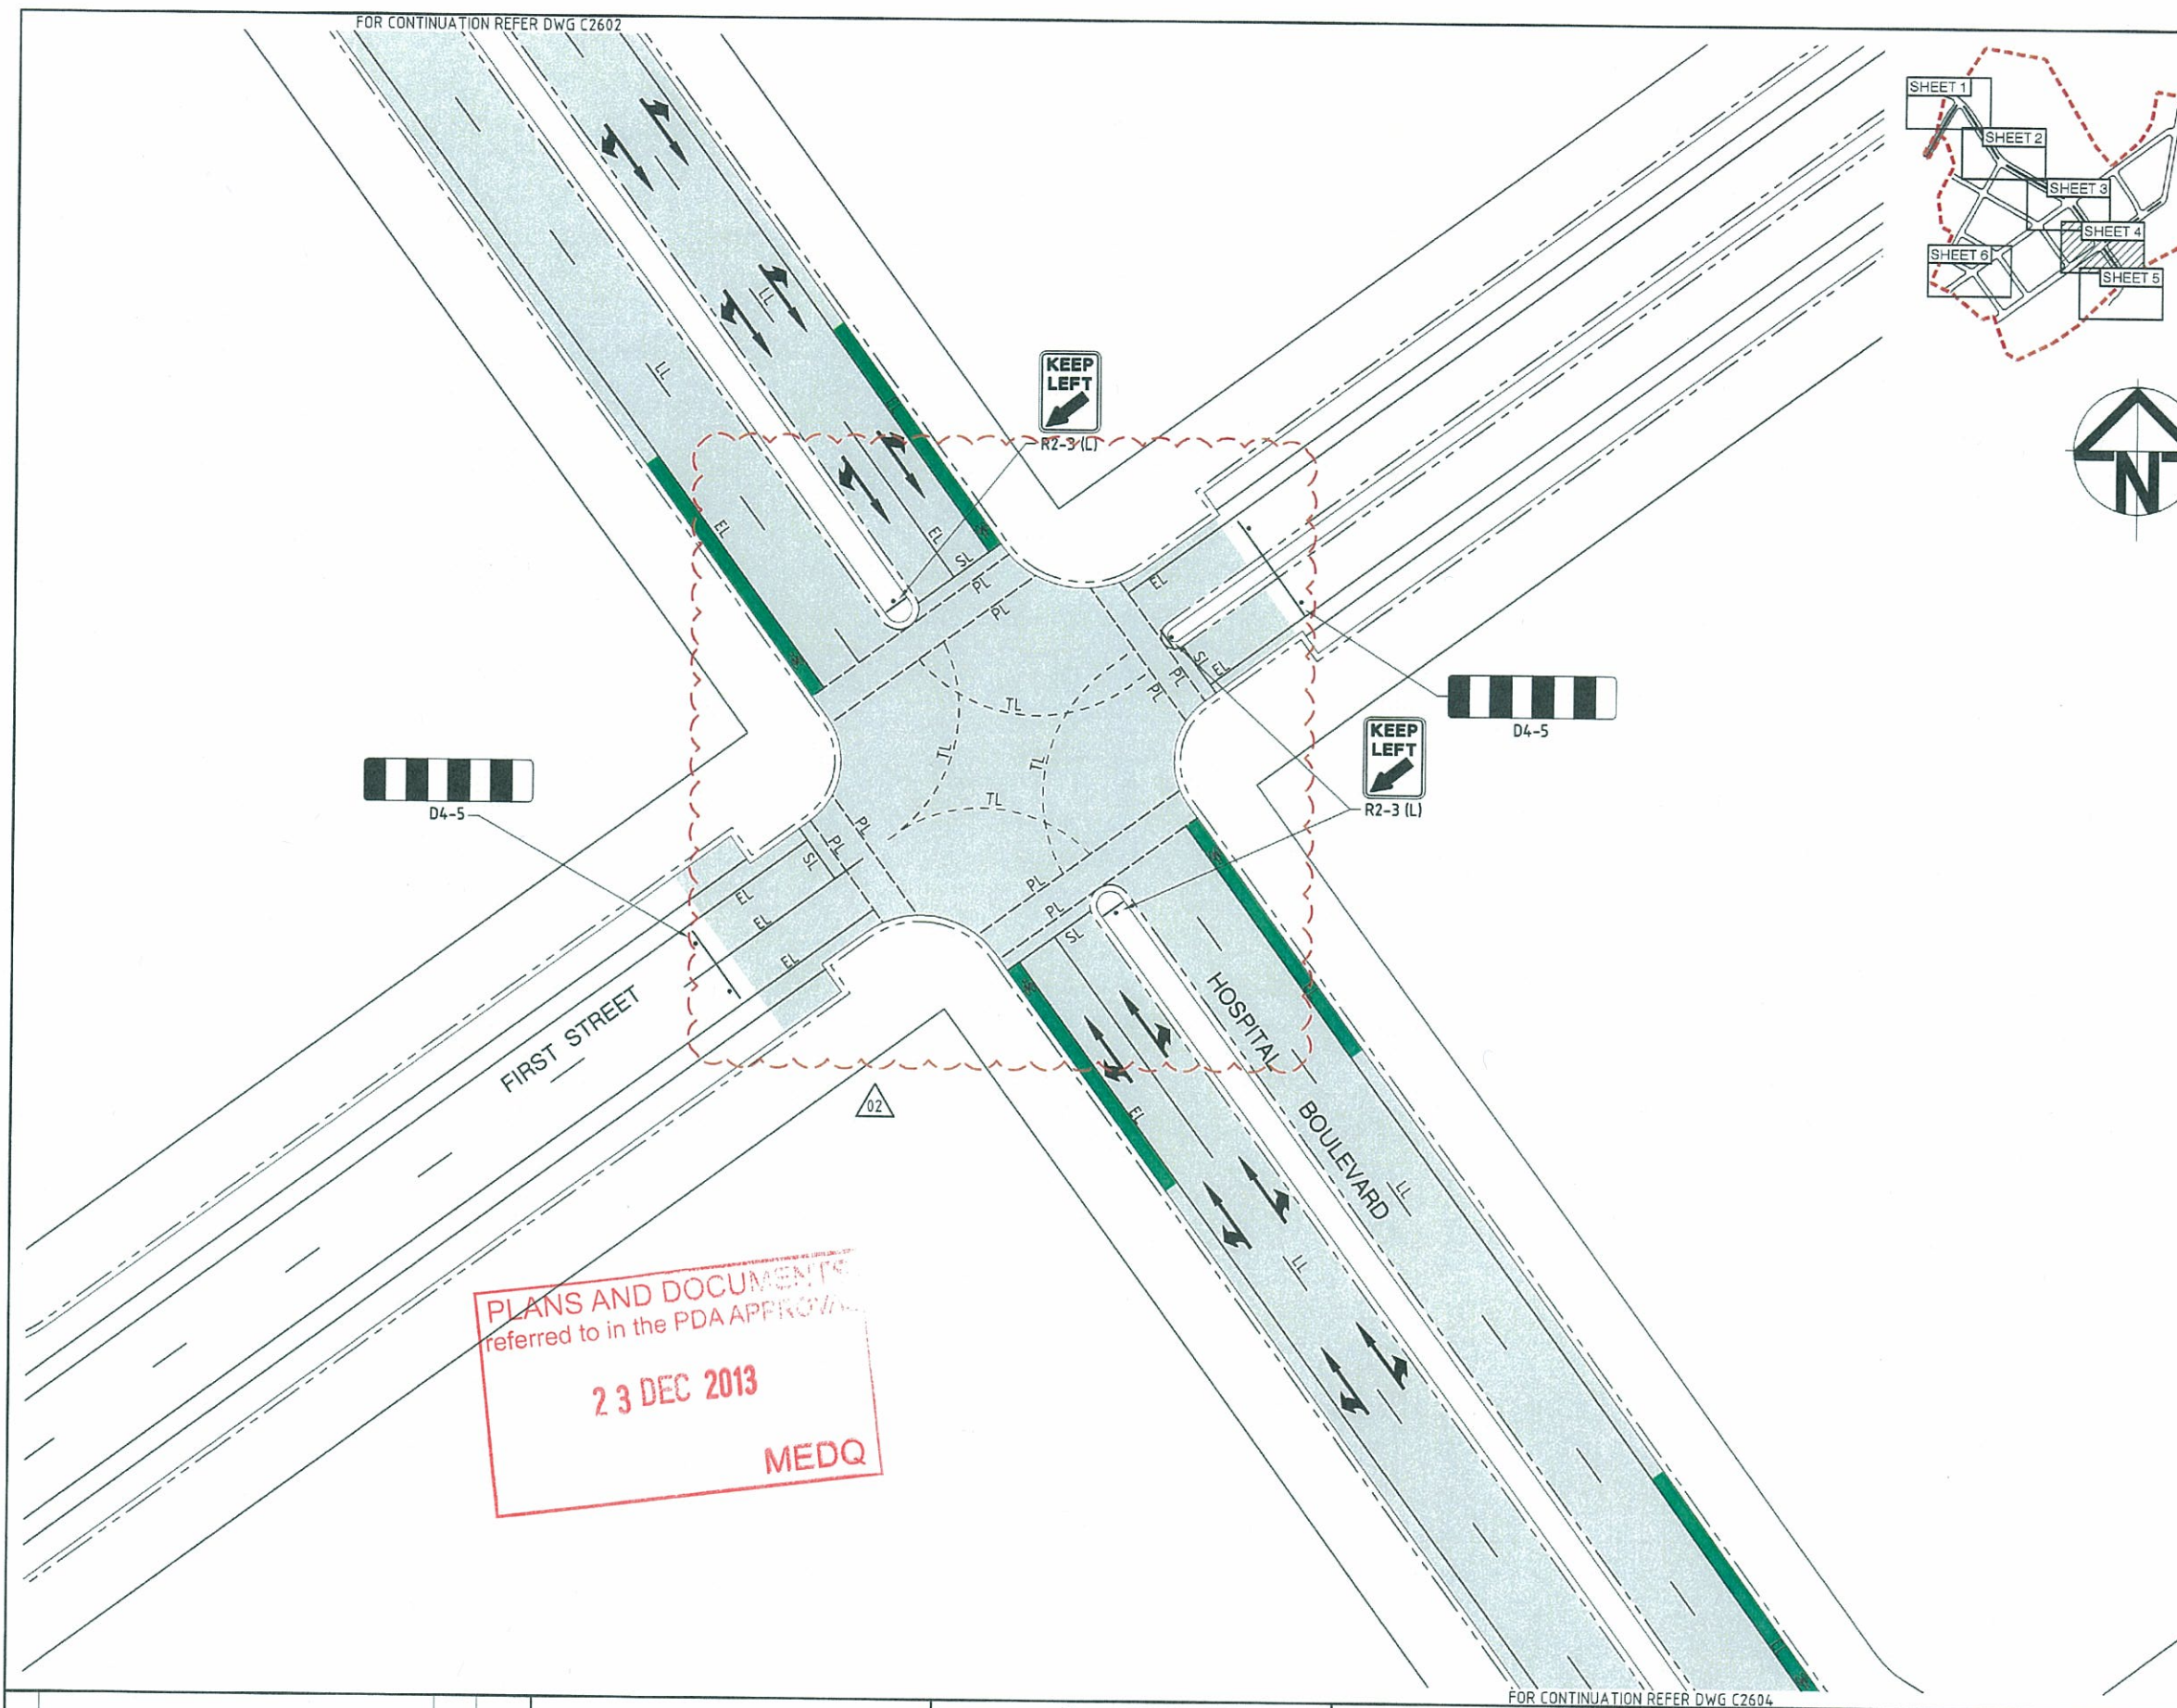

LEGEND

3000 9000 3000 9000 3000	100	LANE LINE (LL)
1000 3000	200	CONTINUITY LINE (CL)
24.000	100	EDGE LINE (EL). REFER NOTE 4.
	80	CAR PARKING BAYS
	300	STOP LINE (SL)
600 600	300	HOLDING LINE (HL)
600 600	100	TURNING LINE (TL)
1000 300 1000	150	PEDESTRIAN LINE (PL)
	100 100	CHEVRON
	100 100	
	1200	BIKE LANE

- ### NOTES
- ALL LINEMARKING TO BE REFLECTORISED WHITE.
 - FINAL SIGN LOCATIONS TO BE DETERMINED ON SITE BY THE SUPERINTENDENT.
 - EXISTING LINEMARKING SUPERSEDED BY NEW LINEMARKING IS TO BE REMOVED BY ROUTING OR OTHER METHOD APPROVED BY QUEENSLAND TRANSPORT.
 - COLOUR OF ALL REFLECTORISED PAVEMENT MARKERS TO BE WHITE EXCEPT AT EDGE LINES TO ONE WAY PAVEMENTS, WHICH SHALL BE AS FOLLOWS:
RIGHT EDGE - WHITE
LEFT EDGE - RED
 - ALL TRAFFIC SIGNS TO BE SIZE 'B' UNLESS NOTED OTHERWISE
 - FOR GUIDE POST INSTALLATION AND DETAILS, REFER QUEENSLAND TRANSPORT STANDARD DRAWING No.1356
 - FOR TRAFFIC SIGN SUPPORT DETAILS, REFER QUEENSLAND TRANSPORT STANDARD DRAWING No.'s 1360 & 1362.
 - ALL ROUTE NAMES ON NEW GUIDE SIGNS TO BE BLACK LETTERING ON WHITE BACKGROUND U.N.O.
 - ALL SIGN MATERIAL TO BE CLASS 1.
 - DIRECTION SIGNS ARE SHOWN INDICATIVE ONLY. DETAILED DESIGNS ARE TO BE USED FOR ORDERING.
 - ALL SIGNAGE, LINEMARKING & RRPMS ARE TO BE PREPARED IN ACCORDANCE WITH THE CURRENT QUEENSLAND TRANSPORT 'MANUAL OF UNIFORM TRAFFIC CONTROL DEVICES' (M.U.T.C.D).


02 GCCC RFI 01 ISSUE FOR DPW APPROVAL Issue Description		BD 15/11/13 BD 14/10/13 Author Date	Scale 0 5 10 15 20 25m 1:250	Surveyor BENNETT • BENNETT Property Consultants, Surveyors & Town Planners All mail to: PO Box 5621, GOCMC, QLD 9726 ma@bennettandbennett.com.au 88m Ph: 08 839 427 801	Client Queensland Government DEPARTMENT OF STATE DEVELOPMENT, INFRASTRUCTURE & PLANNING	Status FOR APPROVAL NOT FOR CONSTRUCTION Approved <i>[Signature]</i> R.E.P.G. No: 8677 Scales 1:250 Original Size A1 Height Datum AHD Grid MGA	Project GOLD COAST PARKLANDS REDEVELOPMENT TRUNK INFRASTRUCTURE Title SIGNAGE & LINEMARKING LAYOUT PLAN - SHEET 4 OF 6	Drawing No. C2603 Project No. AA005621 Issue 02	
Architect ARCHIPELAGO Filenamer: C2600-C2605-AA005621-SIGN & LINE.DWG		Surveyor BENNETT • BENNETT Property Consultants, Surveyors & Town Planners All mail to: PO Box 5621, GOCMC, QLD 9726 ma@bennettandbennett.com.au 88m Ph: 08 839 427 801		Client Queensland Government DEPARTMENT OF STATE DEVELOPMENT, INFRASTRUCTURE & PLANNING		Status FOR APPROVAL NOT FOR CONSTRUCTION Approved <i>[Signature]</i> R.E.P.G. No: 8677 Scales 1:250 Original Size A1 Height Datum AHD Grid MGA		Project GOLD COAST PARKLANDS REDEVELOPMENT TRUNK INFRASTRUCTURE Title SIGNAGE & LINEMARKING LAYOUT PLAN - SHEET 4 OF 6	

PLANS AND DOCUMENTS
referred to in the PDA APPROVAL

23 DEC 2013

MEDQ



FOR CONTINUATION REFER DWG C2603

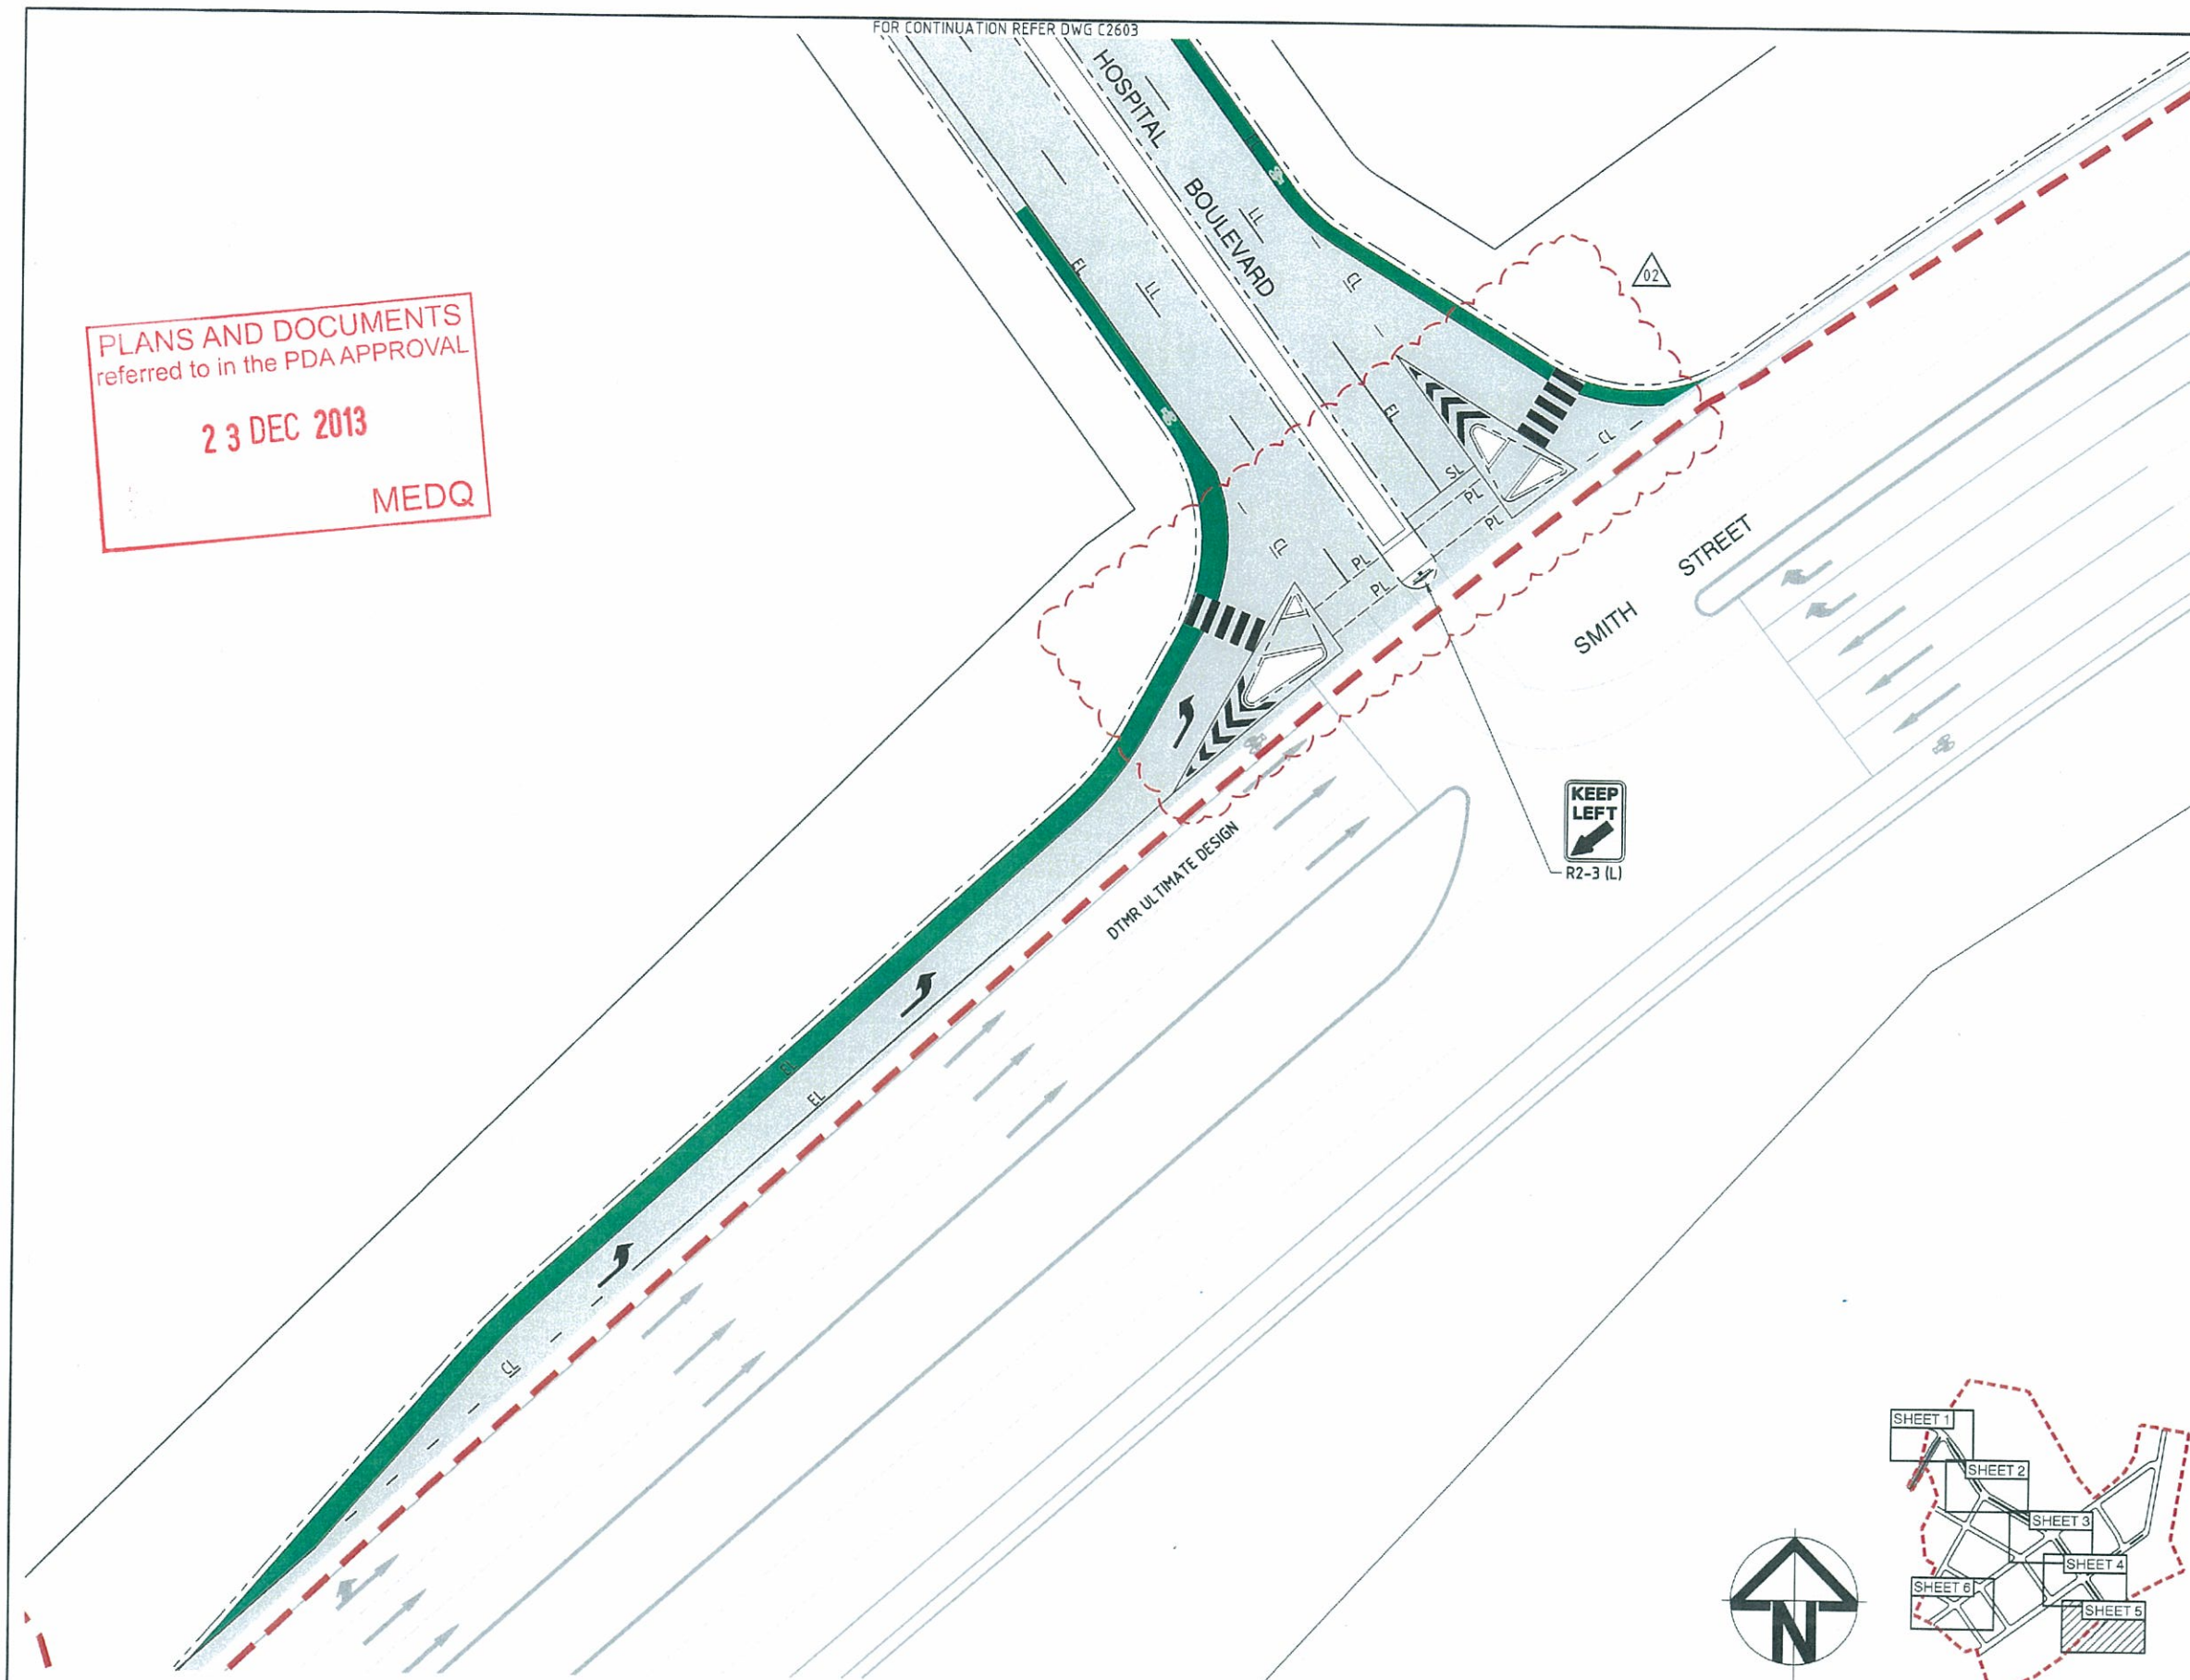

NOTES

1. ALL LINEMARKING TO BE REFLECTORISED WHITE.
2. FINAL SIGN LOCATIONS TO BE DETERMINED ON SITE BY THE SUPERINTENDENT.
3. EXISTING LINEMARKING SUPERSEDED BY NEW LINEMARKING IS TO BE REMOVED BY ROUTING OR OTHER METHOD APPROVED BY QUEENSLAND TRANSPORT.
4. COLOUR OF ALL REFLECTORISED PAVEMENT MARKERS TO BE WHITE EXCEPT AT EDGE LINES TO ONE WAY PAVEMENTS, WHICH SHALL BE AS FOLLOWS:
RIGHT EDGE - WHITE
LEFT EDGE - RED
5. ALL TRAFFIC SIGNS TO BE SIZE 'B' UNLESS NOTED OTHERWISE.
6. FOR GUIDE POST INSTALLATION AND DETAILS, REFER QUEENSLAND TRANSPORT STANDARD DRAWING No.1356
7. FOR TRAFFIC SIGN SUPPORT DETAILS, REFER QUEENSLAND TRANSPORT STANDARD DRAWING No.'s 1360 & 1362.
8. ALL ROUTE NAMES ON NEW GUIDE SIGNS TO BE BLACK LETTERING ON WHITE BACKGROUND U.N.O.
9. ALL SIGN MATERIAL TO BE CLASS 1.
10. DIRECTION SIGNS ARE SHOWN INDICATIVE ONLY. DETAILED DESIGNS ARE TO BE USED FOR ORDERING.
11. ALL SIGNAGE, LINEMARKING & RRPMS ARE TO BE PREPARED IN ACCORDANCE WITH THE CURRENT QUEENSLAND TRANSPORT 'MANUAL OF UNIFORM TRAFFIC CONTROL DEVICES' (M.U.T.C.D.).

LEGEND

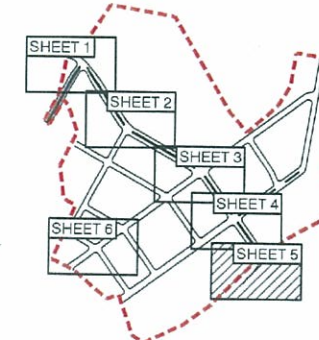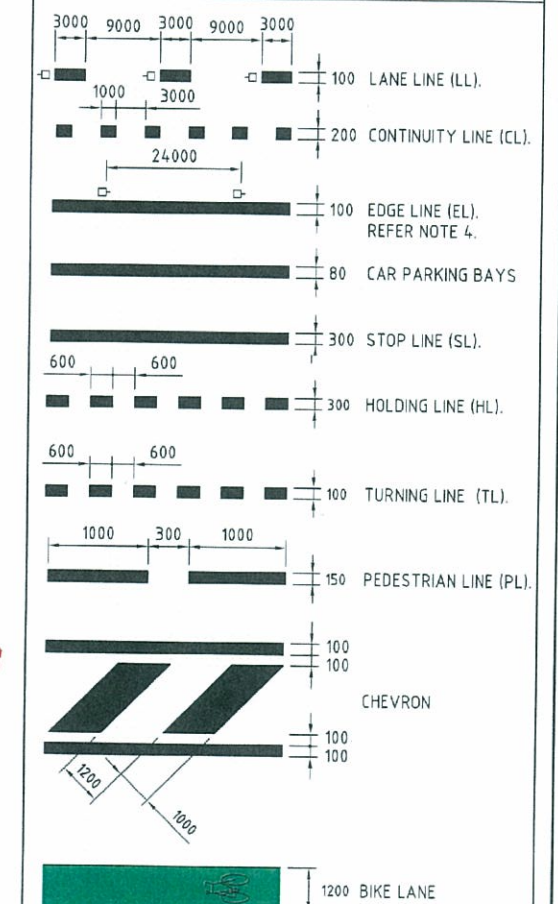

				Surveyor		Client		Status		Project			
				 BENNETT • BENNETT Property Consultants, Surveyors & Town Planners COOMERA OFFICE 6 JONES STREET COOMERA, QLD Ph: (07) 5573 8177 Fax: (07) 5529 4042		 Queensland Government DEPARTMENT OF STATE DEVELOPMENT, INFRASTRUCTURE & PLANNING		FOR APPROVAL NOT FOR CONSTRUCTION Approved:  R.E.P. No: 8677 Scales: 1:250 Original Size: A1 Height Datum: AHD Grid: MGA Current Issue Signatures Author: B DAVEY Designer: T DINGLE Reviewer: B THOMPSON Copyright reserved		GOLD COAST PARKLANDS REDEVELOPMENT TRUNK INFRASTRUCTURE SIGNAGE & LINEMARKING LAYOUT PLAN - SHEET 5 OF 6		 HYDER CONSULTING PTY. LTD ABN 76 104 485 289 P O Box 1653 Southport, QLD 4215 Australia Tel: +61 (07) 5532 3933 Fax: +61 (07) 5591 4778 www.hyderconsulting.com	
				Architect						Title			
				Scale 0 5 10 15 20 25m 1:250		ARCHIPELAGO							
				Filename: C2600-C2605-AA005621-SIGN & LINE.DWG									
02 GCCC R.F.I				BD		15/11/13							
01 ISSUE FOR OPW APPROVAL				BD		14/10/13							
Issue: Description				Author		Date							
 10mm on Original													

18/Nov/2013 1:06 PM

\\hc-aus-gc-fs-01\jobs\AA005621\E-CAD\Civil\DWG\Final\C2600-C2605-AA005621-SIGN & LINE.dwg

