
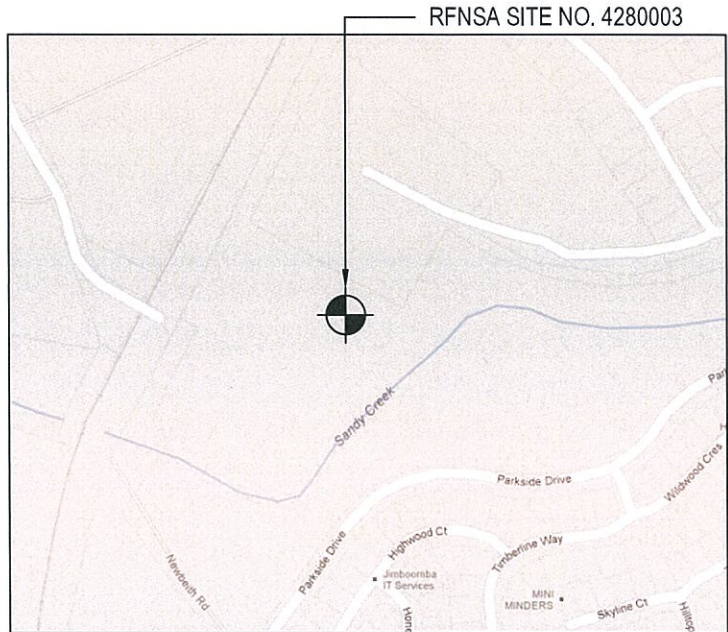


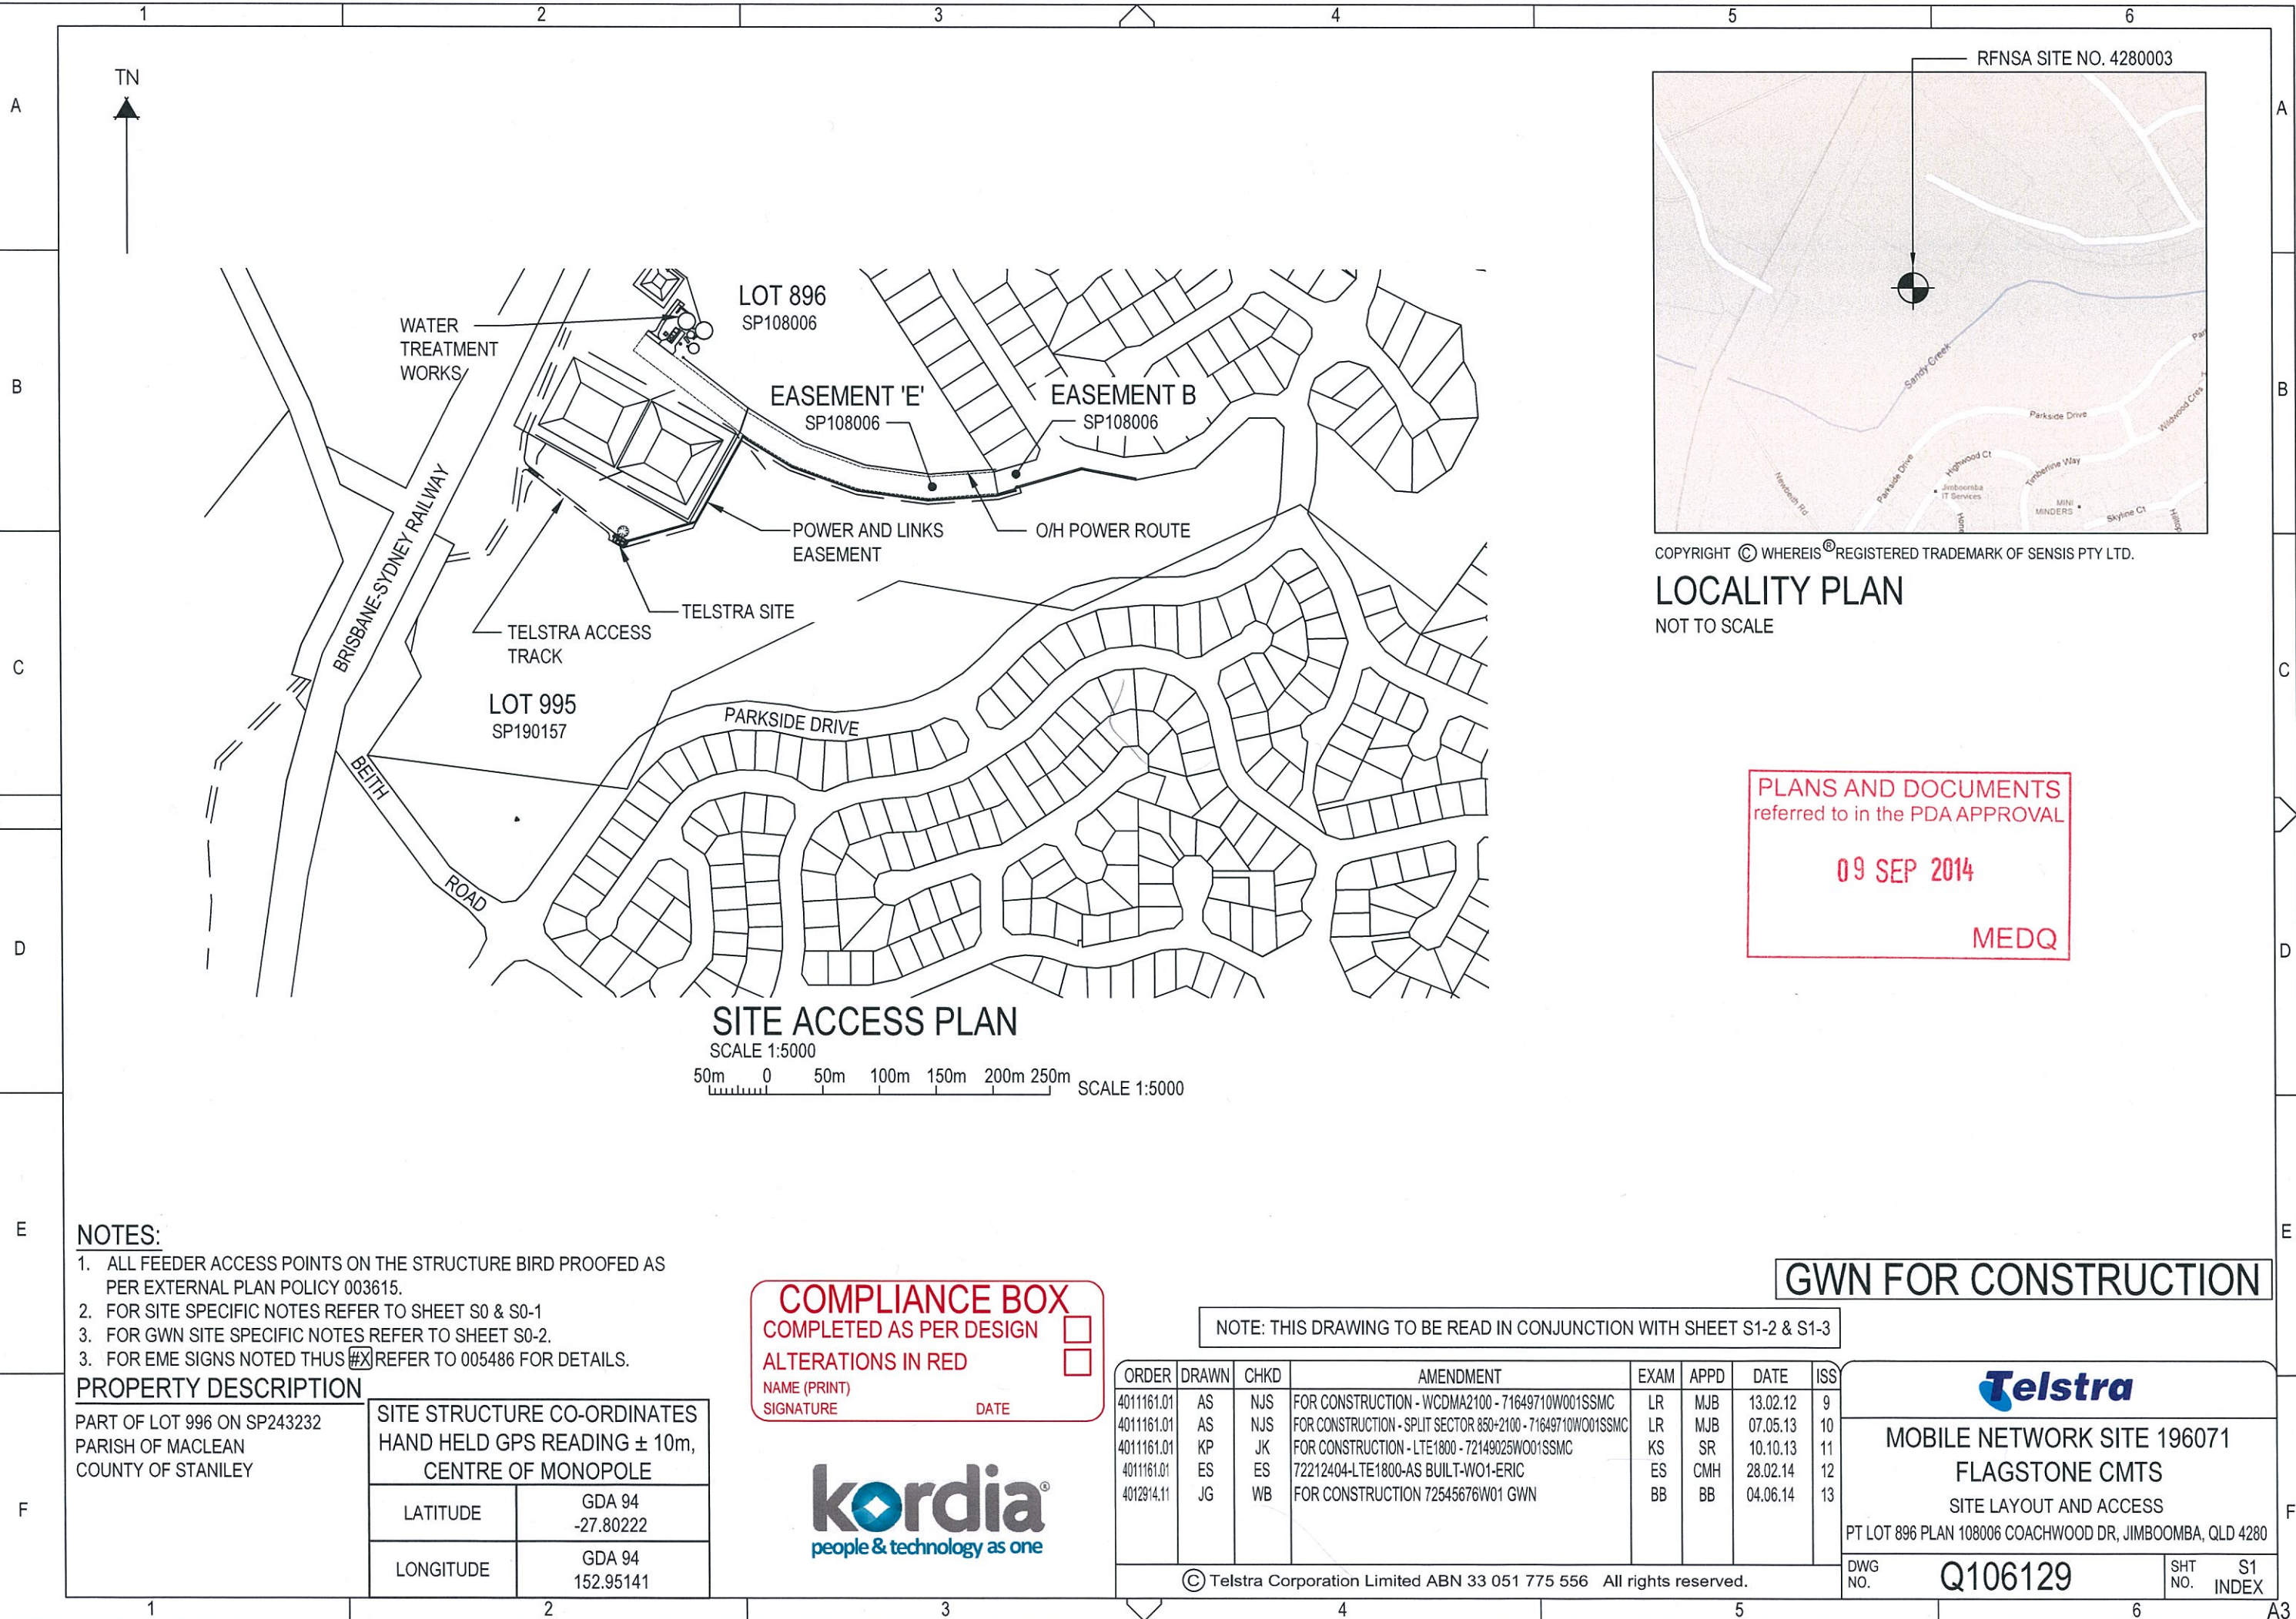

COPYRIGHT © WHEREIS® REGISTERED TRADEMARK OF SENSIS PTY LTD.

LOCALITY PLAN
NOT TO SCALE

PLANS AND DOCUMENTS
referred to in the PDA APPROVAL

09 SEP 2014

MEDQ

NOTES:

1. ALL FEEDER ACCESS POINTS ON THE STRUCTURE BIRD PROOFED AS PER EXTERNAL PLAN POLICY 003615.
2. FOR SITE SPECIFIC NOTES REFER TO SHEET S0 & S0-1
3. FOR GWN SITE SPECIFIC NOTES REFER TO SHEET S0-2.
3. FOR EME SIGNS NOTED THUS REFER TO 005486 FOR DETAILS.

PROPERTY DESCRIPTION

PART OF LOT 996 ON SP243232
PARISH OF MACLEAN
COUNTY OF STANLEY

SITE STRUCTURE CO-ORDINATES
HAND HELD GPS READING ± 10m,
CENTRE OF MONOPOLE

LATITUDE

GDA 94
-27.80222

LONGITUDE

GDA 94
152.95141

COMPLIANCE BOX

COMPLETED AS PER DESIGN ☐

ALTERATIONS IN RED ☐

NAME (PRINT)
SIGNATURE

DATE

kordia
people & technology as one

NOTE: THIS DRAWING TO BE READ IN CONJUNCTION WITH SHEET S1-2 & S1-3

ORDER	DRAWN	CHKD	AMENDMENT	EXAM	APPD	DATE	ISS
4011161.01	AS	NJS	FOR CONSTRUCTION - WCDMA2100 - 71649710W001SSMC	LR	MJB	13.02.12	9
4011161.01	AS	NJS	FOR CONSTRUCTION - SPLIT SECTOR 850+2100 - 71649710W001SSMC	LR	MJB	07.05.13	10
4011161.01	KP	JK	FOR CONSTRUCTION - LTE1800 - 72149025W001SSMC	KS	SR	10.10.13	11
4011161.01	ES	ES	72212404-LTE1800-AS BUILT-WO1-ERIC	ES	CMH	28.02.14	12
4012914.11	JG	WB	FOR CONSTRUCTION 72545676W01 GWN	BB	BB	04.06.14	13

© Telstra Corporation Limited ABN 33 051 775 556 All rights reserved.

GWN FOR CONSTRUCTION

Telstra

MOBILE NETWORK SITE 196071
FLAGSTONE CMTS

SITE LAYOUT AND ACCESS

 
PT LOT 896 PLAN 108006 COACHWOOD DR, JIMBOOMBA, QLD 4280


DWG
NO.

Q106129

SHT
NO.

S1
INDEX



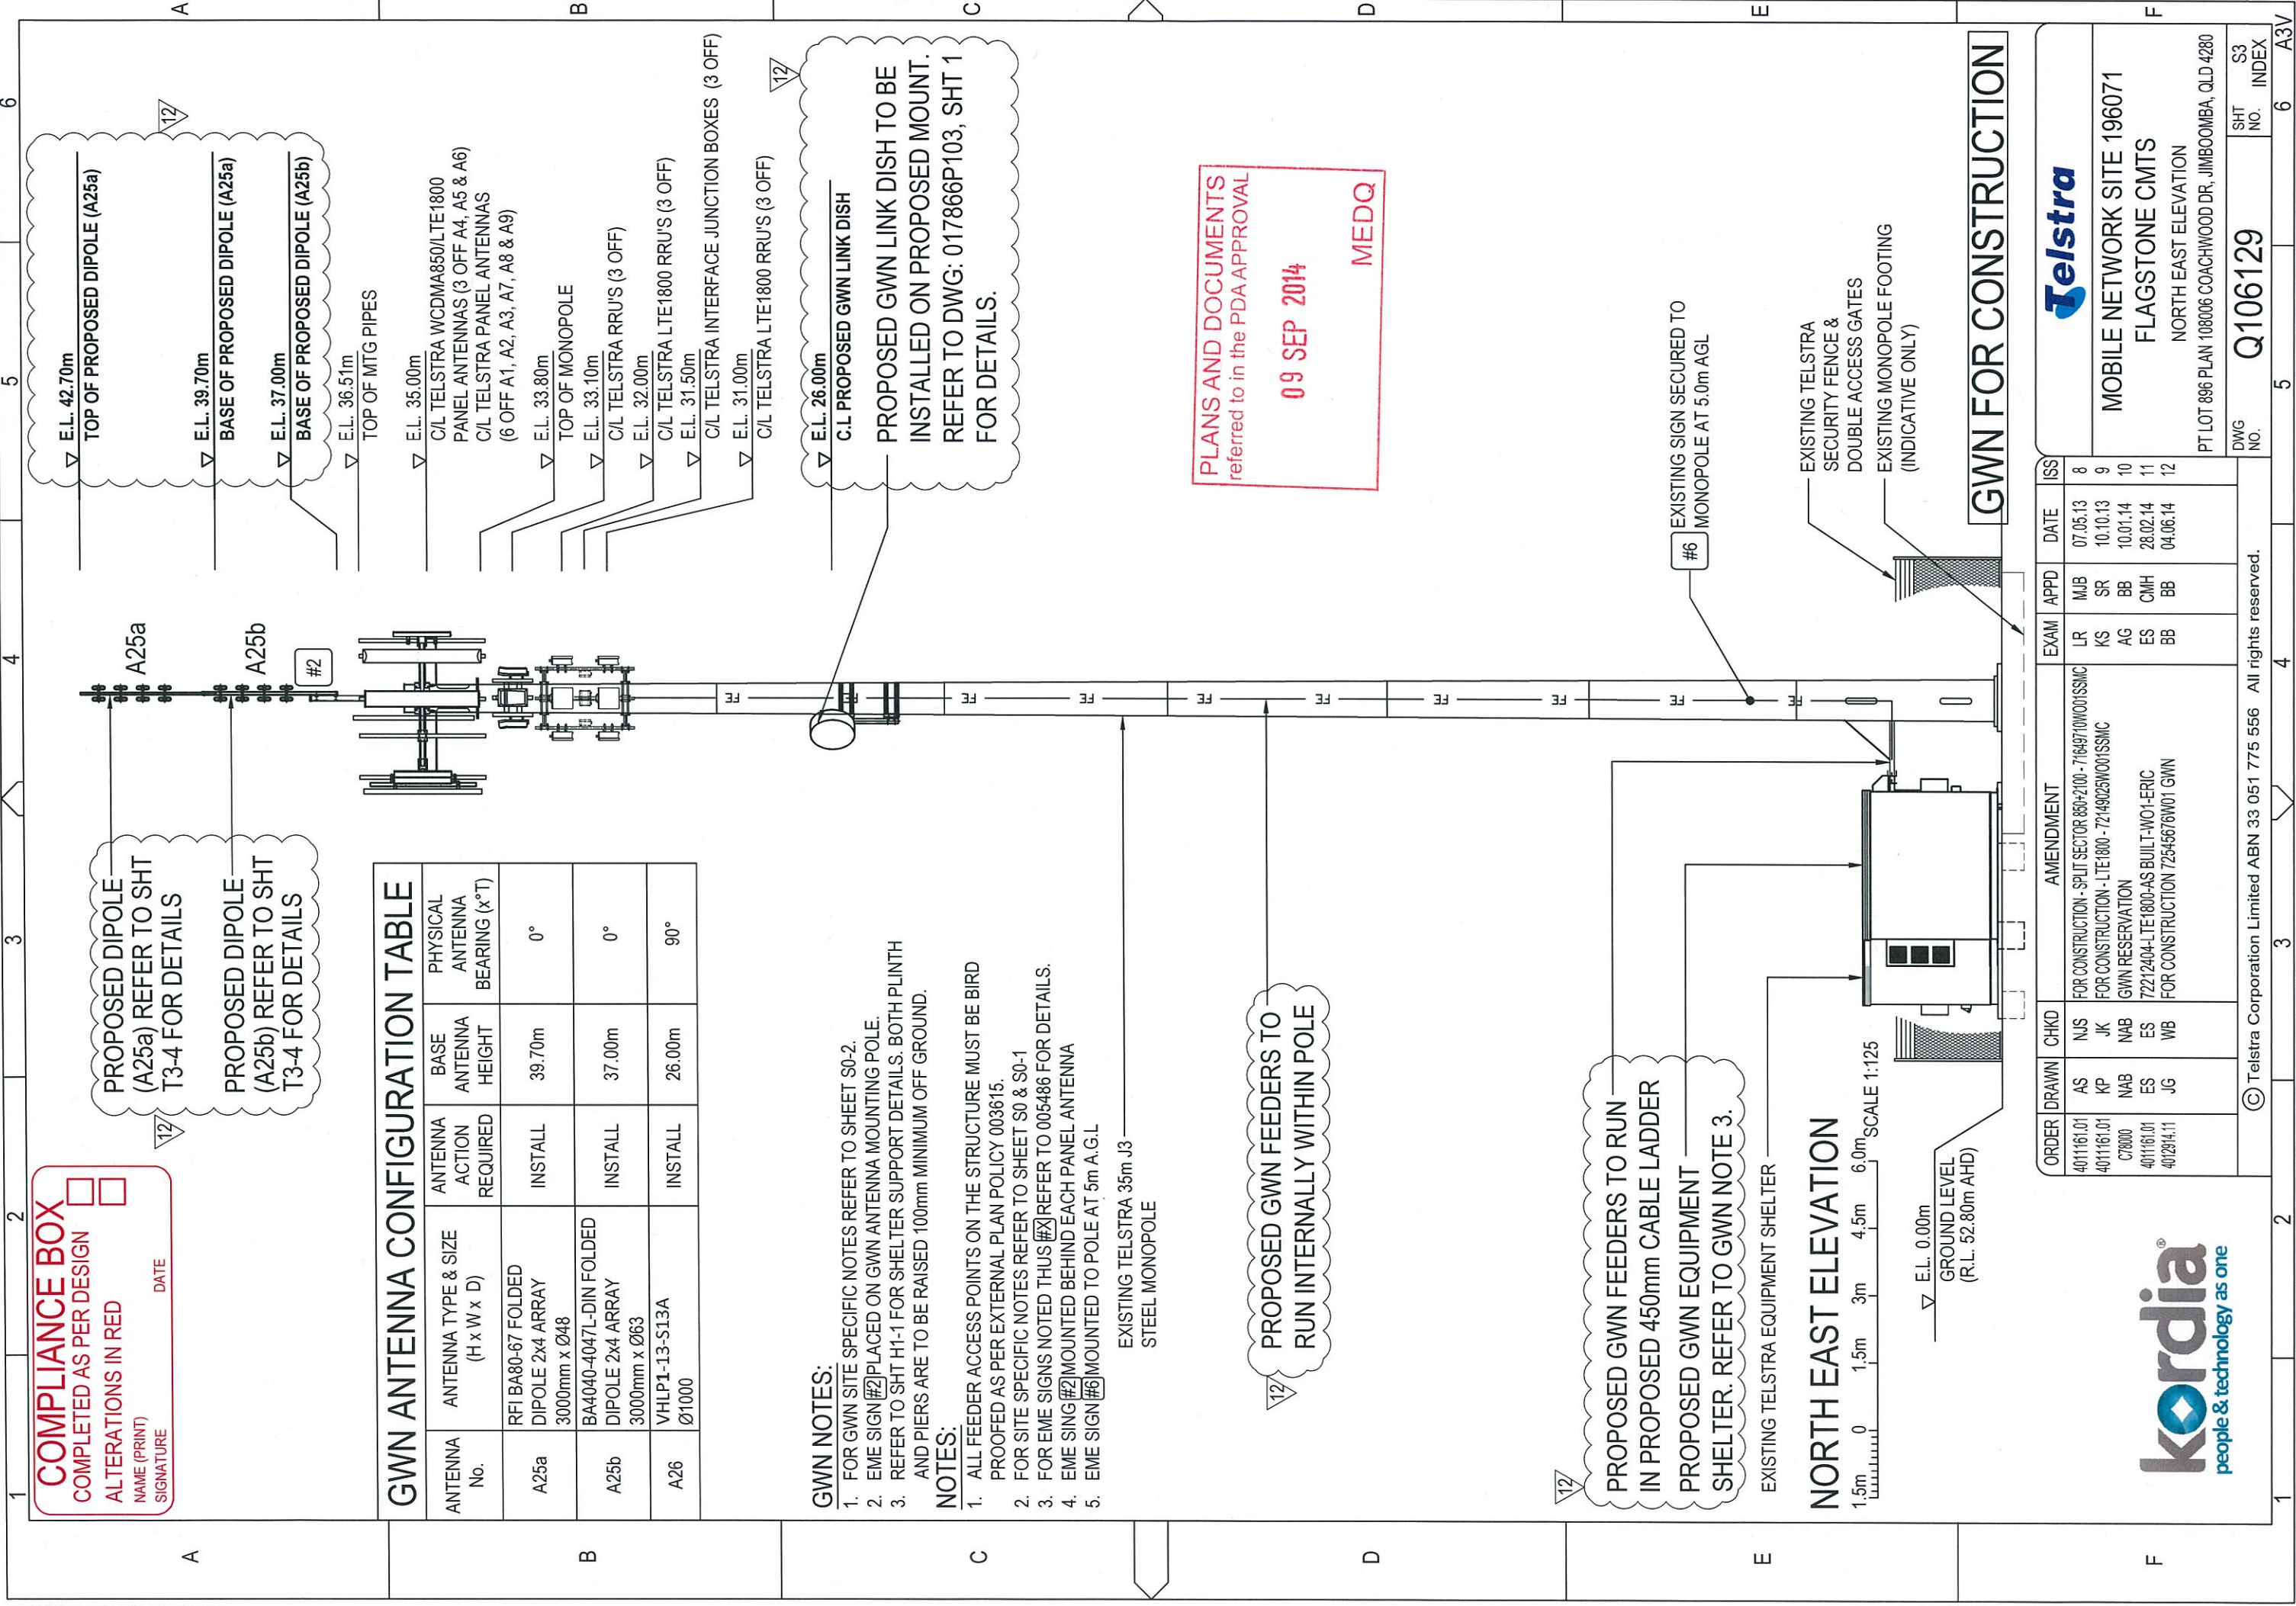

Telstra	
MOBILE NETWORK SITE 196071	
FLAGSTONE CMTS	
NORTH EAST ELEVATION	
PT LOT 896 PLAN 108006 COACHWOOD DR, JIMBOOMBA, QLD 4280	
DWG NO.	SHT NO.
Q106129	6
INDEX	
A3V	

ORDER	DRAWN	CHKD	AMENDMENT	ISS
4011161.01	AS	NJS	FOR CONSTRUCTION - SPLIT SECTOR 880+2100 - 71649710W01SSMC	8
4011161.01	KP	JK	FOR CONSTRUCTION - LTE1800 - 72149025W01SSMC	9
C70000	NAB	NAB	GWN RESERVATION	10
4011161.01	ES	ES	72212404-LTE1800-AS BUILT-WO1-ERIC	11
4012914.11	JG	WB	FOR CONSTRUCTION 72545676W01 GWN	12

EXAM	APPD	DATE
LR	MJB	07.05.13
KS	SR	10.10.13
AG	BB	10.01.14
ES	CMH	28.02.14
BB	BB	04.06.14

© Telstra Corporation Limited ABN 33 051 775 556 All rights reserved.



SLOTTED HOLE PROVIDED
IN SHELTER BASE FRAME
HOLD-DOWN BRACKET

M16 S/S THREADED ROD
125 EMBEDMENT WITH
HILTI HVU FOIL CAPSULE.
PROVIDE 45° SPLAY AT END
OF ROD TO ALLOW FOR
CAPSULE MIXING (TYP)

300 x 300 x 25 EPOXY MORTAR
LEVELLING BED (TYP)

8-N16 MAIN RE-BAR WITH
R10-200 TIES

PIER & HOLD-DOWN DETAIL

100 0 100 200 300 400 500 SCALE 1:10

NOTES:

- PIERS SHALL BE PROVIDED WITH A CLEAN BEARING ON ROCK OR APPROVED MATERIAL.
- TOP OF PIERS SHALL BE 100mm MINIMUM ABOVE FINISHED GROUND LEVEL.
- CONCRETE STRENGTH FOR PIERS & PLINTH, $f_c = 32 \text{ MPa}$.
- COVER TO REINFORCEMENT = 50mm.
- HOLD-DOWN ANCHORS SHALL BE TESTED FOR A TENSILE (PULL-OUT) LOAD OF 8kN PRIOR TO CONSTRUCTION OF THE PLINTH.
- FOR GENERAL NOTES REFER DRG. 017866P05.

COMPLIANCE BOX
COMPLETED AS PER DESIGN ☐
ALTERATIONS IN RED ☐
NAME (PRINT) _____
SIGNATURE _____ DATE _____

kordia
people & technology as one

PLANS AND DOCUMENTS
referred to in the PDA APPROVAL

09 SEP 2014

MEDQ

REFER TO PIER DETAIL

REFER TO PLINTH DETAIL BELOW

FOOTING PLAN

500 0 500 1000 1500 2000 2500 SCALE 1:50

SLOTTED HOLE PROVIDED IN
SHELTER HOLD-DOWN PLATE

M16 S/S THREADED ROD ANCHORED
125 INTO MONOPOLE FOOTING
USING HILTI HVU FOIL CAPSULE
PROVIDE 45° SPLAY AT END TO
ALLOW FOR CAPSULE MIXING

300 x 300 x 20 MIN THICK EPOXY
MORTAR LEVELLING BED

PLINTH TO EXTEND DOWN TO
EXISTING MONOPOLE FOOTING

SEALANT AROUND ROD
(TYP)

SHELTER WALL

SHELTER BASE FRAME

50 x 50 x 4mm WELDMESH
50mm TOP COVER

450 x 450mm PRECAST CONCRETE PLINTH
WITH 25mm CHAMFER ALL ROUND

GROUND LEVEL

EXISTING BACKFILL

EXISTING MONOPOLE FOOTING

SCABBLE PRIOR TO
ANCHOR AND PLINTH
INSTALLATION

PLINTH & HOLD-DOWN DETAIL

SCALE 1:10

GWN FOR CONSTRUCTION

ORDER	DRAWN	CHKD	AMENDMENT	EXAM	APPD	DATE	ISS
40129/14.11	JG	WB	FOR CONSTRUCTION 72545676W01 GWN	BB	BB	04.06.14	1

© Telstra Corporation Limited ABN 33 051 775 556 All rights reserved.

Telstra

MOBILE NETWORK SITE 196071
FLAGSTONE CMTS

GWN SHELTER FOOTING DETAILS
PT LOT 896 PLAN 108006 COACHWOOD DR, JIMBOOMBA, QLD 4280

DWG
NO.

Q106129

SHT
NO. H1-1
INDEX



MOBILE NETWORK SITE 196071
FLAGSTONE CMTS
GWN ANTENNA MOUNTING DETAILS
LOT 896 PLAN 108006 COACHWOOD DR, JIMBOOMBA, QLD 4280

ORDER	DRAWN	CHKD	AMENDMENT	EXAM	APPD	DATE	ISS
40/23/4.11	JG	WB	FOR CONSTRUCTION 72545676W01 GWN	BB	BB	04.06.14	1

© Telstra Corporation Limited ABN 33 051 775 556 All rights reserved.

Q106129

T3-4
INDEX

1	
---	--

The copyright and ownership of the drawings is to be assigned to Telstra

CAD FILE: 06129SDC.DWG