

AMENDED IN RED

By: Karina McGill

Date: 11/07/2016



RUFUS STREET

Proposed Lot 2 boundary

Not part of this approval


Not part of this approval

~~Proposed Road Closure~~
9m²

MACKENZIE STREET

Not part of this approval

Line of Building Awning over Footpath

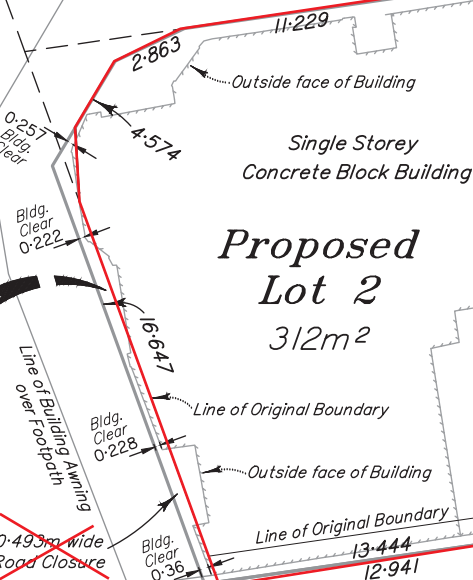

Proposed Lot 2
312m²

Strip Shops Complex
4
RP610540

Single Storey
Concrete Block Building
5
RP610540

Proposed Lot 1
608m²

Vacant Site
Used for Carparking
and Loading

Vacant Site
Used for Carparking
and Loading

**PLANS AND DOCUMENTS
referred to in the PDA
DEVELOPMENT APPROVAL**

Approval no: DEV2016/775

Date: 28 JUL 2016



Prepared By :

JDA Consultants Pty Ltd.

CONSULTING SURVEYORS
TOWN PLANNERS

ACN 010 272 090
50 Prospect Street
Fortitude Valley, 4006
ph : (07) 3252 3777
fax : (07) 3252 1293
Email : jdas@jdaconsultants.net.au

Client:

BUSHFLOWER PTY LTD

Project:
Proposed Realignment of boundaries +
~~Road closure~~ for the property at
1 - 5 Rufus Street, Blackwater.

Level Datum:

Description of Property:
Lots 2 & 3 on RP610540

Locality: Blackwater
Local Government: Central Highlands
Regional Council

Scale:
1 : 200

Date:
10/05/2016

Drawn:
dt

Surveyed:
jdl

Job No.
053 / 12

Drawing No.
05312_subapp_a.dwg

North:



Note:

Face of Building Line

Line of Building Awning

Proposed New Boundary Line

Distances and Areas are
approximate only and are
subject to resurvey.

Comp No.

1Z

