


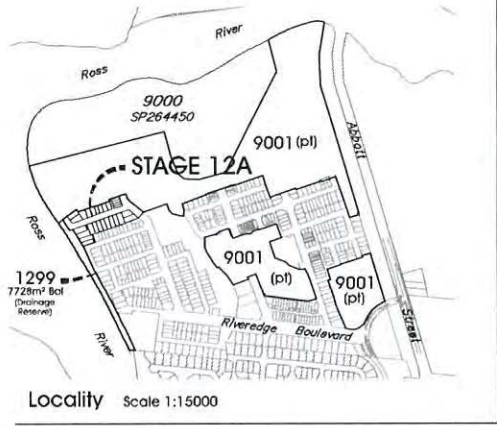

PROPOSED RECONFIGURATION

Lots 1200 - 1224, 1299 & 9001
~~Cancelling Lot 9001 on SP280605;~~
~~Lot 656 and Lot 657 on SP270745~~

Parish of Stuart
 County of Elphinstone
 City of Townsville

AMENDED IN RED

By: Jennifer Davison

Date: 4 AUG 2016



PLANS AND DOCUMENTS
 referred to in the PDA
DEVELOPMENT APPROVAL


Approval no: DEV2016/751

Date: 7 SEP 2016



- STAGE 12A -

Total Stage Area	2.38 ha
Total Residential Lots.....	27
Average Lot Area.....	398m ²
Total Length of New Road	330m
6.5m wide road	40m
17m wide road	210m
20.3m wide road	80m
Total Area of New Road	5364m ²
6.5m road area	195m ²
17m road area	3391m
20.3m road area	1778m

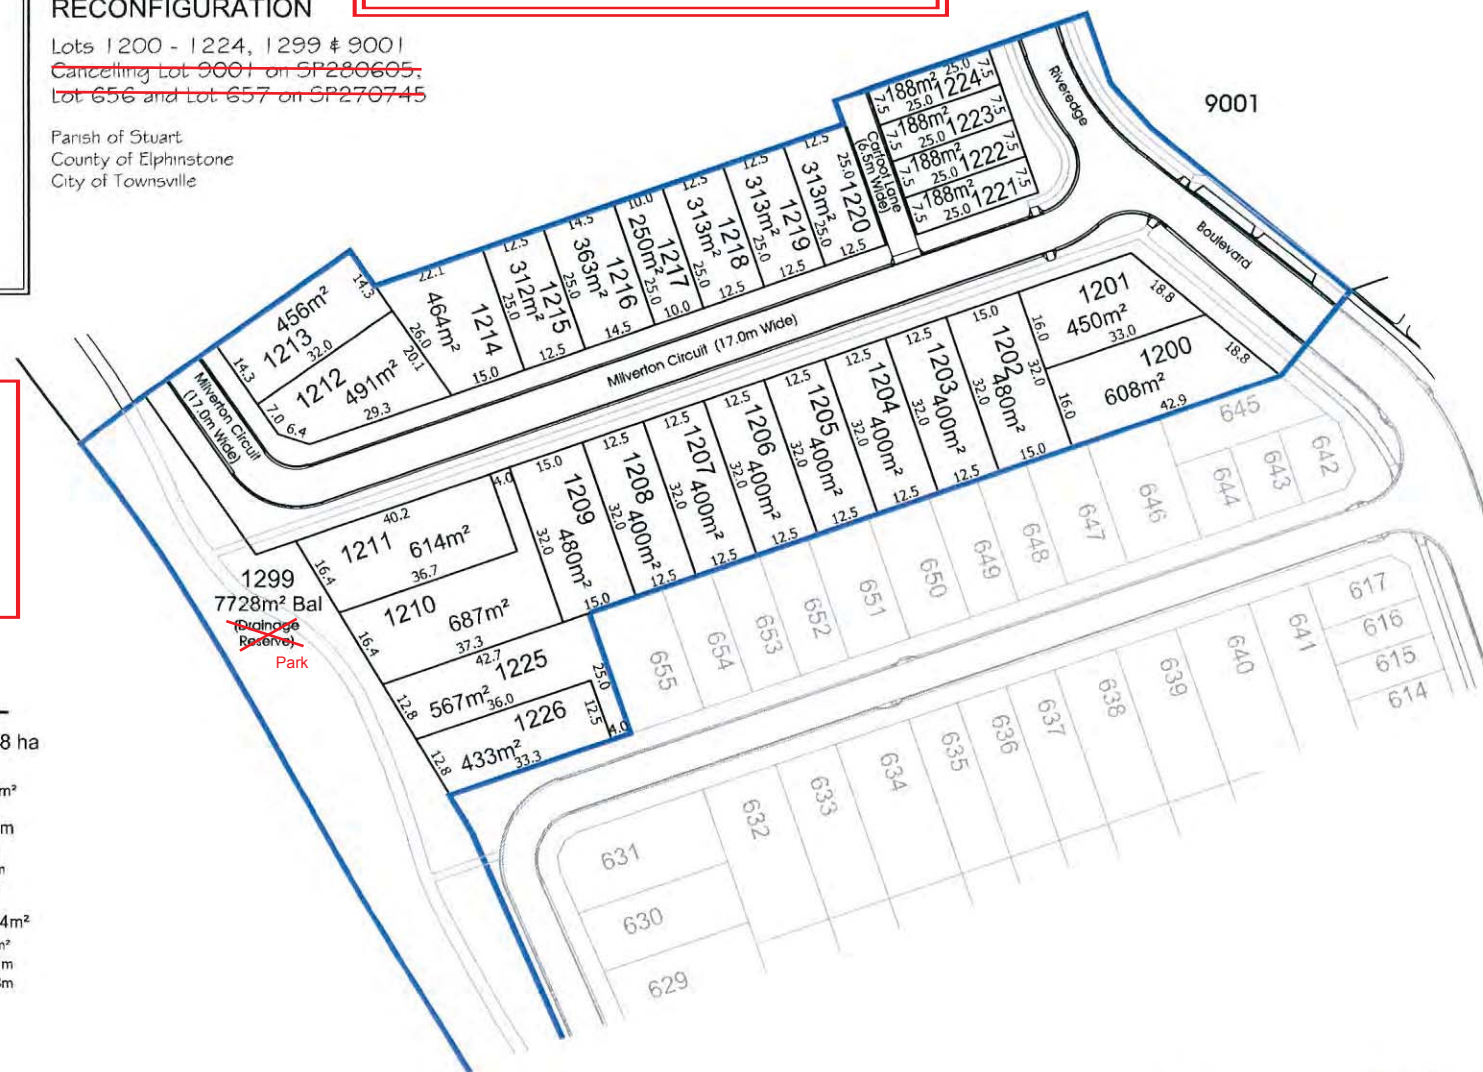

This plan is conceptual and for discussion purposes only. All areas, dimensions and land uses are preliminary, subject to investigation, survey, engineering, and Local Authority and Agency approvals.



Date: 4th December,

Scale: 1:1000 @ A3

Drawn: AJL

Job No: 29060/252-1



Plan No: 29060/42

P 1300 267 878

W www.braziermott.com.au

surveying | town planning | project management | mapping & design

By: Jennifer Davison
Date: 4 AUG 2016

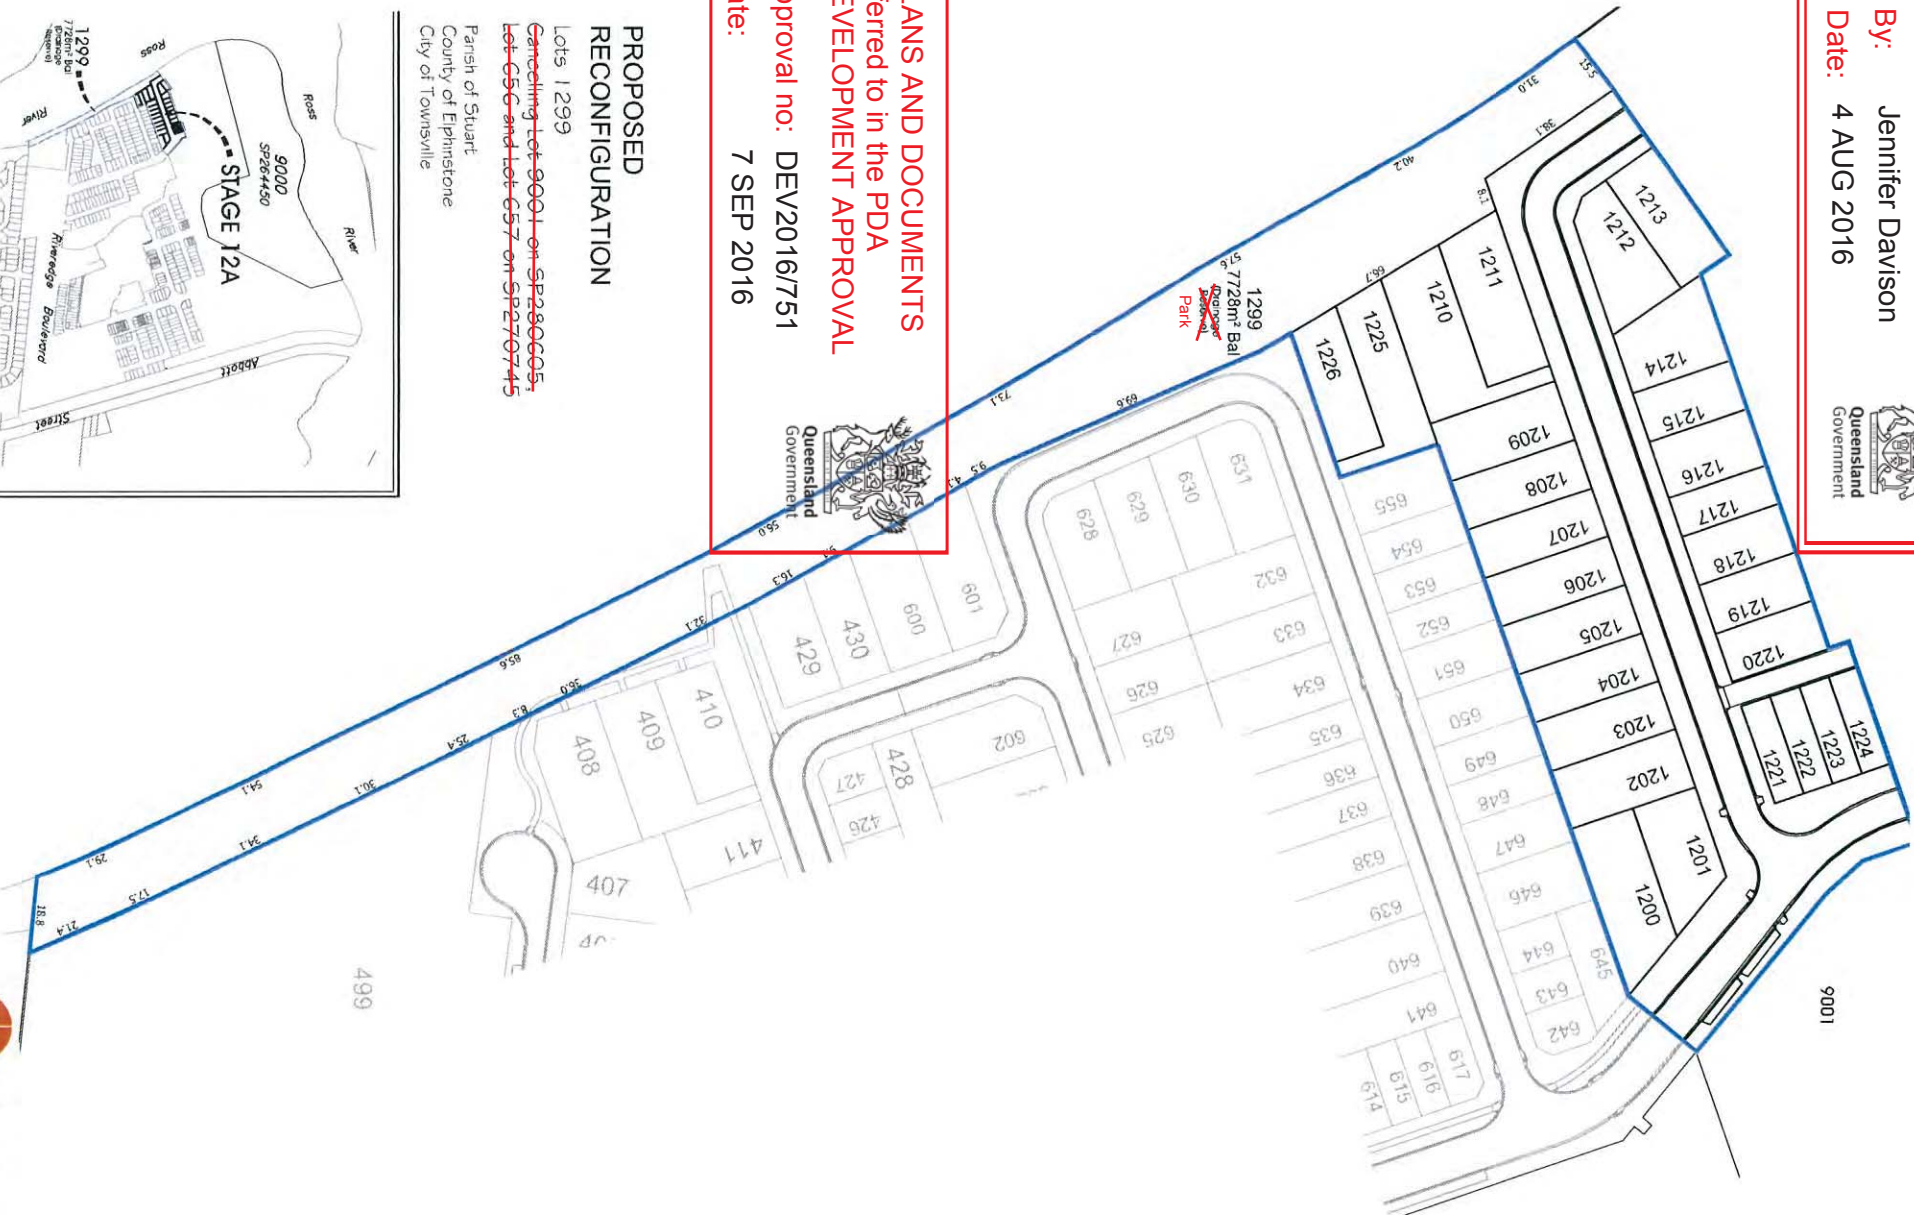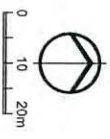

PLANS AND DOCUMENTS referred to in the PDA DEVELOPMENT APPROVAL

Approval no: DEV2016/751


Date: 7 SEP 2016

PROPOSED RECONFIGURATION

Lots 1299

~~Cancelling lot 9001 on SP280605;
lot 656 and lot 657 on SP270745~~

Parish of Stuart
County of Elphinstone
City of Townsville

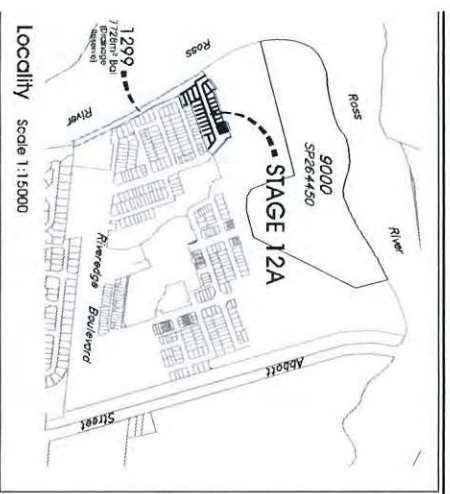

This plan is conceptual and for discussion purposes only. All areas, corridors and land uses are preliminary, subject to investigation, surveys, engineering, and local Authority and Agency approvals.



brazier mom

1300 267 878

1200 20 / 0 / 0
www.braziermolti.com.au
Phon No: 29060/446 B

surveying | town planning | project management | mapping and GIS