

Vegetation Clearing & Fauna Management Plan

~~Economic Development
Queensland (EDQ)~~

Mountain Ridge Road upgrade,
South Maclean

by Orchard (Pebble Creek) Developments
Pty Ltd ATF The Flagstone Trust

CONTENTS

9282 E 02 E VCFMP A -- Vegetation Clearing Notes
9282 E 03 E VCFMP A -- Fauna Notes
9282 E 04 - 07 E VCFMP A -- Detail Sheet
9282 E 08 E VCFMP A -- Clearing Direction
Appendix A -- Tree Schedule

AMENDED IN RED

By: Owen Haslam
Date: 24/01/19




Key Site Contacts

Saunders Havill Group

Mr James Gautrey

Phone: (07) 3251 9485

Email: jamesgautrey@saundershavill.com

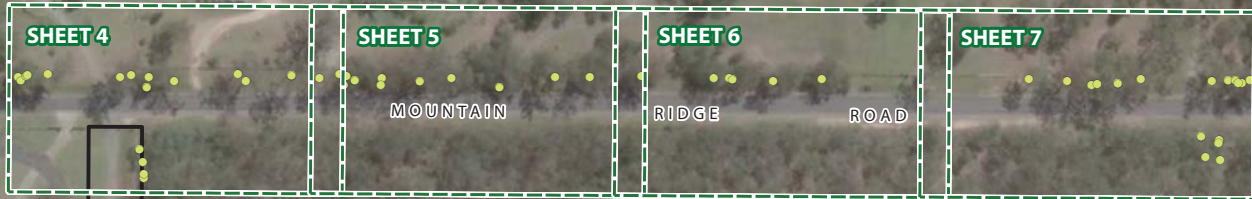

PLANS AND DOCUMENTS
referred to in the POA
DEVELOPMENT APPROVAL

Approval no: DEV2018/994

Date: 30/01/19



Vegetation Clearing and Fauna Management Plan

Vegetation Clearing - Notes

INTRODUCTION

The Environmental Management Division of the **Saunders Havill Group** was engaged by **Orchard (Pebble Creek) Developments Pty Ltd ATF The Flagstone Trust** to prepare a Vegetation Clearing and Fauna Management Plan (VCFMP) for the Mountain Ridge Road upgrade—part of the future residential development at 230 Mountain Ridge Road and 54 Rose Almond Street, South Maclean (L6/RP193185 and L9/SP203507).

The purpose of this plan is to manage the vegetation removal process and the protection of fauna species over the proposed road upgrade. The clearing works will follow the general principal for vegetation clearing documented on this sheet and Sheet 3.

This VCFMP has been prepared by overlaying Saunders Havill Group GPS accurate tree plot data and the proposed layout design—to determine impacts and disturbances to existing vegetation. The tree survey was carried out in 2017-2018 as part of the development application.

PHASE 1 - Tree Protection Fencing to be installed prior to the commencement of any clearing works on the site. Tree protection fencing is to be located at or beyond 12 x diameter at breast height (DBH) unless approved by the appointed Arborist.

PHASE 2 - Council Pre-start Meeting
Fencing shall be in place at the time of the official pre-start meeting for inspection and sign off by Council Officers.

PHASE 3 - Fauna Inspections and Management
Undertake necessary fauna management requirements prior to clearing works - as a minimum this should include the specifications listed on sheet 3 and acknowledge specific **EDQ** approval requirements.

PHASE 4 - Undertake Bulk Clearing
Undertake wholesale removal of vegetation once approved for removal by qualified fauna spotter. Clearing will occur in the direction outlined in sheet 5 of this VCFMP and managed by the appointed fauna spotter to allow all fauna unimpeded movement towards bushland occurring south of Mountain Ridge Road.


ACCESS AND STOCKPILING

A stockpiling location is to be designated in an easily accessible area outside of TPZs. An indicative stockpiling location has been allocated in the Mountain Ridge Rd road reserve, allowing for material to be easily delivered and stored. This location is subject to minor change according to cut / fill activities.

Where possible, cleared native vegetation that is free of weeds will be chipped and stored for re-use at the road reserve or development site (e.g. rehabilitation / embankment stabilisation).

MAINTENANCE

After tree clearing works on site, follow up maintenance works should be carried out on all retained vegetation. An analysis of the vegetation's health and growth should be undertaken to determine specific maintenance needs.

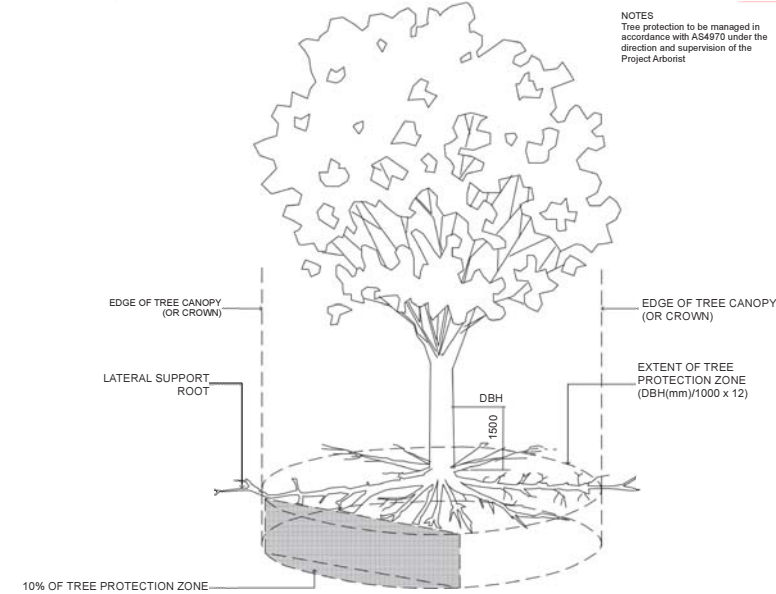


PLANS AND DOCUMENTS referred to in the PDA DEVELOPMENT APPROVAL

Approval no: DEV2018/994
Date: 30/01/19



AS 4970 Tree Protection Fencing Detail

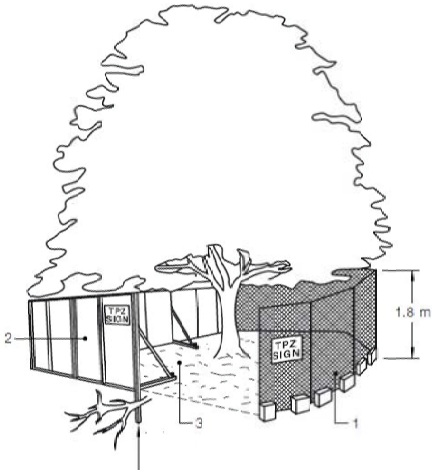

- LEGEND
1. Chain wire mesh panels with shade cloth (if required) attached, held in place with concrete feet.
 2. Alternative plywood or wooden paling fence. This fencing option also prevents building materials or soil entering the TPZ.
 3. Mulch installation across surface of TPZ (at the discretion of the Project Arborist). No Excavation, construction activity, grade changes, surface treatment or storage of materials of any kind is permitted with the TPZ.
 4. Bracing is permissible within the TPZ. Installation of supports should avoid damaging roots.



CLIENT:
Orchard (Pebble Creek)
Developments Pty Ltd
ATF The Flagstone Trust

DISCLAIMER:
THESE PLANS HAVE BEEN PREPARED FOR THE EXCLUSIVE USE OF THE CLIENT. SAUNDERS HAVILL GROUP CANNOT ACCEPT RESPONSIBILITY FOR ANY USE OF OR RELIANCE UPON THE CONTENTS OF THESE DRAWINGS BY ANY OTHER PARTY.
CONFIRM ALL DIMENSIONS ON SITE PRIOR TO CONSTRUCTION AND DO NOT SCALE FROM THE DRAWINGS. ALL DIMENSIONS ARE WELL AND TRUE. ANY DISCREPANCIES SHOULD BE CLARIFIED IN WRITING WITH SAUNDERS HAVILL GROUP PRIOR TO THE COMMENCEMENT OF WORK.
PRIOR TO ANY DEMOLITION, EXCAVATION OR CONSTRUCTION ON SITE, THE RELEVANT AUTHORITY SHOULD BE CONTACTED FOR FURTHER GUIDANCE SERVICES AND DETAIL LOCATIONS OF ALL SERVICES.

REFERENCES:
Tree Protection Zones & Fencing (AS 4970 - 2009)
Decision notice and Conditions of Approval - Ref DEV2017/887 (Qld Govt 2018)

AMENDMENTS:			
Issue	Date	Description	Checked
A	30/11/2018	Client Draft	JG

PROJECT:
Mountain Ridge
Road upgrade,
South Maclean

environmental management			
PLAN OF: Vegetation Clearing & Fauna Management Plan			
DATE:	30/11/2018	CHECKED:	JG
CLIENT REF:	9282	DRAWN:	MC
DRAWING No.:	9282 E 02 VCFMP EXT EDO A		

Vegetation Clearing and Fauna Management Plan

Fauna Management - Notes

INTRODUCTION

The Fauna Management specification on this VCFMP is designed to protect native animals and control/manage impacts during the vegetation clearing works. The clearing area occurs within the Mountain Ridge Rd road reserve that abuts a mixture of rural residential properties and bushland. Common species associated with semi-urban landscapes were spotted at the clearing area during the ecological survey. The fauna management specifications and principles incorporated in this VCFMP applies generically to all native animals and focus on avoiding conflicts and incorporating measures to minimize disturbance. Compliance with this section of the VCFMP is compulsory and incorporates the use of expert consultants including a Fauna Spotter (holding a valid Wildlife Rehabilitation Permit issued by the **Department of Environment and Science**).

FAUNA IMPACTS

Clearing of vegetation provides an obvious source of impact to existing habitat and animal safety. More specifically the existing vegetation provides habitat, movement and protection opportunities for some fauna through both regrowth and canopy trees. These opportunities are to be altered during and post vegetation clearing works.

CONSTRUCTION IMPACTS

- Direct removal of site vegetation
- Loss of habitat
- Noise, vibration and dust
- Erosion and sedimentation
- Threats associated with open cuts etc. and fauna entrapment
- Loss of food sources
- Excavation/compaction/changes in ground levels
- Altering hydrological flows
- Fragmentation of habitat

OPERATIONAL IMPACTS

- Weed introduction (garden escapees)
- Increased hydrology with increased hardstand
- Altering of run-off chemical and nutrient components (quality)
- Barriers to fauna movement
- Vehicles and pedestrian movement and trespass
- Introduction of domestic and predatory species

PLANS AND DOCUMENTS
referred to in the PDA
DEVELOPMENT APPROVAL



Approval no: DEV2018/994

Date: 30/01/19

Fauna Management Schedule

1.0 PRE CLEARING					
Ref:	Management Item	Responsibility	Timing	Reporting	
1.1	TEMPORARY FENCING Prior to the commencement of works and to be inspected the site Environmental Coordinator AS 9470 Temporary Protection Fencing shall be installed around the 'Tree Protection Zone' designated for retention around the basin works area (as per <i>detail sheets</i>). ▪ Fencing shall be fauna friendly ▪ No clearing, stockpiling, site access, earthworks, storage, etc. is to occur within the temporary protection fencing. ▪ Only approved weed management works to occur within the temporary protection fencing ▪ Fencing to be reinstated immediately if damaged or knocked down, any damage to retained trees to be immediately reported to Project Arborist. ▪ Fencing to remain until the completion of all site bulk earthworks.	SITE SUPERVISOR	Prior to the commencement of construction	Inspected by EDQ or the Environmental Site Coordinator	
1.2	CONTRACTOR EDUCATION & AWARENESS All site contractors and subcontractors will be made aware of their responsibilities to protect native fauna. The Fauna Management notes on this VCFMP is provided as a working document to assist on-site management and protection of native animals. This generally will form part of education and training on a broader work place health and safety but as a minimum will include: ▪ Copy of VCFMP kept on-site (Site Office). ▪ General education and awareness notification of contractors and sub-contractors involved in activities potentially impacting native animals as part of site induction – contractors must know the location of the VCFMP, key phone numbers and who to report to if they breach the VCFMP. A list of relevant contact phone numbers as listed on these drawings is kept in a visible and accessible location in the site office.	SITE SUPERVISOR / THE PROPONENT	Prior to the commencement of construction and as part of the site induction for new staff and sub-contractors	SITE SUPERVISOR	
2.0 VEGETATION CLEARING					
2.1	SPOTTER / RELOCATOR Immediately prior to the commencement of clearing of native vegetation a daily visual inspection of the area must be carried out by the fauna spotter-catcher. Furthermore, the fauna spotter-catcher is to be present on site during all clearing operations to supervise and direct clearing works, and to respond to any situations that may arise in relation to fauna. In the event of an animal being located, an area of 5m radius should be established around the tree excluding machinery from the area until the animal has relocated (usually overnight). If an animal requires relocating this must be undertaken by a suitable qualified fauna expert recognized by the Department of Environment & Science . For some fauna a permit will be required. If vegetation is left stockpiled overnight, the Fauna Spotter-Catcher must inspect the vegetation prior to chipping or removal from site. Any native fauna orphaned or injured by the development process must be reported to the Department of Environment & Science (1300 130 372) or RSPCA (1300 264 625). The Site Supervisor is responsible for the safe management of site fauna and implementation of these specific fauna requirements.	SITE SUPERVISOR	Prior to the commencement of construction	Inspected by EDQ or the Environmental Site Coordinator	
2.2	SPECIFIC KOALA MANAGEMENT NOTES A Koala Spotter is a person who holds a tertiary qualification in Biology or Zoology, or who is demonstrably experienced in the identification and location of Koalas in their natural habitat. For example, a koala keeper employed by a licensed Wildlife exhibitor (i.e. a zoo) may be capable of demonstrating competence in locating Koala's. Prior to the commencement and during felling operations, it is the responsibility of the Koala spotter to be present at the site of felling operations identify any tree at the site within which a Koala is present, as well as any tree that has a crown which is intermeshed or overlapping with such a tree; and advise the person who is authorised to conduct the felling operation, or that persons' representative, of the precise location of each such tree Management Item.	SITE SUPERVISOR	Prior to the commencement of construction	Inspected by EDQ or the Environmental Site Coordinator	
2.3	CLEARING PATTERN / FAUNA FLUSHING Clearing occurs once fauna spotter-catcher gives sign off the site is clear of significant native species. The intended clearing direction is southeast towards bushland on southern side of Mountain Ridge Road. Clearing direction is subject to amendment by the fauna spotter/catcher. At the completion of operational works, and prior to the sealing of survey plans for the relevant stage, the Fauna Spotter-Catcher must provide certification to EDQ officers that all works were undertaken in accordance with these fauna management requirements and specific EDQ requirements.	SITE SUPERVISOR	Prior to the commencement of construction	Inspected by EDQ or the Environmental Site Coordinator	



CLIENT:

Orchard (Pebble Creek)
Developments Pty Ltd
ATF The Flagstone Trust

DISCLAIMER:

THESE PLANS HAVE BEEN PREPARED FOR THE EXCLUSIVE USE OF THE CLIENT. SAUNDERS HAVILL GROUP CANNOT ACCEPT RESPONSIBILITY FOR ANY USE OF OR RELIANCE UPON THE CONTENTS OF THESE DRAWINGS BY ANY THIRD PARTY.
CONFIRM ALL DIMENSIONS ON SITE PRIOR TO CONSTRUCTION AND DO NOT SCALE FROM THE DRAWINGS. ALL DIMENSIONS ARE SHOWN IN METRES. ANY DIMENSIONS SHOULD BE CLARIFIED IN WRITING WITH SAUNDERS HAVILL GROUP PRIOR TO THE COMMENCEMENT OF WORKS.
PRIOR TO ANY DEMOLITION, EXCAVATION OR CONSTRUCTION ON SITE, THE RELEVANT AUTHORITY SHOULD BE CONTACTED FOR FURTHER GUIDANCE SERVICES AND DETAIL LOCATIONS OF ALL SERVICES.

REFERENCES:

Tree Protection Zones & Fencing (AS 4970 - 2009)

AMENDMENTS:

Issue	Date	Description	Checked
A	30/11/2018	Client Draft	JG

PROJECT:


Mountain Ridge
Road upgrade,
South Maclean



PLAN OF:

Vegetation Clearing & Fauna
Management Plan

DATE: 30/11/2018	CHECKED: JG
CLIENT REF: 9282	DRAWN: MC
DRAWING No.: 9282 E 03 VCFMP EXT EDO A	

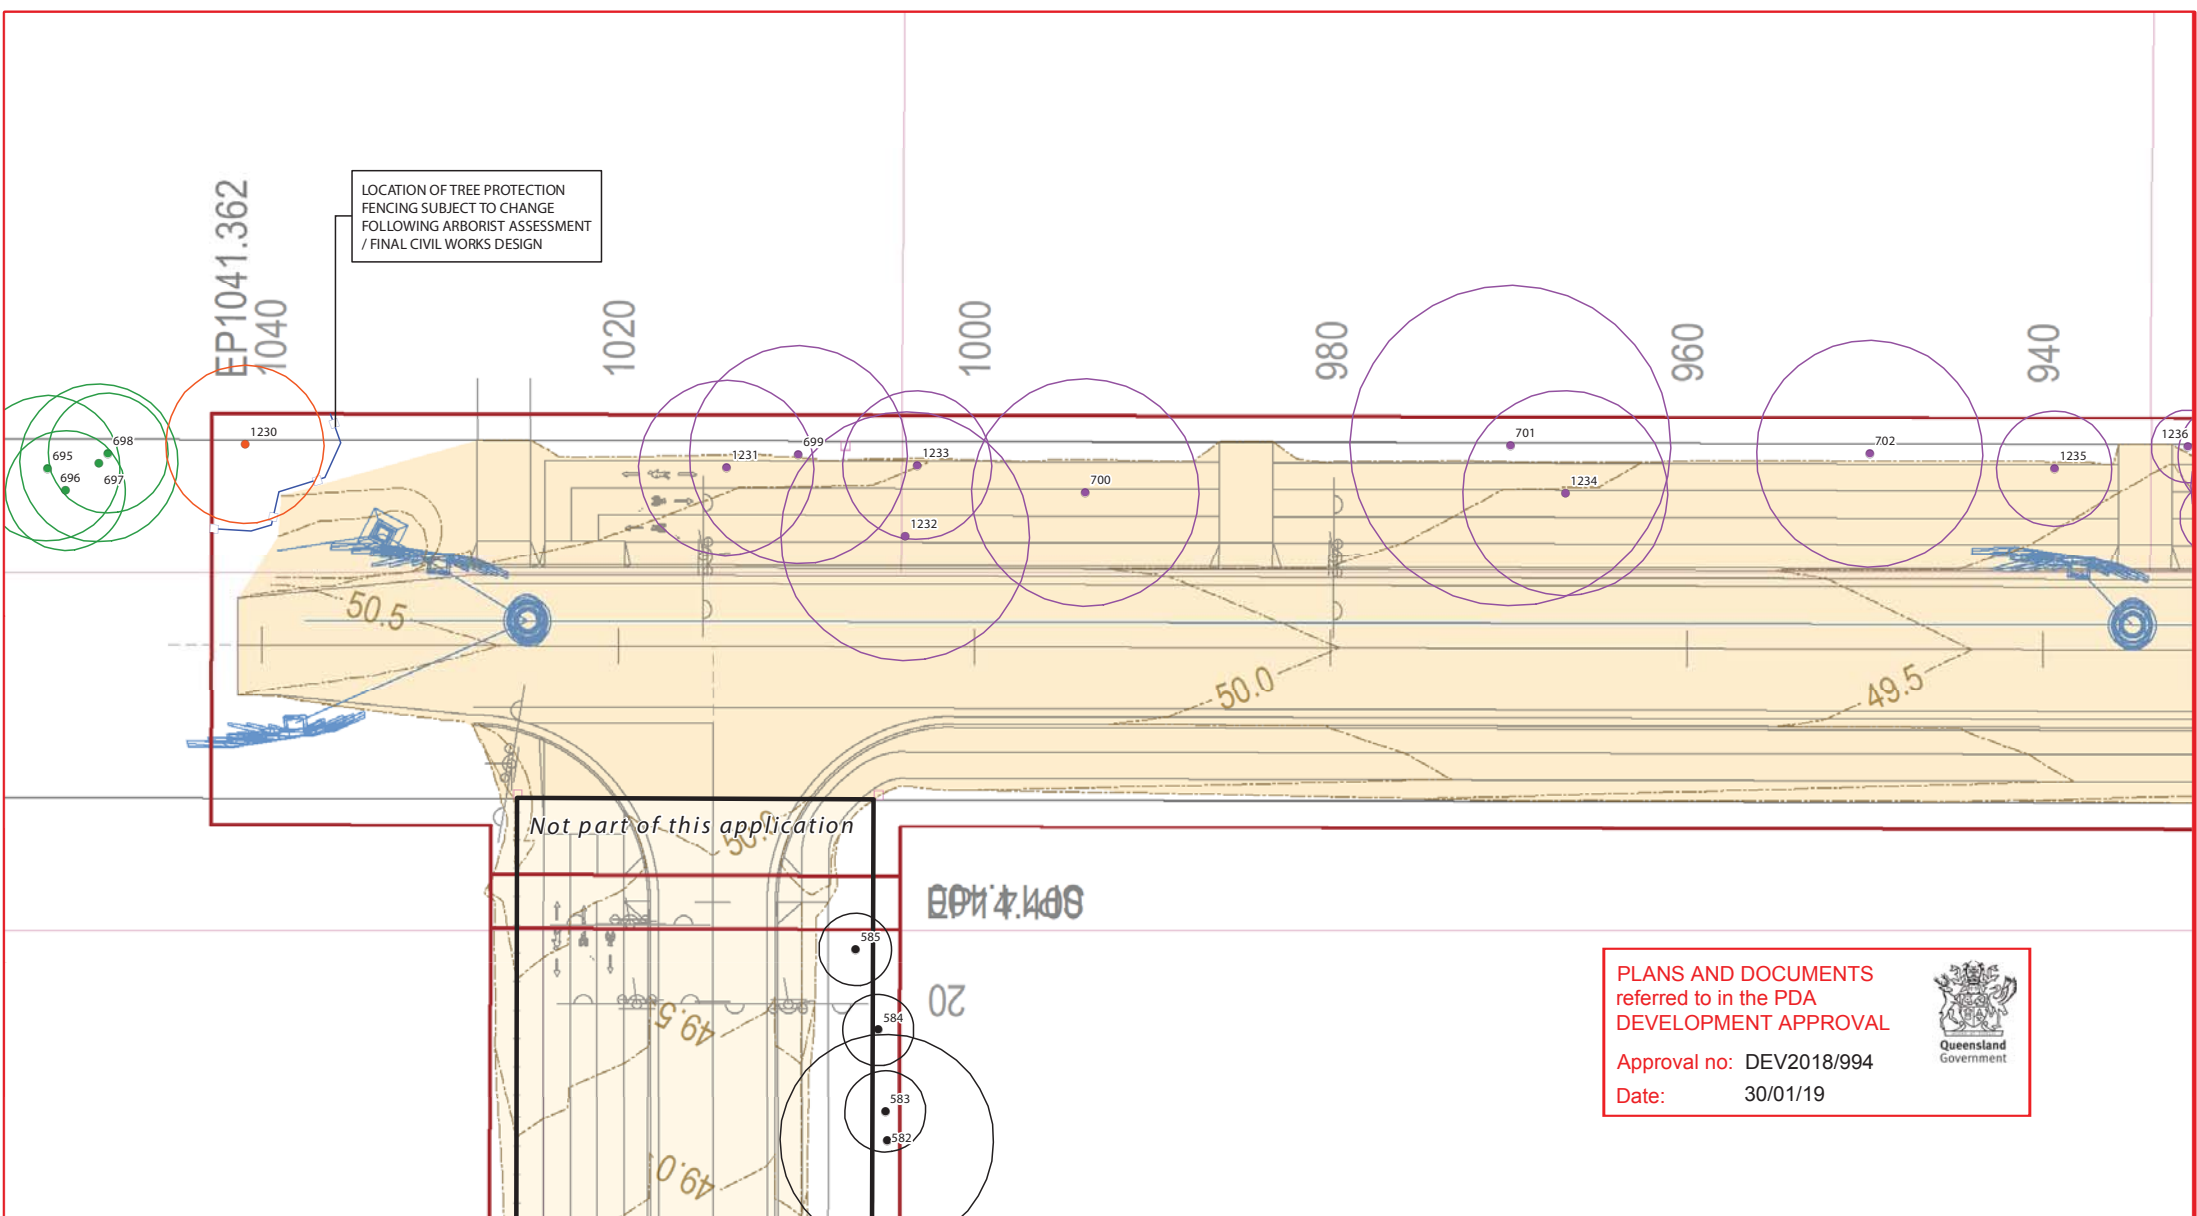

PLANS AND DOCUMENTS
referred to in the PDA
DEVELOPMENT APPROVAL

Approval no: DEV2018/994
Date: 30/01/19



Legend

- Tree to remove (w/TPZ)
- Status subject to arborist inspection (w/TPZ)
- Tree to retain (w/TPZ)
- Not part of this application
- ⊗ Non-native tree sp.
- QLD DCDB
- Development site boundary
- Works boundary
- Roads and pathways
- Earthworks and batters
- Stormwater services
- Sewer services
- Water services
- Electrical services
- Retaining wall
- Future lots
- Tree protection fencing - located around trees to retain adjacent to works
- Earthworks extent
- Earthworks extent not part of this application
- Stockpile location (indicative)

Vegetation Clearing & Fauna Management Plan - Details sheet 4



Orchard (Pebble Creek)
Developments Pty Ltd
ATF The Flagstone Trust

DISCLAIMER:

THESE PLANS HAVE BEEN PREPARED FOR THE EXCLUSIVE USE OF THE CLIENT SAUNDERS HAVILL GROUP. THE CLIENT ACCEPTS RESPONSIBILITY FOR ANY USE OF OR RELIANCE UPON THE CONTENTS OF THESE DRAWINGS BY ANY THIRD PARTY.

CONFORM ALL DIMENSIONS ON SITE PRIOR TO CONSTRUCTION AND DO NOT SCALE IN ON THE DRAWING. ALL DIMENSIONS ARE IN METERS. ANY DIMENSIONS SHOWN BE CLAMPED IN WITHIN WITH SAUNDERS HAVILL GROUP PRIOR TO THE COMMENCEMENT OF WORK.

PLEASE ADVISE SAUNDERS HAVILL GROUP OF ANY CHANGES OR CONSTRUCTION USE. THE RELEVANT AUTHORITY SHOULD BE CONTACTED FOR ANY OTHER ENGINEERING SERVICES AND FOR THE LOCATION OF ALL SERVICES.

REFERENCES:

Engineering base (Peak Urban 2018)

N

0 5 10 20 m 1:300 @ A3


AMENDMENTS:		
Issue	Date	Checked
A	30/11/2018	Client Draft

CLIENT:

Mountain Ridge
Road upgrade,
South Maclean

environmental management

PLAN OF: Vegetation Clearing & Fauna Management Plan	
DATE: 30/11/2018	CHECKED: JG
CLIENT REF: 9282	DRAWN: MC
DRAWING No.: 9282 E 04 VCFMP EXT EDO A	

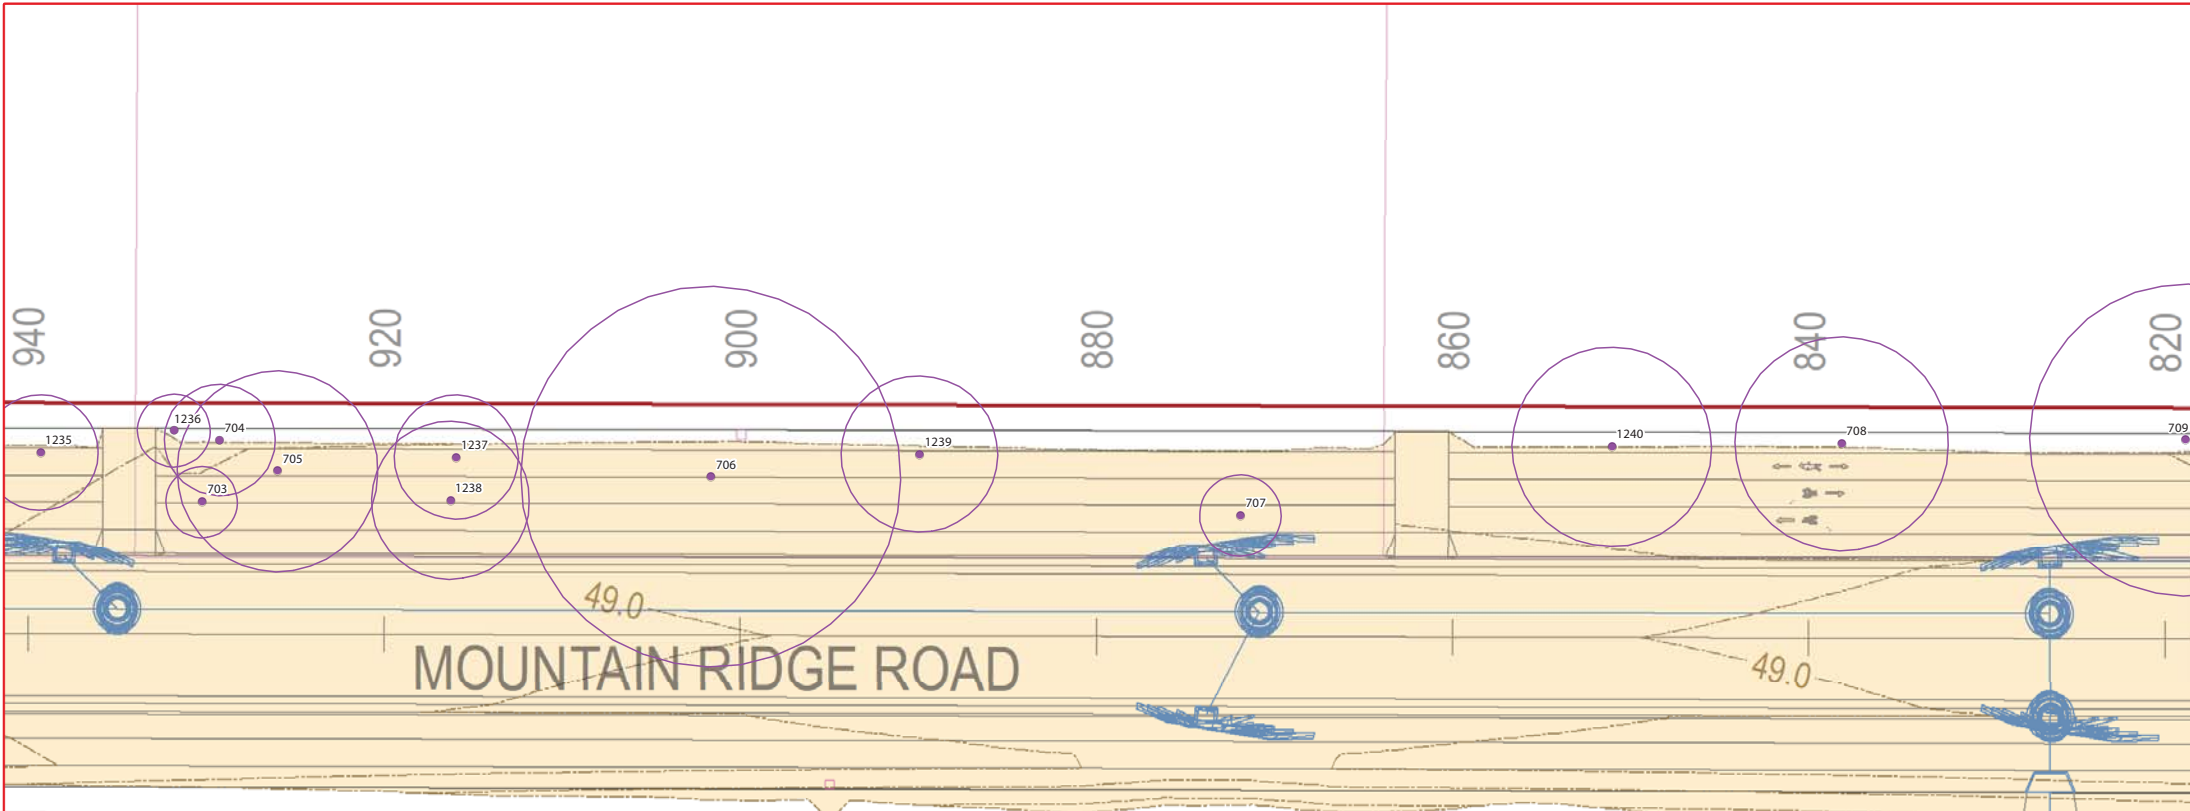

PLANS AND DOCUMENTS
referred to in the PDA
DEVELOPMENT APPROVAL

Approval no: DEV2018/994
Date: 30/01/19



PROJECT ARBORIST TO SUPERVISE
AND DIRECT ANY WORKS WITHIN
TPZ OF TREES TO BE RETAINED AND
ADJOINING BUSHLAND.

Legend

- Tree to remove (w/TPZ)
- Status subject to arborist inspection (w/TPZ)
- Tree to retain (w/TPZ)
- Not part of this application
- ⊗ Non-native tree sp.
- QLD DCDB
- Development site boundary
- Works boundary
- Roads and pathways
- Earthworks and batters
- Stormwater services
- Sewer services
- Water services
- Electrical services
- Retaining wall
- Future lots
- Tree protection fencing - located around trees to retain adjacent to works
- Earthworks extent
- Earthworks extent not part of this application
- ⊗ Stockpile location (indicative)

Vegetation Clearing & Fauna Management Plan - Details sheet 5



Orchard (Pebble Creek)
Developments Pty Ltd
ATF The Flagstone Trust

DISCLAIMER:
THESE PLANS HAVE BEEN PREPARED FOR THE EXCLUSIVE USE OF THE CLIENT SAUNDERS HAVILL GROUP. THE CLIENT SHALL ACCEPT RESPONSIBILITY FOR ANY USE OF OR RELIANCE UPON THE CONTENTS OF THESE DRAWINGS BY ANY THIRD PARTY.
CONFORM ALL DIMENSIONS ON SITE PRIOR TO CONSTRUCTION AND DO NOT SCALE IN OR OUT THE DRAWINGS. ALL DIMENSIONS ARE IN METERS UNLESS OTHERWISE SPECIFIED. ANY DISCREPANCIES SHOULD BE CLARIFIED IN WRITING WITH SAUNDERS HAVILL GROUP PRIOR TO THE COMMENCEMENT OF WORK.
PRIOR TO ANY DEMOLITION, EXCAVATION OR CONSTRUCTION WORK, THE RELEVANT AUTHORITY SHOULD BE CONTACTED FOR ANY OTHER UNDERGROUND SERVICES AND THEIR LOCATIONS OF ALL SERVICES.

REFERENCES:
Engineering base (Peak Urban 2018)



AMENDMENTS:			
Issue	Date	Description	Checked
A	30/11/2018	Client Draft	JG


0 5 10 20 m 1:300 @ A3

CLIENT:

Mountain Ridge
Road upgrade,
South Maclean

environmental management

PLAN OF: Vegetation Clearing & Fauna Management Plan	
DATE: 30/11/2018	CHECKED: JG
CLIENT REF: 9282	DRAWN: MC
DRAWING No.: 9282 E 04 VCFMP EXT EDQ A	

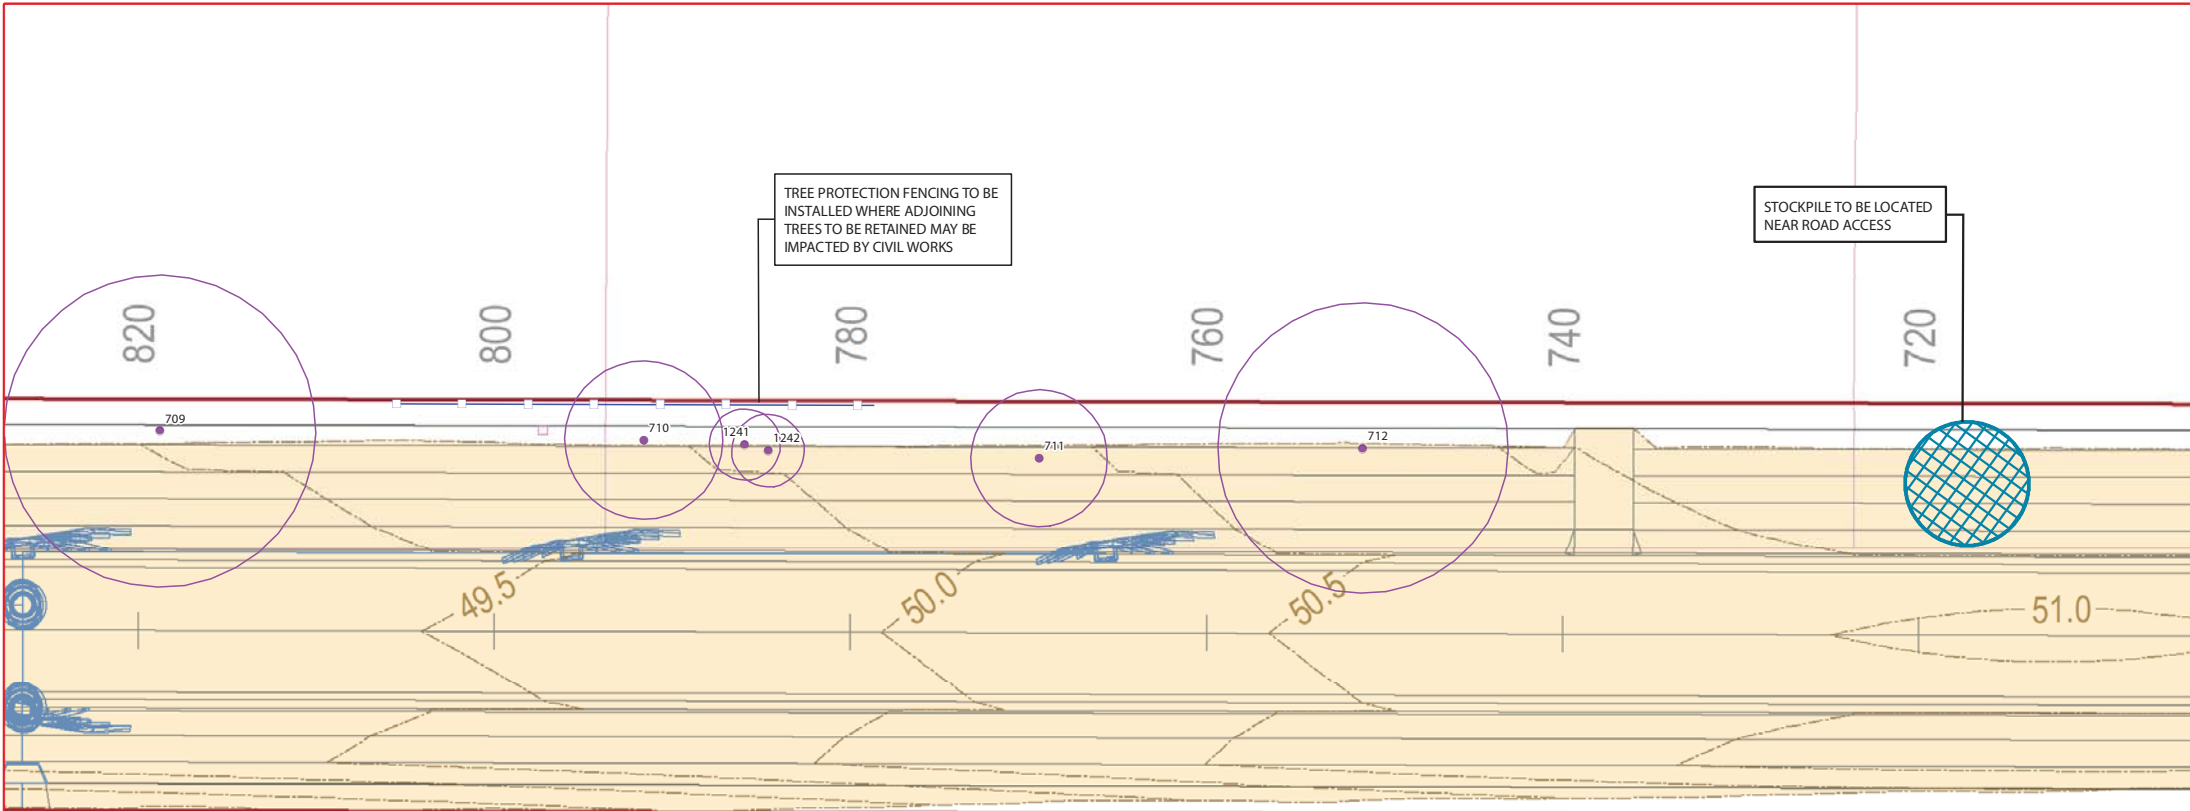

PLANS AND DOCUMENTS
referred to in the PDA
DEVELOPMENT APPROVAL


Approval no: DEV2018/994
Date: 30/01/19


Queensland
Government

Legend

 Tree to remove (w/TPZ)	 Not part of this application	 Development site boundary	 Earthworks and batters	 Water services	 Future lots	 Earthworks extent
 Status subject to arborist inspection (w/TPZ)	 Non-native tree sp.	 Works boundary	 Stormwater services	 Electrical services	 Tree protection fencing - located around trees to retain adjacent to works	 Earthworks extent not part of this application
 Tree to retain (w/TPZ)	 QLD DCDB	 Roads and pathways	 Sewer services	 Retaining wall		 Stockpile location (indicative)

Vegetation Clearing & Fauna Management Plan - Details sheet 6

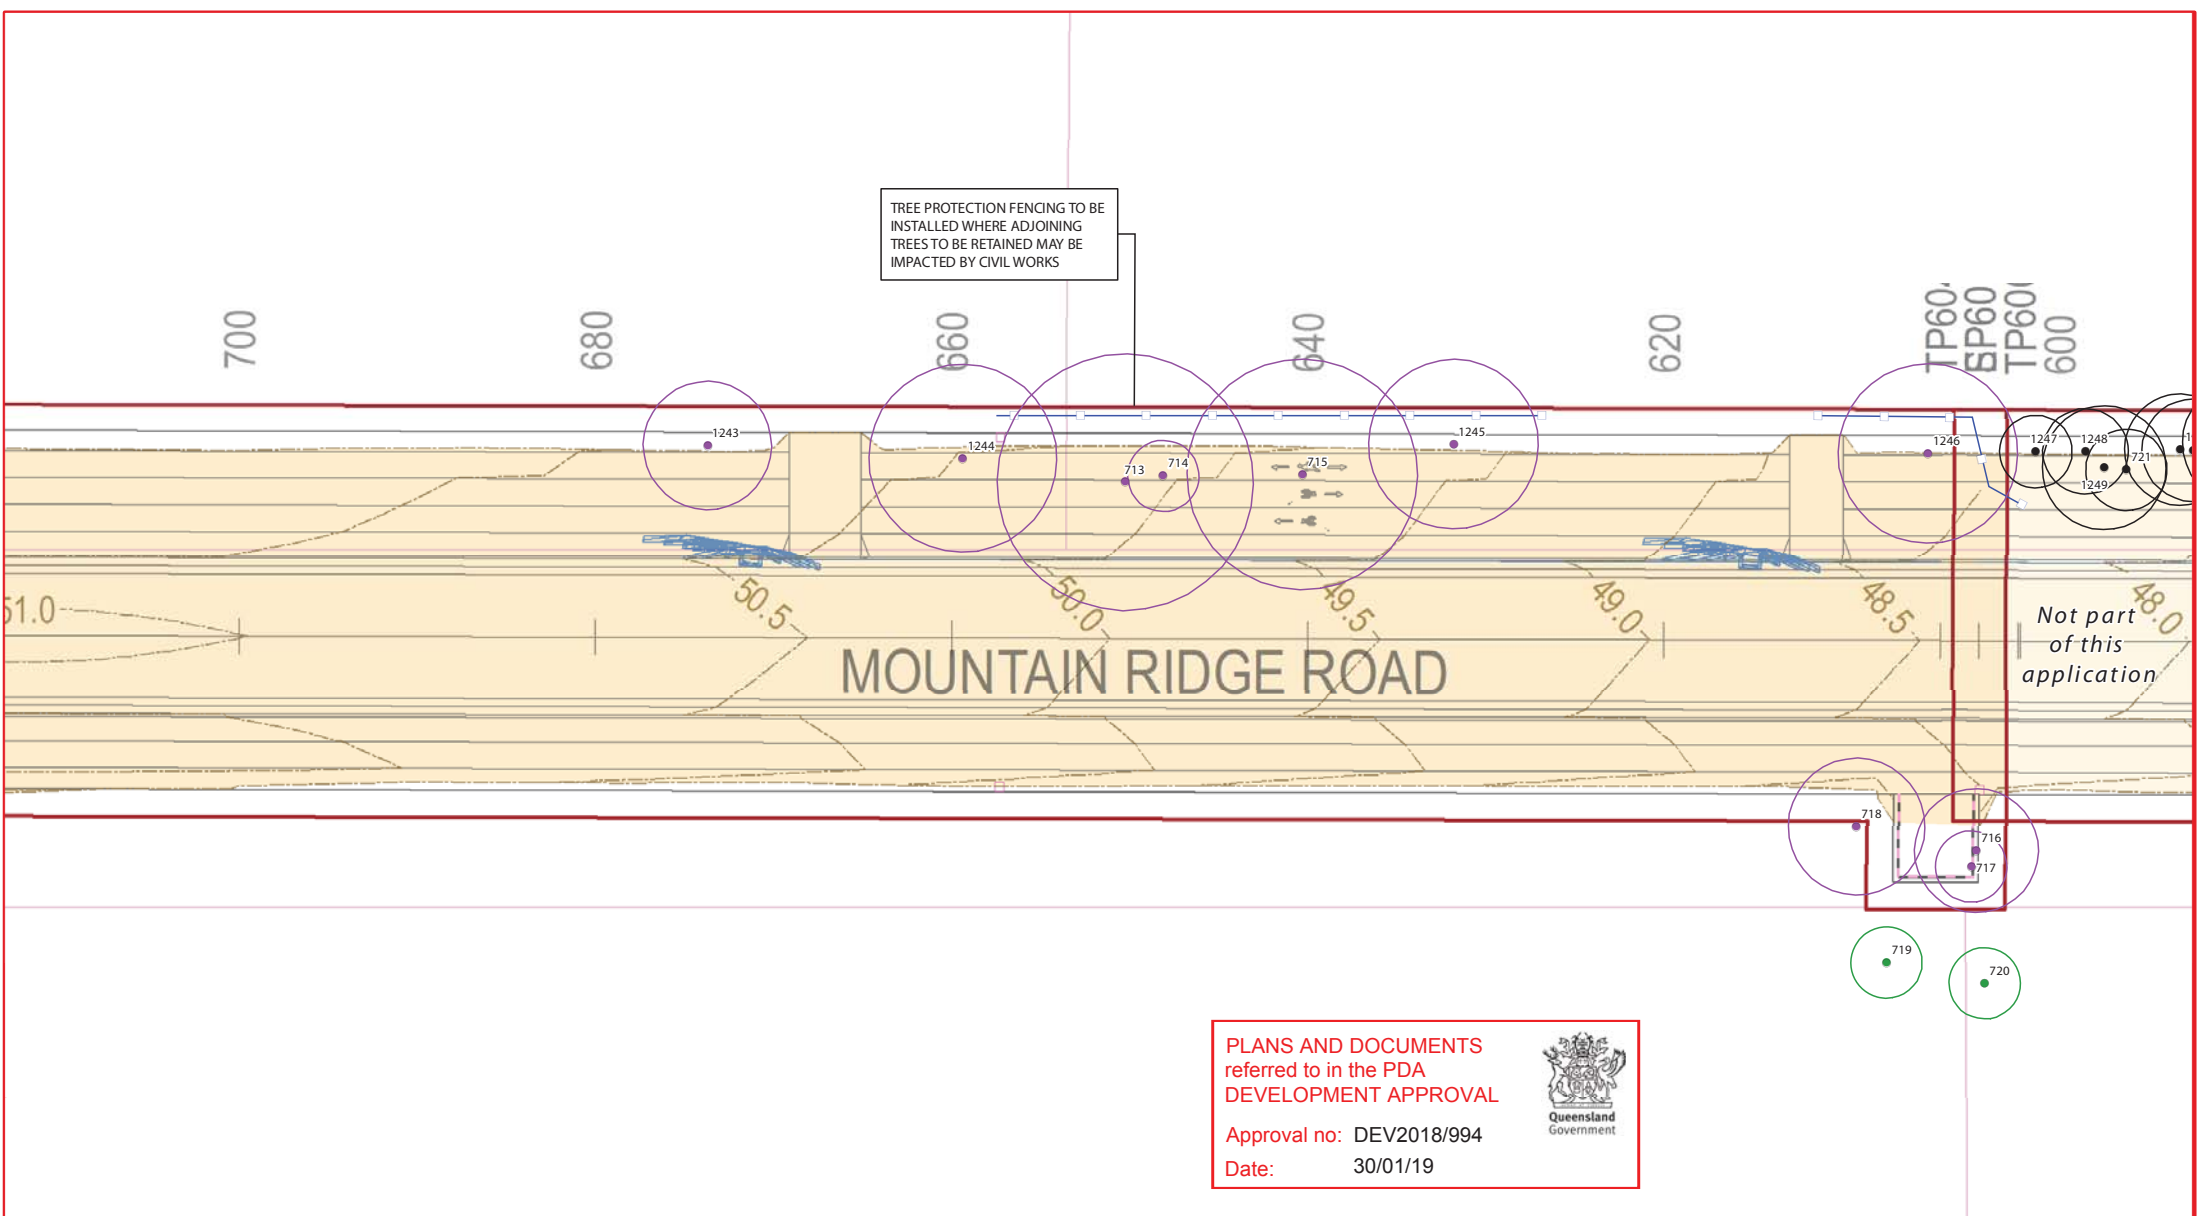

PLANS AND DOCUMENTS referred to in the PDA DEVELOPMENT APPROVAL

Approval no: DEV2018/994

Date: 30/01/19


Legend

Tree to remove (w/TPZ)	Not part of this application	Development site boundary	Earthworks and batters	Water services	Future lots	Earthworks extent
Status subject to arborist inspection (w/TPZ)	Non-native tree sp.	Works boundary	Stormwater services	Electrical services	Tree protection fencing - located around trees to retain adjacent to works	Earthworks extent not part of this application
Tree to retain (w/TPZ)	QLD DCDB	Roads and pathways	Sewer services	Retaining wall	Stockpile location (indicative)	

Vegetation Clearing & Fauna Management Plan - Details sheet 7

	Orchard (Pebble Creek) Developments Pty Ltd ATF The Flagstone Trust	DISCLAIMER: THESE PLANS HAVE BEEN PREPARED FOR THE EXCLUSIVE USE OF THE CLIENT SAUNDERS HAVILL GROUP. THE CLIENT SHALL ACCEPT RESPONSIBILITY FOR ANY USE OF OR RELIANCE UPON THE CONTENTS OF THESE DRAWINGS BY ANY THIRD PARTY. CONFORM ALL DIMENSIONS ON SITE PRIOR TO CONSTRUCTION AND DO NOT SCALE FROM THE DRAWINGS. ALL DIMENSIONS SHALL BE IN METERS. ANY DISCREPANCIES SHOULD BE CLARIFIED IN WRITING WITH SAUNDERS HAVILL GROUP PRIOR TO THE COMMENCEMENT OF WORK. PLEASE ADVISE SAUNDERS HAVILL GROUP OF ANY CHANGES TO THE SITE OR THE DRAWINGS PRIOR TO THE COMMENCEMENT OF WORK.	REFERENCES: Engineering base (Peak Urban 2018)	AMENDMENTS: <table><thead><tr><th>Issue</th><th>Date</th><th>Description</th><th>Checked</th></tr></thead><tbody><tr><td>A</td><td>30/11/2018</td><td>Client Draft</td><td>JG</td></tr></tbody></table>	Issue	Date	Description	Checked	A	30/11/2018	Client Draft	JG	CLIENT: Mountain Ridge Road upgrade, South Maclean	environmental management PLAN OF: Vegetation Clearing & Fauna Management Plan
					Issue	Date	Description	Checked						
					A	30/11/2018	Client Draft	JG						
DATE: 30/11/2018	CHECKED: JG													
CLIENT REF: 9282	DRAWN: MC													

DRAWING No.: 9282 E 04 VCFMP EXT EDO A

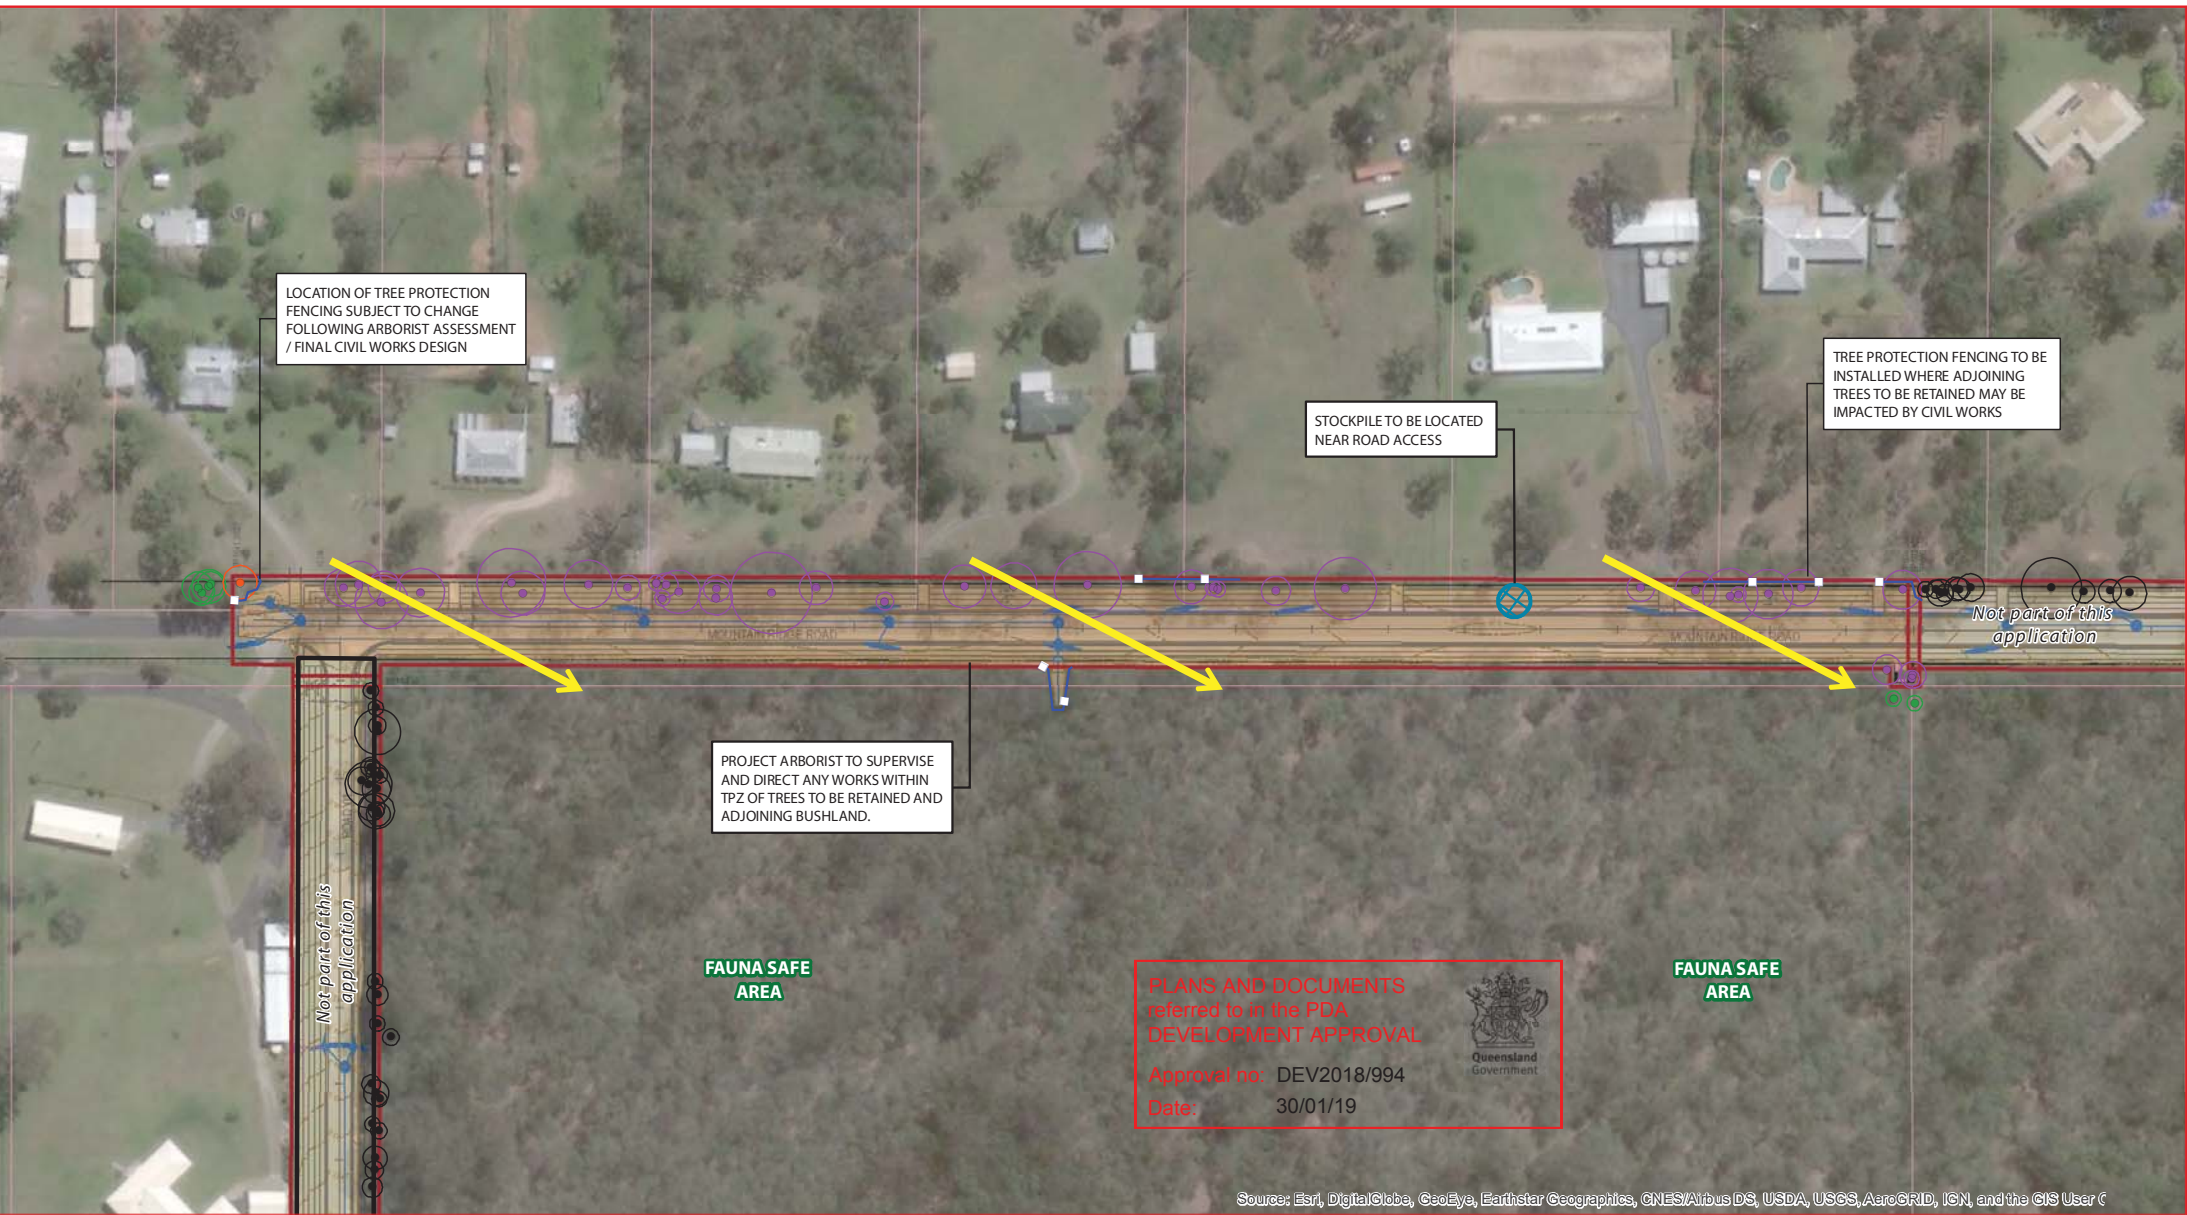

Legend

- Tree to remove (w/TPZ)
- Status subject to arborist inspection (w/TPZ)
- Tree to retain (w/TPZ)
- Not part of this application
- Non-native tree sp.
- QLD DCDB
- Development site boundary
- Works boundary
- Roads and pathways
- Earthworks and batters
- Stormwater services
- Sewer services
- Water services
- Electrical services
- Retaining wall
- Future lots
- Tree protection fencing - located around trees to retain adjacent to works
- Earthworks extent
- Earthworks extent not part of this application
- Stockpile location (indicative)

Vegetation Clearing & Fauna Management Plan - Clearing Direction



Orchard (Pebble Creek)
Developments Pty Ltd
ATF The Flagstone Trust

DISCLAIMER:



REFERENCES:

Engineering base (Peak Urban 2018)

AMENDMENTS:

Issue	Date	Description	Checked
A	30/11/2018	Client Draft	JG

CLIENT:

Mountain Ridge
Road upgrade,
South Maclean

environmental management

PLAN OF:		Vegetation Clearing & Fauna Management Plan	
DATE:	30/11/2018	CHECKED:	JG
CLIENT REF:	9282	DRAWN:	MC
DRAWING No.: 9282 E 08 VCFMP EXT EDO A			



1:1,400 @ A3

Specimen Details										Canopy Condition Details							Trunk Condition Details					Fauna Details and Habitat Value							
Tree ID	Botanical Name	Common Name	Trunk DBH (mm)	Additional Trunks DBH (mm)	Total DBH (mm) [AS 4970-2009]	Height (m)	Spread (m)	Tree Protection Zone (m)	Structural Root Zone (m)	Canopy Form	Spreading	Thinning	Die-Back	Epicormic Growth	Lopped	Canopy Health	Leaning	Vines	Trunk Damage	Fire Damage	Trunk Health	Scats	Scratches	Hollows	Nest	Termite Nest	Habitat Value	Retention	Additional Notes
695	Corymbia intermedia	Pink Bloodwood	340		340	18.0	6.0	4.1	2.1	Regular	-	-	-	-	-	Typical	-	-	-	-	Typical	-	-	-	-	-	-	Retain	
696	Lophostemon suaveolens	Swamp Box	280		280	14.0	5.0	3.4	1.9	Regular	-	-	-	-	-	Typical	-	-	-	-	Typical	-	-	-	-	-	-	Retain	
697	Eucalyptus tereticornis	Forest Red Gum	370		370	18.0	8.0	4.4	2.2	Regular	-	-	-	-	-	Typical	-	-	-	-	Typical	-	-	-	-	-	-	Retain	
698	Corymbia intermedia	Pink Bloodwood	280		280	17.0	5.0	3.4	1.9	Regular	-	-	-	-	-	Typical	-	-	-	-	Typical	-	-	-	-	-	-	Retain	
699	Eucalyptus tereticornis	Forest Red Gum	510		510	21.0	10.0	6.1	2.5	Regular	-	-	-	-	-	Typical	-	-	-	-	Typical	-	-	-	-	-	-	Remove	
700	Eucalyptus tereticornis	Forest Red Gum	470	250	532	16.0	6.0	6.4	2.5	Regular	-	-	Die-back	-	Lopped	Poor	-	-	-	-	Typical	-	-	-	-	-	-	Remove	
701	Eucalyptus siderophloia	Grey Ironbark	750		750	21.0	12.0	9.0	2.9	Regular	-	-	-	-	-	Typical	-	-	-	-	Typical	-	-	-	-	-	-	Remove	
702	Eucalyptus tereticornis	Forest Red Gum	530		530	23.0	9.0	6.4	2.5	One-sided	-	-	-	-	-	Typical	-	-	-	-	Typical	-	-	-	-	-	-	Remove	
703	Corymbia citriodora	Spotted Gum	160		160	13.0	2.0	2.0	1.5	Regular	-	-	-	-	-	Typical	-	-	-	-	Typical	-	-	-	-	-	-	Remove	
704	Corymbia citriodora	Spotted Gum	260		260	15.0	5.0	3.1	1.9	Regular	-	-	-	-	-	Typical	-	-	-	-	Typical	-	-	-	-	-	-	Remove	
705	Corymbia citriodora	Spotted Gum	470		470	23.0	13.0	5.6	2.4	Regular	-	-	-	-	-	Typical	-	-	-	-	Typical	-	-	-	-	-	-	Remove	
706	Corymbia citriodora	Spotted Gum	890		890	25.0	14.0	10.7	3.2	Regular	-	-	-	-	Lopped	Typical	-	-	-	-	Typical	-	-	Large	-	-	-	Remove	Cockatoo nesting
707	Corymbia citriodora	Spotted Gum	190		190	10.0	3.0	2.3	1.6	Regular	-	-	Die-back	-	Lopped	Poor	-	-	-	-	Typical	-	-	-	-	-	-	Remove	
708	Corymbia citriodora	Spotted Gum	500		500	27.0	15.0	6.0	2.5	Regular	-	-	-	-	-	Typical	-	-	-	-	Typical	-	-	-	-	-	-	Remove	
709	Eucalyptus siderophloia	Grey Ironbark	730		730	28.0	16.0	8.8	2.9	Regular	-	-	-	-	-	Typical	-	-	-	-	Typical	-	-	-	-	-	-	Remove	
710	Eucalyptus crebra	Narrow Leaf Ironbark	370		370	15.0	6.0	4.4	2.2	Regular	-	-	-	-	-	Typical	-	-	-	-	Typical	-	-	-	-	-	-	Remove	
711	Eucalyptus tereticornis	Forest Red Gum	320		320	15.0	4.0	3.8	2.1	Regular	-	-	-	-	-	Typical	-	-	-	-	Typical	-	-	-	-	-	-	Remove	
712	Eucalyptus tereticornis	Forest Red Gum	680		680	17.0	9.0	8.2	2.8	Regular	-	-	-	-	-	Typical	-	-	-	-	Typical	-	-	-	-	-	-	Remove	
713	Corymbia intermedia	Pink Bloodwood	600		600	29.0	17.0	7.2	2.7	Regular	-	-	-	-	-	Typical	-	-	-	-	Typical	-	-	-	-	-	-	Remove	
714	Corymbia citriodora	Spotted Gum	140		140	12.0	3.0	2.0	1.4	Regular	-	-	-	-	-	Typical	-	-	-	-	Typical	-	-	-	-	-	-	Remove	
715	Eucalyptus tereticornis	Forest Red Gum	540		540	27.0	14.0	6.5	2.6	Regular	-	-	-	-	-	Typical	-	-	-	-	Typical	-	-	-	-	-	-	Remove	
716	Angophora leiocarpa	Smooth Bark Apple	290		290	15.0	5.0	3.5	2.0	Regular	-	-	-	-	-	Typical	-	-	-	-	Typical	-	-	-	-	-	-	Remove	
717	Acacia dispartima	Hickory Wattle	120		120	9.0	3.0	2.0	1.4	Regular	-	-	-	-	-	Typical	-	-	-	-	Typical	-	-	-	-	-	-	Remove	
718	Acacia dispartima	Hickory Wattle	320		320	13.0	8.0	3.8	2.1	Regular	-	-	Die-back	-	Lopped	Poor	-	-	-	-	Typical	-	-	-	-	-	-	Remove	
719	Acacia dispartima	Hickory Wattle	150		150	10.0	6.0	2.0	1.5	Regular	-	-	-	-	-	Typical	-	-	-	-	Typical	-	-	-	-	-	-	Retain	
720	Acacia dispartima	Hickory Wattle	130		130	12.0	3.0	2.0	1.4	Regular	-	-	-	-	-	Typical	-	-	-	-	Typical	-	-	-	-	-	-	Retain	
1230	Eucalyptus siderophloia	Grey Ironbark	370		370	27.0	13.0	4.4	2.2	Regular	-	-	-	-	-	Typical	-	-	-	-	Typical	-	-	-	-	-	-	Arborist	
1231	Eucalyptus tereticornis	Forest Red Gum	410		410	26.0	12.0	4.9	2.3	Regular	-	-	-	-	-	Typical	-	-	-	-	Typical	-	-	-	-	-	-	Remove	
1232	Eucalyptus tereticornis	Forest Red Gum	560	160	582	19.0	9.0	7.0	2.6	Regular	-	-	-	-	-	Typical	-	-	-	-	Typical	-	-	-	-	-	-	Remove	
1233	Acacia dispartima	Hickory Wattle	270	220	348	9.0	7.0	4.2	2.1	Regular	-	-	-	-	-	Typical	-	-	-	-	Typical	-	-	-	-	-	-	Remove	
1234	Eucalyptus tereticornis	Forest Red Gum	480		480	20.0	7.0	5.8	2.4	Regular	-	-	Die-back	-	-	Typical	-	-	-	-	Typical	-	-	-	-	-	-	Remove	
1235	Angophora leiocarpa	Smooth Bark Apple	270		270	20.0	7.0	3.2	1.9	Regular	-	-	-	-	-	Typical	-	-	-	-	Typical	-	-	-	-	-	-	Remove	
1236	Angophora leiocarpa	Smooth Bark Apple	170		170	16.0	6.0	2.0	1.6	Regular	-	-	-	-	-	Typical	-	-	-	-	Typical	-	-	-	-	-	-	Remove	
1237	Angophora leiocarpa	Smooth Bark Apple	290		290	18.0	5.0	3.5	2.0	Regular	-	-	-	Epicormic	-	Typical	-	-	-	-	Typical	-	-	-	-	-	-	Remove	
1238	Eucalyptus tereticornis	Forest Red Gum	370		370	23.0	15.0	4.4	2.2	Regular	-	-	-	-	-	Typical	-	-	-	-	Typical	-	-	-	-	-	-	Remove	
1239	Eucalyptus tereticornis	Forest Red Gum	300	210	366	20.0	8.0	4.4	2.2	Regular	-	-	-	-	-	Typical	-	-	-	-	Typical	-	-	-	-	-	-	Remove	
1240	Corymbia tessellaris	Moreton Bay Ash	340	320	467	27.0	16.0	5.6	2.4	Regular	-	-	-	-	-	Typical	-	-	-	-	Typical	-	-	-	Small	-	-	Remove	2 stick nest
1241	Eucalyptus tereticornis	Forest Red Gum	140		140	17.0	4.0	2.0	1.4	Regular	-	-	-	-	-	Typical	-	-	-	-	Typical	-	-	-	-	-	-	Remove	
1242	Corymbia citriodora	Spotted Gum	170		170	14.0	4.0	2.0	1.6	Regular	-	-	-	-	-	Typical	-	-	-	-	Typical	-	-	-	-	-	-	Remove	
1243	Corymbia citriodora	Spotted Gum	300		300	22.0	9.0	3.6	2.0	Regular	-	-	-	-	-	Typical	-	-	-	-	Typical	-	-	-	-	-	-	Remove	
1244	Eucalyptus tereticornis	Forest Red Gum	440		440	26.0	14.0	5.3	2.3	Regular	-	-	-	-	-	Typical	-	-	-	-	Typical	-	-	-	-	-	-	Remove	
1245	Eucalyptus tereticornis	Forest Red Gum	300	260	397	17.0	12.0	4.8	2.2	Regular	-	-	-	-	-	Typical	-	-	-	-	Typical	-	-	-	-	-	-	Remove	
1246	Angophora leiocarpa	Smooth Bark Apple	420		420	29.0	15.0	5.0	2.3	Regular	-	-	-	-	-	Typical	-	-	-	-	Typical	-	-	-	-	-	-	Remove	