

Notes:

General

- All development is to be undertaken in accordance with the Development Approval, and Queensland Development Code (QDC), except as varied below.
- Maximum height of buildings shall not exceed two (2) storeys.
- Maximum building location envelopes are subject to future proposed easements and/or other underground services.
- All lots subject to an acoustic assessment to determine level of acoustic treatments.
- Buildings shall be constructed in accordance with Bushfire AS3959.
- Secondary dwellings are not permitted on lots less than 400m².
- All lots (excluding multiple residential allotments) must contain a house.

Setbacks

- Setbacks are as per the Plan of Development Table unless otherwise dimensioned. If a lot is not developed for a Multiple Residential (MR) site, then the equivalent site detached lot setbacks will apply.
- The location of the built to boundary walls are indicated on the Plan of Development. Where built to boundary walls are not adopted site setbacks shall be in accordance with the Plan of Development Table.
- Boundary setbacks are measured to the wall of the structure.
- Front verandah and covered areas to the front door are permitted to extend into the front setback on the condition that the roofed area is not enclosed. For front setbacks, this roofed area can extend to 1.0m from the front property line.
- Eaves cannot encroach (other than where buildings are built to boundary) closer than 450mm to the lot boundary.
- Buildings to be sited in accordance with the 'Special Siting Requirements for Corner Allotments'.

Private Open Space

- Private open space must measure a minimum of 10m² with a minimum dimension in any direction of 2.4 metres and must be uncovered (no roof).
- Private open space must be directly accessible from a living space.

On-site car parking and driveways

- On-site car parking is to be provided in accordance with the following minimum requirements:
 - For lots up to 12.49 metres wide - 1 covered space per dwelling;
 - For Ascot Allotments - 2 spaces per dwelling, one of which must be capable of being covered;
 - For lots 12.5 metres wide or greater - 2 covered spaces per dwelling;
 - For Multiple Residential sites, at least 1 covered space per dwelling, plus 0.5 spaces per dwelling (can be uncovered);
- Garages for any single storey dwelling on a Lot between 10.0m and 12.49m in width must adhere to the following design criteria:
 - The front facing building wall, which comprises the garage door, must not exceed an external width of 5.7m.
 - The garage door:
 - Width must not exceed 4.8m
 - Must have a minimum 450mm eave above it
 - Must be setback a minimum of 240mm behind the pillar of the garage door, and
 - Must have a sectional, tilt or roller door
 - The front facade of the dwelling must be forward of the alignment of the garage wall, and must include the following:
 - A front entrance door with glass inserts and / or windows or with a sidelight where the front door is solid. If the front facade includes a habitable room with window, a sidelight is not required.
 - A front verandah, portico or porch located over the front entrance, which extends a minimum of 1600mm forward of the entrance door
 - The verandah, portico or porch is to include front plants with distinct materials and/or colours.
 - Driveways cannot exceed 3.0m across the verge on lots between 10.0m and 12.49m wide."
- Double car garages are permitted on any double storey dwelling or laneway dwelling built on a lot between 10.0m and 12.49m.
- Driveways are to accord with Logan City Council's (LCC) standards. Prior to construction, approval from LCC for Vehicular Access to Residential Premises is required.
- The maximum width of a driveway at the lot boundary shall be 4.8 metres for a lot with a double car width garage and 3.0 metres for a lot with a single car width garage.
- Garages and carports accessed from a Laneway must be built setback 0.9 metres from the boundary. Ingress/egress must be achieved for a B99 Vehicle.
- Maximum of one driveway per dwelling unless it is a MR lot.
- Minimum distance of a driveway from an intersection of one street with another street is 6.0 metres. The Driveway must be laid at the grade of the adjacent verge area. No grade changes to the verge for the driveway will be allowed.
- Where there is a footpath within the verge, the footpath should be cut at the nearest joint and the footpath reinstated to the driveway without compromising the structural integrity of the footpath.
- Driveways must be completed prior to occupation of the dwelling.

Fencing

- Fencing erected by Peet must not be altered, modified or removed without prior written approval from Peet.
- Fencing on all park or street frontages has a maximum height of 1.2metres where solid or have a maximum height of 1.8 metres where containing openings that make the fence more than 50% transparent.
- Fencing on all park or street frontages is constructed with visible posts, which are at least 120mm x 120mm and 100mm higher than the infill palings or panels.
- Fencing on lanes can be screen fencing at 1.8m high where along private open space, carparking and service areas.
- Fencing on corner lots is to be designed as front fences addressing both streets (rather than a front and a side fence).
- Notwithstanding the above, solid front fences and walls may be 1.8 metres in height if the dwelling has a frontage to a street with traffic volumes in excess of, or projected to exceed, 10,000 vehicles per day.
- Retaining walls must not exceed more than 1.0 metres where fronted to a public street or park. Retaining walls to side and rear boundaries (which are not adjoining a public street or park) can be up to 2.0 metres. Retaining in excess of this must use terraced retaining.
- No timber retaining walls over 1.0m or adjoining parks or public streets.
- Walkers over 1.0m require RPEQ certification.

Building Articulation

- All buildings with a width of more than 10 metres that are visible from a street or park are to include articulation to reduce the mass of the building by one or more of the following:
 - Windows recessed into the facade or bay windows;
 - Balconies, porches or verandahs;
 - Articulation of roof lines
 - Window hoods; and/or
 - Use of multiple cladding materials
- Buildings that do not comply may be assessed on architectural merit when accompanied by a report from a Registered Architect.
- Carports and garages are to be compatible with the main building design in terms of height, roof form, detailing, materials and colours.
- All building materials must be suitably coloured, stained or painted, including retaining, fences, walls and roofs. Un-treated materials, such as zinc coated steel, bare metal, concrete block or masonry panels are not permitted.
- Air-conditioners, gas bottles, hot water systems, clothes lines and other household services must be screened and/or located to minimise visual impact to public streets or parks.
- Homes must include a clearly identifiable and addressed front door and undercover point of entry.
- Screened drying and rubbish bins area must be behind the main face of the dwelling.
- At least two openings to all habitable rooms to facilitate cross flow ventilation are required.

Slope and Building Footings

- Buildings on sloping sites, must be built to the boundary on the low side of the lot and the footing must be projected deep enough to be below the adjoining property building pad level.
- If the nominated pad level is not provided, the pad level is to be assumed as the average of the four corners of the adjacent block, using the as constructed levels.
- Building footings are to be designed in accordance with the appropriate Australian Standard. Building footings are to be designed to ensure there are no adverse impacts (functional, financial or construction limitations) on adjoining allotments, particularly in relation to retaining walls.

Additional Criteria for Multiple Residential Allotments

- Buildings must address all street frontages with driveways, pedestrianies or both.
- All dwellings must have a clearly identifiable front door, which is undercover.
- Have drying and rubbish bin areas behind the main face of the dwelling or suitably screen from public streets and park frontages.
- Maximum number of dwellings on each multiple residential lot is annotated on the Plan of Development.



Additional Criteria for Secondary Dwellings

- Floor area must be between a minimum of 30m² and 75m².
- Materials, detailing, colours and roof form are consistent with those of the main house.
- Outdoor living space must measure a minimum of 9m² with a minimum dimension in any direction of 3 metres.
- Outdoor living space must be directly accessible from the main living space and can be combined with the primary dwelling outdoor space.
- Outdoor living space on a corner allotment must be suitably screened / located within the secondary street boundary setback.
- A minimum of one (5m x 3m) car parking space must be provided for the secondary dwelling, in addition to parking for the primary dwelling.
- The driveway must be shared with the primary house, however on corner allotments a separate driveway may be provided with a minimum width of 3 metres and a maximum width of 5 metres.
- Corner allotments must provide dedicated pedestrian entry and a viable door from and addressing the secondary street to the secondary dwelling.
- Corner allotments must provide a minimum of one habitable room, with large windows or balconies, fronting the secondary street.

Definitions

Laneway Allotment - Allotments serviced by a laneway.

Special Siting Requirements for Corner Allotments

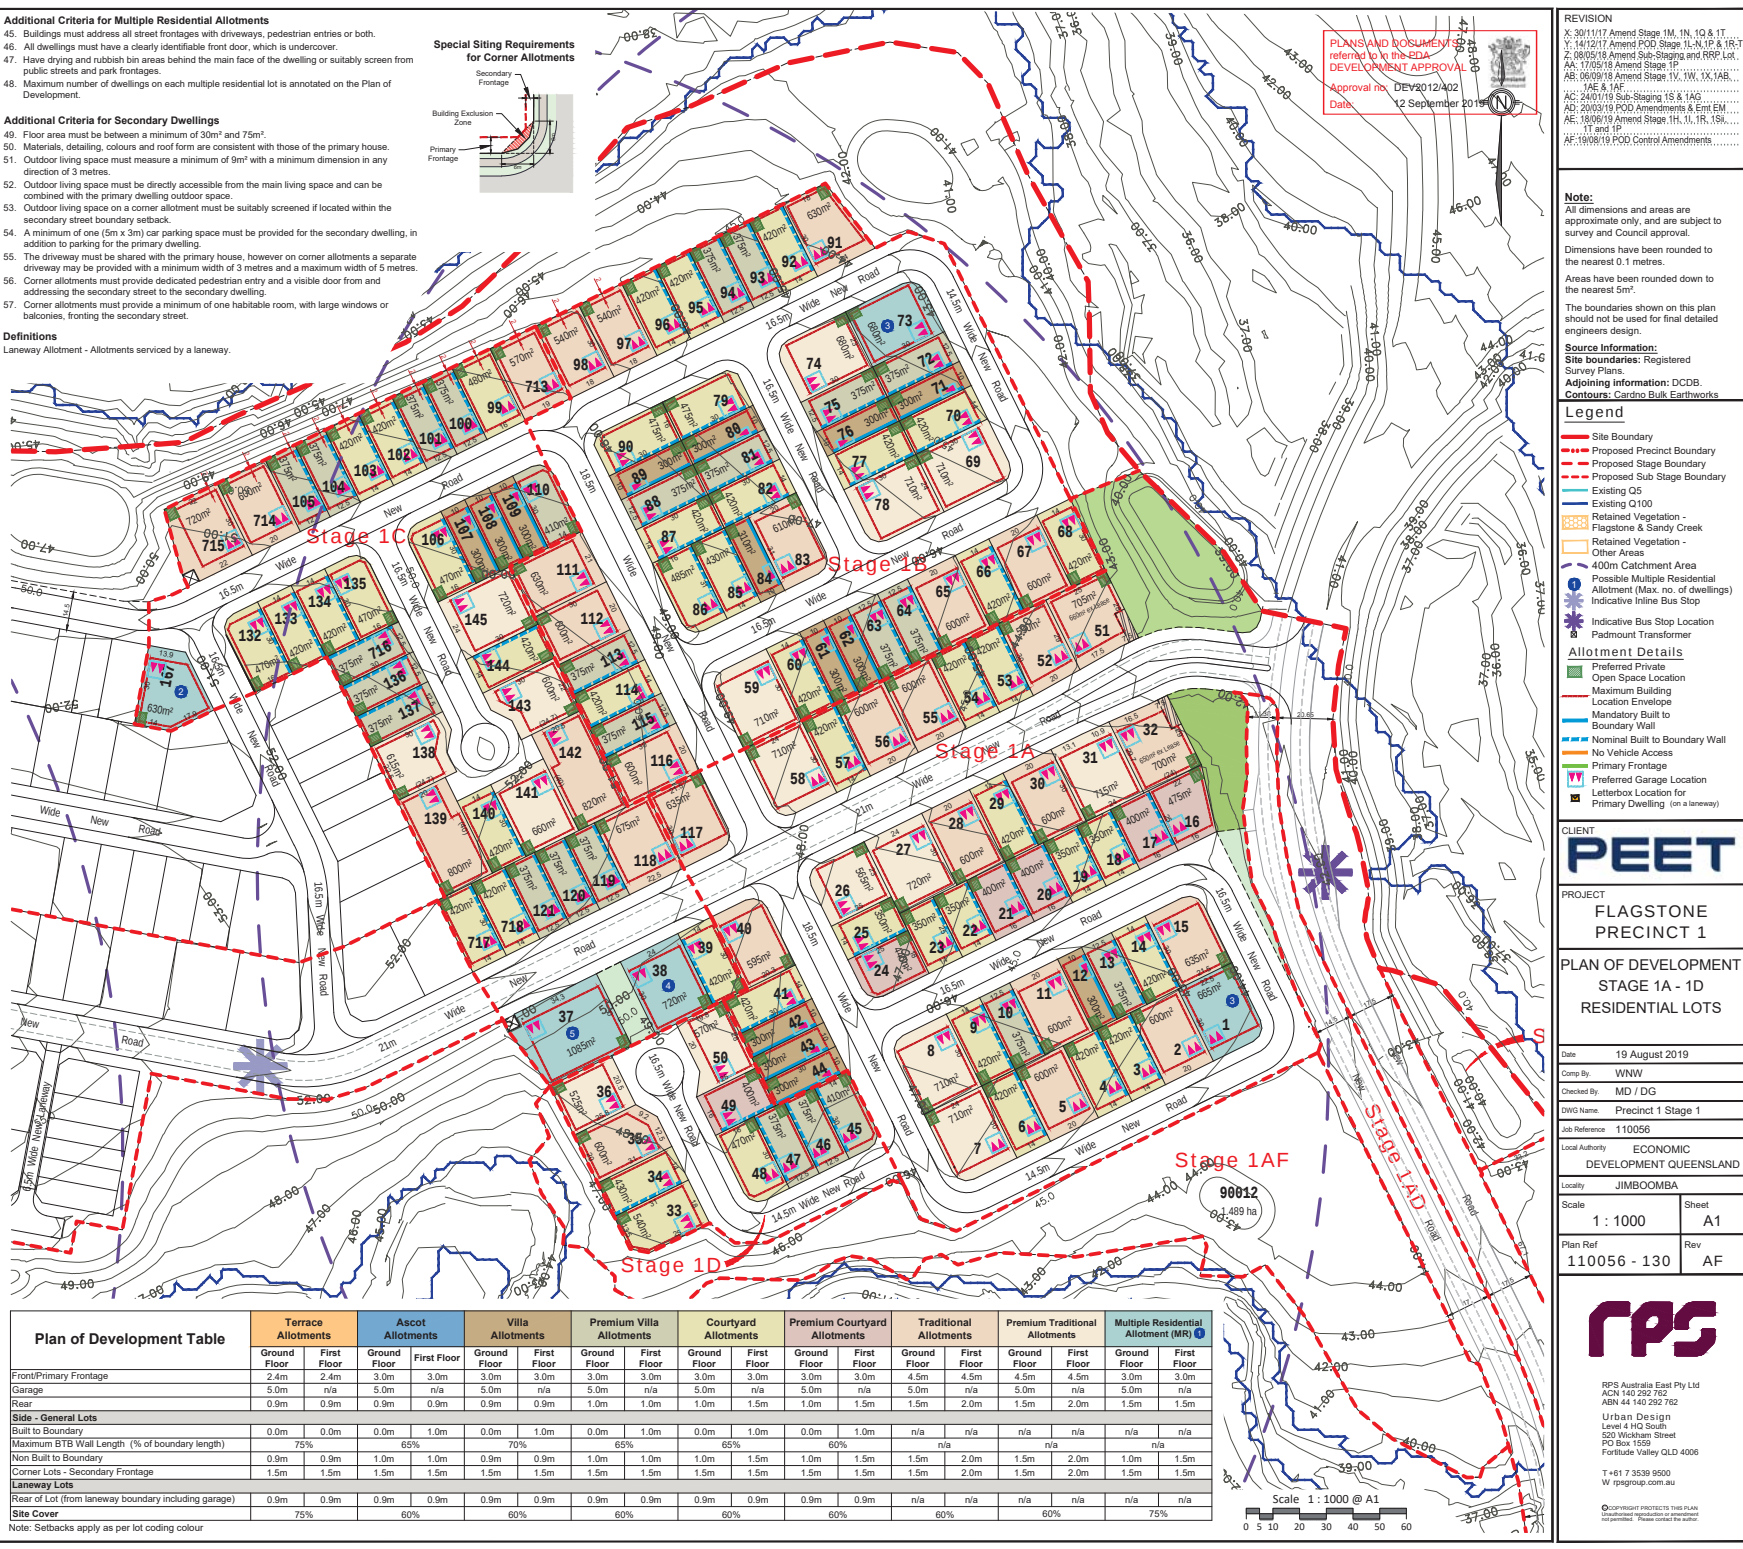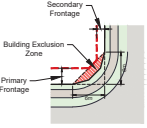

Plan of Development Table	Terrace Allotments		Ascot Allotments		Villa Allotments		Premium Villa Allotments		Courtyard Allotments		Premium Courtyard Allotments		Traditional Allotments		Premium Traditional Allotments		Multiple Residential Allotment (MR) 1	
	Ground Floor	First Floor	Ground Floor	First Floor	Ground Floor	First Floor	Ground Floor	First Floor	Ground Floor	First Floor	Ground Floor	First Floor	Ground Floor	First Floor	Ground Floor	First Floor	Ground Floor	First Floor
Built to Boundary	0.0m	0.0m	0.0m	1.0m	0.0m	1.0m	0.0m	1.0m	0.0m	1.0m	0.0m	1.0m	n/a	n/a	n/a	n/a	n/a	n/a
Maximum STB Wall Length (% of boundary length)	75%		65%		70%		65%		65%		60%		n/a	n/a	n/a	n/a	n/a	n/a
Non Built to Boundary	0.9m	0.9m	1.0m	1.0m	0.9m	0.9m	1.0m	1.0m	1.0m	1.5m	1.0m	1.5m	1.5m	2.0m	1.5m	2.0m	1.0m	1.5m
Corner Lots - Secondary Frontage	1.5m	1.5m	1.5m	1.5m	1.5m	1.5m	1.5m	1.5m	1.5m	1.5m	1.5m	1.5m	1.5m	2.0m	1.5m	2.0m	1.5m	1.5m
Laneway Lots																		
Rear of Lot (from laneway boundary including garage)	0.9m	0.9m	0.9m	0.9m	0.9m	0.9m	0.9m	0.9m	0.9m	0.9m	0.9m	0.9m	0.9m	n/a	n/a	n/a	n/a	n/a
Site Cover	75%		60%		60%		60%		60%		60%		60%		60%		75%	

Note: Setbacks apply as per lot coding colour

PLANS AND DOCUMENTS referred to in this EDA
DEVELOPMENT APPROVAL
Approval no. DEV2012/02
Date: 12 September 2019

REVISION

- X: 30/11/17 Amended Stage 1M, 1N, 1O & 1P

Note:

All dimensions and areas are approximate only, and are subject to survey and Council approval. Dimensions have been rounded to the nearest 0.1 metres. Areas have been rounded down to the nearest 5m².

The boundaries shown on this plan should not be used for final detailed engineering design.

Source Information:
Site boundaries: Registered Survey Plans.
Adjoining information: DCOB.
Contours: Carcho Bulk Earthworks

Legend

- Site Boundary
- Proposed Precinct Boundary
- Proposed Stage Boundary
- Proposed Sub Stage Boundary
- Existing Q100
- Retained Vegetation - Flagstone & Sandy Creek
- Retained Vegetation - Other
- 400m Catchment Area
- Possible Multiple Residential Allotment (Max. no. of dwellings)
- Indicative In-line Bus Stop
- Indicative Bus Stop Location
- Padmount Transformer

Allotment Details

- Preferred Private
- Open Space Location
- Maximum Building
- Location Envelope
- Mandatory Built to Boundary Wall
- Nominal Built to Boundary Wall
- No Vehicle Access
- Primary Frontage
- Preferred Garage Location
- Letterbox Location for Primary Dwelling (on a laneway)

CLIENT

PEET

PROJECT

FLAGSTONE PRECINCT 1

PLAN OF DEVELOPMENT
STAGE 1A - 1D
RESIDENTIAL LOTS

Date	19 August 2019
Comp By	WNW
Checked By	MD / DG
DWG Name	Precinct 1 Stage 1
Job Reference	110056
Local Authority	ECONOMIC DEVELOPMENT QUEENSLAND
Locality	JIMBOOMBA
Scale	1 : 1000
Sheet	A1
Plan Ref	110056 - 130
Rev	AF

RPS

RPS Australia East Pty Ltd
ACN 140 292 782
ABN 44 140 292 782
Urban Design
Level 4 HQ South
520 Wickham Street
Box 155
Fortitude Valley QLD 4006
T +61 7 3539 9500
W rpsgroup.com.au

© COPYRIGHT PROTECTED BY THIS PLAN
UNLAWFUL TO REPRODUCE OR TRANSMIT

Notes:

General

1. All development is to be undertaken in accordance with the Development Approval, and Queensland Development Code (QDC), except as varied below.
2. The maximum height of buildings shall not exceed two (2) storeys.
3. Maximum building location envelopes are subject to future proposed easements and/or other underground services.
4. All lots subject to an acoustic assessment to determine level of acoustic treatments.
5. Buildings shall be constructed in accordance with Bushfire AS3959.
6. Secondary dwellings are not permitted on lots less than 400m².
7. All lots (excluding multiple residential allotments) must contain a house.

Setbacks

8. Setbacks are as per the Plan of Development Table unless otherwise dimensioned. If a lot is not developed for a Multiple Residential (MR) site, then the equivalent size detached lot setbacks will apply.
9. The location of the built to boundary walls are indicated on the Plan of Development. Where built to boundary walls are not adopted site setbacks shall be in accordance with the Plan of Development Table.
10. Boundary setbacks are measured to the wall of the structure.
11. Front verandah and covered areas to the front door are permitted to extend into the front setback on the condition that the roofed area is not enclosed. For front setbacks, this roofed area can extend to 1.0m from the front property line.
12. Eaves cannot encroach (other than where buildings are built to boundary) closer than 450mm to the lot boundary.
13. Buildings to be sited in accordance with the 'Special Siting Requirements for Corner Allotments'.

Private Open Space

14. Private open space must measure a minimum of 10m² with a minimum dimension in any direction of 2.4 metres and must be uncovered (no roof).
15. Private open space must be directly accessible from a living space.

On-site car parking and driveways

16. On-site car parking is to be provided in accordance with the following minimum requirements:
 - For lots up to 12.49 metres wide - 1 covered space per dwelling;
 - For Ascot Allotments - 2 spaces per dwelling, one of which must be capable of being covered;
 - For lots 12.5 metres wide or greater - 2 covered spaces per dwelling;
 - For Multiple Residential sites, at least 1 covered space per dwelling, plus 0.5 spaces per dwelling (can be uncovered);
17. Garages for any single storey dwelling on a Lot between 10.0m and 12.49m in width must adhere to the following design criteria:
 - a. The front facing building wall, which comprises the garage door, must not exceed an external width of 5.7m

- b. The garage door:
 - i. Width must not exceed 4.8m
 - ii. Must have a minimum 450mm eave above it
 - iii. Must be setback a minimum of 240mm behind the pillar of the garage door, and
 - iv. Must have a sectional, tilt or roller door.
 - c. The front facade of the dwelling must be forward of the alignment of the garage wall, and must include the following:
 - i. A front entrance door with glass inserts and / or windows or with a sideglaze where the front door is solid. If the front facade includes a habitable room with window, a sideglaze is not required.
 - ii. A front verandah, portico or porch located over the front entrance, which extends a minimum of 1600mm forward of the entrance door
 - iii. The verandah, portico or porch is to include front piers with distinct materials and/or colours.
 - d. Driveways cannot exceed 3.0m across the verge on Lots between 10.0m and 12.49m wide.
18. Double car garages are permitted on any double storey dwelling or laneway dwelling built on a Lot between 10.0m and 12.49m.
 19. Driveways are to accord with Logan City Council's (LCC) standards. Prior to construction, approval from LCC for Vehicular Access to Residential Premises is required.
 20. The maximum width of a driveway at the lot boundary shall be 4.8 metres for a lot with a double car width garage and 3.0 metres for a lot with a single car width garage.
 21. Garages and carports accessed from a Laneway must be built setback 0.9 metres from the boundary. Ingress/egress must be achieved for a B99 Vehicle.
 22. Maximum of one driveway per dwelling unless it is a MR lot.
 23. Minimum distance of a driveway from an intersection of one street with another street is 6.0 metres. The Driveway must be laid at the grade of the adjacent verge area. No grade changes to the verge for the driveway will be allowed.
 24. Where there is a footpath within the verge, the footpath should be cut at the nearest joint and the footpath reinstated to the driveway without compromising the structural integrity of the footpath.
 25. Driveways must be completed prior to occupation of the dwelling.

Fencing

26. Fencing erected by PEET must not be altered, modified or removed without prior written approval from PEET.
27. Fencing on all park or street frontages has a maximum height of 1.2metres where solid or have a maximum height of 1.8 metres where containing openings that make the fence more than 50% transparent.
28. Fencing on all park or street frontages is constructed with visible posts, which are at least 120mm x 120mm and 100mm higher than the infill panels or panels.
29. Fencing on lanes can be screen fencing at 1.8m high where along private open space, carparking and service areas.
30. Fencing on corner lots is to be designed as front fences addressing both streets (rather than a front and a side fence).
31. Notwithstanding the above, solid front fences walls may be 1.8 metres in height if the dwelling has a frontage to a street with traffic volumes in excess of, or projected to exceed, 10,000 vehicles per day.
32. Retaining walls must not exceed more than 1.0 metres where fronted to a public street or park. Retaining walls to side and rear boundaries (which are not adjoining a public street or park) can be up to 2.0 metres. Retaining in excess of this must use terraced retaining.

Plan of Development Table	Terrace Allotments		Ascot Allotments		Villa Allotments		Premium Villa Allotments		Courtyard Allotments		Premium Courtyard Allotments		Traditional Allotments		Premium Traditional Allotments		Multiple Residential Allotment (MR) 1	
	Ground Floor	First Floor	Ground Floor	First Floor	Ground Floor	First Floor	Ground Floor	First Floor	Ground Floor	First Floor	Ground Floor	First Floor	Ground Floor	First Floor	Ground Floor	First Floor	Ground Floor	First Floor
Front/Primary Frontage	2.4m	2.4m	3.0m	3.0m	3.0m	3.0m	3.0m	3.0m	3.0m	3.0m	3.0m	3.0m	3.0m	3.0m	3.0m	3.0m	3.0m	3.0m
Garage	5.0m	n/a	5.0m	n/a	5.0m	n/a	5.0m	n/a	5.0m	n/a	5.0m	n/a	5.0m	n/a	5.0m	n/a	5.0m	n/a
Rear	0.9m	0.9m	0.9m	0.9m	0.9m	0.9m	1.0m	1.0m	1.0m	1.5m	1.0m	1.5m	1.5m	2.0m	1.5m	2.0m	1.5m	1.5m
Side - General Lots																		
Built to Boundary	0.0m	0.0m	0.0m	1.0m	0.0m	1.0m	0.0m	1.0m	0.0m	1.0m	0.0m	1.0m	0.0m	1.0m	n/a	n/a	n/a	n/a
Maximum BTB Wall Length (% of boundary length)	75%		65%		70%		65%		65%		60%		n/a		n/a		n/a	
Non Built to Boundary	0.9m	0.9m	1.0m	1.0m	0.9m	0.9m	1.0m	1.0m	1.0m	1.5m	1.0m	1.5m	2.0m	1.5m	2.0m	2.0m	1.0m	1.5m
Corner Lots - Secondary Frontage	1.5m	1.5m	1.5m	1.5m	1.5m	1.5m	1.5m	1.5m	1.5m	1.5m	1.5m	1.5m	1.5m	2.0m	1.5m	2.0m	1.5m	1.5m
Laneway Lots																		
Rear of Lot (from laneway boundary including garage)	0.9m	0.9m	0.9m	0.9m	0.9m	0.9m	0.9m	0.9m	0.9m	0.9m	0.9m	0.9m	n/a	n/a	n/a	n/a	n/a	n/a
Site Cover	75%		60%		60%		60%		60%		60%		60%		60%		75%	

Note: Setbacks apply as per lot coding colour

AMENDED IN RED


By: Marissa Bais

Date: 12 September 2019



Lot 695, Lot 696 and Lot 697 have 3m setback to front wall only

Special Siting Requirements for Corner Allotments

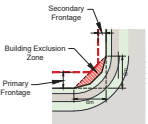

Additional Criteria for Multiple Residential Allotments

43. Buildings must address all street frontages with driveways, pedestrian entries or both.
44. All dwellings must have a clearly identifiable front door, which is undercover.
45. Have drying and rubbish bin areas behind the main face of the dwelling or suitably screen from public streets and park frontages.
46. Maximum number of dwellings on each multiple residential lot is annotated on the Plan of Development.

Additional Criteria for Secondary Dwellings

47. Floor area must be between a minimum of 30m² and 75m².
48. Materials, detailing, colours and roof form are consistent with those of the primary house.
49. Outdoor living space must measure a minimum of 8m² with a minimum dimension in any direction of 3 metres.
50. Outdoor living space must be directly accessible from the main living space and can be combined with the primary dwelling outdoor space.
51. Outdoor living space on a corner allotment must be suitably screened if located within the secondary street boundary setback.
52. A minimum of one (6m x 3m) car parking space must be provided for the secondary dwelling, in addition to parking for the primary dwelling.
53. The driveway must be shared with the primary house, however on corner allotments a separate driveway may be provided with a minimum width of 3 metres and a maximum width of 5 metres.
54. Corner allotments must provide dedicated pedestrian entry and a visible door from and addressing the secondary street to the secondary dwelling.
55. Corner allotments must provide a minimum of one habitable room, with large windows or balconies, fronting the secondary street.

Definitions

Laneway Allotment - Allotments serviced by a laneway.

REVISION

- X: 30/11/17 Amend Stage 1M, 1N, 1Q & 1T
- X: 14/12/17 Amend PDD Stage 1N, 1P & 1R
- Z: 08/05/18 Amend Sub-Staging and RRP Lot
- AA: 17/05/18 Amend Stage 1P
- AB: 06/05/18 Amend Stage 1N, 1V, 1X, 1Y, 1Z
- AE & 1AF
- AC: 24/01/19 Sub-Staging 1S & 1AG
- AD: 20/03/19 PDD Amendments & End Eas
- AE: 18/06/19 Amend Stage 1H, 1I, 1J, 1R, 1S, 1T and 1P
- AF: 18/09/19 PDD Control Amendments

Note:

All dimensions and areas are approximate only and are subject to survey and Council approval.

Dimensions have been rounded to the nearest 0.1 metres.

Areas have been rounded down to the nearest 5m².

The boundaries shown on this plan should not be used for final detailed engineers design.

Source Information:
Site boundaries: Registered Survey Plans
Adjoining information: DCCB, Contours: Cardno Bulk Earthworks

Legend

- Site Boundary
- Proposed Precinct Boundary
- Proposed Stage Boundary
- Proposed Sub Stage Boundary
- Entry Statements - Lease
- Retained Vegetation - Flagstone & Sandy Creek
- Retained Vegetation - Other Areas
- 400m Catchment Area
- Possible Multiple Residential Allotment (Max. no. of dwellings)
- Indicative Bus Stop Location
- Allotment Details
 - Preferred Private Open Space Location
 - Maximum Building Location Envelope
 - Mandatory Built to Boundary Wall
 - Nominal Built to Boundary Wall
 - No Vehicle Access
 - Primary Frontage
 - Preferred Garage Location
 - Letterbox Location for Primary Dwelling (on a laneway)

CLIENT

PEET

PROJECT

FLAGSTONE PRECINCT 1

PLAN OF DEVELOPMENT

STAGE 1K - 1M & 10, 1R - S

RESIDENTIAL LOTS

Date: 19 August 2019

Comp By: WNW

Checked By: MD / DG

DWG Name: Precinct 1 Stage 1

Job Reference: 110056

Local Authority: ECONOMIC DEVELOPMENT QUEENSLAND

Locality: JIMBOOMBA

Scale: 1 : 1000

Sheet: A1

Plan Ref: 110056 - 132

Rev: AF

Scale: 1 : 1000 @ A1

Scale: 0 5 10 20 30 40 50 60



Notes:

General:

1. All development is to be undertaken in accordance with the Development Approval, and Queensland Development Code (QDC), except as varied below.
2. The maximum height of buildings shall not exceed two (2) storeys.
3. Maximum building location envelopes are subject to future proposed easements and/or other underground services.
4. All lots subject to an acoustic assessment to determine level of acoustic treatments.
5. Buildings shall be constructed in accordance with Bushfire AS3959.
6. Secondary dwellings are not permitted on lots less than 400m².
7. All lots (excluding multiple residential allotments) must contain a house.

Setbacks:

1. Setbacks are as per the Plan of Development Table unless otherwise dimensioned. If a lot is not developed for a Multiple Residential (MR) site, then the equivalent size detached lot setbacks will apply.
2. The location of the built to boundary walls are indicated on the Plan of Development. Where built to boundary walls are not adopted site setbacks shall be in accordance with the Plan of Development Table.
3. Boundary setbacks are measured to the wall of the structure.
4. Front verandah and covered areas to the front door are permitted to extend into the front setback on the condition that the roofed area is not enclosed. For front setbacks, this roofed area can extend to 1.0m from the front property line.
5. Eaves cannot encroach (other than where buildings are built to boundary) closer than 450mm to the lot boundary.
6. Buildings to be sited in accordance with the 'Special Siting Requirements for Corner Allotments'.

Private Open Space

14. Private open space must measure a minimum of 10m² with a minimum dimension in any direction of 2.4 metres and must be uncovered (no roof).
15. Private open space must be directly accessible from a living space.

On-site car parking and driveways

16. On-site car parking is to be provided in accordance with the following minimum requirements:
 - For lots up to 12.49 metres wide - 1 covered space per dwelling;
 - For Ascot Allotments - 2 spaces per dwelling, one of which must be capable of being covered;
 - For lots 12.5 metres wide or greater - 2 covered spaces per dwelling;
 - For Multiple Residential sites, at least 1 covered space per dwelling, plus 0.5 spaces per dwelling (can be uncovered);
17. Garages for any single storey dwelling on a Lot between 10.0m and 12.49m in width must adhere to the following design criteria:
 - a. The front facing building wall, which comprises the garage door, must not exceed an external width of 5.7m
 - b. The garage door:
 - i. Width must not exceed 4.8m
 - ii. Must have a minimum 450mm eave above it
 - iii. Must be setback a minimum of 240mm behind the pillar of the garage door, and
 - iv. Must have a sectional, tilt or roller door.
 - c. The front facade of the dwelling must be forward of the alignment of the garage wall, and must include the following:
 - i. A front entrance door with glass inserts and / or windows or with a side light where the front door is solid. If the front facade includes a habitable room with window, a side light is not required.
 - ii. A front verandah, portico or porch located over the front entrance, which extends a minimum of 1600mm forward of the entrance door
 - iii. The verandah, portico or porch is to include front steps with distinct materials and/or colours.
 - d. Driveways cannot exceed 3.0m across the verge on Lots between 10.0m and 12.49m wide.
18. Double car garages are permitted on any double storey dwelling or laneway dwelling built on a Lot between 10.0m and 12.49m.
19. Driveways are to be in accordance with Logan City Council's (LCC) standards. Prior to construction, approval from LCC for Vehicular Access to Residential Premises is required.
20. The maximum width of a driveway at the lot boundary shall be 4.8 metres for a lot with a double car width garage and 3.0 metres for a lot with a single car width garage.
21. Garages and carports accessed from a Laneway must be built setback 0.9 metres from the boundary. Ingress/egress must be achieved for a B99 Vehicle.
22. Maximum of one driveway per dwelling unless it is a MR lot.
23. Minimum distance of a driveway from an intersection of one street with another street is 6.0 metres. This driveway must be laid at the grade of the adjacent verge area. No grade changes to the verge for the driveway will be allowed.
24. Where there is a footpath within the verge, the footpath should be cut at the nearest joint and the footpath reinstated to the driveway without compromising the structural integrity of the footpath.
25. Driveways must be completed prior to occupation of the dwelling.

Fencing

26. Fencing erected by Peet must not be altered, modified or removed without prior written approval from Peet.
27. Fencing on all park or street frontages has a maximum height of 1.2metres where solid or have a maximum height of 1.8 metres where containing openings that make the fence more than 50% transparent.
28. Fencing on all park or street frontages is constructed with visible posts, which are at least 120mm x 120mm and 100mm higher than the infill railings or panels.
29. Fencing on lanes can be screen fencing at 1.8m high where along private open space, carparking and service areas.
30. Fencing on corner lots is to be designed as front fences addressing both streets (rather than a front and a side fence).
31. Notwithstanding the above, solid front fences and walls may be 1.8 metres in height if the dwelling has a frontage to a street with traffic volumes in excess of or projected to exceed, 10,000 vehicles per day.
32. Retaining walls must not exceed more than 1.0 metres where fronted to a public street or park. Retaining walls to side and rear boundaries (which are not adjoining a public street or park) can be up to 2.0 metres. Retaining in excess of this must use terraced retaining.
33. No timber retaining walls over 1.0m or adjoining parks or public streets.
34. Walls over 1.0m require RPEQ certification.

Building Articulation

35. All buildings with a width of more than 10 metres that are visible from a street or park are to include articulation to reduce the mass of the building by one or more of the following:
 - Windows recessed into the facade or bay windows;
 - Balconies, porches or verandahs;
 - Articulation of roof lines
 - Window hoods; and/or
 - Use of multiple cladding materials
- Buildings that do not comply may be assessed on architectural merit when accompanied by a report from a Registered Architect
36. Carports and garages are to be compatible with the main building design in terms of height, roof form, detailing, materials and colours.
37. All building materials must be suitably coloured, stained or painted, including retaining, fences, walls and roofs. Untreated materials, such as zinc coated steel, bare metal, concrete block or masonry panels, are not permitted.
38. Air-conditioners, gas bottles, hot water systems, clothes lines and other household services must be screened and/or located to minimise visual impact to public streets or parks.
39. Homes must include a clearly identifiable and addressed front door and undercover cover point of entry.
40. Screened drying and rubbish bins areas must be behind the main face of the dwelling.
41. At least two openings to all habitable rooms to facilitate cross flow ventilation are required.

Slope and Building Footings

42. Buildings on sloping sites, must be built to the boundary on the low side of the lot and the footing must be projected deep enough to be below the adjoining property building pad level.
43. If the nominated pad level is not provided, the pad level is to be assumed as the average of the four corners of the adjacent block, using the as constructed levels.
44. Building footings are to be designed in accordance with the appropriate Australian Standard. Building footings are to be designed to ensure that there are no adverse impacts (functional, financial or construction limitations) on adjoining allotments, particularly in relation to retaining walls.

Additional Criteria for Multiple Residential Allotments

45. Buildings must address all street frontages with driveways, pedestrian entries or both.
46. All dwellings must have a clearly identifiable front door, which is undercover.
47. Have drying and rubbish bin areas behind the main face of the dwelling or suitably screen from public streets and park frontages.
48. Maximum number of dwellings on each multiple residential lot is annotated on the Plan of Development.


Additional Criteria for Secondary Dwellings

49. Floor area must be between a minimum of 30m² and 75m².
50. Materials, detailing, colours and roof form are consistent with those of the primary house.
51. Outdoor living space must measure a minimum of 9m² with a minimum dimension in any direction of 3 metres.
52. Outdoor living space must be directly accessible from the main living space and can be combined with the primary dwelling outdoor space.
53. Outdoor living space on a corner allotment must be suitably screened if located within the secondary street boundary setback.
54. A minimum of one (9m x 3m) car parking space must be provided for the secondary dwelling, in addition to parking for the primary dwelling.
55. The driveway must be shared with the primary house, however on corner allotments a separate driveway may be provided with a minimum width of 3 metres and a maximum width of 5 metres.
56. Corner allotments must provide dedicated pedestrian entry and a visible door from and addressing the secondary street to the secondary dwelling.
57. Corner allotments must provide a minimum of one habitable room, with large windows or balconies, fronting the secondary street.

Definitions

Laneway Allotment - Allotments serviced by a laneway.

Special Siting Requirements for Corner Allotments

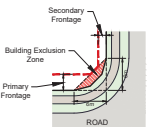

PLANS AND DOCUMENTS referred to in the PDA DEVELOPMENT APPROVAL
Approval no: DEV2012/402
Date: 12 September 2019

Plan of Development Table

	Terrace Allotments		Ascot Allotments		Villa Allotments		Premium Villa Allotments		Courtyard Allotments		Premium Courtyard Allotments		Traditional Allotments		Premium Traditional Allotments		Multiple Residential (MR) ①	
	Ground Floor	First Floor	Ground Floor	First Floor	Ground Floor	First Floor	Ground Floor	First Floor	Ground Floor	First Floor	Ground Floor	First Floor	Ground Floor	First Floor	Ground Floor	First Floor	Ground Floor	First Floor
Front/Primary Frontage	2.4m	2.4m	3.0m	3.0m	3.0m	3.0m	3.0m	3.0m	3.0m	3.0m	3.0m	3.0m	4.5m	4.5m	4.5m	4.5m	3.0m	3.0m
Garage	5.0m	n/a	5.0m	n/a	5.0m	n/a	5.0m	n/a	5.0m	n/a	5.0m	n/a	5.0m	n/a	5.0m	n/a	5.0m	n/a
Rear	0.9m	0.9m	0.9m	0.9m	0.9m	0.9m	1.0m	1.0m	1.0m	1.5m	1.0m	1.5m	1.5m	2.0m	1.5m	2.0m	1.5m	1.5m
Side - General Lots																		
Built to Boundary	0.0m	0.0m	0.0m	1.0m	0.0m	0.0m	0.0m	1.0m	0.0m	1.0m	0.0m	1.0m	0.0m	n/a	n/a	n/a	n/a	n/a
Maximum EFTB Wall Length (% of boundary length)	75%			65%		70%		65%		65%		60%		n/a	n/a	n/a	n/a	n/a
Non Built to Boundary	0.9m	0.9m	1.0m	1.0m	0.9m	0.9m	1.0m	1.0m	1.0m	1.5m	1.0m	1.5m	1.5m	2.0m	1.5m	2.0m	1.0m	1.5m
Corner Lots - Secondary Frontage	1.5m	1.5m	1.5m	1.5m	1.5m	1.5m	1.5m	1.5m	1.5m	1.5m	1.5m	1.5m	1.5m	2.0m	1.5m	2.0m	1.5m	1.5m
Laneway Lots																		
Rear of Lot (from laneway boundary including garage)	0.9m	0.9m	0.9m	0.9m	0.9m	0.9m	0.9m	0.9m	0.9m	0.9m	0.9m	0.9m	n/a	n/a	n/a	n/a	n/a	n/a
Site Cover																		
	75%			60%		60%		60%		60%		60%		60%		60%		75%

Note: Setbacks apply as per lot coding colour

REVISION
X: 30/11/17 Amended Stage 1M, 1N, 1Q & 1T
Y: 30/12/17 Amended Stage 1P, 1Q, 1R & 1S
Z: 08/05/18 Amended Sub-Staging and RRP Lot
AA: 17/05/18 Amended Stage 1P
AB: 06/06/18 Amended Stage 1N, 1Q, 1R, 1S, 1T & 1U
AC: 24/01/19 Sub-Staging 1S & 1AG
AD: 20/03/19 VCO Amended Stage 1P
AE: 18/06/19 Amended Stage 1H, 1I, 1R, 1S, 1T & 1U
AF: 18/06/19 VCO Control Amended

Note:
All dimensions and areas are approximate only, and are subject to survey and Council approval.
Dimensions have been rounded to the nearest 0.1 metres.
Areas have been rounded down to the nearest 5m².
The boundaries shown on this plan should not be used for final detailed engineering design.
Source Information:
Site boundaries: Registered Survey Plans.
Adjoining information: DCCB.
Contours: Cadmus Bulk Earthworks

Legend

- Site Boundary
- Proposed Precinct Boundary
- Proposed Stage Boundary
- Proposed Sub Stage Boundary
- Existing OS
- Existing O/D
- Retained Vegetation - Flagstone & Sandy Creek
- Retained Vegetation - Other Areas
- 400m Catchment Area
- Possible Multiple Residential Allotment (Max. no. of dwellings)
- Indicative Bus Stop Location

Allotment Details

- Preferred Private Open Space Location
- Maximum Building Location Envelope
- Mandatory Built to Boundary Wall
- Nominal Built to Boundary Wall
- No Vehicle Access
- Primary Frontage
- Preferred Garage Location
- Letterbox Location (on a laneway)

CLIENT
PEET

PROJECT
FLAGSTONE PRECINCT 1

PLAN OF DEVELOPMENT
STAGE 1N, 1P, 1Q & 1T
RESIDENTIAL LOTS

Date: 19 August 2019
Comp By: WNW
Checked By: MD / DG
DWG Name: Precinct 1 Stage 1
Job Reference: 110056
Local Authority: ECONOMIC DEVELOPMENT QUEENSLAND
Locality: JIMBOOMBA
Scale: 1 : 1000
Sheet: A1
Plan Ref: 110056 - 133
Rev: AF

RPS

RPS Australia East Pty Ltd
ACN 140272752
ABN 44 140 292 752
Urban Design
Level 4 HQ South
520 Wickham Street
PO Box 1059
Fortitude Valley QLD 4006
T +61 7 3539 9500
W rpsgroup.com.au

© copyright reserved to the Plans copyright holder. All rights reserved.



Legend

General


- Site Boundary
- - - Proposed Precinct Boundary
- - - Proposed Super Stage Boundary
- - - Proposed Sub Stage Boundary
- 400m Catchment Area
- ★ Indicative Bus Stop Location
- Padmount Transformer

Open Space


- Regional Recreation Park
- Corridor Park
- Neighbourhood Recreation Park
- Local Recreation Park
- Local Linear Recreation Park
- Stormwater Detention
- Linear Connections
- Entry Statements

On-Street Parking

- Indicative Car Park Location
- Indicative 3.5m Wide Driveway

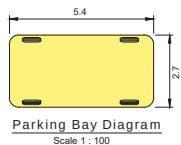

Parking Breakdown
 Total On-Street Visitor Parking Spaces Provided 611
 Total Residential Dwellings 749
 Total On-Street Visitor Parking Spaces Required 562
 (based on 0.75 per dwelling)

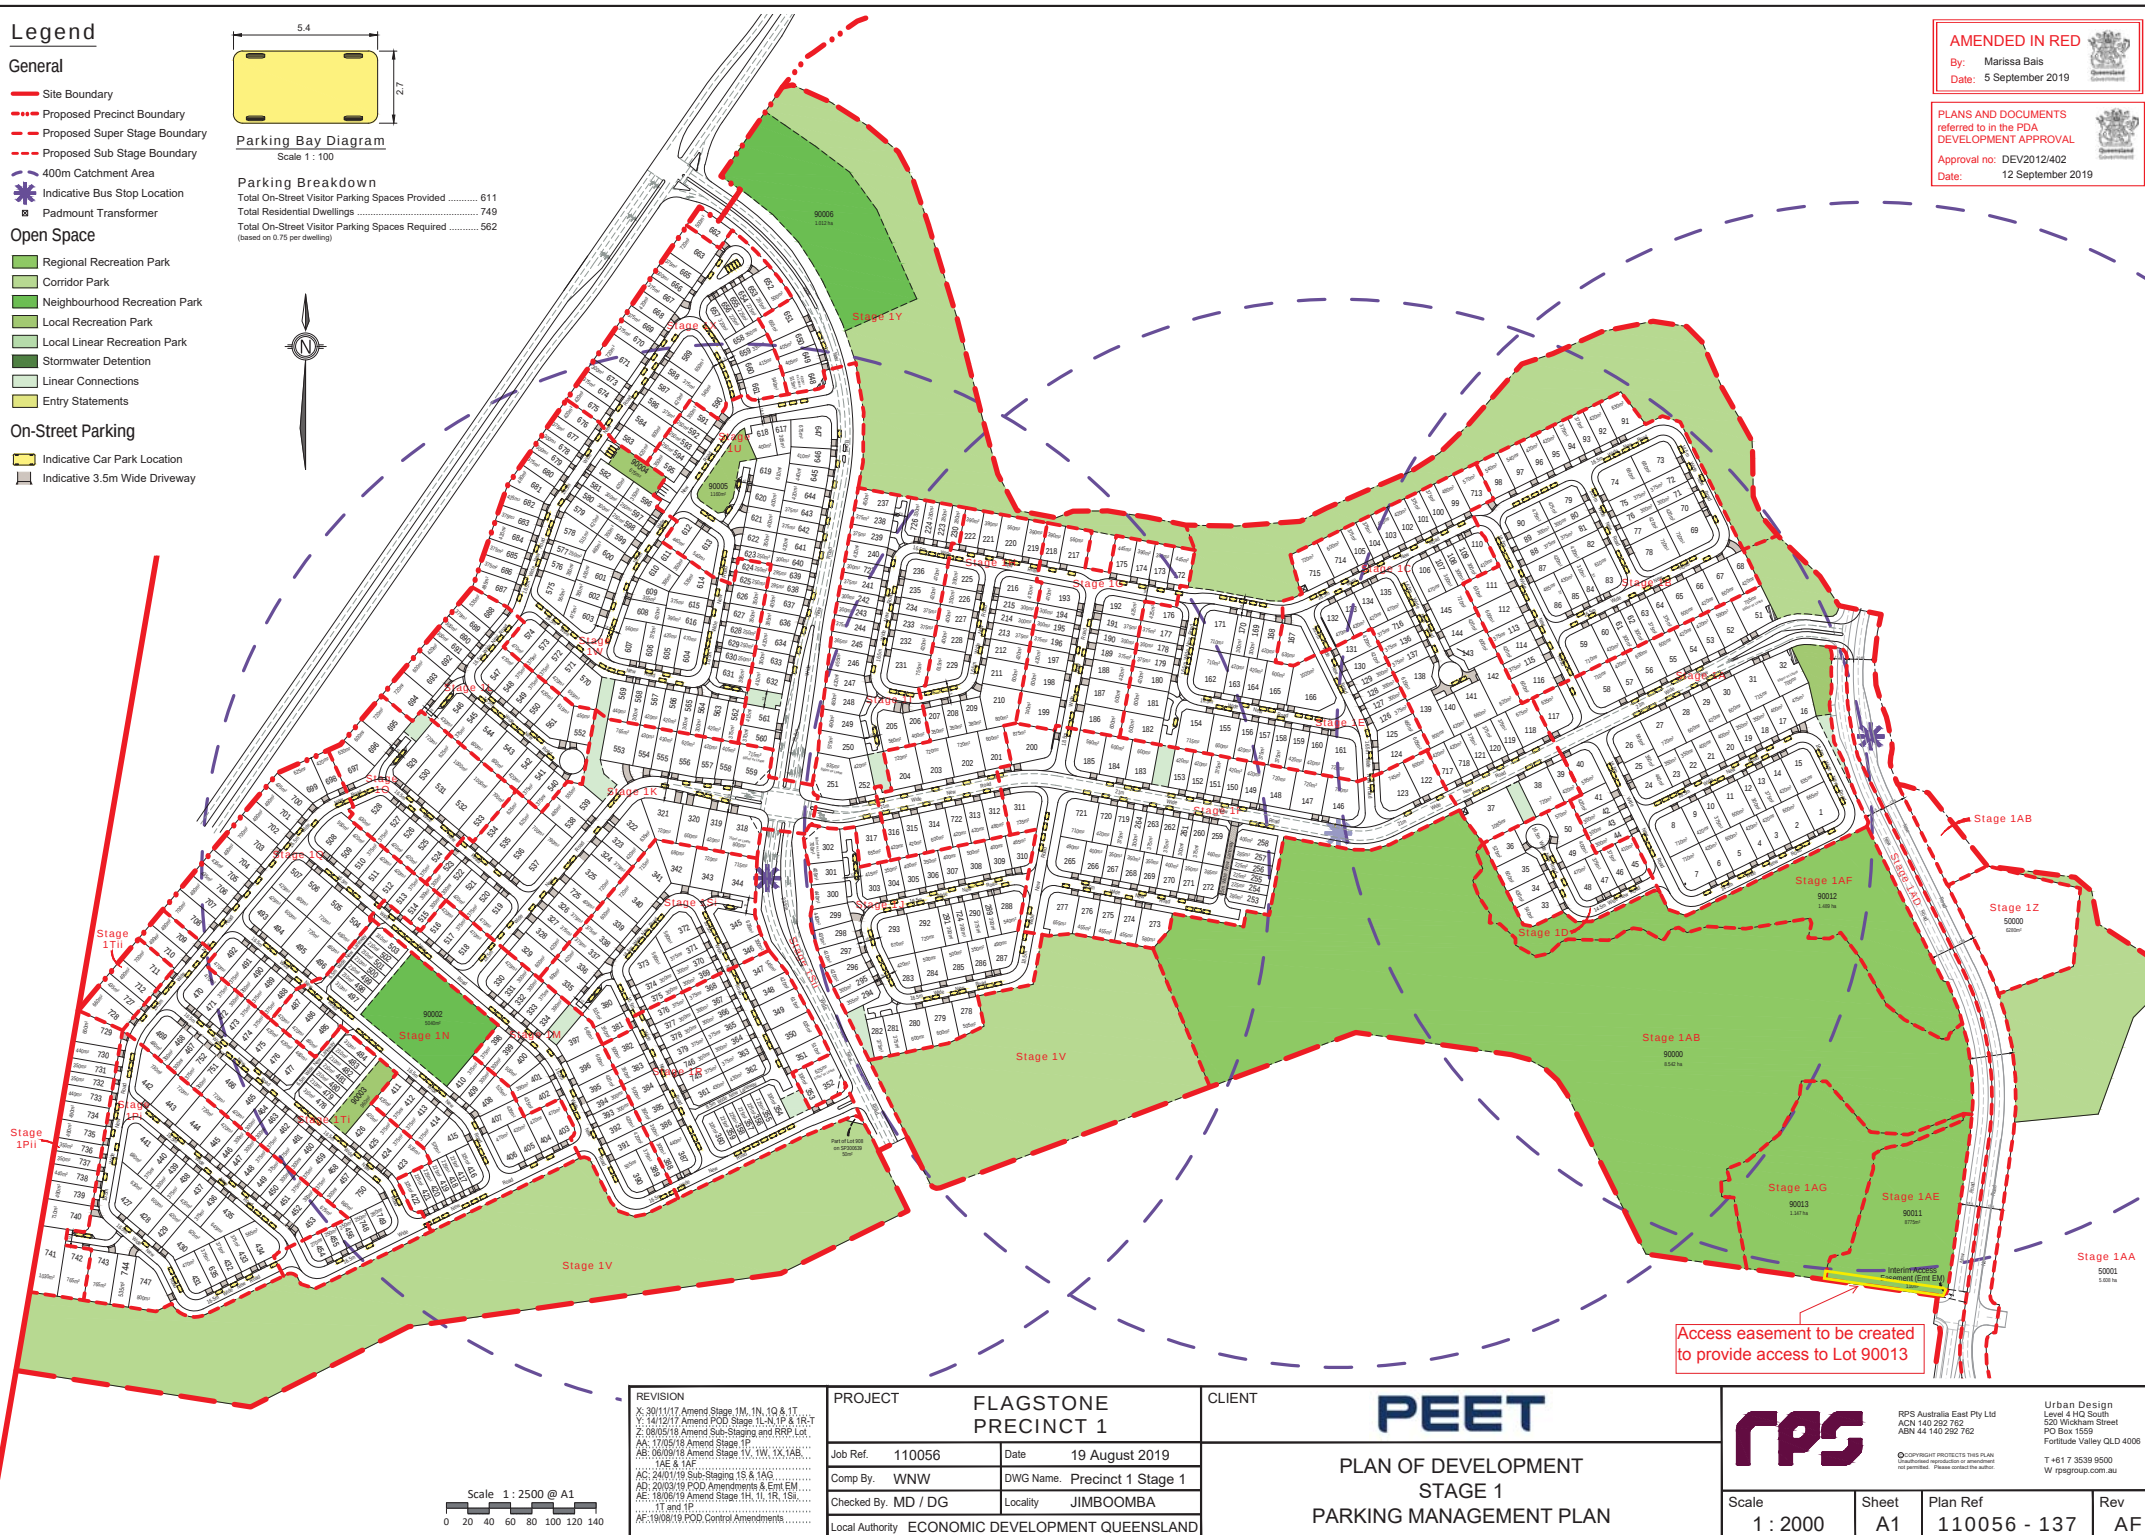

AMENDED IN RED

By: Marissa Bais
 Date: 5 September 2019

PLANS AND DOCUMENTS referred to in the PDA DEVELOPMENT APPROVAL

Approval no: DEV2012/402
 Date: 12 September 2019

REVISION X: 30/11/17 Amend Stage 1M, 1N, 1O & 1T Y: 14/12/17 Amend POD Stage 1L-N, 1P & 1R-T Z: 08/05/18 Amend Sub-Staging and RRP Lot AA: 17/05/18 Amend Stage 1P AB: 06/08/18 Amend Stage 1V, 1W, 1X, 1Y, 1Z AC: 24/07/19 Sub-Staging 1S & 1AG AD: 20/03/19 POD Amendments & Emt EM AE: 18/08/19 Amend Stage 1H, 1I, 1R, 1S, 1T and 1P AF: 19/08/19 POD Control Amendments	PROJECT FLAGSTONE PRECINCT 1	CLIENT 
	Job Ref. 110056 Date 19 August 2019	PLAN OF DEVELOPMENT STAGE 1 PARKING MANAGEMENT PLAN				
	Comp By. WNW DWG Name. Precinct 1 Stage 1					
	Checked By. MD / DG Locality JIMBOOMBA					
	Local Authority ECONOMIC DEVELOPMENT QUEENSLAND					
Scale 1 : 2000			Sheet A1	Plan Ref 110056 - 137	Rev AF	

Access easement to be created to provide access to Lot 90013

RPS Australia East Pty Ltd
 ACN 140 292 762
 ABN 44 140 292 762

© COPYRIGHT PROJECTS THIS PLAN
 Unauthorised reproduction or amendment
 not permitted. Please contact the author.

Urban Design
 Level 4 HQ South
 530 Wickham Street
 PO Box 1559
 Fortitude Valley QLD 4006
 T +61 7 3639 9500
 W rpsgroup.com.au