PROJECT NUMBER: BR210689
DATE: 05/10/22
MARKUP: KSD-2 Trunk Stormwater Augmentation Sketch
Sheet 1 of 2

AMENDED IN GREEN
By: Chris Hinton
Date: 18 October 2022

PLANS AND DOCUMENTS referred to in the PDA DEVELOPMENT APPROVAL
Approval no: DEV2022/1284
Date: 20 October 2022

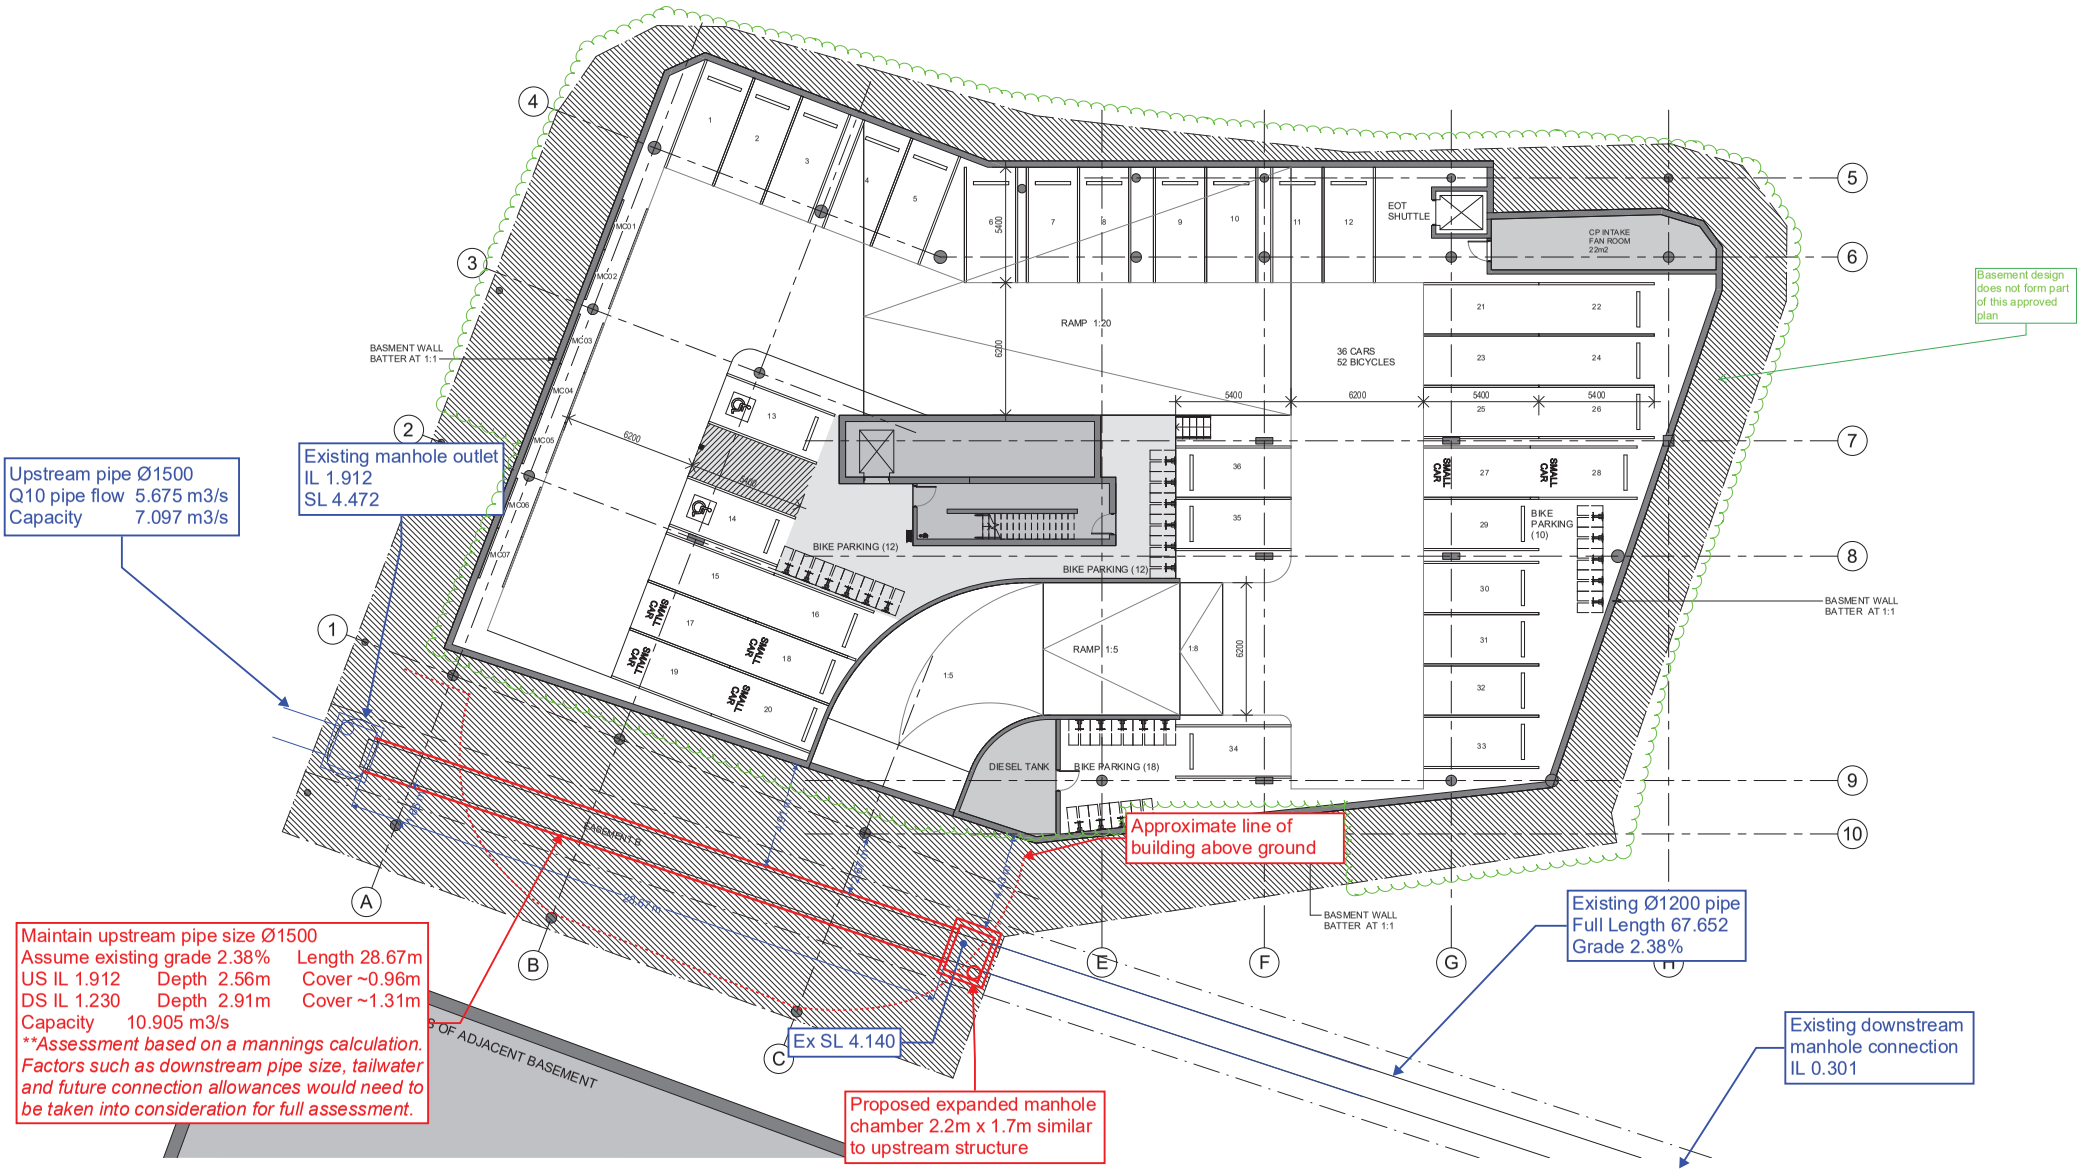

DEVELOPMENT APPLICATION
FURTHER ISSUES RESPONSE PACKAGE

Project: HAMILTON HARBOUR - KSD2
CRN KINGSFORD SMITH DRIVE & NORTHSHORE WAY
Drawing Title: BASEMENT

Scale: 1 : 125 @ A1
Date: 23/15/22
Revision: 24
Drawing Number: DA-03

Cox Architecture
www.coxarchitecture.com.au