


Cover Sheet

To be read concurrently with the approved
Vegetation Management Plan Version D.

For any inconsistencies within *Detail Sheets*
11, 12, 14, 15, 17, 18, 20, 21, and *Clearing*
Direction, the approved *Vegetation*
Management Version D prevails.

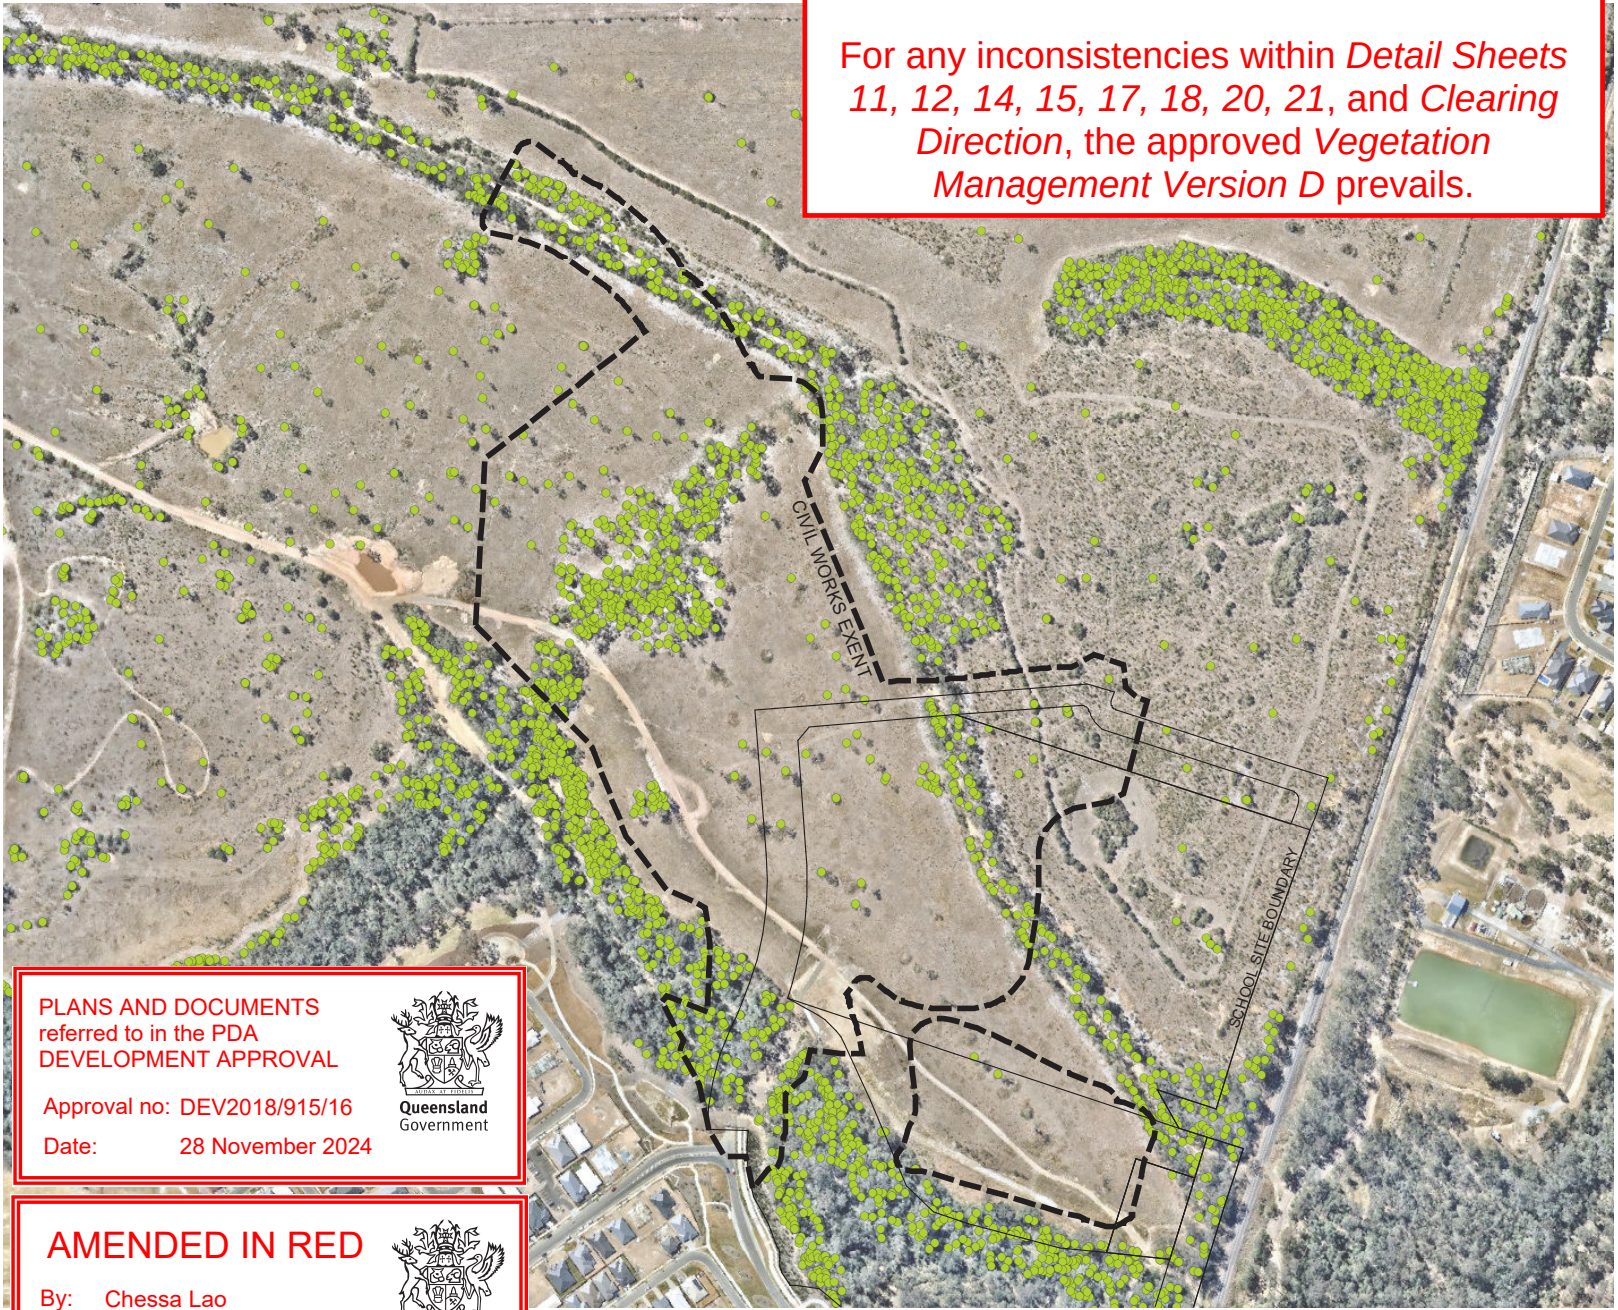

PLANS AND DOCUMENTS
referred to in the PDA
DEVELOPMENT APPROVAL

Approval no: DEV2018/915/16
Date: 28 November 2024



AMENDED IN RED

By: Chessa Lao
Date: 19 November 2024



Vegetation Management Plan

Version C

Stages 2 to 5 (Phase 1 & School Site)



by PEET Ltd

*Economic Development
Queensland*

CONTENTS
8047 E 02 Stage 2 VMP C -- Vegetation Clearing Notes
8047 E 03 Stage 2 VMP C -- Key Plan
8047 E 04-21 Stage 2 VMP C -- Detail Sheets
8047 E 22 Stage 2 VMP C -- Clearing Direction
Appendix A -- Tree Schedule

~~PLANS AND DOCUMENTS
referred to in the PDA
DEVELOPMENT APPROVAL~~

~~Approval no: DEV2018/915
Date: 3 August 2018~~



Key Site Contacts

Saunders Havill Group
Dr Andrew Davies
Phone: (07) 3251 9444
Email: andrewdavies@saundershavill.com



Vegetation Management Plan

Vegetation Clearing - Notes

INTRODUCTION

The *Environmental Management Division* of the **Saunders Havill Group** was engaged by **PEET Flagstone City** to prepare a *Vegetation Management Plan (VMP)* for the removal of vegetation for the first phase of operational works in stage 2-5 of Flagstone City project.

This VMP was drafted in response to the project's *Natural Environment Site Strategy's (NESS)* requirement for *VMPs*. The *VMP* will manage the vegetation clearing practices during operational work stages. The *VMP* will cover the first phase of clearing in the Stage 2-5 area of the project and correspond with the lodgement of the planning and civil applications for new roads, school site and space for surplus fill as a result of civil works. The clearing works will follow the general principal for vegetation clearing documented on this sheet.

To assist in the spatial depiction of the phase 1 clearing area and better allocate a tree retention and removal status, ecologists from the **Saunders Havill Group** completed a tree survey using Trimble Antenna based GPS units. The survey collected the following data on trees within and adjoining the phase 1 extent as provided by the project urban designer and engineer:

- Reference Point and Location
- Botanical Name / Common Name
- Trunk DBH
- AS4970-2009 – Tree Protection Zone

- Height and Spread
- Canopy and Trunk Condition Comments
- Fauna and Habitat Values and Details

Particular attention and detail was collected along Sandy Creek interface area to maximise the retention of healthy native habitat trees along the corridor.

CLEARING PHASES AND PROCESS

The following stages are required for clearing to be undertaken on this property and a copy of this *VMP* must be present with the clearing contractor on-site:

PHASE 1 – Demarcation

Tree Protection Fencing to be installed prior to the commencement of any clearing works on the site. Tree protection fencing is to be located at or beyond 12 x diameter at breast height (DBH) unless approved by an appointed Arborist around trees designated for retention or as per the locations shown in this drawing package (refer Fencing Note). Fencing shall clearly demark the extent of works ensuring no additional vegetation will be cleared.

PHASE 2 - Pre-start Meeting

Fencing shall be in place at the time of the official pre-start meeting for inspection by the Environmental Coordinator. A fauna spotter pre-works assessment report must be

carried out prior to the pre-start meeting and provided to the clearing contractor (Refer to *Fauna Management Plan* accompanying this application for details).


PHASE 4 - Undertake Clearing Works

Undertake removal of vegetation once approved for removal by the appointed fauna spotter. Clearing will occur in the direction outlined in *Fauna Management Plan* and managed by the appointed fauna spotter to allow all fauna unimpeded movement away from works areas. The contractor is to follow any tree felling directions of the appointed fauna spotter/arborist, including but not limited to, an excavator vertical tree grab attachment or cherry picker, where the use of bulldozer is not appropriate.

PHASE 5 - Post clearing Works

Cleared vegetation is to be reused on or off premises. Recycling techniques include mulching, tub-grinding, wood chipping and salvage (e.g. custom milling). Trees with identified hollows should have the hollow section preserved and this section should be suitably mounted on nearby or adjacent suitable trees.

Carry out assessment of all retained trees by a qualified arborist along the edge of development once civil works have been completed. Implement any tree management measures if advised by the arborist.

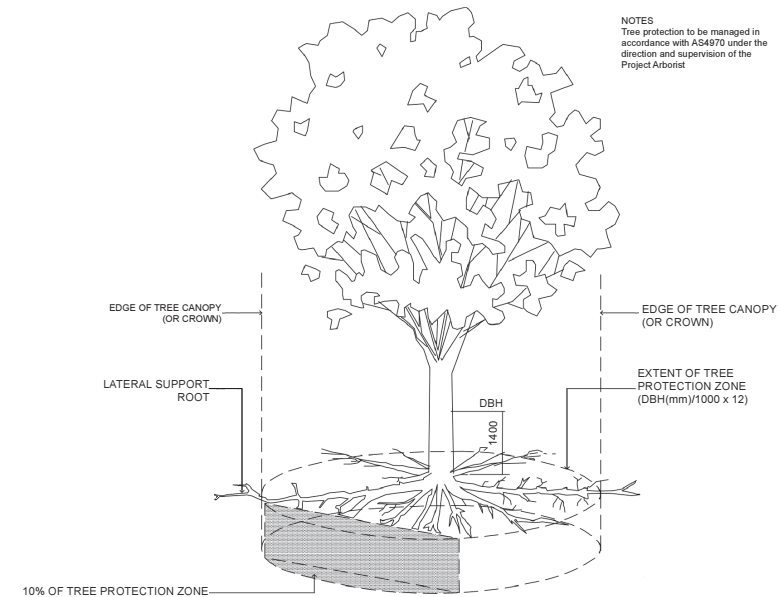

AMENDED IN RED

By: Chessa Lao
Date: 19 November 2024



PLANS AND DOCUMENTS
referred to in the PDA
DEVELOPMENT APPROVAL

Approval no: DEV2018/915
Date: 3 August 2018




PLANS AND DOCUMENTS
referred to in the PDA
DEVELOPMENT APPROVAL

Approval no: DEV2018/915/16
Date: 28 November 2024



Tree Protection Fencing Detail

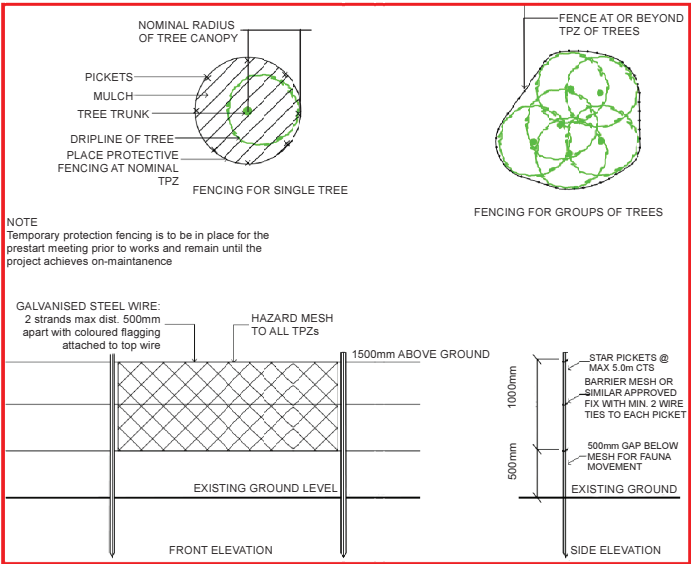

DISCLAIMER:

THESE PLANS HAVE BEEN PREPARED FOR THE EXCLUSIVE USE OF THE CLIENT. SAUNDERS HAVILL GROUP CANNOT ACCEPT RESPONSIBILITY FOR ANY USE OF OR RELIANCE UPON THE CONTENTS OF THESE DRAWINGS BY ANY OTHER PARTY.

CONFIRM ALL DIMENSIONS ON SITE PRIOR TO CONSTRUCTION AND DO NOT SCALE FROM THE DRAWINGS. ALL DIMENSIONS ARE IN METRES UNLESS OTHERWISE STATED. ANY DIMENSIONS SHOULD BE CLARIFIED IN WRITING WITH SAUNDERS HAVILL GROUP PRIOR TO THE COMMENCEMENT OF WORK.

PRIOR TO ANY DEMOLITION, EXCAVATION OR CONSTRUCTION ON SITE, THE RELEVANT AUTHORITY SHOULD BE CONTACTED FOR ANY OTHER RELEVANT SERVICES AND UTILITIES LOCATIONS FOR ALL SERVICES.

REFERENCES:

AMENDMENTS:

Issue	Date	Description	Checked
A	23/01/2018	Client Draft	AD
B	7/02/2018	Surplus fill area added	AD
C	19/06/2018	Civil extent amendments	AD

CLIENT:

PEET Limited

PROJECT:


Flagstone City - Stage 2-5
Phase 1 works



PLAN OF:

Vegetation
Management Plan

DATE: 19/06/2018	CHECKED: AD
JOB REF: 8047	DRAWN: TC
DRAWING No: 8047 E 02 Stage 2 VMP C	

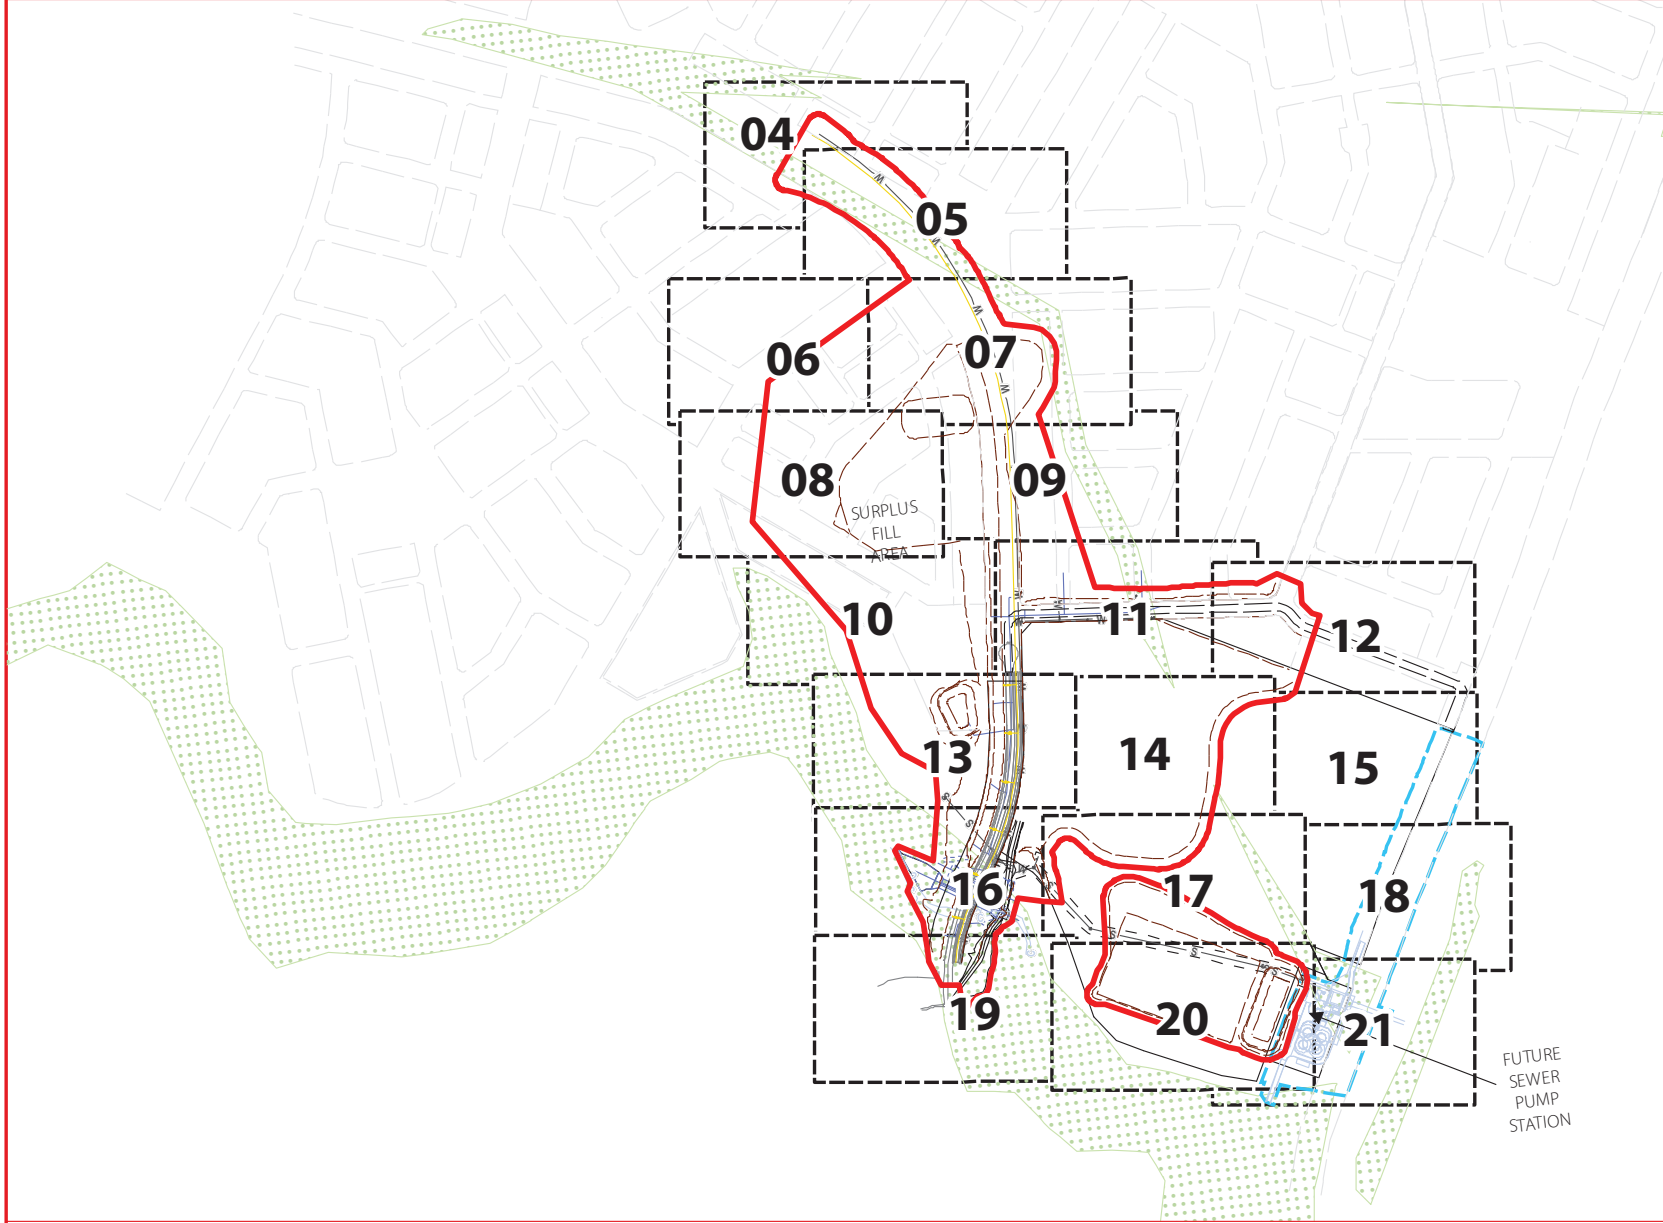

AMENDED IN RED

By: Chessa Lao
Date: 19 November 2024



PLANS AND DOCUMENTS
referred to in the PDA
DEVELOPMENT APPROVAL

Approval no: DEV2018/915/16
Date: 28 November 2024



~~PLANS AND DOCUMENTS
referred to in the PDA
DEVELOPMENT APPROVAL~~

~~Approval no: DEV2018/915
Date: 3 August 2018~~




Legend

- Stage 2-5 phase 1 & school site works (including additional 10m vegetation clearing for construction access)
- School lot & road layout
- Civil road design
- Trunk sewer
- Temporary waterway crossing track
- Civil storm water design/culvert design
- Civil electrical/lighting design
- Batter top/toe
- Civil design contours
- Separate application area for LWIA Sewer pump station
- LWIA pump station design details
- Remnant Vegetation extent

Vegetation Management Plan - Key Plan



DISCLAIMER
THESE PLANS HAVE BEEN PREPARED FOR THE EXCLUSIVE USE OF THE CLIENT. SAUNDERS HAVILL GROUP CANNOT ACCEPT RESPONSIBILITY FOR ANY USE OF OR RELIANCE ON THE CONTENTS OF THESE DRAWINGS BY ANY THIRD PARTY.
CONFIRM ALL DIMENSIONS ON SITE PRIOR TO CONSTRUCTION AND DO NOT SCALE FROM THE DRAWINGS. A ALL CONSTRUCTION AND REMEDIATION WORK MUST BE COMPLETED IN ACCORDANCE WITH THE SAUNDERS HAVILL GROUP PROJECTS COMMENCEMENT OF WORK.
PRIOR TO ANY DEMOLITION, RELOCATION OR CONSTRUCTION WORK, THE RELEVANT AUTHORITY SHOULD BE CONTACTED FOR FURTHER GUIDANCE AND SERVICES AND THE LOCATION OF ALL SERVICES.

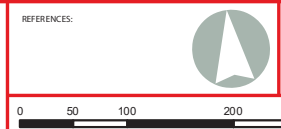

AMENDMENTS:			
Date	Description	Checked	
23/01/2018	Client Draft	AD	
7/02/2018	Surplus fill area added	AD	
21/06/2018	Civil water arm and manholes	AD	

CLIENT:
PEET Limited
PROJECT:
Flagstone City - Stage 2-5
Phase 1 works

environmental management			
PLAN OF: Vegetation Management Plan			
DATE: 21/06/2018		CHECKED: AD	
JOB REF: 8047		DRAWN: TC	
DRAWING No.: 8047 E 03 Stage 2 VMP C			

Refer to *Vegetation Management Plan - Detail Sheet 04, Drawing No. 8047 E 04 Stage 2 VMP D*, dated 26 August 2024 in the approved Revised Vegetation Management Plan.

PLANS AND DOCUMENTS referred to in the PDA
DEVELOPMENT APPROVAL

Approval no: DEV2018/915/16
Date: 28 November 2024



~~PLANS AND DOCUMENTS referred to in the PDA
DEVELOPMENT APPROVAL~~

~~Approval no: DEV2018/915
Date: 3 August 2018~~



AMENDED IN RED

By: Chessa Lao
Date: 19 November 2024



Legend

- Tree to retain (with TPZ)
- Tree to remove (with TPZ)
- Tree to remove - part of separate LWIA application (with TPZ)
- Tree to remove - Area required for surplus fill due to civil works
- Stage 2-5 phase 1 & school site works (including additional 10m vegetation clearing for construction access)
- School lot & road layout
- Civil road design
- Trunk sewer
- Temporary waterway crossing track
- Civil storm water design/culvert design
- Civil electrical/lighting design
- Batter top/toe
- Civil design contours

- Stockpile location (indicative)
- Separate application area for LWIA Sewer pump station
- LWIA pump station design details

- Tree protection fencing - to be fauna friendly design & subject to minor changes by Arborist and civil engineer
- Remnant Vegetation extent
- Existing contours (0.5m)

Vegetation Management Plan - Detail Sheet II



DISCLAIMER
THESE PLANS HAVE BEEN PREPARED FOR THE EXCLUSIVE USE OF THE CLIENT. SAUNDERS HAVILL GROUP CANNOT ACCEPT RESPONSIBILITY FOR ANY USE OF OR RELIANCE ON THEM IN CONNECTIONS OTHER THAN THAT FOR WHICH THEY WERE PREPARED.

REFERENCES:




AMENDMENTS:	Date	Description	Checked
A	23/01/2018	Client Draft	AD
B	7/02/2018	Surplus fill area added	AD
C	21/06/2018	Civil extent and amendments	AD

CLIENT: PEET Limited
PROJECT: Flagstone City - Stage 2-5 Phase 1 works

environmental management	
PLAN OF: Vegetation Management Plan	
DATE: 21/06/2018	CHECKED: AD
JOB REF: 7833	DRAWN: TC
DRAWING No.: 8047 E 11 Stage 2 VMP C	

0 10 20 40 m 1:600 @ A3

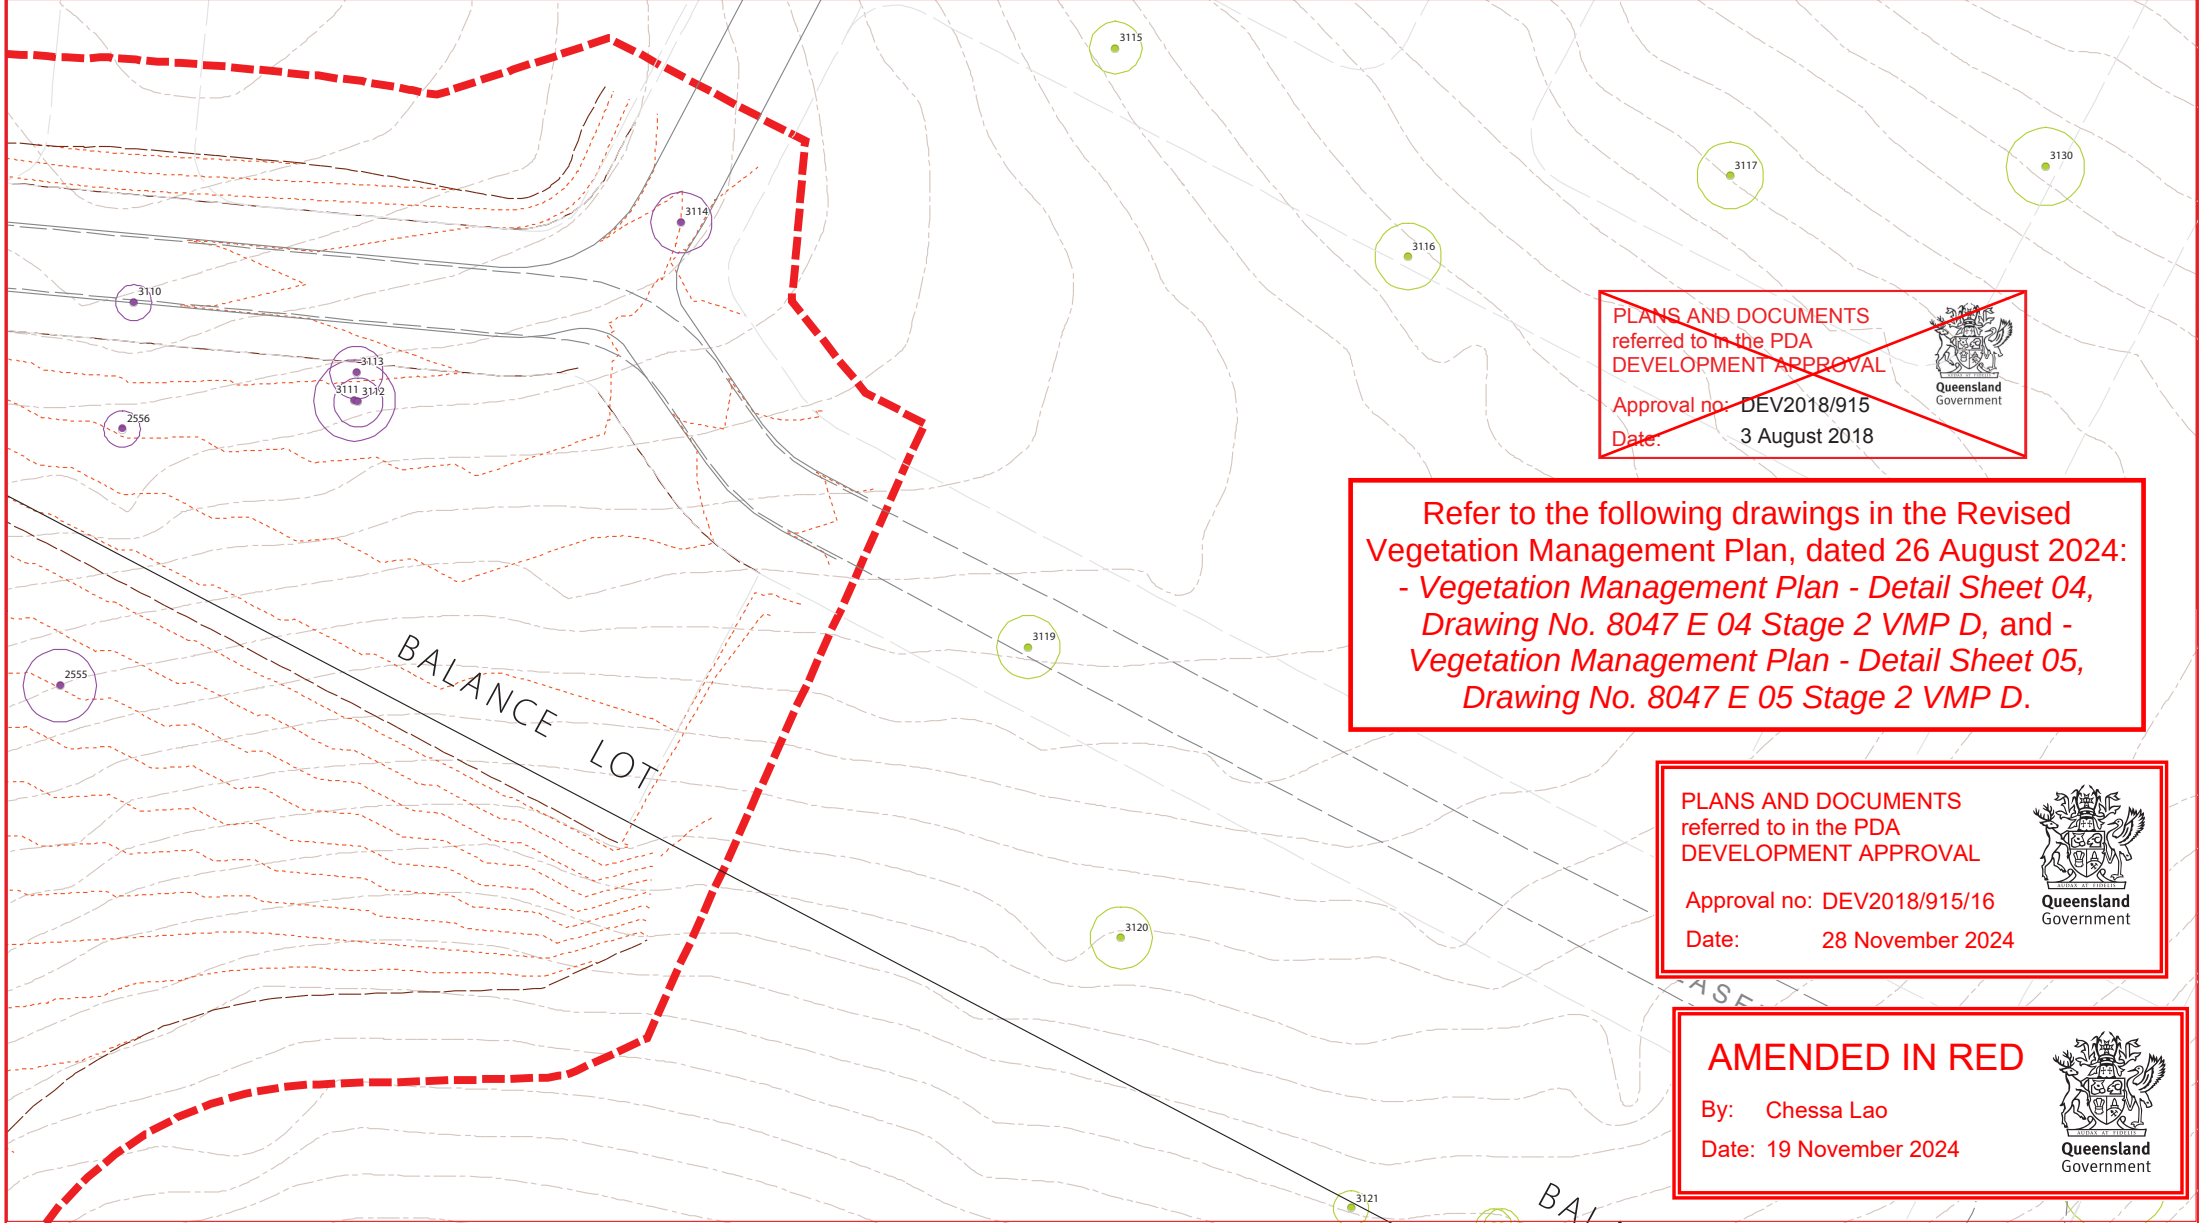

~~PLANS AND DOCUMENTS
referred to in the PDA
DEVELOPMENT APPROVAL~~

~~Approval no: DEV2018/915
Date: 3 August 2018~~

Queensland Government

Refer to the following drawings in the Revised Vegetation Management Plan, dated 26 August 2024:
- Vegetation Management Plan - Detail Sheet 04, Drawing No. 8047 E 04 Stage 2 VMP D, and - Vegetation Management Plan - Detail Sheet 05, Drawing No. 8047 E 05 Stage 2 VMP D.

PLANS AND DOCUMENTS
referred to in the PDA
DEVELOPMENT APPROVAL

Approval no: DEV2018/915/16
Date: 28 November 2024

Queensland Government

AMENDED IN RED


By: Chessa Lao
Date: 19 November 2024

Queensland Government

- Legend**
- Tree to retain (with TPZ)
 - Tree to remove (with TPZ)
 - Tree to remove - part of separate LWIA application (with TPZ)
 - Tree to remove - Area required for surplus fill due to civil works
 - Stage 2-5 phase 1 & school site works (including additional 10m vegetation clearing for construction access)
 - School lot & road layout
 - Civil road design
 - Trunk sewer
 - Temporary waterway crossing track
 - Civil storm water design/culvert design
 - Civil electrical/lighting design
 - Batter top/toe
 - Civil design contours
 - Stockpile location (indicative)
 - Separate application area for LWIA Sewer pump station
 - LWIA pump station design details
 - Tree protection fencing - to be fauna friendly design & subject to minor changes by Arborist and civil engineer
 - Remnant Vegetation extent
 - Existing contours (0.5m)

Vegetation Management Plan - Detail Sheet I2



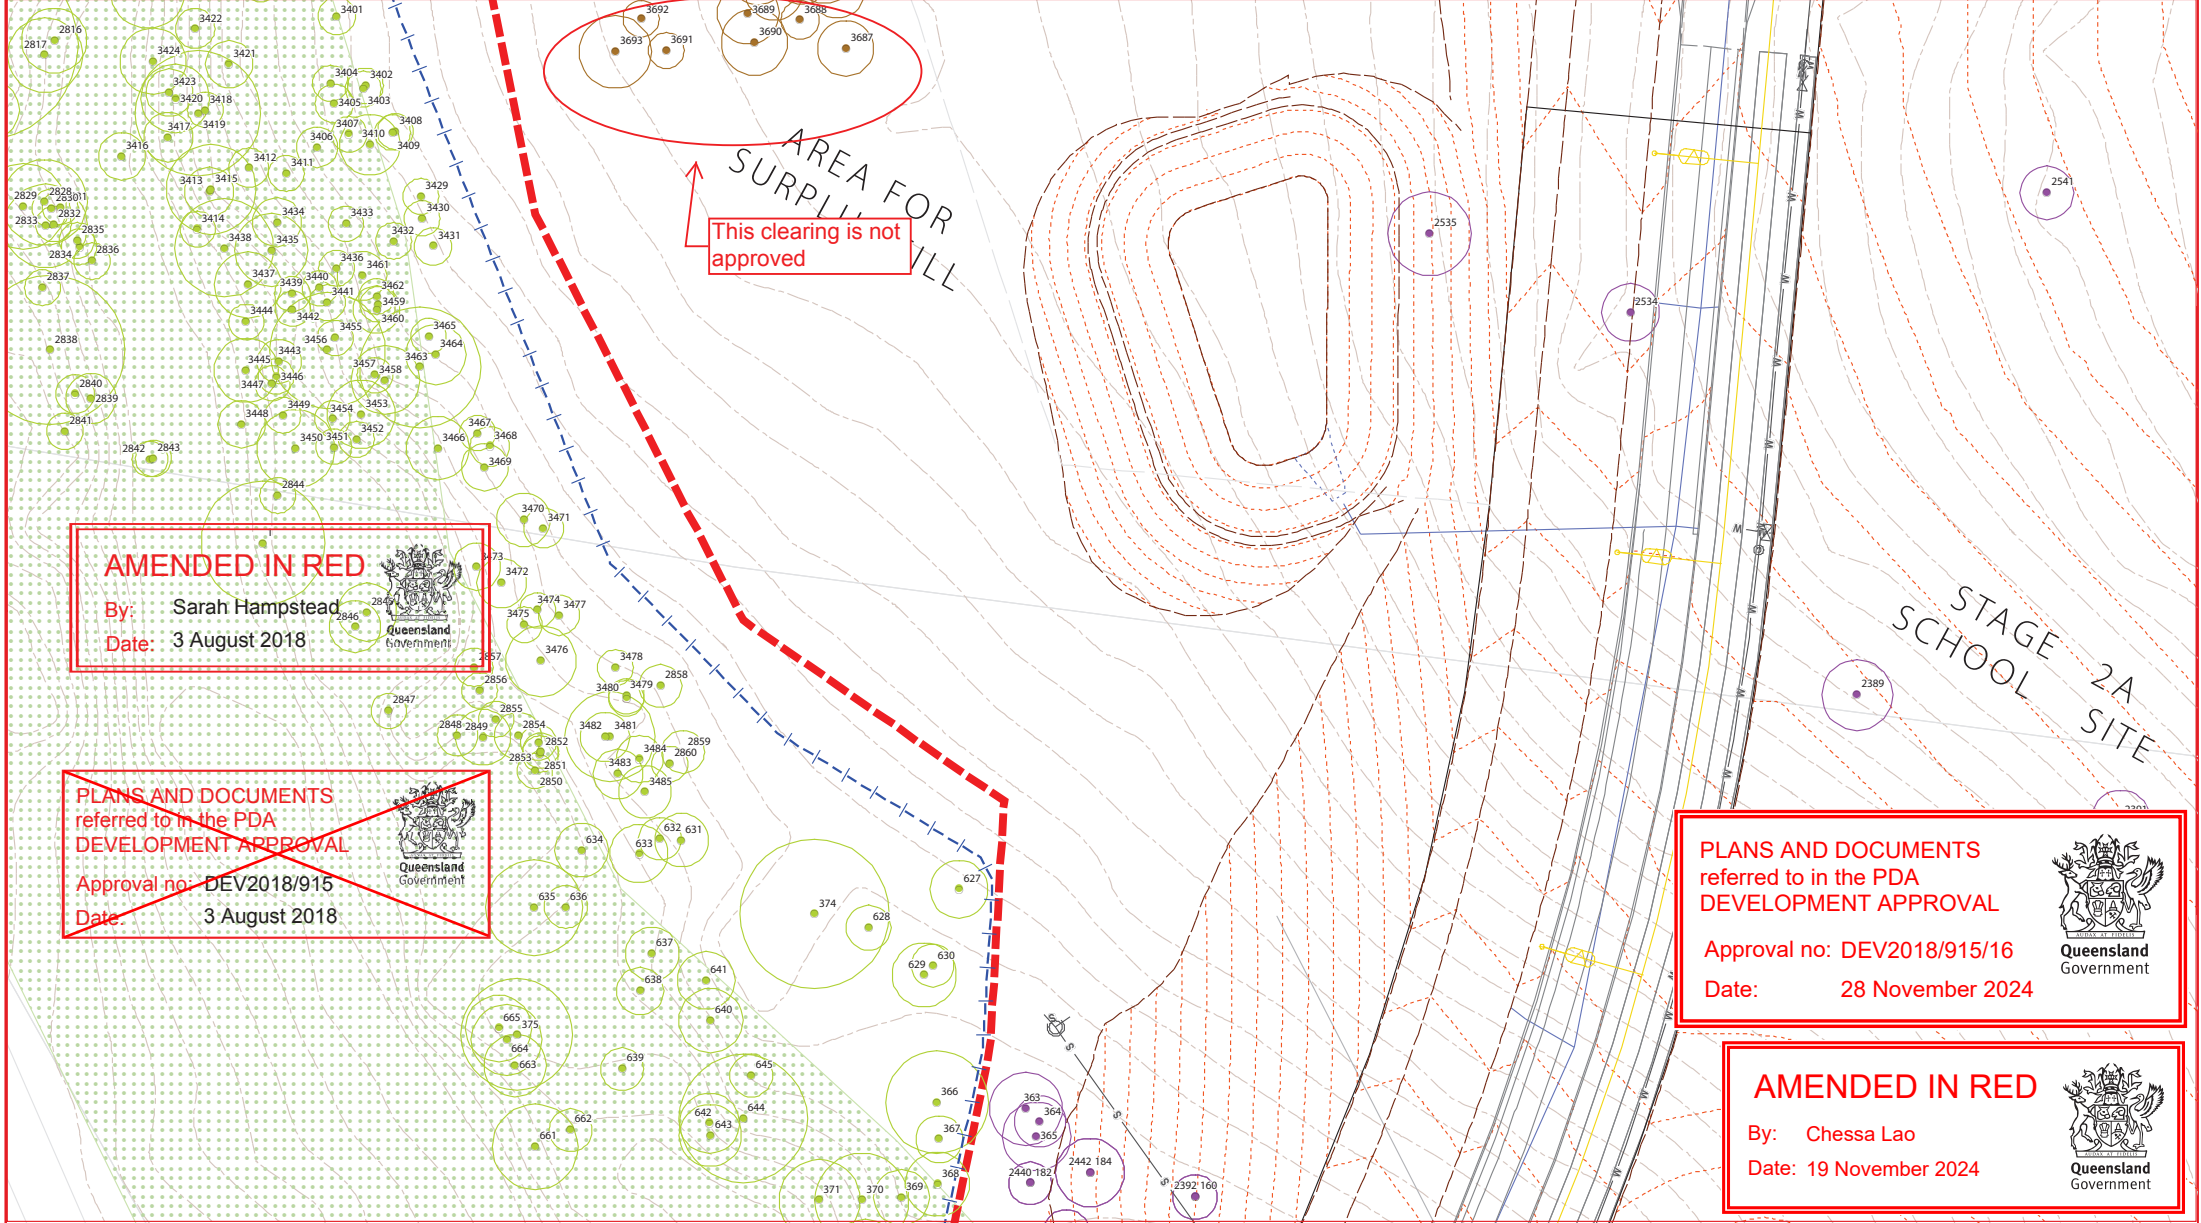

Legend

- Tree to retain (with TPZ)
- Tree to remove (with TPZ)
- Tree to remove - part of separate LWIA application (with TPZ)
- Tree to remove - Area required for surplus fill due to civil works
- Stage 2-5 phase 1 & school site works (including additional 10m vegetation clearing for construction access)
- School lot & road layout
- Civil road design
- Trunk sewer
- Temporary waterway crossing track
- Civil storm water design/culvert design
- Civil electrical/lighting design
- Batter top/toe
- Civil design contours
- Stockpile location (indicative)
- Separate application area for LWIA Sewer pump station
- LWIA pump station design details
- Tree protection fencing - to be fauna friendly design & subject to minor changes by Arborist and civil engineer
- Remnant Vegetation extent
- Existing contours (0.5m)

Vegetation Management Plan - Detail Sheet I3

DISCLAIMER

THESE PLANS HAVE BEEN PREPARED FOR THE EXCLUSIVE USE OF THE CLIENT. SAUNDERS HAVILL GROUP CANNOT ACCEPT RESPONSIBILITY FOR ANY USE OF OR RELIANCE ON THEM TO CONVEY THE INTENT OF THESE DRAWINGS OR ANY THIRD PARTY.

CONFORM TO ALL DIMENSIONS UNLESS OTHERWISE SPECIFIED OR TO CONSTRUCT ON AND DO NOT SCALE FROM THE DRAWINGS. ALL DIMENSIONS ARE IN METERS. A 10% OVERLAP IS TO BE MAINTAINED BETWEEN ALL CLEARING AREAS. 

IN THE EVENT OF ANY DISCREPANCY BETWEEN THE PLANS AND THE FIELD SITUATION, THE FIELD SITUATION SHALL PREVAIL.

REFERENCES:

0 10 20 40 m

1:600 @ A3

AMENDMENTS:

Issue	Date	Description	Checked
A	23/01/2018	Client Draft	AD
B	7/02/2018	5 surplus fill areas added	AD
C	21/06/2018	Civil extent and amendments	AD

CLIENT: PEET Limited

PROJECT: Flagstone City - Stage 2-5 Phase 1 works

environmental management

PLAN OF: Vegetation Management Plan

DATE	21/06/2018	CHECKED:	AD
JOB REF:	7833	DRAWN:	TC
DRAWING No.:	8047 E 13 Stage 2 VMP C		

saunders havill group

PEET Flagstone

Refer to the following drawings in the Revised Vegetation Management Plan, dated 26 August 2024:

- Vegetation Management Plan - Detail Sheet 04, Drawing No. 8047 E 04 Stage 2 VMP D, and
- Vegetation Management Plan - Detail Sheet 06, Drawing No. 8047 E 06 Stage 2 VMP D.

PLANS AND DOCUMENTS referred to in the PDA DEVELOPMENT APPROVAL

Approval no: DEV2018/915
Date: 3 August 2018



PLANS AND DOCUMENTS referred to in the PDA DEVELOPMENT APPROVAL

Approval no: DEV2018/915/16
Date: 28 November 2024



AMENDED IN RED

By: Chessa Lao
Date: 19 November 2024



Legend

- Tree to retain (with TPZ)
- Tree to remove (with TPZ)
- Tree to remove - part of separate LWIA application (with TPZ)
- Tree to remove - Area required for surplus fill due to civil works
- Stage 2-5 phase 1 & school site works (including additional 10m vegetation clearing for construction access)
- School lot & road layout
- Civil road design
- Trunk sewer
- Temporary waterway crossing track
- Civil storm water design/culvert design
- Civil electrical/lighting design
- Batter top/toe
- Civil design contours

- Stockpile location (indicative)
- Separate application area for LWIA Sewer pump station
- LWIA pump station design details

- Tree protection fencing - to be fauna friendly design & subject to minor changes by Arborist and civil engineer
- Remnant Vegetation extent
- Existing contours (0.5m)

Vegetation Management Plan - Detail Sheet I4



DISCLAIMER

THESE PLANS HAVE BEEN PREPARED FOR THE EXCLUSIVE USE OF THE CLIENT. SAUNDERS HAVILL GROUP CANNOT ACCEPT RESPONSIBILITY FOR ANY USE OF OR RELIANCE ON THE CONTENTS OF THESE DRAWINGS BY ANY THIRD PARTY.

CONFIRM ALL DIMENSIONS ON SITE PRIOR TO CONSTRUCTION AND DO NOT SCALE FROM THE DRAWINGS. A ALL DIMENSIONS ARE IN METRES. A 10% OVERLAP IS TO BE MAINTAINED BETWEEN ALL DIMENSIONS. 


REFERENCES



0 10 20 40 m
1:600 @ A3

AMENDMENTS:		
Date	Description	Checked
23/01/2018	Client Draft	AD
7/02/2018	Surplus fill area added	AD
21/06/2018	Civil extent area amendments	AD

CLIENT:


PEET Limited

PROJECT:

Flagstone City - Stage 2-5
Phase 1 works

environmental management

PLAN OF:	
Vegetation Management Plan	
DATE: 21/06/2018	CHECKED: AD
JOB REF: 7833	DRAWN: TC
DRAWING No.: 8047 E 14 Stage 2 VMP C	

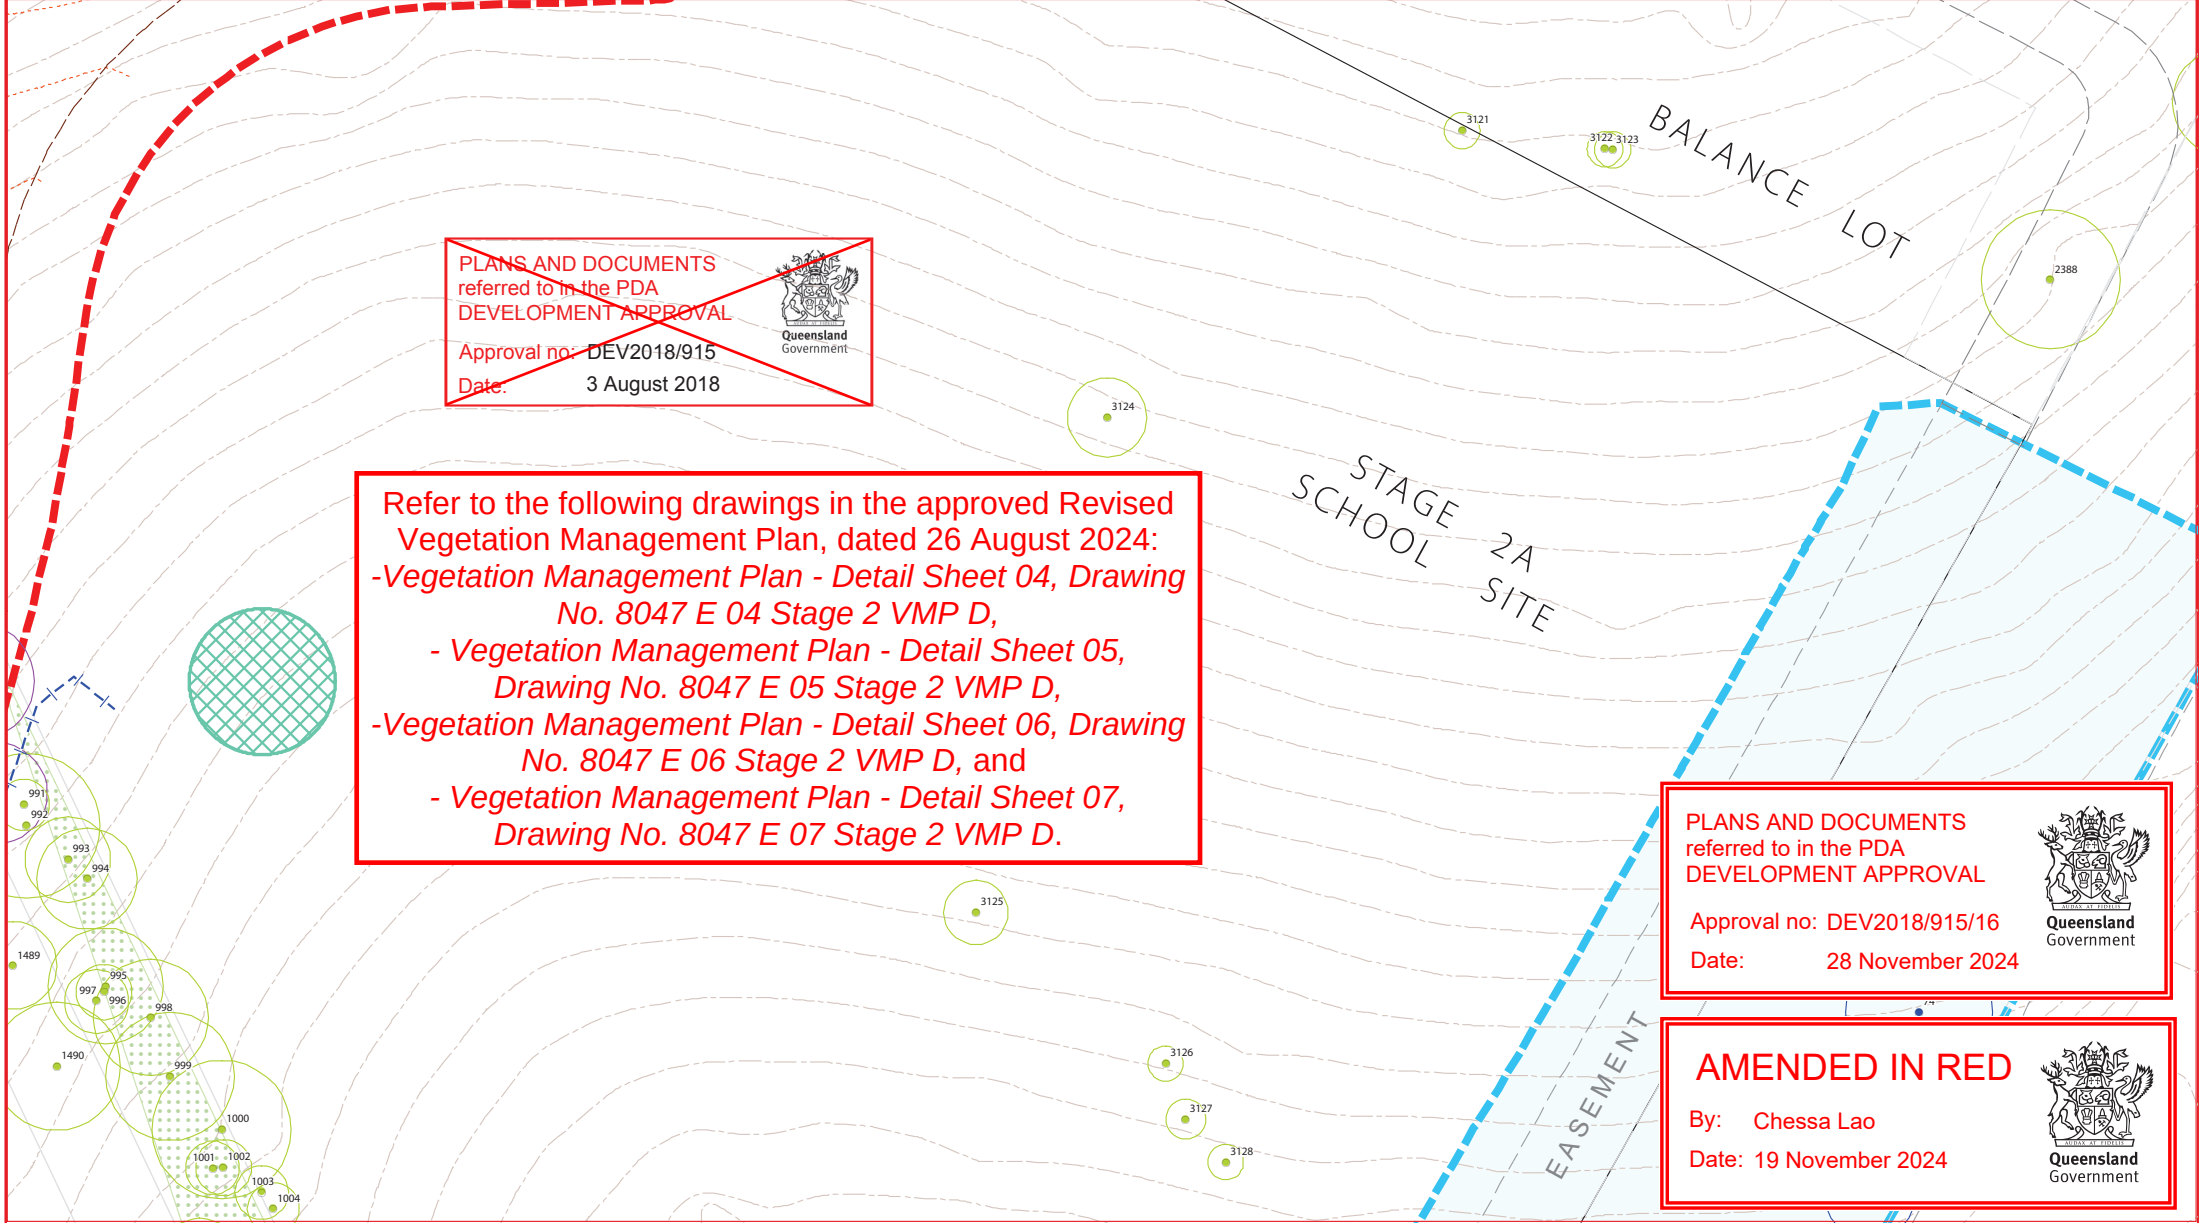

~~PLANS AND DOCUMENTS
referred to in the PDA
DEVELOPMENT APPROVAL~~

~~Approval no: DEV2018/915
Date: 3 August 2018~~



Refer to the following drawings in the approved Revised Vegetation Management Plan, dated 26 August 2024:

- Vegetation Management Plan - Detail Sheet 04, Drawing No. 8047 E 04 Stage 2 VMP D,
- Vegetation Management Plan - Detail Sheet 05, Drawing No. 8047 E 05 Stage 2 VMP D,
- Vegetation Management Plan - Detail Sheet 06, Drawing No. 8047 E 06 Stage 2 VMP D, and
- Vegetation Management Plan - Detail Sheet 07, Drawing No. 8047 E 07 Stage 2 VMP D.

PLANS AND DOCUMENTS
referred to in the PDA
DEVELOPMENT APPROVAL

Approval no: DEV2018/915/16
Date: 28 November 2024



AMENDED IN RED

By: Chessa Lao
Date: 19 November 2024



Legend

-  Tree to retain (with TPZ)
-  Tree to remove - Area required for surplus fill due to civil works
-  Tree to remove (with TPZ)
-  Tree to remove - part of separate LWIA application (with TPZ)
-  Stage 2-5 phase 1 & school site works (including additional 10m vegetation clearing for construction access)
-  School lot & road layout
-  Civil road design
-  Trunk sewer
-  Temporary waterway crossing track
-  Civil storm water design/culvert design
-  Civil electrical/lighting design
-  Batter top/toe
-  Civil design contours
-  Stockpile location (indicative)
-  Separate application area for LWIA Sewer pump station
-  LWIA pump station design details
-  Tree protection fencing - to be fauna friendly design & subject to minor changes by Arborist and civil engineer
-  Remnant Vegetation extent
-  Existing contours (0.5m)

Vegetation Management Plan - Detail Sheet I5



DISCLAIMER:

THESE PLANS HAVE BEEN PREPARED FOR THE EXCLUSIVE USE OF THE CLIENT. SAUNDERS HAVILL GROUP CANNOT ACCEPT RESPONSIBILITY FOR ANY USE OF OR RELIANCE ON THEM TO CONSENTS OF THESE DRAWINGS OR ANY THIRD PARTY.



REFERENCES:



1:600 @ A3

AMENDMENTS:

Issue	Date	Description	Checked
A	23/01/2018	Client Draft	AD
B	7/02/2018	Supplies fill area added	AD
C	21/06/2018	Civil extent and amendments	AD

CLIENT: PEET Limited

PROJECT: Flagstone City - Stage 2-5 Phase 1 works

environmental management

PLAN OF: Vegetation Management Plan

DATE	21/06/2018	CHECKED:	AD
JOB REF:	7833	DRAWN:	TC
DRAWING No.:	8047 E 15 Stage 2 VMP C		

PLANS AND DOCUMENTS
referred to in the PDA
DEVELOPMENT APPROVAL

Approval no: DEV2018/915
Date: 3 August 2018



PLANS AND DOCUMENTS
referred to in the PDA
DEVELOPMENT APPROVAL

Approval no: DEV2018/915/16
Date: 28 November 2024



AMENDED IN RED

By: Chessa Lao
Date: 19 November 2024



Legend

- Tree to retain (with TPZ)
- Tree to remove (with TPZ)
- Tree to remove - part of separate LWIA application (with TPZ)
- Tree to remove - Area required for surplus fill due to civil works
- Stage 2-5 phase 1 & school site works (including additional 10m vegetation clearing for construction access)
- School lot & road layout
- Civil road design
- Trunk sewer
- Temporary roadway crossing track
- Civil storm water design/culvert design
- Civil electrical/lighting design
- Batter top/toe
- Civil design contours
- Stockpile location (indicative)
- Separate application area for LWIA Sewer pump station
- LWIA pump station design details
- Tree protection fencing - to be fauna friendly design & subject to minor changes by Arborist and civil engineer
- Remnant Vegetation extent
- Existing contours (0.5m)

**saunders
havill
group**

PEET Flagstone

DISCLAIMER

THESE PLANS HAVE BEEN PREPARED FOR THE EXCLUSIVE USE OF THE CLIENT. SAUNDERS HAVILL GROUP CANNOT ACCEPT RESPONSIBILITY FOR ANY USE OF OR RELIANCE ON THE CONTENTS OF THESE DRAWINGS BY ANY THIRD PARTY.

CONFIRM ALL DIMENSIONS, LEVELS, FINISHES, TOLERANCES AND LOCATIONS DO NOT VARY FROM THE DRAWINGS. A ALL DIMENSIONS ARE TO BE TAKEN FROM THE FACE UNLESS OTHERWISE SPECIFIED. CLARIFIED IN WRITING BY A SAUNDERS HAVILL GROUP PROJECT OFFICE COMMENCEMENT OF WORK.


REFERENCES:



0 10 20 40 m 1:600 @ A3

AMENDMENTS:			
Date	Description	Checked	By
23/01/2018	Client Draft	AD	
7/02/2018	5 surplus fill area added	AD	
21/06/2018	Civil extent and amendments	AD	

CLIENT:
PEET Limited

PROJECT:

Flagstone City - Stage 2-5
Phase 1 works

environmental management

Vegetation Management Plan			
DATE:	21/06/2018	CHECKED:	AD
JOB REF:	7833	DRAWN:	TC
DRAWING No.:	8047 E 16 Stage 2 VMP C		

Refer to the following drawings in the approved Revised Vegetation Management Plan, dated 26 August 2024:

- Vegetation Management Plan - Detail Sheet 06, Drawing No. 8047 E 06 Stage 2 VMP D, and
- Vegetation Management Plan - Detail Sheet 08, Drawing No. 8047 E 08 Stage 2 VMP D.

PLANS AND DOCUMENTS referred to in the PDA DEVELOPMENT APPROVAL

Approval no: DEV2018/915

Date: 3 August 2018

PLANS AND DOCUMENTS referred to in the PDA DEVELOPMENT APPROVAL

Approval no: DEV2018/915/16

Date: 28 November 2024

AMENDED IN RED

By: Chessa Lao

Date: 19 November 2024



Legend

- Tree to retain (with TPZ)
- Tree to remove (with TPZ)
- Tree to remove - part of separate LWIA application (with TPZ)
- Tree to remove - Area required for surplus fill due to civil works
- Stage 2-5 phase 1 & school site works (including additional 10m vegetation clearing for construction access)
- School lot & road layout
- Civil road design
- Trunk sewer
- Temporary roadway crossing track
- Civil storm water design/culvert design
- Civil electrical/lighting design
- Batter top/toe
- Civil design contours
- Stockpile location (indicative)
- Separate application area for LWIA Sewer pump station
- LWIA pump station design details
- Tree protection fencing - to be fauna friendly design & subject to minor changes by Arborist and civil engineer
- Remnant Vegetation extent
- Existing contours (0.5m)

Vegetation Management Plan - Detail Sheet I7



DISCLAIMER

THESE PLANS HAVE BEEN PREPARED FOR THE EXCLUSIVE USE OF THE CLIENT. SAUNDERS HAVILL GROUP CANNOT ACCEPT RESPONSIBILITY FOR ANY USE OF OR RELIANCE ON THE CONTENTS OF THESE DRAWINGS BY ANY THIRD PARTY.



REFERENCES:



0 10 20 40 m

1:600 @ A3

AMENDMENTS:			
Date	Description	Checked	By
23/01/2018	Client Draft	AD	
7/02/2018	5 surplus fill areas added	AD	
21/06/2018	Civil extent and amendments	AD	

CLIENT: PEET Limited

PROJECT:

Flagstone City - Stage 2-5
Phase 1 works

environmental management

PLAN OF: Vegetation Management Plan

DATE: 21/06/2018	CHECKED: AD
JOB REF: 7833	DRAWN: TC
DRAWING No.: 8047 E 17 Stage 2 VMP C	

PLANS AND DOCUMENTS
referred to in the PDA
DEVELOPMENT APPROVAL

Approval no: DEV2018/915
Date: 3 August 2018



Refer to the following drawings in the approved Revised
Vegetation Management Plan, dated 26 August 2024:

- Vegetation Management Plan - Detail Sheet 06,
Drawing No. 8047 E 06 Stage 2 VMP D,
- Vegetation Management Plan - Detail Sheet 07,
Drawing No. 8047 E 07 Stage 2 VMP D
- Vegetation Management Plan - Detail Sheet 08,
Drawing No. 8047 E 08 Stage 2 VMP D, and
- Vegetation Management Plan - Detail Sheet 09,
Drawing No. 8047 E 09 Stage 2 VMP D.

PLANS AND DOCUMENTS
referred to in the PDA
DEVELOPMENT APPROVAL

Approval no: DEV2018/915/16
Date: 28 November 2024



AMENDED IN RED

By: Chessa Lao
Date: 19 November 2024



LWIA SEWER PUMP STATION
APPLICATION AREA

Legend

- Tree to retain (with TPZ)
- Tree to remove (with TPZ)
- Tree to remove - part of separate LWIA application (with TPZ)
- Tree to remove - Area required for surplus fill due to civil works
- Stage 2-5 phase 1 & school site works (including additional 10m vegetation clearing for construction access)
- School lot & road layout
- Civil road design
- Trunk sewer
- Temporary waterway crossing track
- Civil storm water design/culvert design
- Civil electrical/lighting design
- Batter top/toe
- Civil design contours
- Stockpile location (indicative)
- Separate application area for LWIA Sewer pump station
- LWIA pump station design details
- Tree protection fencing - to be fauna friendly design & subject to minor changes by Arborist and civil engineer
- Remnant Vegetation extent
- Existing contours (0.5m)



DISCLAIMER

THESE PLANS HAVE BEEN PREPARED FOR THE EXCLUSIVE USE OF THE CLIENT. SAUNDERS HAVILL GROUP CANNOT ACCEPT RESPONSIBILITY FOR ANY USE OF OR RELIANCE ON THEM TO EXCEED THE INTENT OF THESE DRAWINGS OR ANY THIRD PARTY.



REFERENCES



0 10 20 40 m 1:600 @ A3

AMENDMENTS

No.	Date	Description	Checked
A	23/01/2018	Client Draft	AD
B	7/02/2018	5 surplus fill area added	AD
C	21/06/2018	Civil water arm and manholes	AD

CLIENT

PEET Limited

PROJECT

Flagstone City - Stage 2-5
Phase 1 works

environmental management

PLAN OF:

Vegetation Management Plan

DATE: 21/06/2018 CHECKED: AD

JOB REF: 7833 DRAWN: TC

DRAWING No.: 8047 E 18 Stage 2 VMP C

~~PLANS AND DOCUMENTS
referred to in the PDA
DEVELOPMENT APPROVAL~~

Approval no: DEV2018/915
Date: 3 August 2018




PLANS AND DOCUMENTS
referred to in the PDA
DEVELOPMENT APPROVAL

Approval no: DEV2018/915/16
Date: 28 November 2024



AMENDED IN RED

By: Chessa Lao
Date: 19 November 2024

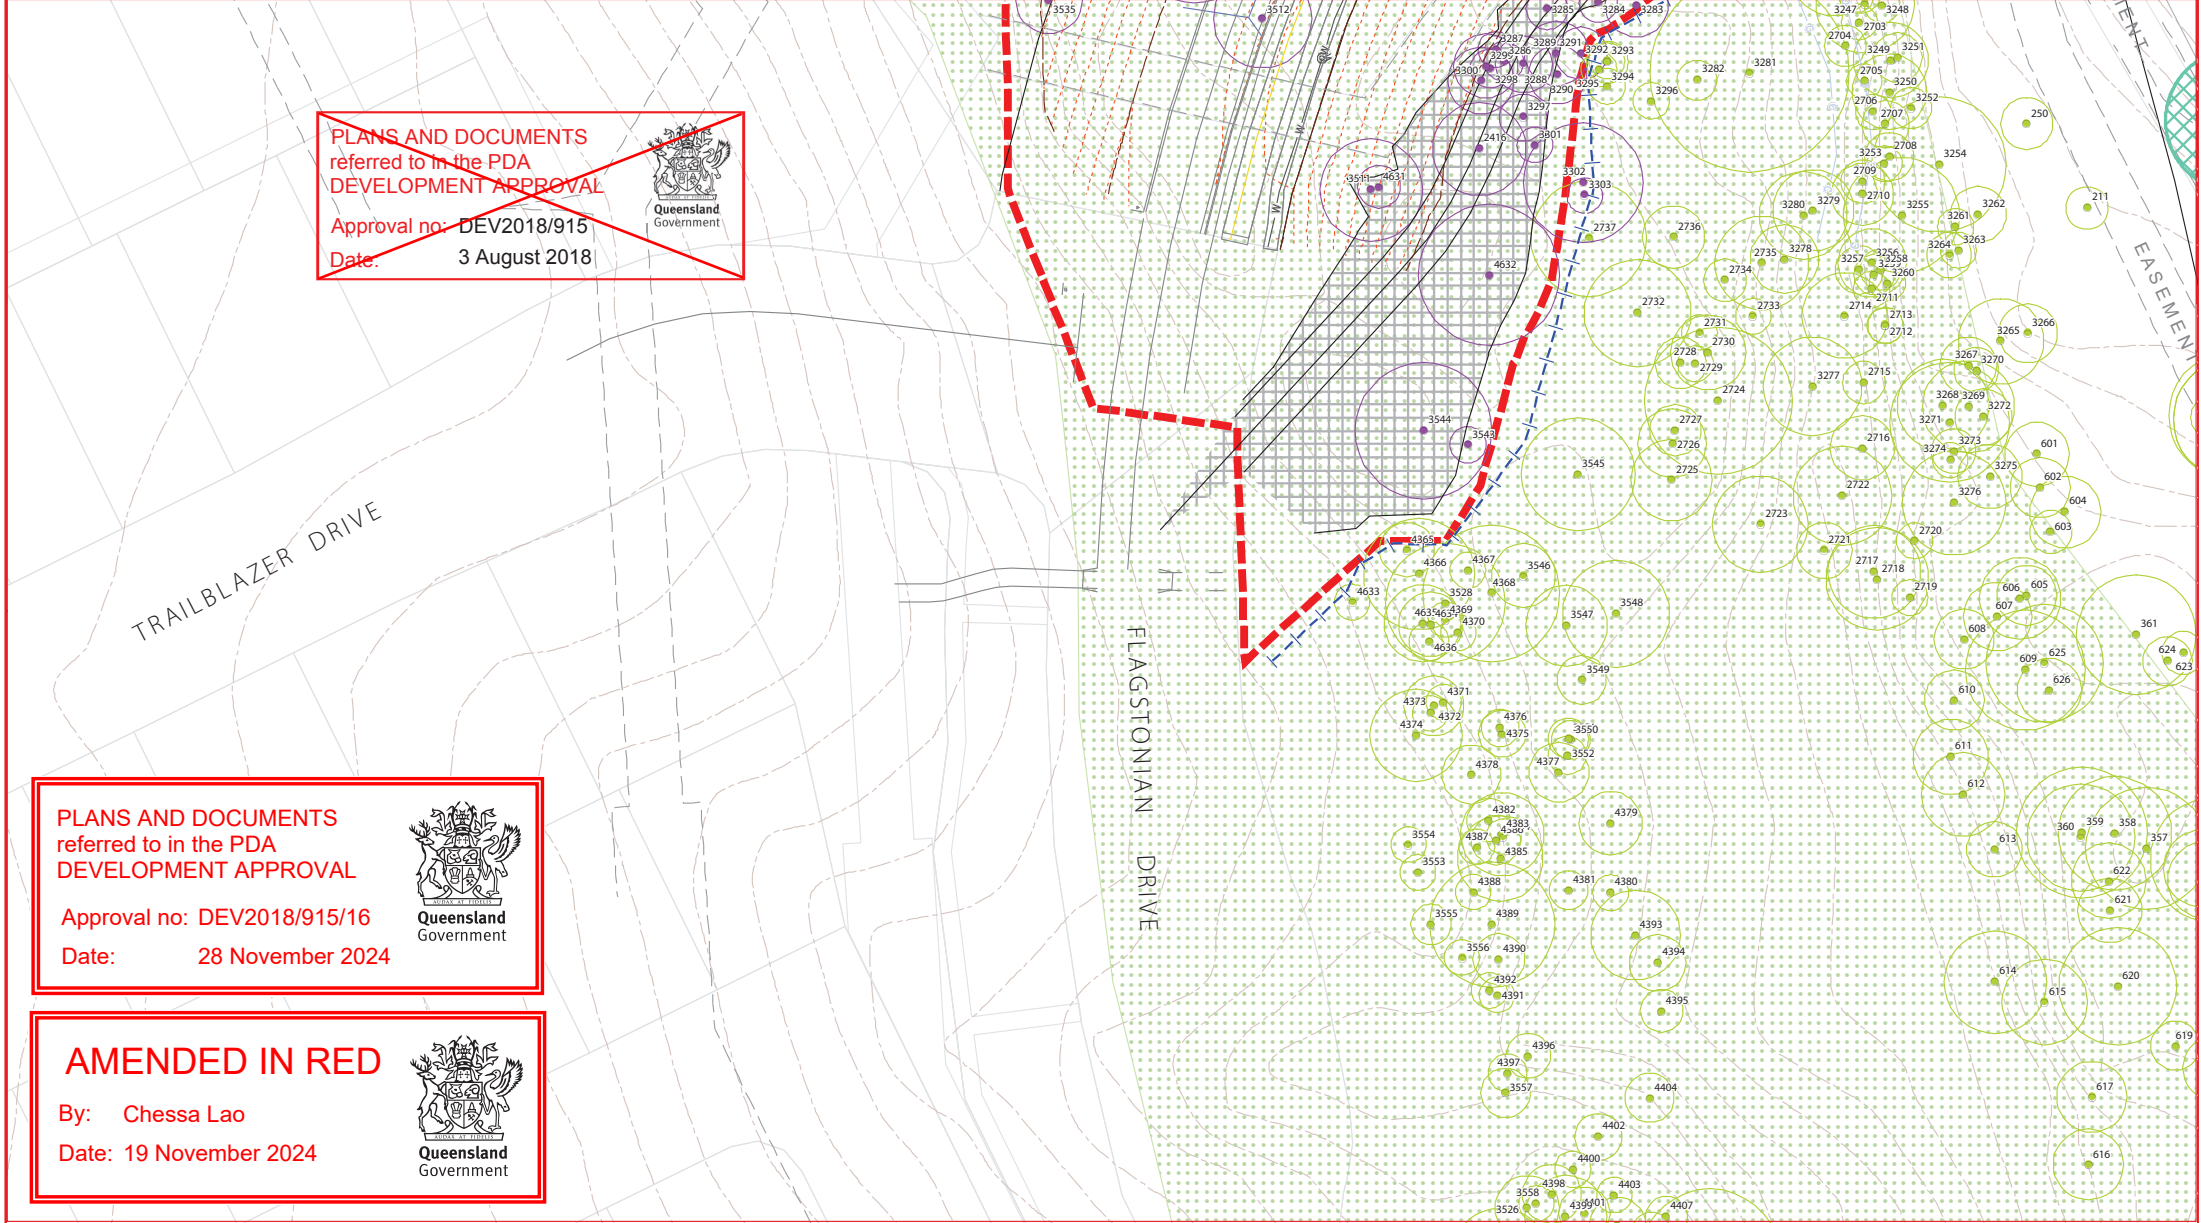

- Legend**
- Tree to retain (with TPZ)
 - Tree to remove (with TPZ)
 - Tree to remove - part of separate LWIA application (with TPZ)
 - Tree to remove - Area required for surplus fill due to civil works
 - Stage 2-5 phase 1 & school site works (including additional 10m vegetation clearing for construction access)
 - School lot & road layout
 - Civil road design
 - Trunk sewer
 - Temporary roadway crossing track
 - Civil storm water design/culvert design
 - Civil electrical/lighting design
 - Batter top/toe
 - Civil design contours
 - Stockpile location (indicative)
 - Separate application area for LWIA Sewer pump station
 - LWIA pump station design details
 - Tree protection fencing - to be fauna friendly design & subject to minor changes by Arborist and civil engineer
 - Remnant Vegetation extent
 - Existing contours (0.5m)

Vegetation Management Plan - Detail Sheet I9

DISCLAIMER




REFERENCES:

0 10 20 40 m

1:600 @ A3

AMENDMENTS:

Date	Description	Checked
23/01/2018	Client Draft	AD
7/02/2018	Suppl. fill area added	AD
21/06/2018	Civil extent and amendments	AD


CLIENT:
PEET Limited

PROJECT:
Flagstone City - Stage 2-5
Phase 1 works

environmental management

PLAN OF: Vegetation Management Plan

DATE: 21/06/2018	CHECKED: AD
JOB REF: 7833	DRAWN: TC
DRAWING No.: 8047 E 19 Stage 2 VMP C	

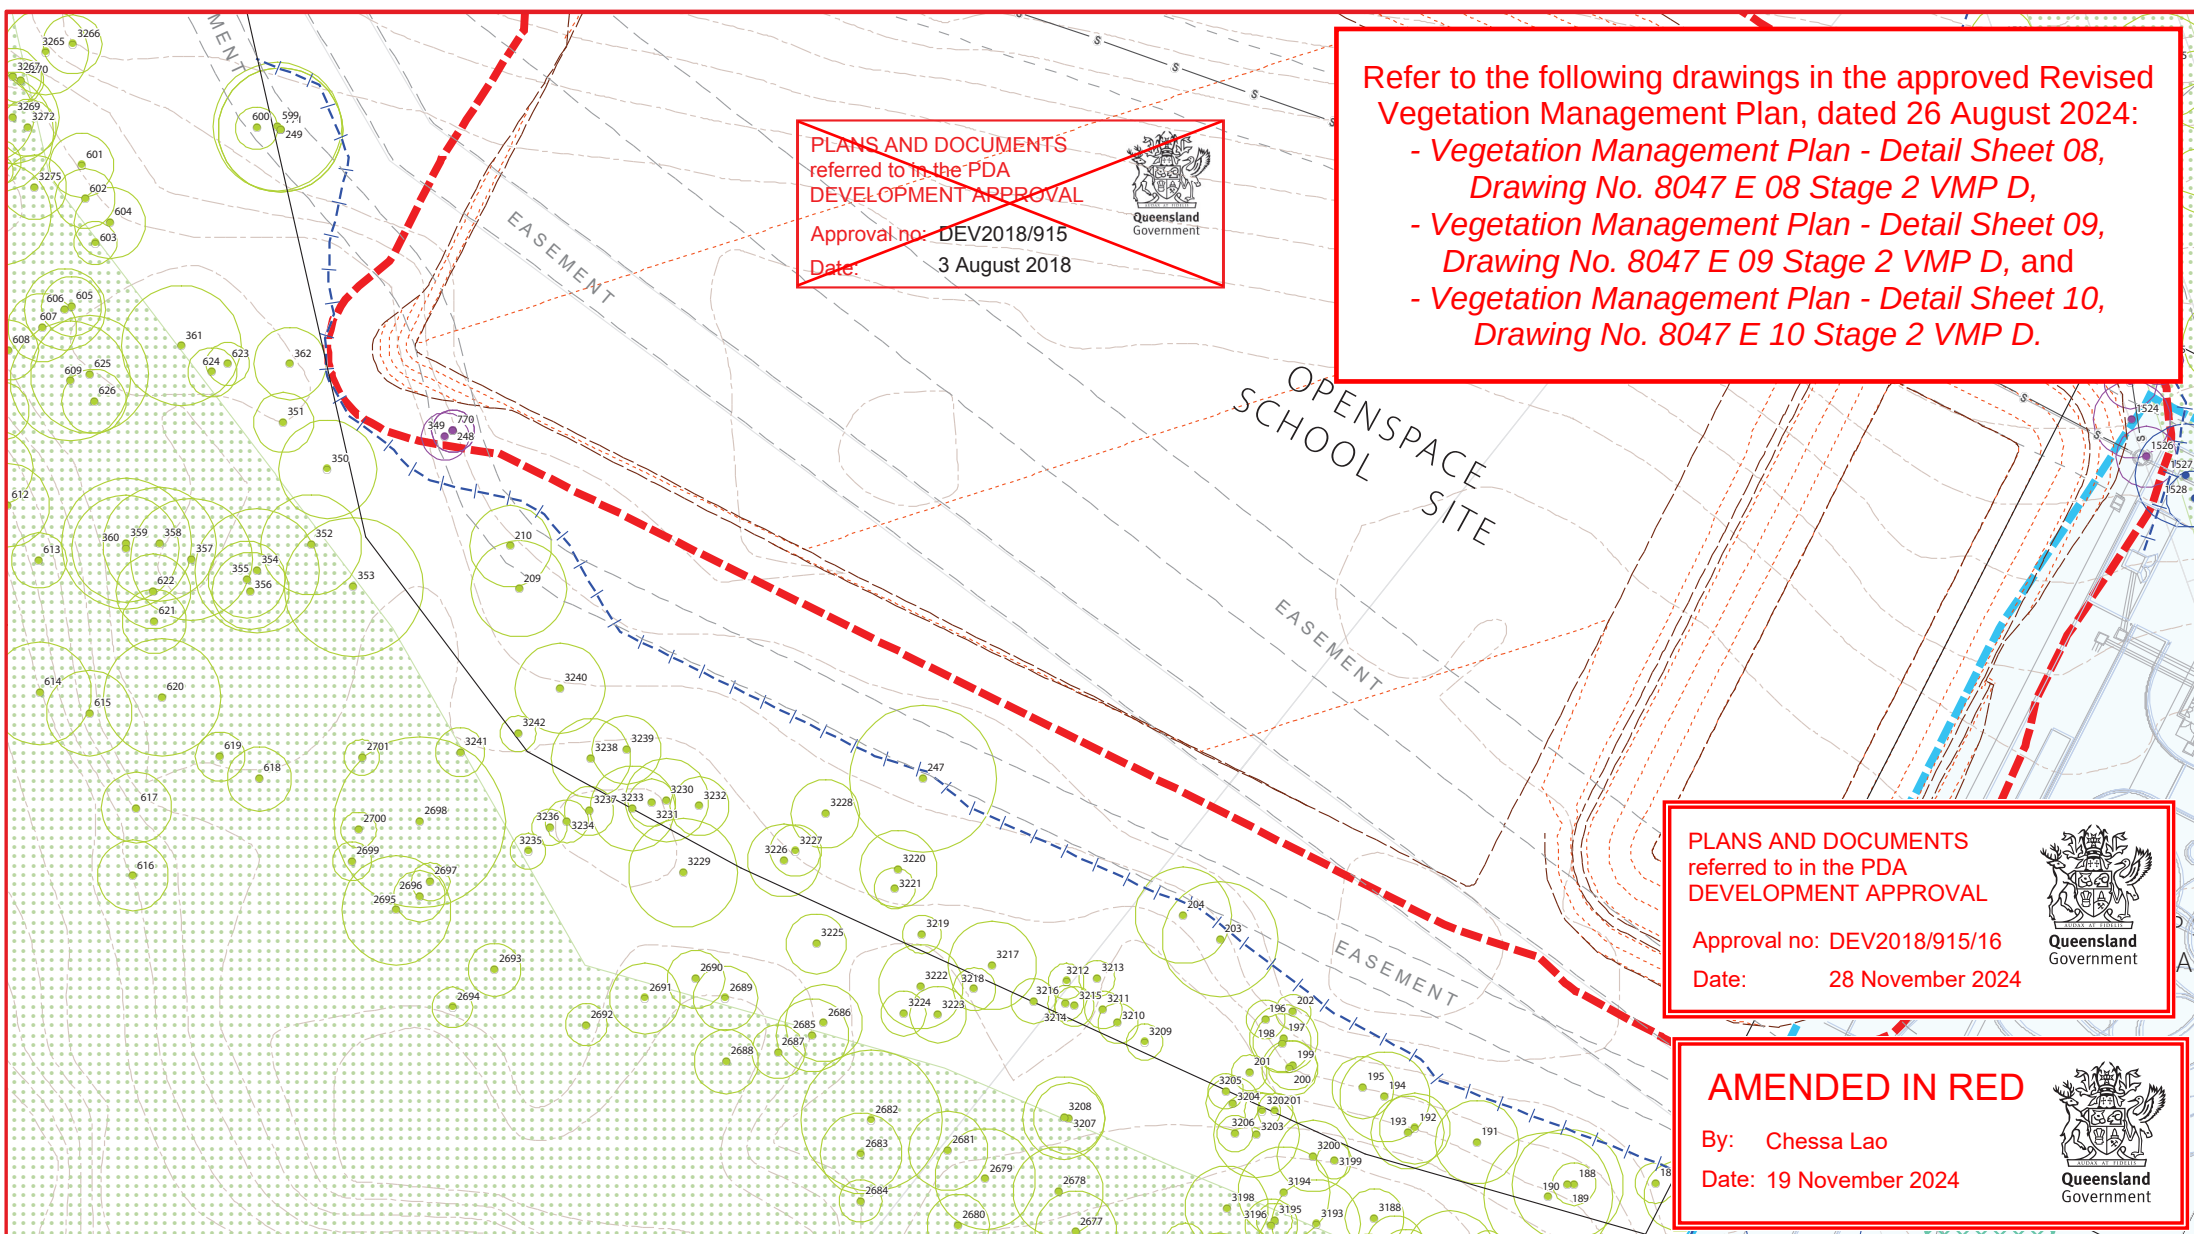

Legend

- Tree to retain (with TPZ)
- Tree to remove (with TPZ)
- Tree to remove - part of separate LWIA application (with TPZ)
- Tree to remove - Area required for surplus fill due to civil works
- Stage 2-5 phase 1 & school site works (including additional 10m vegetation clearing for construction access)
- School lot & road layout
- Civil road design
- Trunk sewer
- Temporary roadway crossing track
- Civil storm water design/culvert design
- Civil electrical/lighting design
- Batter top/toe
- Civil design contours
- Stockpile location (indicative)
- Separate application area for LWIA Sewer pump station
- LWIA pump station design details
- Tree protection fencing - to be fauna friendly design & subject to minor changes by Arborist and civil engineer
- Remnant Vegetation extent
- Existing contours (0.5m)

**saunders
havill
group**

PEET Flagstone

DISCLAIMER





REFERENCES:



0 10 20 40 m
1:600 @ A3

AMENDMENTS:

No.	Date	Description	Checked
A	23/01/2018	Client Draft	AD
B	7/02/2018	5 surplus fill area added	AD
C	21/06/2018	Civil water am and mnts	AD

CLIENT:

PEET Limited

PROJECT:

Flagstone City - Stage 2-5
Phase 1 works

environmental management

PLAN OF:

Vegetation
Management Plan

DATE: 21/06/2018	CHECKED: AD
JOB REF: 7833	DRAWN: TC
DRAWING No.: 8047 E 20 Stage 2 VMP C	

Refer to the following drawings in the approved Revised Vegetation Management Plan, dated 26 August 2024:

- Vegetation Management Plan - Detail Sheet 09, Drawing No. 8047 E 09 Stage 2 VMP D, and
- Vegetation Management Plan - Detail Sheet 10, Drawing No. 8047 E 10 Stage 2 VMP D.

AMENDED IN RED

By: Chessa Lao

Date: 19 November 2024



PLANS AND DOCUMENTS referred to in the PDA DEVELOPMENT APPROVAL

Approval no: DEV2018/915/16

Date: 28 November 2024



~~PLANS AND DOCUMENTS referred to in the PDA DEVELOPMENT APPROVAL~~

~~Approval no: DEV2018/915~~

~~Date: 3 August 2018~~



LWIA SEWER PUMP STATION APPLICATION AREA

Legend

- Tree to retain (with TPZ)
- Tree to remove (with TPZ)
- Tree to remove - part of separate LWIA application (with TPZ)
- Tree to remove - Area required for surplus fill due to civil works
- Stage 2-5 phase 1 & school site works (including additional 10m vegetation clearing for construction access)
- School lot & road layout
- Civil road design
- Trunk sewer
- Temporary roadway crossing track
- Civil storm water design/culvert design
- Civil electrical/lighting design
- Batter top/toe
- Civil design contours
- Stockpile location (indicative)
- Separate application area for LWIA Sewer pump station
- LWIA pump station design details
- Tree protection fencing - to be fauna friendly design & subject to minor changes by Arborist and civil engineer
- Remnant Vegetation extent
- Existing contours (0.5m)

Vegetation Management Plan - Detail Sheet 21



DISCLAIMER

THESE PLANS HAVE BEEN PREPARED FOR THE EXCLUSIVE USE OF THE CLIENT. SAUNDERS HAVILL GROUP CANNOT ACCEPT RESPONSIBILITY FOR ANY USE OF OR RELIANCE ON THESE PLANS OR DRAWINGS BY ANY THIRD PARTY.

CONFIRM ALL DIMENSIONS ON SITE PRIOR TO CONSTRUCTION AND DO NOT SCALE FROM THE DRAWINGS. A ALL DIMENSIONS ARE IN METRES. A 10% OVERLAP IS TO BE MAINTAINED BETWEEN ALL DIMENSIONS. A 10% OVERLAP IS TO BE MAINTAINED BETWEEN ALL DIMENSIONS.

PRIOR TO ANY DEMOLITION, EXCAVATION OR CONSTRUCTION, THE CLIENT SHOULD BE ADVISED BY THE RELEVANT AUTHORITY THAT THE CLIENT IS RESPONSIBLE FOR OBTAINING ALL NECESSARY PERMITS AND APPROVALS FOR ALL SERVICES.

REFERENCES:



0 10 20 40 m 1:600 @ A3

AMENDMENTS:			
Date	Description	Checked	AD
23/01/2018	Client Draft	AD	
7/02/2018	Surplus fill area added	AD	
21/06/2018	Civil extent and amendments	AD	

CLIENT: PEET Limited

PROJECT:

Flagstone City - Stage 2-5 Phase 1 works

environmental management

PLAN OF:

Vegetation Management Plan

DATE: 21/06/2018 CHECKED: AD
JOB REF: 7833 DRAWN: TC
DRAWING No.: 8047 E 21 Stage 2 VMP C

Specimen Details										Canopy Condition Details							Trunk Condition Details					Fauna Details and Habitat Value						
Tree ID	Botanical Name	Common Name	Trunk DBH (mm)	Additional Trunks DBH (mm)	Total DBH (mm) (AS 4970-2009)	Height (m)	Spread (m)	Tree Protection Zone (m)	Structural Root Zone (m)	Canopy Form	Spreading	Thinning	Die-Back	Epicormic Growth	Lopped	Canopy Health	Leaning	Vines	Trunk Damage	Fire Damage	Trunk Health	Scats	Scratches	Hollows	Nest	Termite Nest	Habitat Value	Retention
1	Eucalyptus tereticornis	Forest Red Gum	580		580	24	8	7	3	Regular	-	-	-	-	-	Typical	-	-	-	-	Typical	-	-	-	-	-	-	Retain
16	DEAD/STAG		1250		1250	12	1	15	4	Regular	-	-	-	-	-	Typical	-	-	-	-	Typical	-	-	Large	-	-	High	Remove
40	Glochidion ferdinandi	Cheese Tree	200	180, 150	308	8	6	4	2	Regular	-	-	-	-	-	Typical	-	-	-	-	Typical	-	-	-	-	-	-	Retain
41	Eucalyptus tereticornis	Forest Red Gum	920		920	38	14	11	3	Regular	-	-	Die-back	-	-	Typical	-	-	-	-	Typical	-	-	-	-	-	-	Retain
42	Angophora subvelutina	Broad-leaved Apple	360		360	17	6	4	2	Regular	-	-	-	-	-	Typical	-	-	-	-	Typical	-	-	-	-	-	-	Retain
43	Eucalyptus tereticornis	Forest Red Gum	480		480	23	7	6	2	Regular	-	Thinning	Die-back	-	-	Typical	-	-	-	-	Typical	-	-	-	-	-	-	Remove - LCC sewer works
44	Lophostemon suaveolens	Swamp Box	340		340	15	6	4	2	Regular	-	-	-	-	-	Typical	-	-	-	-	Typical	-	-	-	-	-	-	Remove - LCC sewer works
45	Eucalyptus tereticornis	Forest Red Gum	400		400	25	7	5	2	Regular	-	-	-	-	-	Typical	-	-	-	-	Typical	-	-	-	-	-	-	Remove - LCC sewer works
46	Eucalyptus tereticornis	Forest Red Gum	620		620	28	11	7	3	Regular	-	-	-	-	-	Typical	-	-	-	-	Typical	-	-	-	-	-	-	Remove - LCC sewer works
47	Angophora subvelutina	Broad-leaved Apple	510		510	18	8	6	2	Regular	-	-	-	-	-	Typical	-	-	-	-	Typical	-	-	-	-	-	-	Remove - LCC sewer works
48	Eucalyptus tereticornis	Forest Red Gum	520		520	26	9	6	3	Regular	-	-	-	-	-	Typical	-	-	-	-	Typical	-	-	-	-	-	-	Remove - LCC sewer works
49	Corymbia tessellaris	Moreton Bay Ash	390		390	21	4	5	2	One-sided	-	Thinning	Die-back	-	-	Poor	-	-	-	-	Typical	-	-	-	-	-	-	Remove - LCC sewer works
50	Eucalyptus tereticornis	Forest Red Gum	400		400	19	5	5	2	Regular	-	-	Die-back	-	-	Typical	-	-	-	-	Typical	-	-	-	-	-	-	Remove - LCC sewer works
51	Eucalyptus tereticornis	Forest Red Gum	730		730	28	12	9	3	Regular	-	-	-	-	-	Typical	-	-	-	-	Typical	-	-	-	-	-	-	Remove - LCC sewer works
52	Eucalyptus tereticornis	Forest Red Gum	680		680	32	11	8	3	Regular	-	-	-	-	-	Typical	-	-	-	-	Typical	-	-	-	-	-	-	Remove - LCC sewer works
53	Lophostemon suaveolens	Swamp Box	380		380	16	6	5	2	Regular	-	-	-	-	-	Typical	-	-	-	-	Typical	-	-	-	-	-	-	Remove - LCC sewer works
54	Eucalyptus tereticornis	Forest Red Gum	620		620	36	12	7	3	Regular	-	-	-	-	-	Typical	-	-	-	-	Typical	-	-	-	-	-	-	Remove - LCC sewer works
55	Eucalyptus tereticornis	Forest Red Gum	540		540	28	7	6	3	Regular	-	Thinning	Die-back	-	-	Poor	-	-	-	-	Typical	-	-	-	-	-	-	Remove - LCC sewer works
56	Eucalyptus tereticornis	Forest Red Gum	620		620	33	12	7	3	Regular	-	-	-	-	-	Typical	-	-	-	-	Typical	-	-	-	-	-	-	Remove - LCC sewer works
57	Eucalyptus tereticornis	Forest Red Gum	320		320	23	6	4	2	One-sided	-	Thinning	Die-back	-	-	Typical	-	-	-	-	Typical	-	-	-	-	-	-	Remove - LCC sewer works
58	Eucalyptus tereticornis	Forest Red Gum	500		500	28	9	6	2	Regular	-	-	-	-	-	Typical	-	-	-	-	Typical	-	-	-	-	-	-	Remove - LCC sewer works
59	Eucalyptus tereticornis	Forest Red Gum	330		330	26	4	4	2	Regular	-	Thinning	Die-back	-	-	Poor	-	-	-	-	Typical	-	-	-	-	-	-	Remove - LCC sewer works
60	Corymbia tessellaris	Moreton Bay Ash	300		300	19	7	4	2	Regular	-	-	-	-	-	Typical	-	-	-	-	Typical	-	-	-	-	-	-	Remove - LCC sewer works
61	Eucalyptus tereticornis	Forest Red Gum	490		490	29	9	6	2	Regular	-	-	-	-	-	Typical	-	-	-	-	Typical	-	-	-	-	-	-	Remove - LCC sewer works
62	Angophora leiocarpa	Smooth-barked Apple	270		270	17	5	3	2	One-sided	-	-	-	-	-	Typical	-	-	-	-	Typical	-	-	-	-	-	-	Remove - LCC sewer works
63	DEAD/STAG		450		450	29	8	5	2	Regular	-	-	-	-	-	Typical	-	-	-	-	Typical	-	-	-	-	-	-	Remove - LCC sewer works
64	Eucalyptus tereticornis	Forest Red Gum	280		280	19	2	3	2	Regular	-	Thinning	Die-back	Epicormic	-	Poor	-	-	-	-	Typical	-	-	-	-	-	-	Remove - LCC sewer works
65	Corymbia citriodora	Spotted Gum	590	210	626	34	12	8	3	Regular	-	-	-	-	-	Typical	-	-	-	-	Typical	-	-	-	-	-	-	Remove - LCC sewer works
66	Eucalyptus tereticornis	Forest Red Gum	540		540	33	9	6	3	Regular	-	-	-	-	-	Typical	-	-	-	-	Typical	-	-	-	-	-	-	Remove - LCC sewer works
67	Corymbia citriodora	Spotted Gum	450		450	32	12	5	2	Regular	-	-	-	-	-	Typical	-	-	-	-	Typical	-	-	-	-	-	-	Remove - LCC sewer works
68	Corymbia trachyphloia	Brown Bloodwood	320		320	17	7	4	2	Regular	-	-	Die-back	-	-	Typical	-	-	Trunk Dmg.	-	Typical	-	-	-	-	-	-	Remove - LCC sewer works
69	Corymbia citriodora	Spotted Gum	480		480	23	7	6	2	Regular	-	-	-	-	-	Typical	-	-	Trunk Dmg.	-	Typical	-	-	-	-	-	-	Remove - LCC sewer works
70	Corymbia citriodora	Spotted Gum	500		500	32	9	6	2	Regular	-	-	Die-back	-	-	Typical	-	-	Trunk Dmg.	-	Typical	-	-	-	-	-	-	Remove - LCC sewer works
71	Corymbia citriodora	Spotted Gum	710		710	36	12	9	3	Regular	-	-	-	-	-	Typical	-	-	Trunk Dmg.	-	Typical	-	-	-	-	-	-	Remove - LCC sewer works
72	Corymbia citriodora	Spotted Gum	670		670	38	12	8	3	Regular	-	-	-	-	-	Typical	-	-	Trunk Dmg.	-	Typical	-	-	-	-	-	-	Remove - LCC sewer works
73	Corymbia citriodora	Spotted Gum	720		720	28	12	9	3	Regular	-	-	-	-	-	Typical	-	-	-	-	Typical	-	-	-	-	-	-	Remove - LCC sewer works
74	Corymbia citriodora	Spotted Gum	690		690	34	14	8	3	Regular	-	-	-	-	-	Typical	-	-	-	-	Typical	-	-	-	-	-	-	Remove - LCC sewer works
75	Eucalyptus tereticornis	Forest Red Gum	300		300	12	5	4	2	Regular	-	-	-	-	-	Typical	-	-	-	-	Typical	-	-	-	-	-	-	Remove - LCC sewer works
76	Eucalyptus tereticornis	Forest Red Gum	280		280	13	5	3	2	Regular	-	Thinning	-	-	-	Typical	-	-	-	-	Typical	-	-	-	-	-	-	Remove - LCC sewer works
77	Eucalyptus tereticornis	Forest Red Gum	940		940	21	7	11	3	Regular	-	-	-	-	-	Typical	-	-	-	-	Typical	-	-	-	-	-	-	Remove - LCC sewer works
78	Corymbia citriodora	Spotted Gum	550		550	25	7	7	3	Regular	-	-	Die-back	-	-	Typical	-	-	-	-	Typical	-	-	-	-	-	-	Remove - LCC sewer works
79	Eucalyptus tereticornis	Forest Red Gum	530		530	21	6	6	3	Regular	-	-	-	-	-	Typical	-	-	-	-	Typical	-	-	-	-	-	-	Remove - LCC sewer works
80	Angophora leiocarpa	Smooth-barked Apple	330		330	15	5	4	2	Regular	-	-	-	-	-	Typical	-	-	-	-	Typical	-	-	-	-	-	-	Remove - LCC sewer works
81	Corymbia citriodora	Spotted Gum	610		610	29	8	7	3	Regular	-	-	-	-	-	Typical	-	-	-	-	Typical	-	-	-	-	-	-	Remove - LCC sewer works
82	Corymbia citriodora	Spotted Gum	420		420	16	7	5	2	Regular	-	-	-	-	-	Typical	-	-	-	-	Typical	-	-	-	-	-	-	Remove - LCC sewer works
98	Lophostemon suaveolens	Swamp Box	370		370	22	8	4	2	Regular	-	-	-	-	-	Typical	-	-	-	-	Typical	-	-	-	-	-	-	Retain
100	Lophostemon suaveolens	Swamp Box	360		360	13	7	4	2	Regular	-	-	-	-	-	Typical	-	-	-	-	Typical	-	-	-	-	-	-	Retain
101	Melaleuca bracteata	Black Tea Tree	200		200	14	5	2	2	Regular	-	-	-	-	-	Typical	-	-	-	-	Typical	-	-	-	-	-	-	Retain
102	Lophostemon suaveolens	Swamp Box	530		530	14	8	6	3	Regular	-	-	-	-	-	Typical	-	-	Trunk Dmg.	-	Typical	-	-	-	-	-	-	Retain
103	Eucalyptus tereticornis	Forest Red Gum	420		420	25	7	5	2	Regular	-	-	-	-	-	Typical	-	-	-	-	Typical	-	-	-	-	-	-	Remove - LCC sewer works
104	Angophora subvelutina	Broad-leaved Apple	250		250	13	7	3	2	Regular	-	-	-	-	-	Typical	-	-	-	-	Typical	-	-	-	-	-	-	Retain
105	Eucalyptus tereticornis	Forest Red Gum	560		560	27	9	7	3	Regular	-	-	-	-	-	Typical	-	-	-	-	Typical	-	-	-	-	-	-	Retain
106	Eucalyptus tereticornis	Forest Red Gum	390		390	22	8	5	2	Regular	-	-	-	-	-	Typical	-	-	-	-	Typical	-	-	-	-			

Tree ID	Specimen Details								Canopy Condition Details							Trunk Condition Details					Fauna Details and Habitat Value							Retention
	Botanical Name	Common Name	Trunk DBH (mm)	Additional Trunks DBH (mm)	Total DBH (mm) [AS 4970-2009]	Height (m)	Spread (m)	Tree Protection Zone (m)	Structural Root Zone (m)	Canopy Form	Spreading	Thinning	Die-Back	Epicormic Growth	Lopped	Canopy Health	Leaning	Vines	Trunk Damage	Fire Damage	Trunk Health	Scats	Scratches	Hollows	Nest	Termite Nest	Habitat Value	
116	Lophostemon suaveolens	Swamp Box	200		200	14	6	2	2	Regular	-	-	-	-	-	Typical	-	-	-	-	Typical	-	-	-	-	-	-	Remove - LCC sewer works
117	Eucalyptus tereticornis	Forest Red Gum	460		460	27	9	6	2	Regular	-	-	-	-	-	Typical	-	-	-	-	Typical	-	-	-	-	-	-	Remove - LCC sewer works
118	Eucalyptus tereticornis	Forest Red Gum	370		370	23	8	4	2	Regular	-	-	-	-	-	Typical	-	-	-	-	Typical	-	-	-	-	-	-	Remove - LCC sewer works
119	Lophostemon suaveolens	Swamp Box	290		290	16	7	3	2	Regular	-	-	-	-	-	Typical	-	-	-	-	Typical	-	-	-	-	-	-	Remove - LCC sewer works
120	Lophostemon suaveolens	Swamp Box	230		230	16	6	3	2	Regular	-	-	-	-	-	Typical	-	-	-	-	Typical	-	-	-	-	-	-	Remove - LCC sewer works
121	Eucalyptus crebra	Narrow-leaved Ironbark	280		280	24	6	3	2	Regular	-	Thinning	Die-back	-	-	Poor	-	-	-	-	Typical	-	-	-	-	-	-	Remove - LCC sewer works
122	Acacia dispartima	Hickory Wattle	350	220	413	16	9	5	2	Regular	-	-	-	-	-	Typical	-	-	-	-	Typical	-	-	-	-	-	-	Remove - LCC sewer works
123	Acacia dispartima	Hickory Wattle	240		240	16	7	3	2	Regular	-	-	-	-	-	Typical	-	-	-	-	Typical	-	-	-	-	-	-	Remove - LCC sewer works
124	Acacia dispartima	Hickory Wattle	240		240	11	9	3	2	Regular	-	-	-	-	-	Typical	Major	-	-	-	Typical	-	-	-	-	-	-	Remove - LCC sewer works
125	Corymbia citriodora	Spotted Gum	200		200	17	2	2	2	Regular	-	-	-	-	-	Typical	-	-	-	-	Typical	-	-	-	-	-	-	Remove - LCC sewer works
126	Lophostemon suaveolens	Swamp Box	330		330	14	7	4	2	Regular	-	-	-	-	-	Typical	-	-	-	-	Typical	-	-	-	-	-	-	Remove - LCC sewer works
127	Acacia dispartima	Hickory Wattle	220	200	297	13	8	4	2	Regular	-	-	-	-	-	Typical	-	-	-	-	Typical	-	-	-	-	-	-	Remove - LCC sewer works
128	Eucalyptus moluccana	Gum Topped Box	240		240	18	6	3	2	Regular	-	-	-	-	-	Typical	-	-	-	-	Typical	-	-	-	-	-	-	Remove - LCC sewer works
129	Angophora leiocarpa	Smooth-barked Apple	260		260	17	6	3	2	Regular	-	-	-	-	-	Typical	-	-	-	-	Typical	-	-	-	-	-	-	Remove - LCC sewer works
130	Corymbia citriodora	Spotted Gum	220		220	18	5	3	2	Regular	-	-	-	-	-	Typical	-	-	-	-	Typical	-	-	-	-	-	-	Remove - LCC sewer works
131	Lophostemon suaveolens	Swamp Box	280		280	12	4	3	2	Regular	-	-	-	-	-	Typical	-	-	-	-	Typical	-	-	-	-	-	-	Remove - LCC sewer works
132	Alphitonia excelsa	Soap Tree	250		250	12	4	3	2	Regular	-	-	-	-	-	Typical	-	-	-	-	Typical	-	-	-	-	-	-	Remove - LCC sewer works
144	Lophostemon suaveolens	Swamp Box	280		280	13	4	3	2	Regular	-	-	-	-	-	Typical	-	-	-	-	Typical	-	-	-	-	-	-	Retain
145	Lophostemon suaveolens	Swamp Box	240		240	18	4	3	2	Regular	-	-	-	-	-	Typical	-	-	-	-	Typical	-	-	-	-	-	-	Retain
146	Casuarina cunninghamiana	River Sheoak	300		300	15	4	4	2	Regular	-	-	-	-	-	Typical	-	-	-	-	Typical	-	-	-	-	-	-	Retain
147	Eucalyptus tereticornis	Forest Red Gum	430		430	26	6	5	2	Regular	-	Thinning	-	-	-	Typical	-	-	-	-	Typical	-	-	-	-	-	-	Retain
148	Eucalyptus siderophloia	Grey Ironbark	360		360	25	9	4	2	Regular	-	-	-	-	-	Typical	-	-	-	-	Typical	-	-	-	-	-	-	Retain
149	Eucalyptus siderophloia	Grey Ironbark	440		440	31	12	5	2	Regular	-	-	-	-	-	Typical	-	-	Trunk Dmg.	-	Typical	-	-	-	-	-	-	Remove - LCC sewer works
150	Eucalyptus tereticornis	Forest Red Gum	290		290	24	6	3	2	Regular	-	Thinning	-	-	-	Typical	-	-	-	-	Typical	-	-	-	-	-	-	Remove - LCC sewer works
151	Eucalyptus tereticornis	Forest Red Gum	640		640	29	16	8	3	Regular	-	-	-	-	-	Typical	-	-	-	-	Typical	-	-	-	-	-	-	Remove - LCC sewer works
152	Eucalyptus tereticornis	Forest Red Gum	250		250	16	5	3	2	Regular	-	Thinning	Die-back	-	-	Typical	-	-	-	-	Typical	-	-	-	-	-	-	Remove - LCC sewer works
153	Eucalyptus tereticornis	Forest Red Gum	240		240	18	7	3	2	Regular	-	-	-	-	-	Typical	-	-	-	-	Typical	-	-	-	-	-	-	Remove - LCC sewer works
154	Eucalyptus tereticornis	Forest Red Gum	560		560	30	16	7	3	Regular	-	Thinning	-	-	-	Typical	-	-	-	-	Typical	-	-	-	-	-	-	Remove - LCC sewer works
155	Eucalyptus tereticornis	Forest Red Gum	280		280	25	5	3	2	Regular	-	Thinning	Die-back	-	-	Typical	-	-	-	-	Typical	-	-	-	-	-	-	Remove - LCC sewer works
156	Eucalyptus tereticornis	Forest Red Gum	350		350	30	6	4	2	Regular	-	Thinning	Die-back	-	-	Typical	-	-	-	-	Typical	-	-	-	-	-	-	Remove - LCC sewer works
157	Corymbia intermedia	Pink Bloodwood	270	260	375	18	5	4	2	Regular	-	Thinning	Die-back	-	-	Typical	-	-	-	-	Typical	-	-	-	-	-	-	Remove - LCC sewer works
158	Eucalyptus tereticornis	Forest Red Gum	320		320	28	7	4	2	Regular	-	-	-	-	-	Typical	-	-	-	-	Typical	-	-	-	-	-	-	Remove - LCC sewer works
159	Lophostemon suaveolens	Swamp Box	250		250	10	8	3	2	Regular	-	-	-	-	-	Typical	-	-	-	-	Typical	-	-	-	-	-	-	Remove - LCC sewer works
160	Lophostemon suaveolens	Swamp Box	210		210	11	3	3	2	Regular	-	-	-	-	-	Typical	-	-	-	-	Typical	-	-	-	-	-	-	Remove
161	Corymbia intermedia	Pink Bloodwood	265		265	15	5	3	2	Regular	-	-	-	-	-	Typical	-	-	-	-	Typical	-	-	-	-	-	-	Remove
162	Acacia dispartima	Hickory Wattle	250		250	10	4	3	2	Regular	-	-	-	-	-	Typical	-	-	-	-	Typical	-	-	-	-	-	-	Remove
163	Acacia dispartima	Hickory Wattle	260		260	11	4	3	2	One-sided	-	-	-	-	-	Typical	-	-	-	-	Typical	-	-	-	-	-	-	Remove
164	Corymbia intermedia	Pink Bloodwood	265		265	9	3	3	2	Regular	-	-	-	-	Lopped	Typical	-	-	-	-	Typical	-	-	-	-	-	-	Remove
165	Lophostemon suaveolens	Swamp Box	275		275	11	4	3	2	Regular	-	-	-	-	-	Typical	-	-	-	-	Typical	-	-	-	-	-	-	Remove
166	Acacia dispartima	Hickory Wattle	270		270	11	6	3	2	Regular	-	-	-	-	-	Typical	-	-	-	-	Typical	-	-	-	-	-	-	Remove
167	Lophostemon suaveolens	Swamp Box	285	210	354	12	5	4	2	Regular	-	-	-	-	-	Typical	-	-	-	-	Typical	-	-	-	-	-	-	Remove
168	Lophostemon suaveolens	Swamp Box	200		200	11	3	2	2	Regular	-	-	-	-	-	Typical	-	-	-	-	Typical	-	-	-	-	-	-	Remove
169	Angophora floribunda	Rough-barked Apple	365		365	18	6	4	2	Regular	-	-	-	-	-	Typical	-	-	-	-	Typical	-	-	-	-	-	-	Remove
170	Acacia dispartima	Hickory Wattle	210	150	258	13	7	3	2	Regular	-	-	-	-	-	Typical	-	-	-	-	Typical	-	-	-	-	-	-	Remove
171	Corymbia intermedia	Pink Bloodwood	200		200	16	4	2	2	Regular	-	-	-	-	-	Typical	-	-	-	-	Typical	-	-	-	-	-	-	Remove
172	Angophora floribunda	Rough-barked Apple	310		310	17	7	4	2	Regular	-	-	-	-	-	Typical	-	-	-	-	Typical	-	-	-	-	-	-	Remove
173	Acacia dispartima	Hickory Wattle	250		250	13	6	3	2	Regular	-	-	-	-	-	Typical	-	-	-	-	Typical	-	-	-	-	-	-	Remove
174	Eucalyptus tereticornis	Forest Red Gum	630		630	26	12	8	3	Regular	-	-	-	-	-	Typical	-	-	-	-	Typical	-	-	-	-	-	-	Remove
175	Casuarina cunninghamiana	River Sheoak	320		320	18	8	4	2	Regular	-	-	-	-	-	Typical	Minor	-	-	-	Typical	-	-	-	-	-	-	Remove
176	Casuarina cunninghamiana	River Sheoak	220		220	9	7	3	2	One-sided	-	-	-	-	-	Typical	Major	-	-	-	Typical	-	-	-	-	-	-	Remove
177	Casuarina cunninghamiana	River Sheoak	420		420	17	7	5	2	Regular	-	-	-	-	-	Typical	-	-	-	-	Typical	-	-	-	-	-	-	Remove
178	Melaleuca viminalis	Weeping Bottlebrush	220		220	12	6	3	2	Regular	-	-	-	-	-	Typical	-	-	-	-	Typical	-	-	-	-	-	-	Remove
179	Acacia dispartima	Hickory Wattle	200	190, 150	314	13	7	4	2	Regular	-	-	-	-	-	Typical	-	-	-	-	Typical	-	-	-	-	-	-	Remove
180	Eucalyptus tereticornis	Forest Red Gum	265		265	16	5	3	2	Regular	-	-	-	-	-	Typical	-	-	-	-	Typical	-	-	-	-	-	-	Remove
181	Eucalyptus tereticornis	Forest Red Gum	485		485	19	7	6	2	Regular	-	-	-	-	-	Typical	-	-	-	-	Typical	-	-	-	-	-	-	Remove
182	Lophostemon suaveolens	Swamp Box	200		200	12	3	2	2	Regular	-	-	-	-	-	Typical	-	-	-	-	Typical	-	-	-	-	-	-	Remove
183	Lophostemon suaveolens	Swamp Box	220		220	12	4	3	2	Regular	-	-	-	-	-	Typical	-	-	-	-	Typical	-	-	-	-	-	-	Remove
184	Lophostemon suaveolens	Swamp Box	320		320	13	5	4	2	Regular	-	-	-	-	-	Typical	-	-	-	-	Typical	-	-	-	-	-	-	Remove
185	Corymbia intermedia	Pink Bloodwood	560		560	26	10	7	3	Regular	-	-	-	-	-	Typical	-	-	-	-	Typical	-	-	-	-	-	-	Remove - LCC sewer works
186	Corymbia tessellaris	Moreton Bay Ash	330		330	24	6	4	2	Regular	-	-	-	-	-	Typical	-	-	-	-	Typical	-	-	-	-	-	-	Retain
187	Alphitonia excelsa	Soap Tree	190		190	11	4	2	2	Regular	-	-	-	-	-	Typical	-	-	-	-	Typical	-	-	-	-	-	-	Retain
188	Corymbia tessellaris	Moreton Bay Ash	200		200	4	2	2	2	Regular	-	-	-	-	Lopped	Typical	-	-	-	-	Typical	-	-	-	-	-	-	Retain
189	Angophora subvelutina	Broad-leaved Apple	520		520	20	11	6	3	Regular	-	-	-	-	-	Typical	-	-	-	-	Typical	-	-	-	-	-	-	Retain
190	Eucalyptus tereticornis	Forest Red Gum	600		600	27	12	7	3	Regular	-	-	-	-	-	Typical	-	-	-	-	Typical	-	-	-	-	-	-	Retain
191	Lophostemon suaveolens	Swamp Box	390		390	19	6	5	2	Regular	-	-	-	-	-	Typical	-	-	-	-	Typical							

Tree ID	Specimen Details						Canopy Condition Details								Trunk Condition Details					Fauna Details and Habitat Value							Retention	
	Botanical Name	Common Name	Trunk DBH (mm)	Additional Trunks DBH (mm)	Total DBH (mm) [AS 4970-2009]	Height (m)	Spread (m)	Tree Protection Zone (m)	Structural Root Zone (m)	Canopy Form	Spreading	Thinning	Die-Back	Epicormic Growth	Lopped	Canopy Health	Leaning	Vines	Trunk Damage	Fire Damage	Trunk Health	Scats	Scratches	Hollows	Nest	Termite Nest		Habitat Value
195	Angophora subvelutina	Broad-leaved Apple	290		290	20	8	3	2	Regular	-	-	-	-	-	Typical	-	-	-	-	Typical	-	-	-	-	-	-	Retain
196	Lophostemon suaveolens	Swamp Box	180		180	11	3	2	2	Regular	-	-	-	-	-	Typical	-	-	-	-	Typical	-	-	-	-	-	-	Retain
197	Lophostemon suaveolens	Swamp Box	320		320	17	6	4	2	Regular	-	-	-	-	-	Typical	-	-	-	-	Typical	-	-	-	-	-	-	Retain
198	Lophostemon suaveolens	Swamp Box	270		270	15	5	3	2	Regular	-	-	-	-	-	Typical	-	-	-	-	Typical	-	-	-	-	-	-	Retain
199	Corymbia tessellaris	Moreton Bay Ash	230		230	20	7	3	2	Regular	-	-	-	-	-	Typical	-	-	-	-	Typical	-	-	-	-	-	-	Retain
200	Corymbia tessellaris	Moreton Bay Ash	260		260	23	7	3	2	Regular	-	-	-	-	-	Typical	-	-	-	-	Typical	-	-	-	-	-	-	Retain
201	Acacia dispartima	Hickory Wattle	150		150	10	4	2	1	Regular	-	-	-	-	-	Typical	-	-	-	-	Typical	-	-	-	-	-	-	Retain
202	Eucalyptus crebra	Narrow-leaved Ironbark	160		160	9	3	2	2	Regular	-	-	-	-	-	Typical	-	-	-	-	Typical	-	-	-	-	-	-	Retain
203	Angophora subvelutina	Broad-leaved Apple	540		540	26	12	6	3	Regular	-	-	-	-	-	Typical	-	-	-	-	Typical	-	-	-	-	-	-	Retain
204	Angophora subvelutina	Broad-leaved Apple	450		450	26	8	5	2	Regular	-	-	-	-	-	Typical	-	-	-	-	Typical	-	-	-	-	-	-	Retain
205	Lophostemon suaveolens	Swamp Box	180		180	14	4	2	2	Regular	-	-	-	-	-	Typical	-	-	-	-	Typical	-	-	-	-	-	-	Retain
206	Corymbia tessellaris	Moreton Bay Ash	280		280	20	8	3	2	Regular	-	-	-	-	-	Typical	-	-	-	-	Typical	-	-	-	-	-	-	Retain
207	Corymbia tessellaris	Moreton Bay Ash	150		150	20	4	2	1	Regular	-	-	-	-	-	Typical	-	-	-	-	Typical	-	-	-	-	-	-	Retain
208	Eucalyptus tereticornis	Forest Red Gum	180		180	11	4	2	2	Regular	-	-	-	-	-	Typical	-	-	-	-	Typical	-	-	-	-	-	-	Remove - LCC sewer works
209	Eucalyptus crebra	Narrow-leaved Ironbark	450		450	26	8	5	2	Regular	-	-	-	-	-	Typical	-	-	-	-	Typical	-	-	-	-	-	-	Retain
210	Eucalyptus tereticornis	Forest Red Gum	380		380	26	8	5	2	Regular	-	-	-	-	-	Typical	-	-	-	-	Typical	-	-	-	-	-	-	Retain
211	Lophostemon suaveolens	Swamp Box	200		200	16	5	2	2	Regular	-	-	-	-	-	Typical	-	-	-	-	Typical	-	-	-	-	-	-	Retain
212	Corymbia intermedia	Pink Bloodwood	270	330	426	17	9	5	2	Regular	-	-	-	-	-	Typical	-	-	-	-	Typical	-	-	-	-	-	-	Retain
213	Eucalyptus tereticornis	Forest Red Gum	680		680	34	14	8	3	Regular	-	-	Die-back	-	-	Typical	-	-	-	-	Typical	-	-	-	-	-	-	Retain
214	Corymbia tessellaris	Moreton Bay Ash	450		450	27	10	5	2	Regular	-	-	-	-	-	Typical	-	-	-	-	Typical	-	-	-	-	-	-	Retain
215	Corymbia tessellaris	Moreton Bay Ash	380		380	25	6	5	2	One-sided	-	-	-	-	-	Typical	-	-	-	-	Typical	-	-	-	-	-	-	Retain
216	Angophora subvelutina	Broad-leaved Apple	600		600	27	12	7	3	Regular	-	-	-	-	-	Typical	-	-	-	-	Typical	-	-	-	-	-	-	Retain
240	Angophora subvelutina	Broad-leaved Apple	365		365	17	7	4	2	One-sided	-	-	-	-	-	Typical	-	-	-	-	Typical	-	-	-	-	-	-	Retain
241	Corymbia tessellaris	Moreton Bay Ash	660		660	28	9	8	3	Regular	-	Thinning	Die-back	-	-	Typical	-	-	Trunk Dmg.	-	Typical	-	-	-	-	-	-	Retain
242	Lophostemon suaveolens	Swamp Box	260		260	13	5	3	2	Regular	-	-	-	-	-	Typical	-	-	-	-	Typical	-	-	-	-	-	-	Retain
243	Corymbia tessellaris	Moreton Bay Ash	480		480	23	7	6	2	Regular	-	Thinning	Die-back	-	-	Poor	-	-	Trunk Dmg.	-	Typical	-	-	-	-	-	-	Retain
244	Corymbia tessellaris	Moreton Bay Ash	150		150	17	4	2	1	Regular	-	-	-	-	-	Typical	-	-	-	-	Typical	-	-	-	-	-	-	Retain
245	Lophostemon suaveolens	Swamp Box	220		220	11	5	3	2	Regular	-	-	-	-	-	Typical	-	-	-	-	Typical	-	-	-	-	-	-	Retain
246	Eucalyptus tereticornis	Forest Red Gum	190		190	15	4	2	2	Regular	-	-	-	-	-	Typical	-	-	-	-	Typical	-	-	-	-	-	-	Remove - LCC sewer works
247	Eucalyptus tereticornis	Forest Red Gum	690		690	32	14	8	3	Regular	-	-	-	-	-	Typical	-	-	-	-	Typical	-	-	-	-	-	-	Retain
248	Eucalyptus tereticornis	Forest Red Gum	200		200	16	4	2	2	Regular	-	-	-	-	-	Typical	-	-	-	-	Typical	-	-	-	-	-	-	Remove
249	Eucalyptus tereticornis	Forest Red Gum	520	260	581	23	9	7	3	Regular	-	-	-	-	-	Typical	-	-	-	-	Typical	-	-	-	-	-	-	Retain
250	Lophostemon suaveolens	Swamp Box	220	100	242	11	6	3	2	Regular	-	-	-	-	-	Typical	-	-	-	-	Typical	-	-	-	-	-	-	Retain
251	Lophostemon suaveolens	Swamp Box	285		285	13	6	3	2	Regular	-	-	-	-	-	Typical	-	-	-	-	Typical	-	-	-	-	-	-	Retain
339	Eucalyptus crebra	Narrow-leaved Ironbark	340		340	17	8	4	2	Regular	-	-	-	-	-	Typical	-	-	-	-	Typical	-	-	-	-	-	-	Remove
340	Angophora leiocarpa	Smooth-barked Apple	290		290	15	8	3	2	Regular	-	-	-	-	-	Typical	-	-	-	-	Typical	-	-	-	-	-	-	Remove
341	Angophora subvelutina	Broad-leaved Apple	290		290	13	8	3	2	Regular	-	-	-	-	-	Typical	-	-	-	-	Typical	-	-	-	-	-	-	Retain
342	Angophora subvelutina	Broad-leaved Apple	400		400	29	12	5	2	Regular	-	-	-	-	-	Typical	-	-	-	-	Typical	-	-	-	-	-	-	Retain
343	Corymbia tessellaris	Moreton Bay Ash	350		350	32	16	4	2	Regular	-	-	-	-	-	Typical	-	-	-	-	Typical	-	-	-	-	-	-	Retain
344	Angophora subvelutina	Broad-leaved Apple	550		550	28	16	7	3	Regular	-	-	-	-	-	Typical	-	-	-	-	Typical	-	-	-	-	-	-	Retain
345	Angophora subvelutina	Broad-leaved Apple	500		500	27	14	6	2	Regular	-	-	-	-	-	Typical	-	-	-	-	Typical	-	-	-	-	-	-	Retain
346	Angophora subvelutina	Broad-leaved Apple	370		370	25	11	4	2	Regular	-	-	-	-	-	Typical	-	-	-	-	Typical	-	-	-	-	-	-	Retain
347	Angophora subvelutina	Broad-leaved Apple	320		320	23	9	4	2	Regular	-	-	-	-	-	Typical	-	-	-	-	Typical	-	-	-	-	-	-	Retain
348	Melaleuca viminalis	Weeping Bottlebrush	400		400	20	10	5	2	Regular	-	-	-	-	-	Typical	-	Native	-	-	Typical	-	-	-	-	-	-	Retain
349	Eucalyptus saligna	Sydney Blue Gum	220		220	20	5	3	2	Regular	-	-	-	-	-	Typical	-	-	-	-	Typical	-	-	-	-	-	-	Remove
350	Corymbia intermedia	Pink Bloodwood	460		460	26	9	6	2	Regular	-	-	-	-	-	Typical	-	-	-	-	Typical	-	-	-	-	-	-	Retain
351	Corymbia tessellaris	Moreton Bay Ash	280		280	30	7	3	2	Regular	-	-	-	-	-	Typical	-	-	-	-	Typical	-	-	-	-	-	-	Retain
352	Angophora subvelutina	Broad-leaved Apple	470		470	23	12	6	2	Regular	-	-	-	-	-	Typical	-	-	-	-	Typical	-	-	-	-	-	-	Retain
353	Angophora subvelutina	Broad-leaved Apple	650		650	23	13	8	3	Regular	-	-	-	-	-	Typical	-	-	-	-	Typical	-	-	-	-	-	-	Retain
354	Eucalyptus tereticornis	Forest Red Gum	580		580	33	13	7	3	Regular	-	-	-	-	-	Typical	-	-	-	-	Typical	-	-	-	-	-	-	Retain
355	Lophostemon suaveolens	Swamp Box	360		360	15	4	4	2	Regular	-	-	-	-	-	Typical	-	-	-	-	Typical	-	-	-	-	-	-	Retain
356	Eucalyptus tereticornis	Forest Red Gum	360		360	20	3	4	2	Regular	-	-																

Tree ID	Specimen Details								Canopy Condition Details								Trunk Condition Details					Fauna Details and Habitat Value							Retention
	Botanical Name	Common Name	Trunk DBH (mm)	Additional Trunks DBH (mm)	Total DBH (mm) [AS 4970-2009]	Height (m)	Spread (m)	Tree Protection Zone (m)	Structural Root Zone (m)	Canopy Form	Spreading	Thinning	Die-Back	Epicormic Growth	Lopped	Canopy Health	Leaning	Vines	Trunk Damage	Fire Damage	Trunk Health	Scats	Scratches	Hollows	Nest	Termite Nest	Habitat Value		
373	Lophostemon suaveolens	Swamp Box	310		310	18	9	4	2	Regular	-	-	-	-	-	Typical	-	-	-	-	Typical	-	-	-	-	-	-	Retain	
374	Eucalyptus tereticornis	Forest Red Gum	700		700	33	19	8	3	Regular	-	-	-	-	-	Typical	-	-	-	-	Typical	-	-	-	-	-	-	Retain	
375	Angophora subvelutina	Broad-leaved Apple	520		520	30	15	6	3	Regular	-	-	-	-	-	Typical	-	-	-	-	Typical	-	-	-	-	-	-	Retain	
379	Lophostemon suaveolens	Swamp Box	330		330	10	5	4	2	Regular	-	-	-	-	-	Typical	-	-	-	-	Typical	-	-	-	-	-	-	Retain	
380	Lophostemon suaveolens	Swamp Box	320		320	12	6	4	2	Regular	-	-	-	-	-	Typical	-	-	-	-	Typical	-	-	-	-	-	-	Retain	
381	Acacia dispartima	Hickory Wattle	220		220	5	4	3	2	Regular	-	-	-	-	-	Typical	-	-	-	-	Typical	-	-	-	-	-	-	Retain	
382	Eucalyptus saligna	Sydney Blue Gum	270		270	13	4	3	2	Regular	-	-	-	-	-	Typical	-	-	-	-	Typical	-	-	-	-	-	-	Retain	
383	Lophostemon suaveolens	Swamp Box	230		230	12	3	3	2	Regular	-	-	-	-	-	Typical	-	-	-	-	Typical	-	-	-	-	-	-	Retain	
409	Angophora subvelutina	Broad-leaved Apple	250		250	24	13	3	2	Regular	-	-	-	-	-	Typical	-	-	-	-	Typical	-	-	-	-	-	-	Retain	
410	Angophora subvelutina	Broad-leaved Apple	260		260	15	10	3	2	Regular	-	-	-	-	-	Typical	-	-	-	-	Typical	-	-	-	-	-	-	Retain	
411	Angophora subvelutina	Broad-leaved Apple	450		450	26	12	5	2	Regular	-	-	-	-	-	Typical	-	-	-	-	Typical	-	-	-	-	-	-	Retain	
412	Eucalyptus tereticornis	Forest Red Gum	620		620	32	13	7	3	Regular	-	-	-	-	-	Typical	-	-	-	-	Typical	-	-	-	-	-	-	Retain	
413	Eucalyptus tereticornis	Forest Red Gum	450		450	33	16	5	2	Regular	-	-	-	-	-	Typical	-	-	-	-	Typical	-	-	-	-	-	-	Retain	
414	Angophora subvelutina	Broad-leaved Apple	450		450	26	11	5	2	Regular	-	-	-	-	-	Typical	-	-	-	-	Typical	-	-	-	-	-	-	Retain	
415	Eucalyptus tereticornis	Forest Red Gum	470		470	33	16	6	2	Regular	-	-	-	-	-	Typical	-	-	-	-	Typical	-	-	-	-	-	-	Retain	
416	Angophora subvelutina	Broad-leaved Apple	380		380	28	15	5	2	Regular	-	-	-	-	-	Typical	-	-	-	-	Typical	-	-	-	-	-	-	Retain	
417	Angophora leiocarpa	Smooth-barked Apple	260		260	19	8	3	2	Regular	-	-	-	-	-	Typical	-	-	-	-	Typical	-	-	-	-	-	-	Retain	
418	Corymbia citriodora	Spotted Gum	470		470	27	13	6	2	Regular	-	-	-	-	-	Typical	-	-	-	-	Typical	-	-	-	-	-	-	Retain	
419	Corymbia tessellaris	Moreton Bay Ash	230		230	17	9	3	2	Regular	-	-	-	-	-	Typical	-	-	-	-	Typical	-	-	-	-	-	-	Retain	
420	Eucalyptus tereticornis	Forest Red Gum	410		410	25	11	5	2	Regular	-	-	-	-	-	Typical	-	-	-	-	Typical	-	-	-	-	-	-	Retain	
421	Corymbia citriodora	Spotted Gum	470		470	26	13	6	2	Regular	-	-	-	-	-	Typical	-	-	-	-	Typical	-	-	-	-	-	-	Retain	
422	Eucalyptus moluccana	Gum Topped Box	450		450	30	14	5	2	Regular	-	-	-	-	-	Typical	-	-	-	-	Typical	-	-	Large	-	-	-	Retain	
423	Eucalyptus tereticornis	Forest Red Gum	390		390	25	10	5	2	Regular	-	-	-	-	-	Typical	-	-	-	-	Typical	-	-	-	-	-	-	Retain	
424	Corymbia citriodora	Spotted Gum	290		290	21	7	3	2	Regular	-	-	-	-	-	Typical	-	-	-	-	Typical	-	-	-	-	-	-	Retain	
425	Eucalyptus moluccana	Gum Topped Box	710		710	30	14	9	3	Regular	-	-	-	-	-	Typical	-	-	-	-	Typical	-	-	-	-	-	-	Retain	
426	Eucalyptus moluccana	Gum Topped Box	450	220	501	27	10	6	2	Regular	-	-	-	-	-	Typical	-	-	-	-	Typical	-	-	-	-	-	-	Retain	
429	Eucalyptus moluccana	Gum Topped Box	240		240	17	8	3	2	Regular	-	-	-	-	-	Typical	-	-	-	-	Typical	-	-	-	-	-	-	Retain	
430	Eucalyptus moluccana	Gum Topped Box	440		440	25	13	5	2	Regular	-	-	-	-	-	Typical	-	-	-	-	Typical	-	-	-	-	-	-	Retain	
431	Eucalyptus moluccana	Gum Topped Box	610		610	27	11	7	3	Regular	-	-	-	-	-	Typical	-	-	-	-	Typical	-	-	-	-	-	-	Retain	
432	Eucalyptus moluccana	Gum Topped Box	260		260	23	8	3	2	Regular	-	-	-	-	-	Typical	-	-	-	-	Typical	-	-	-	-	-	-	Retain	
433	Eucalyptus moluccana	Gum Topped Box	380		380	25	15	5	2	Regular	-	-	-	-	-	Typical	-	-	-	-	Typical	-	-	-	-	-	-	Retain	
434	Eucalyptus moluccana	Gum Topped Box	420	180	457	21	9	5	2	Regular	-	-	-	-	-	Typical	-	-	-	-	Typical	-	-	-	-	-	-	Retain	
435	Eucalyptus tereticornis	Forest Red Gum	240		240	20	5	3	2	Regular	-	-	-	-	-	Typical	-	-	-	-	Typical	-	-	-	-	-	-	Retain	
436	Angophora subvelutina	Broad-leaved Apple	330		330	15	9	4	2	Regular	-	-	-	-	-	Typical	-	-	-	-	Typical	-	-	-	-	-	-	Retain	
437	Eucalyptus tereticornis	Forest Red Gum	350		350	21	9	4	2	Regular	-	-	-	-	-	Typical	-	-	-	-	Typical	-	-	-	-	-	-	Retain	
438	Eucalyptus tereticornis	Forest Red Gum	390		390	27	15	5	2	Regular	-	-	-	-	-	Typical	-	-	-	-	Typical	-	-	-	-	-	-	Retain	
439	Eucalyptus tereticornis	Forest Red Gum	250		250	20	8	3	2	Regular	-	-	-	-	-	Typical	-	-	-	-	Typical	-	-	-	-	-	-	Retain	
440	Lophostemon suaveolens	Swamp Box	260		260	14	6	3	2	Regular	-	-	-	-	-	Typical	-	-	-	-	Typical	-	-	-	-	-	-	Retain	
441	Corymbia intermedia	Pink Bloodwood	450		450	26	11	5	2	Regular	-	-	-	-	-	Typical	-	-	-	-	Typical	-	-	-	-	-	-	Retain	
442	Eucalyptus tereticornis	Forest Red Gum	270		270	22	8	3	2	Regular	-	-	-	-	-	Typical	-	-	-	-	Typical	-	-	-	-	-	-	Retain	
586	Acacia concurrens	Black Wattle	220		220	11	3	3	2	Regular	-	-	-	-	-	Typical	-	-	-	-	Typical	-	-	-	-	-	-	Remove - LCC sewer works	
587	Lophostemon suaveolens	Swamp Box	210		210	16	7	3	2	Regular	-	-	-	-	-	Typical	-	-	-	-	Typical	-	-	-	-	-	-	Remove - LCC sewer works	
588	Alphitonia excelsa	Soap Tree	330		330	17	7	4	2	Regular	-	-	-	-	-	Typical	-	-	-	-	Typical	-	-	-	-	-	-	Remove - LCC sewer works	
589	Eucalyptus crebra	Narrow-leaved Ironbark	240		240	17	5	3	2	Regular	-	-	-	-	-	Typical	-	-	-	-	Typical	-	-	-	-	-	-	Remove - LCC sewer works	
590	Angophora subvelutina	Broad-leaved Apple	380		380	16	7	5	2	Regular	-	-	-	-	-	Typical	-	-	-	-	Typical	-	-	-	-	-	-	Remove - LCC sewer works	
591	Lophostemon suaveolens	Swamp Box	290		290	16	5	3	2	Regular	-	-	-	-	-	Typical	-	-	-	-	Typical	-	-	-	-	-	-	Retain	
592	Angophora subvelutina	Broad-leaved Apple	660		660	22	14	8	3	Regular	-	-	-	-	-	Typical	-	-	-	-	Typical	-	-	-	-	-	-	Retain	
593	Ficus coronata	Sandpaper Fig	200		200	8	6	2	2	Regular	-	-	-	-	-	Typical	-	-	-	-	Typical	-	-	-	-	-	-	Retain	
594	Angophora subvelutina	Broad-leaved Apple	390		390	18	8	5	2	Regular	-	-	-	-	-	Typical	-	-	-	-	Typical	-	-	-	-	-	-	Retain	
595	Angophora subvelutina	Broad-leaved Apple	400	320	512	17	9	6	2	Regular	-	-	-	-	-	Typical	-	-	-	-	Typical	-	-	-	-	-	-	Retain	
596	Melaleuca viminalis	Weeping Bottlebrush	300		300	12	4	4	2	Regular	-	-	-	-	-	Typical	-	Native	-	-	Typical	-	-	-	-	-	-	Retain	
597	Lophostemon suaveolens	Swamp Box	240		240	17	5	3	2	Regular	-	-	-	-	-	Typical	-	-	-	-	Typical	-	-	-	-	-	-	Retain	
598	Alphitonia excelsa	Soap Tree	390		390	10	5	5	2	One-sided	-	-	-	-	-	Typical	Major	Introduced	Trunk Dmg.	-	Poor	-	-	-	-	-	-	Retain	
599	Eucalyptus tereticornis	Forest Red Gum	600		600	25	8	7	3	Regular	-	-	-	-	-	Typical	-	-	-	-	Typical	-	-	-	-	-	-	Retain	
600	Acacia dispartima	Hickory Wattle	200		200	12	3	2	2	Regular	-	-	-	-	-	Typical	-	-	-	-	Typical	-	-	-	-	-	-	Retain	
601	Corymbia tessellaris	Moreton Bay Ash	300		300	19	5	4	2	Regular	-	-	-	-	-	Typical	-	-	-	-	Typical	-	-	-	-	-	-	Retain	
602	Lophostemon suaveolens	Swamp Box	280		280	16	6	3	2	Regular	-	-	-	-	-	Typical	-	-	-	-	Typical	-	-	-	-	-	-	Retain	
603	Lophostemon suaveolens	Swamp Box	200		200	12	4	2	2	Regular	-	-	-	-	-	Typical	-	-	-	-	Typical	-	-	-	-	-	-	Retain	
604	Acacia dispartima	Hickory Wattle	250	220	333	14	5	4	2	Regular	-	-	-	-	-	Typical	-	-	-	-	Typical	-	-	-	-	-	-	Retain	
605	Acacia dispartima	Hickory Wattle	280		280	13	4	3	2	Regular	-	-	-	-	-	Typical	-	-	-	-	Typical	-	-	-	-	-	-	Retain	
606	Corymbia tessellaris	Moreton Bay Ash	380		380	22	8	5	2	Regular	-	-	-	-	-	Typical	-	-	-	-	Typical	-	-	-	-	-	-	Retain	
607	Corymbia tessellaris	Moreton Bay Ash	320		320	17	5	4	2	Regular	-	-	-	-	-	Typical	-	-	-	-	Typical	-	-	-	-	-	-	Retain	
608	Acacia dispartima	Hickory Wattle	280		280	10	6	3	2	Regular	-	-	-	-	-	Typical	-	-	-	-	Typical	-	-	-	-	-	-	Retain	
609	Eucalyptus tereticornis	Forest Red Gum	560		560	24	9	7	3	Regular	-	-	-	-	-	Typical	-	-	-	-	Typical	-	-	-	-	-	-	Retain	
610	Corymbia tessellaris	Moreton Bay Ash	280		280	21	7	3	2	Regular	-	-	-	-	-	Typical	-	-	-	-	Typical	-	-	-	-	-	-	Retain	
611	Melaleuca viminalis	We																											

Tree ID	Specimen Details								Canopy Condition Details								Trunk Condition Details					Fauna Details and Habitat Value							Retention
	Botanical Name	Common Name	Trunk DBH (mm)	Additional Trunks DBH (mm)	Total DBH (mm) (AS 4970-2009)	Height (m)	Spread (m)	Tree Protection Zone (m)	Structural Root Zone (m)	Canopy Form	Spreading	Thinning	Die-Back	Epicormic Growth	Lopped	Canopy Health	Leaning	Vines	Trunk Damage	Fire Damage	Trunk Health	Scats	Scratches	Hollows	Nest	Termite Nest	Habitat Value		
614	Casuarina cunninghamiana	River Sheoak	480		480	20	10	6	2	Regular	-	-	-	-	-	Typical	-	-	-	-	Typical	-	-	-	-	-	-	Retain	
615	Casuarina cunninghamiana	River Sheoak	400		400	24	10	5	2	Regular	-	-	-	-	-	Typical	-	-	-	-	Typical	-	-	-	-	-	-	Retain	
616	Casuarina cunninghamiana	River Sheoak	330		330	18	8	4	2	Regular	-	-	-	-	-	Typical	-	-	-	-	Typical	-	-	-	-	-	-	Retain	
617	Acacia dispartima	Hickory Wattle	330		330	12	5	4	2	Regular	-	Thinning	Die-back	-	-	Poor	-	-	-	-	Typical	-	-	-	-	-	-	Retain	
618	Corymbia intermedia	Pink Bloodwood	300		300	18	6	4	2	Regular	-	-	-	-	-	Typical	-	Native	-	-	Typical	-	-	-	-	-	-	Retain	
619	Acacia dispartima	Hickory Wattle	230		230	16	6	3	2	Regular	-	-	-	-	-	Typical	-	-	-	-	Typical	-	-	-	-	-	-	Retain	
620	Angophora subvelutina	Broad-leaved Apple	550		550	20	10	7	3	Regular	-	-	-	-	-	Typical	-	-	-	-	Typical	-	-	-	-	-	-	Retain	
621	Lophostemon suaveolens	Swamp Box	300		300	16	6	4	2	Regular	-	-	-	-	-	Typical	-	-	-	-	Typical	-	-	-	-	-	-	Retain	
622	Lophostemon suaveolens	Swamp Box	350		350	17	7	4	2	Regular	-	-	-	-	-	Typical	-	-	-	-	Typical	-	-	-	-	-	-	Retain	
623	Alphitonia excelsa	Soap Tree	200		200	11	4	2	2	Regular	-	-	-	-	-	Typical	-	-	-	-	Typical	-	-	-	-	-	-	Retain	
624	Corymbia tessellaris	Moreton Bay Ash	230		230	18	4	3	2	Regular	-	Thinning	-	-	-	Typical	-	-	-	-	Typical	-	-	-	-	-	-	Retain	
625	Eucalyptus tereticornis	Forest Red Gum	550		550	23	9	7	3	Regular	-	-	-	-	-	Typical	-	-	-	-	Typical	-	-	-	-	-	-	Retain	
626	Eucalyptus tereticornis	Forest Red Gum	300		300	24	8	4	2	Regular	-	-	-	-	-	Typical	-	-	-	-	Typical	-	-	-	-	-	-	Retain	
627	Eucalyptus tereticornis	Forest Red Gum	270		270	17	5	3	2	Regular	-	-	-	-	-	Typical	-	-	-	-	Typical	-	-	-	-	-	-	Retain	
628	Lophostemon suaveolens	Swamp Box	210		210	13	3	3	2	Regular	-	-	-	-	-	Typical	-	-	-	-	Typical	-	-	-	-	-	-	Retain	
629	Eucalyptus tereticornis	Forest Red Gum	300		300	17	4	4	2	Regular	-	-	-	-	-	Typical	-	-	-	-	Typical	-	-	-	-	-	-	Retain	
630	Eucalyptus crebra	Narrow-leaved Ironbark	200		200	16	4	2	2	Regular	-	-	-	-	-	Typical	-	-	-	-	Typical	-	-	-	-	-	-	Retain	
631	Corymbia tessellaris	Moreton Bay Ash	250		250	17	4	3	2	Regular	-	Thinning	-	-	-	Typical	-	-	-	-	Typical	-	-	-	-	-	-	Retain	
632	Corymbia tessellaris	Moreton Bay Ash	200		200	17	3	2	2	Regular	-	-	-	-	-	Typical	-	-	-	-	Typical	-	-	-	-	-	-	Retain	
633	Lophostemon suaveolens	Swamp Box	270		270	17	5	3	2	Regular	-	-	-	-	-	Typical	-	-	-	-	Typical	-	-	-	-	-	-	Retain	
634	Lophostemon suaveolens	Swamp Box	250		250	17	5	3	2	Regular	-	-	-	-	-	Typical	-	-	-	-	Typical	-	-	-	-	-	-	Retain	
635	Eucalyptus major	Grey Gum	450		450	25	12	5	2	Regular	-	-	-	-	-	Typical	-	-	-	-	Typical	-	-	-	-	-	-	Retain	
636	Lophostemon suaveolens	Swamp Box	200		200	15	5	2	2	Regular	-	-	-	-	-	Typical	-	-	-	-	Typical	-	-	-	-	-	-	Retain	
637	Lophostemon suaveolens	Swamp Box	250		250	13	4	3	2	One-sided	-	-	-	-	-	Typical	-	-	-	-	Typical	-	-	-	-	-	-	Retain	
638	Lophostemon suaveolens	Swamp Box	220		220	15	5	3	2	Regular	-	-	-	-	-	Typical	-	-	-	-	Typical	-	-	-	-	-	-	Retain	
639	Eucalyptus tereticornis	Forest Red Gum	200		200	12	4	2	2	Regular	-	Thinning	-	-	-	Typical	-	-	-	-	Typical	-	-	-	-	-	-	Retain	
640	Corymbia tessellaris	Moreton Bay Ash	300		300	19	5	4	2	One-sided	-	Thinning	-	-	-	Typical	-	-	-	-	Typical	-	-	-	-	-	-	Retain	
641	Angophora subvelutina	Broad-leaved Apple	270		270	15	9	3	2	Regular	-	-	-	-	-	Typical	-	-	-	-	Typical	-	-	-	-	-	-	Retain	
642	Lophostemon suaveolens	Swamp Box	280		280	18	8	3	2	Regular	-	-	-	-	-	Typical	-	-	-	-	Typical	-	-	-	-	-	-	Retain	
643	Lophostemon suaveolens	Swamp Box	290		290	18	6	3	2	Regular	-	-	-	-	-	Typical	-	-	-	-	Typical	-	-	-	-	-	-	Retain	
644	Eucalyptus tereticornis	Forest Red Gum	600		600	25	10	7	3	Regular	-	-	-	-	-	Typical	-	-	-	-	Typical	-	-	-	-	-	-	Retain	
645	Lophostemon suaveolens	Swamp Box	200		200	14	4	2	2	Regular	-	-	-	-	-	Typical	-	-	-	-	Typical	-	-	-	-	-	-	Retain	
646	Eucalyptus tereticornis	Forest Red Gum	450		450	27	14	5	2	Regular	-	-	-	-	-	Typical	-	-	-	-	Typical	-	-	-	-	-	-	Retain	
647	Eucalyptus tereticornis	Forest Red Gum	660		660	28	10	8	3	Regular	-	-	-	-	-	Typical	-	-	-	-	Typical	-	-	-	-	-	-	Retain	
648	Lophostemon suaveolens	Swamp Box	200		200	13	3	2	2	Regular	-	-	-	-	-	Typical	-	-	-	-	Typical	-	-	-	-	-	-	Remove	
649	Casuarina cunninghamiana	River Sheoak	430		430	18	7	5	2	Regular	-	-	-	-	-	Typical	-	-	-	-	Typical	-	-	-	-	-	-	Retain	
650	Casuarina cunninghamiana	River Sheoak	280		280	19	6	3	2	Regular	-	-	-	-	-	Typical	-	-	-	-	Typical	-	-	-	-	-	-	Remove	
651	Casuarina cunninghamiana	River Sheoak	350		350	22	10	4	2	Regular	-	-	-	-	-	Typical	-	-	-	-	Typical	-	-	-	-	-	-	Remove	
652	Casuarina cunninghamiana	River Sheoak	300		300	18	7	4	2	One-sided	-	-	-	-	-	Typical	-	-	-	-	Typical	-	-	-	-	-	-	Remove	
653	Casuarina cunninghamiana	River Sheoak	500		500	22	12	6	2	Regular	-	-	-	-	-	Typical	-	-	-	-	Typical	-	-	-	-	-	-	Remove	
654	Casuarina cunninghamiana	River Sheoak	370		370	19	4	4	2	Regular	-	Thinning	Die-back	-	-	Poor	-	-	-	-	Typical	-	-	-	-	-	-	Remove	
655	Casuarina cunninghamiana	River Sheoak	400		400	20	9	5	2	Regular	-	-	-	-	-	Typical	-	-	-	-	Typical	-	-	-	-	-	-	Remove	
656	Casuarina cunninghamiana	River Sheoak	200		200	15	5	2	2	One-sided	-	Thinning	Die-back	-	-	Poor	-	-	-	-	Typical	-	-	-	-	-	-	Retain	
657	Casuarina cunninghamiana	River Sheoak	400		400	20	9	5	2	Regular	-	-	-	-	-	Typical	-	-	-	-	Typical	-	-	-	-	-	-	Retain	
658	Casuarina cunninghamiana	River Sheoak	210		210	17	4	3	2	Regular	-	Thinning	Die-back	-	-	Poor	-	-	-	-	Typical	-	-	-	-	-	-	Retain	
659	Casuarina cunninghamiana	River Sheoak	240		240	10	5	3	2	One-sided	-	-	-	-	-	Typical	Major	-	-	-	Typical	-	-	-	-	-	-	Retain	
660	Casuarina cunninghamiana	River Sheoak	360		360	20	8	4	2	Regular	-	-	-	-	-	Typical	-	-	-	-	Typical	-	-	-	-	-	-	Retain	
661	Casuarina cunninghamiana	River Sheoak	400		400	15	6	5	2	Regular	-	-	-	-	-	Typical	-	-	-	-	Typical	-	-	-	-	-	-	Retain	
662	Acacia dispartima	Hickory Wattle	200		200	10	5	2	2	Regular	-	-	-	-	-	Typical	-	-	-	-	Typical	-	-	-	-	-	-	Retain	
663	Lophostemon suaveolens	Swamp Box	290		290	15	4	3	2	Regular	-	-	-	-	-	Typical	-	-	-	-	Typical	-	-	-	-	-	-	Retain	
664	Casuarina cunninghamiana	River Sheoak	330		330	20	7	4	2	Regular	-	-	-	-	-	Typical	-	-	-	-	Typical	-	-	-	-	-	-	Retain	
665	Lophostemon suaveolens	Swamp Box	310		310	17	7	4	2	Regular	-	-	-	-	-	Typical	-	-	-	-	Typical	-	-	-	-	-	-	Retain	
671	Eucalyptus tereticornis	Forest Red Gum	310		310	15	4	4	2	Regular	-	-	-	-	-	Typical	-	-	-	-	Typical	-	-	-	-	-	-	Retain	
672	Eucalyptus tereticornis	Forest Red Gum	240		240	18	6	3	2	Regular	-	-	-	-	-	Typical	-	-	-	-	Typical	-	-	-	-	-	-	Retain	
673	Eucalyptus tereticornis	Forest Red Gum	200		200	17	5	2	2	Regular	-	-	-	-	-	Typical	-	-	-	-	Typical	-	-	-	-	-	-	Retain	
674	Eucalyptus tereticornis	Forest Red Gum	230		230	18	5	3	2	Regular	-	-	-	-	-	Typical	-	-	-	-	Typical	-	-	-	-	-	-	Retain	
675	Lophostemon suaveolens	Swamp Box	230		230	16	3	3	2	Regular	-	-	-	-	-	Typical	-	-	-	-	Typical	-	-	-	-	-	-	Retain	
676	Corymbia tessellaris	Moreton Bay Ash	230		230	17	5	3	2	Regular	-	-	-	-	-	Typical	-	-	-	-	Typical	-	-	-	-	-	-	Retain	
677	Lophostemon suaveolens	Swamp Box	210		210	12	4	3	2	Regular	-	-	-	-	-	Typical	-	-	-	-	Typical	-	-	-	-	-	-	Retain	
678	Eucalyptus tereticornis	Forest Red Gum	380		380	19	4	5	2	Regular	-	Thinning	-	Epicormic	-	Poor	-	-	-	-	Typical	-	-	-	-	-	-	Retain	
720	Casuarina cunninghamiana	River Sheoak	400		400	22	12	5	2	Regular	-	-	-	-	-	Typical	-	-	-	-	Typical	-	-	-	-	-	-	Retain	
721	Casuarina cunninghamiana	River Sheoak	360		360	20	10	4	2	Regular	-	-	-	-	-	Typical	-	-	-	-	Typical	-	-	-	-	-	-	Retain	
722	Casuarina cunninghamiana	River Sheoak	400		400	19	5	5	2	Regular	-	Thinning	Die-back	-	-	Poor	-	-	Trunk Dmg.	-	Typical	-	-	-	-	-	-	Retain	
723	Casuarina cunninghamiana	River Sheoak	460		460	20	8	6	2	Regular	-	Thinning	Die-back	-	-	Typical	-	-	-	-	Typical	-	-	-	-	-	-	Retain	
724	Casuarina cunninghamiana	River Sheoak	400		400	21	5	5	2	Regular	-	Thinning	Die-back	-	-	Poor	-	-	-	-	Typical	-	-	-	-	-	-	Retain	
725	Casuarina cunninghamiana	River Sheoak	350	380	517																								

Tree ID	Specimen Details								Canopy Condition Details							Trunk Condition Details					Fauna Details and Habitat Value							
	Botanical Name	Common Name	Trunk DBH (mm)	Additional Trunks DBH (mm)	Total DBH (mm) [AS 4970-2009]	Height (m)	Spread (m)	Tree Protection Zone (m)	Structural Root Zone (m)	Canopy Form	Spreading	Thinning	Die-Back	Epicormic Growth	Lopped	Canopy Health	Leaning	Vines	Trunk Damage	Fire Damage	Trunk Health	Scats	Scratches	Hollows	Nest	Termite Nest	Habitat Value	Retention
728	Corymbia tessellaris	Moreton Bay Ash	410		410	30	14	5	2	Regular	-	-	-	-	-	Typical	-	-	-	-	Typical	-	-	-	-	-	-	Retain
729	Casuarina cunninghamiana	River Sheoak	460		460	20	9	6	2	Regular	-	-	-	-	-	Typical	-	-	-	-	Typical	-	-	-	-	-	-	Retain
730	Casuarina cunninghamiana	River Sheoak	240		240	18	8	3	2	Regular	-	-	-	-	-	Typical	-	-	-	-	Typical	-	-	-	-	-	-	Retain
731	Eucalyptus tereticornis	Forest Red Gum	460		460	22	10	6	2	Regular	-	-	-	-	-	Typical	-	-	-	-	Typical	-	-	-	-	-	-	Retain
732	Angophora subvelutina	Broad-leaved Apple	360		360	18	7	4	2	Regular	-	-	-	-	-	Typical	-	-	-	-	Typical	-	-	-	-	-	-	Retain
733	Lophostemon suaveolens	Swamp Box	200		200	12	5	2	2	Regular	-	-	-	-	-	Typical	-	-	-	-	Typical	-	-	-	-	-	-	Retain
734	Corymbia tessellaris	Moreton Bay Ash	220		220	17	5	3	2	Regular	-	-	-	-	-	Typical	-	-	-	-	Typical	-	-	-	-	-	-	Retain
735	Angophora leiocarpa	Smooth-barked Apple	200		200	20	5	2	2	Regular	-	-	-	-	-	Typical	-	-	-	-	Typical	-	-	-	-	-	-	Retain
736	Eucalyptus tereticornis	Forest Red Gum	250		250	18	7	3	2	Regular	-	-	-	-	-	Typical	-	-	-	-	Typical	-	-	-	-	-	-	Retain
737	Corymbia citriodora	Spotted Gum	400		400	24	10	5	2	Regular	-	-	-	-	-	Typical	-	-	-	-	Typical	-	-	-	-	-	-	Retain
738	Corymbia citriodora	Spotted Gum	340	160	376	24	8	5	2	Regular	-	-	-	-	-	Typical	-	-	-	-	Typical	-	-	-	-	-	-	Retain
739	Eucalyptus tereticornis	Forest Red Gum	650		650	25	9	8	3	Regular	-	-	-	-	-	Typical	-	-	-	-	Typical	-	-	-	-	-	-	Retain
740	Corymbia citriodora	Spotted Gum	260		260	21	6	3	2	Regular	-	-	-	-	-	Typical	-	-	-	-	Typical	-	-	-	-	-	-	Retain
741	Eucalyptus moluccana	Gum Topped Box	600		600	25	14	7	3	Regular	-	-	-	-	-	Typical	-	-	-	-	Typical	-	-	-	-	-	-	Retain
742	Corymbia citriodora	Spotted Gum	440		440	29	8	5	2	Regular	-	-	-	-	-	Typical	-	-	-	-	Typical	-	-	-	-	-	-	Retain
743	Lophostemon suaveolens	Swamp Box	280		280	16	5	3	2	Regular	-	Thinning	-	-	-	Typical	-	-	-	-	Typical	-	-	-	-	-	-	Retain
744	Eucalyptus moluccana	Gum Topped Box	800		800	28	10	10	3	Regular	-	Thinning	-	-	-	Typical	-	-	-	-	Typical	-	-	-	-	-	-	Retain
745	Eucalyptus moluccana	Gum Topped Box	560		560	27	7	7	3	Regular	-	Thinning	-	-	-	Typical	-	-	-	-	Typical	-	-	-	-	-	-	Retain
746	Eucalyptus moluccana	Gum Topped Box	600		600	29	10	7	3	Regular	-	-	-	-	-	Typical	-	-	-	-	Typical	-	-	-	-	-	-	Retain
747	Angophora leiocarpa	Smooth-barked Apple	410		410	19	4	5	2	Regular	-	Thinning	Die-back	Epicormic	-	Poor	-	-	-	-	Typical	-	-	-	-	-	-	Retain
748	Eucalyptus moluccana	Gum Topped Box	400		400	22	8	5	2	One-sided	-	-	-	-	-	Typical	-	-	-	-	Typical	-	-	-	-	-	-	Retain
749	Eucalyptus moluccana	Gum Topped Box	510		510	24	10	6	2	Regular	-	-	-	-	-	Typical	-	-	-	-	Typical	-	-	-	-	-	-	Retain
750	Eucalyptus moluccana	Gum Topped Box	440		440	22	8	5	2	Regular	-	-	-	-	-	Typical	-	-	-	-	Typical	-	-	-	-	-	-	Retain
751	Eucalyptus moluccana	Gum Topped Box	220		220	19	3	3	2	Regular	-	Thinning	-	-	-	Typical	-	-	-	-	Typical	-	-	-	-	-	-	Retain
752	Lophostemon suaveolens	Swamp Box	220		220	12	4	3	2	Regular	-	-	-	-	-	Typical	-	-	-	-	Typical	-	-	-	-	-	-	Retain
753	Eucalyptus moluccana	Gum Topped Box	220		220	16	4	3	2	Regular	-	-	-	-	-	Typical	-	-	-	-	Typical	-	-	-	-	-	-	Retain
754	Eucalyptus moluccana	Gum Topped Box	220		220	19	6	3	2	Regular	-	-	-	-	-	Typical	-	-	-	-	Typical	-	-	-	-	-	-	Retain
755	Eucalyptus moluccana	Gum Topped Box	400		400	30	9	5	2	One-sided	-	-	-	-	-	Typical	-	-	-	-	Typical	-	-	-	-	-	-	Retain
756	Eucalyptus moluccana	Gum Topped Box	510		510	26	8	6	2	Regular	-	-	-	-	-	Typical	-	-	-	-	Typical	-	-	-	-	-	-	Retain
757	Eucalyptus moluccana	Gum Topped Box	290	150	326	27	6	4	2	Regular	-	-	-	-	-	Typical	-	-	-	-	Typical	-	-	-	-	-	-	Retain
758	Eucalyptus moluccana	Gum Topped Box	400		400	20	7	5	2	Regular	-	-	-	-	-	Typical	-	-	-	-	Typical	-	-	-	-	-	-	Retain
759	Eucalyptus moluccana	Gum Topped Box	420		420	26	8	5	2	Regular	-	-	-	-	-	Typical	-	-	-	-	Typical	-	-	-	-	-	-	Retain
760	Eucalyptus moluccana	Gum Topped Box	350		350	19	4	4	2	Regular	-	Thinning	-	-	-	Typical	-	-	-	-	Typical	-	-	-	-	-	-	Retain
761	Eucalyptus moluccana	Gum Topped Box	430		430	27	9	5	2	Regular	-	-	-	-	-	Typical	-	-	-	-	Typical	-	-	-	-	-	-	Retain
762	Eucalyptus moluccana	Gum Topped Box	540		540	27	13	6	3	Regular	-	-	-	-	-	Typical	-	-	-	-	Typical	-	-	-	-	-	-	Retain
763	Eucalyptus moluccana	Gum Topped Box	470		470	30	8	6	2	Regular	-	-	-	-	-	Typical	-	-	-	-	Typical	-	-	-	-	-	-	Retain
764	Eucalyptus tereticornis	Forest Red Gum	230		230	17	4	3	2	Regular	-	-	-	-	-	Typical	-	-	-	-	Typical	-	-	-	-	-	-	Retain
765	Acacia dispartima	Hickory Wattle	230		230	8	3	3	2	Regular	-	Thinning	Die-back	-	-	Poor	Major	-	-	-	Typical	-	-	-	-	-	-	Retain
766	Corymbia intermedia	Pink Bloodwood	230		230	16	5	3	2	Regular	-	-	-	-	-	Typical	-	-	-	-	Typical	-	-	-	-	-	-	Retain
767	Lophostemon suaveolens	Swamp Box	230		230	14	4	3	2	One-sided	-	-	-	-	-	Typical	Minor	-	-	-	Typical	-	-	-	-	-	-	Retain
768	Lophostemon suaveolens	Swamp Box	240		240	16	4	3	2	Regular	-	-	-	-	-	Typical	-	-	-	-	Typical	-	-	-	-	-	-	Retain
769	Eucalyptus tereticornis	Forest Red Gum	520		520	21	9	6	3	Regular	-	-	-	-	-	Typical	-	-	-	-	Typical	-	-	-	-	-	-	Retain
770	Eucalyptus tereticornis	Forest Red Gum	200		200	16	4	2	2	Regular	-	-	-	-	-	Typical	-	-	-	-	Typical	-	-	-	-	-	-	Remove
771	Eucalyptus tereticornis	Forest Red Gum	520	260	581	23	9	7	3	Regular	-	-	-	-	-	Typical	-	-	-	-	Typical	-	-	-	-	-	-	Retain
874	Corymbia citriodora	Spotted Gum	240		240	19	3	3	2	Regular	-	-	-	-	-	Typical	-	-	-	-	Typical	-	-	-	-	-	-	Retain
875	Corymbia citriodora	Spotted Gum	240		240	18	4	3	2	Regular	-	-	-	-	-	Typical	-	-	-	-	Typical	-	-	-	-	-	-	Retain
876	Eucalyptus crebra	Narrow-leaved Ironbark	280		280	20	6	3	2	Regular	-	-	-	-	-	Typical	-	-	-	-	Typical	-	-	-	-	-	-	Retain
877	Eucalyptus crebra	Narrow-leaved Ironbark	210		210	16	3	3	2	Regular	-	-	-	-	-	Typical	-	-	-	-	Typical	-	-	-	-	-	-	Retain
878	Corymbia citriodora	Spotted Gum	250		250	18	5	3	2	Regular	-	-	-	-	-	Typical	-	-	-	-	Typical	-	-	-	-	-	-	Retain
879	Eucalyptus crebra	Narrow-leaved Ironbark	550		550	24	10	7	3	Regular	-	-	-	-	-	Typical	-	-	Trunk Dmg.	-	Typical	-	-	-	-	-	-	Retain
880	Corymbia citriodora	Spotted Gum	200		200	17	3	2	2	Regular	-	Thinning	Die-back	Epicormic	-	Poor	-	-	-	-	Typical	-	-	-	-	-	-	Retain
881	Corymbia citriodora	Spotted Gum	200		200	17	3	2	2	Regular	-	-	-	-	-	Typical	-	-	-	-	Typical	-	-	-	-	-	-	Retain
882	Eucalyptus moluccana	Gum Topped Box	280		280	17	5	3	2	Regular	-	-	-	-	-	Typical	-	-	-	-	Typical	-	-	-	-	-	-	Retain
883	Corymbia citriodora	Spotted Gum	230	150, 80	286	16	4	3	2	Regular	-	-	-	-	Lopped	Typical	-	-	-	-	Typical	-	-	-	-	-	-	Retain
884	Corymbia citriodora	Spotted Gum	270		270	17	5	3	2	Regular	-	-	-	-	-	Typical	-	-	-	-	Typical	-	-	-	-	-	-	Retain
885	Corymbia citriodora	Spotted Gum	320		320	19	6	4	2	Regular	-	-	-	-	-	Typical	-	-	-	-	Typical	-	-	-	-	-	-	Retain
886	Corymbia citriodora	Spotted Gum	250		250	17	7	3	2	Regular	-	-	-	-	-	Typical	-	-	-	-	Typical	-	-	-	-	-	-	Retain
889	Corymbia citriodora	Spotted Gum	360	180	402	22	6	5	2	Regular	-	-	-	-	-	Typical	-	-	-	-	Typical	-	-	-	-	-	-	Retain
890	Corymbia citriodora	Spotted Gum	220		220	14	3	3	2	Regular	-	-	-	-	-	Typical	-	-	-	-	Typical	-	-	-	-	-	-	Retain
892	Corymbia citriodora	Spotted Gum	270		270	18	5	3	2	Regular	-	-	-	-	-	Typical	-	-	-	-	Typical	-	-	-	-	-	-	Retain
893	Corymbia citriodora	Spotted Gum	280		280	17	5	3	2	Regular	-	-	-	-	-	Typical	-	-	-	-	Typical	-	-	-	-	-	-	Retain
894	Corymbia citriodora	Spotted Gum	230		230	15	4	3	2	Regular	-	-	-	-	-	Typical	-	-	-	-	Typical	-	-	-	-	-	-	Retain
895	Eucalyptus crebra	Narrow-leaved Ironbark	230		230	18	4	3	2	Regular	-	-	-	-	-	Typical	-	-	-	-	Typical	-	-	-	-	-	-	Retain
896	Corymbia citriodora	Spotted Gum	220		220	19	5	3	2	Regular	-	-	-	-	-	Typical	-	-	-	-	Typical	-	-	-	-	-	-	Retain
897	Corymbia citriodora	Spotted Gum	240		240	16	5	3	2	Regular	-	-	-	-	-	Typical	-	-	-	-	Typical	-	-	-	-	-	-	Retain
898	Corymbia citriodora	Spotted Gum</																										

Tree ID	Specimen Details								Canopy Condition Details								Trunk Condition Details					Fauna Details and Habitat Value							
	Botanical Name	Common Name	Trunk DBH (mm)	Additional Trunks DBH (mm)	Total DBH (mm) [AS 4970-2009]	Height (m)	Spread (m)	Tree Protection Zone (m)	Structural Root Zone (m)	Canopy Form	Spreading	Thinning	Die-Back	Epicormic Growth	Lopped	Canopy Health	Leaning	Vines	Trunk Damage	Fire Damage	Trunk Health	Scats	Scratches	Hollows	Nest	Termite Nest	Habitat Value	Retention	
901	Corymbia citriodora	Spotted Gum	210		210	20	3	3	2	Regular	-	-	-	-	-	Typical	-	-	-	-	Typical	-	-	-	-	-	-	Retain	
902	Corymbia citriodora	Spotted Gum	280		280	23	7	3	2	Regular	-	-	-	-	-	Typical	-	-	-	-	Typical	-	-	-	-	-	-	Retain	
903	Corymbia citriodora	Spotted Gum	200		200	20	6	2	2	Regular	-	-	-	-	-	Typical	-	-	-	-	Typical	-	-	-	-	-	-	Retain	
904	Corymbia citriodora	Spotted Gum	190	80	206	18	4	2	2	Regular	-	-	-	-	-	Typical	-	-	-	-	Typical	-	-	-	-	-	-	Retain	
905	Corymbia citriodora	Spotted Gum	210		210	18	5	3	2	Regular	-	-	-	-	-	Typical	-	-	-	-	Typical	-	-	-	-	-	-	Retain	
906	Eucalyptus crebra	Narrow-leaved Ironbark	240		240	19	4	3	2	Regular	-	-	-	-	-	Typical	-	-	-	-	Typical	-	-	-	-	-	-	Retain	
907	Corymbia citriodora	Spotted Gum	260		260	22	5	3	2	Regular	-	-	-	-	-	Typical	-	-	-	-	Typical	-	-	-	-	-	-	Retain	
908	Eucalyptus crebra	Narrow-leaved Ironbark	200		200	18	5	2	2	Regular	-	-	-	-	-	Typical	-	-	-	-	Typical	-	-	-	-	-	-	Retain	
909	Corymbia citriodora	Spotted Gum	250		250	22	5	3	2	Regular	-	-	-	-	-	Typical	-	-	-	-	Typical	-	-	-	-	-	-	Retain	
910	Corymbia citriodora	Spotted Gum	210		210	20	5	3	2	Regular	-	-	-	-	-	Typical	-	-	-	-	Typical	-	-	-	-	-	-	Retain	
911	Corymbia citriodora	Spotted Gum	230		230	19	5	3	2	Regular	-	-	-	-	-	Typical	-	-	-	-	Typical	-	-	-	-	-	-	Retain	
912	Eucalyptus crebra	Narrow-leaved Ironbark	330		330	25	9	4	2	Regular	-	-	-	-	-	Typical	-	-	-	-	Typical	-	-	-	-	-	-	Retain	
913	Eucalyptus crebra	Narrow-leaved Ironbark	220		220	18	4	3	2	Regular	-	Thinning	Die-back	-	-	Poor	-	-	-	-	Typical	-	-	-	-	-	-	Retain	
914	Corymbia citriodora	Spotted Gum	200		200	18	4	2	2	Regular	-	-	-	-	-	Typical	-	-	-	-	Typical	-	-	-	-	-	-	Retain	
915	Corymbia citriodora	Spotted Gum	200		200	18	3	2	2	Regular	-	-	-	-	-	Typical	-	-	-	-	Typical	-	-	-	-	-	-	Retain	
916	Corymbia citriodora	Spotted Gum	230		230	20	5	3	2	Regular	-	-	-	-	-	Typical	-	-	-	-	Typical	-	-	-	-	-	-	Retain	
917	Eucalyptus crebra	Narrow-leaved Ironbark	260		260	19	4	3	2	Regular	-	Thinning	Die-back	-	-	Poor	-	-	-	-	Typical	-	-	-	-	-	-	Retain	
918	Corymbia citriodora	Spotted Gum	210		210	18	4	3	2	Regular	-	Thinning	-	Epicormic	-	Poor	-	-	-	-	Typical	-	-	-	-	-	-	Retain	
919	Corymbia citriodora	Spotted Gum	250		250	18	5	3	2	Regular	-	-	-	-	-	Typical	-	-	-	-	Typical	-	-	-	-	-	-	Retain	
920	Corymbia citriodora	Spotted Gum	200		200	22	4	2	2	Regular	-	-	-	-	-	Typical	-	-	-	-	Typical	-	-	-	-	-	-	Retain	
921	Corymbia citriodora	Spotted Gum	220		220	19	5	3	2	Regular	-	-	-	-	-	Typical	-	-	-	-	Typical	-	-	-	-	-	-	Retain	
922	Corymbia citriodora	Spotted Gum	210		210	19	4	3	2	Regular	-	-	-	-	-	Typical	-	-	-	-	Typical	-	-	-	-	-	-	Retain	
923	Corymbia citriodora	Spotted Gum	350		350	20	6	4	2	Regular	-	-	-	-	-	Typical	-	-	-	-	Typical	-	-	-	-	-	-	Retain	
924	Eucalyptus crebra	Narrow-leaved Ironbark	400		400	22	8	5	2	Regular	-	-	-	-	-	Typical	-	-	-	-	Typical	-	-	-	-	-	-	Retain	
925	Eucalyptus crebra	Narrow-leaved Ironbark	260		260	19	8	3	2	Regular	-	-	-	-	-	Typical	-	-	-	-	Typical	-	-	-	-	-	-	Retain	
926	Eucalyptus siderophloia	Grey Ironbark	390		390	19	7	5	2	Regular	-	Thinning	Die-back	-	-	Poor	-	-	Trunk Dmg.	-	Typical	-	-	-	-	-	-	Retain	
927	Eucalyptus crebra	Narrow-leaved Ironbark	270		270	18	4	3	2	Regular	-	-	-	Epicormic	-	Typical	-	-	-	-	Typical	-	-	-	-	-	-	Retain	
928	Corymbia citriodora	Spotted Gum	290		290	18	9	3	2	Regular	-	-	-	-	-	Typical	-	-	-	-	Typical	-	-	-	-	-	-	Retain	
929	Corymbia citriodora	Spotted Gum	210		210	18	3	3	2	Regular	-	-	-	-	-	Typical	-	-	-	-	Typical	-	-	-	-	-	-	Retain	
930	Corymbia citriodora	Spotted Gum	220	140	261	17	4	3	2	Regular	-	-	-	-	-	Typical	-	-	-	-	Typical	-	-	-	-	-	-	Retain	
931	Corymbia citriodora	Spotted Gum	230	170	286	16	6	3	2	Regular	-	-	-	-	-	Typical	-	-	-	-	Typical	-	-	-	-	-	-	Retain	
932	Eucalyptus crebra	Narrow-leaved Ironbark	290		290	18	5	3	2	Regular	-	Thinning	Die-back	Epicormic	-	Poor	-	-	-	-	Typical	-	-	-	-	-	-	Retain	
939	Corymbia citriodora	Spotted Gum	240		240	21	8	3	2	Regular	-	-	-	-	-	Typical	-	-	-	-	Typical	-	-	-	-	-	-	Retain	
940	Corymbia citriodora	Spotted Gum	220		220	19	4	3	2	Regular	-	-	-	-	-	Typical	-	-	-	-	Typical	-	-	-	-	-	-	Retain	
941	Eucalyptus crebra	Narrow-leaved Ironbark	350		350	23	10	4	2	Regular	-	Thinning	-	-	-	Typical	-	-	-	-	Typical	-	-	-	-	-	-	Retain	
942	Eucalyptus siderophloia	Grey Ironbark	210		210	17	3	3	2	Regular	-	Thinning	-	Epicormic	-	Poor	-	-	-	-	Typical	-	-	-	-	-	-	Retain	
943	Corymbia citriodora	Spotted Gum	300		300	25	7	4	2	Regular	-	-	-	-	-	Typical	-	-	-	-	Typical	-	-	-	-	-	-	Retain	
944	Eucalyptus tereticornis	Forest Red Gum	320		320	20	9	4	2	Regular	-	-	-	-	-	Typical	-	-	-	-	Typical	-	-	-	-	-	-	Retain	
945	Eucalyptus major	Grey Gum	260		260	18	4	3	2	Regular	-	-	-	-	-	Typical	-	-	-	-	Typical	-	-	-	-	-	-	Retain	
946	Eucalyptus crebra	Narrow-leaved Ironbark	290		290	20	3	3	2	Regular	-	Thinning	Die-back	-	-	Poor	-	-	Trunk Dmg.	-	Poor	-	-	-	-	-	-	Retain	
947	Corymbia citriodora	Spotted Gum	270		270	21	6	3	2	Regular	-	-	-	-	-	Typical	-	-	-	-	Typical	-	-	-	-	-	-	Retain	
948	Eucalyptus crebra	Narrow-leaved Ironbark	200		200	17	3	2	2	Regular	-	-	-	-	-	Typical	-	-	-	-	Typical	-	-	-	-	-	-	Retain	
949	Eucalyptus crebra	Narrow-leaved Ironbark	290		290	20	8	3	2	Regular	-	-	-	-	-	Typical	-	-	-	-	Typical	-	-	-	-	-	-	Retain	
950	Corymbia citriodora	Spotted Gum	260		260	19	5	3	2	Regular	-	-	-	-	-	Typical	-	-	-	-	Typical	-	-	-	-	-	-	Retain	
951	Corymbia citriodora	Spotted Gum	220		220	16	3	3	2	One-sided	-	-	-	-	-	Typical	-	-	-	-	Typical	-	-	-	-	-	-	Retain	
952	Eucalyptus tereticornis	Forest Red Gum	230		230	17	3	3	2	One-sided	-	-	-	-	-	Typical	-	-	-	-	Typical	-	-	-	-	-	-	Retain	
953	Eucalyptus tereticornis	Forest Red Gum	400		400	22	8	5	2	Regular	-	Thinning	-	-	-	Typical	-	-	-	-	Typical	-	-	-	-	-	-	Retain	
954	Corymbia citriodora	Spotted Gum	230		230	18	6	3	2	Regular	-	-	-	-	-	Typical	-	-	-	-	Typical	-	-	-	-	-	-	Retain	
955	Eucalyptus siderophloia	Grey Ironbark	280		280	24	6	3	2	Regular	-	-	-	-	-	Typical	-	-	-	-	Typical	-	-	-	-	-	-	Retain	
956	Eucalyptus crebra	Narrow-leaved Ironbark	220		220	20	5	3	2	Regular	-	-	-	-	-	Typical	-	-	-	-	Typical	-	-	-	-	-	-	Retain	
957	Corymbia citriodora	Spotted Gum	300		300	20	8	4	2	Regular	-	-	-	-	-	Typical	-	-	-	-	Typical	-	-	-	-	-	-	Remove	
958	Corymbia citriodora	Spotted Gum	270		270	21	6	3	2	Regular	-	-	-	-	-	Typical	-	-	-	-	Typical	-	-	-	-	-	-	Remove	
959	Corymbia citriodora	Spotted Gum	250		250	22	6	3	2	Regular	-	-	-	-	-	Typical	-	-	-	-	Typical	-	-	-	-	-	-	Remove	
960	Corymbia citriodora	Spotted Gum	340		340	24	10	4	2	Regular	-	-	-	-	-	Typical	-	-	-	-	Typical	-	-	-	-	-	-	Remove	
961	Eucalyptus crebra	Narrow-leaved Ironbark	240		240	18	6	3	2	Regular	-	-	-	-	-	Typical	-	-	-	-	Typical	-	-	-	-	-	-	Remove	
962	Corymbia citriodora	Spotted Gum	210		210	18	5	3	2	Regular	-	-	-	-	-	Typical	-	-	-	-	Typical	-	-	-	-	-	-	Remove	
963	Eucalyptus crebra	Narrow-leaved Ironbark	200		200	16	5	2	2	Regular	-	Thinning	-	-	-	Typical	-	-	-	-	Typical	-	-	-	-	-	-	Remove	
964	Corymbia citriodora	Spotted Gum	480		480	26	7	6	2	Regular	-	Thinning	Die-back	-	-	Typical	-	-	-	-	Typical	-	-	-	-	-	-	Remove	
965	Corymbia citriodora	Spotted Gum	400		400	22	9	5	2	Regular	-	-	-	-	-	Typical	-	-	-	-	Typical	-	-	-	-	-	-	Remove	
966	Eucalyptus crebra	Narrow-leaved Ironbark	220		220	16	6	3	2	Regular	-	-	-	-	-	Typical	-	-	-	-	Typical	-	-	-	-	-	-	Remove	
967	Corymbia citriodora	Spotted Gum	380		380	25	10	5	2	Regular	-	-	-	-	-	Typical	-	-	-	-	Typical	-	-	-	-	-	-	Remove	
968	Corymbia citriodora	Spotted Gum	340		340	16	5	4	2	One-sided	-	-	-	-	-	Typical	Minor	-	-	-	Typical	-	-	-	-	-	-	Remove	
969	Corymbia citriodora	Spotted Gum	300		300	18	3	4	2	Regular	-	Thinning	Die-back	Epicormic	-	Poor	-	-	-	-	Typical	-	-	-	-	-	-	Remove	
970	Eucalyptus siderophloia	Grey Ironbark	200	170, 140	297	16	5	4	2	Regular	-	-	-	-	-	Typical	-	-	-	-	Typical	-	-	-	-	-	-	Remove	
971	Corymbia citriodora	Spotted Gum	680		680	25	10	8	3	Regular	-	-	-	-	-	Typical	-	-	-	-	Typical	-	-	Large	-	-	-	Remove	

Tree ID	Specimen Details								Canopy Condition Details							Trunk Condition Details					Fauna Details and Habitat Value							Retention
	Botanical Name	Common Name	Trunk DBH (mm)	Additional Trunks DBH (mm)	Total DBH (mm) [AS 4970-2009]	Height (m)	Spread (m)	Tree Protection Zone (m)	Structural Root Zone (m)	Canopy Form	Spreading	Thinning	Die-Back	Epicormic Growth	Lopped	Canopy Health	Leaning	Vines	Trunk Damage	Fire Damage	Trunk Health	Scats	Scratches	Hollows	Nest	Termite Nest	Habitat Value	
975	Eucalyptus crebra	Narrow-leaved Ironbark	250		250	16	5	3	2	One-sided	-	-	-	-	-	Typical	-	-	-	-	Typical	-	-	-	-	-	-	Remove
976	Eucalyptus siderophloia	Grey Ironbark	200		200	16	4	2	2	Regular	-	-	-	-	-	Typical	-	-	-	-	Typical	-	-	-	-	-	-	Remove
977	Corymbia citriodora	Spotted Gum	450		450	20	8	5	2	Regular	-	-	-	-	-	Typical	-	-	-	-	Typical	-	-	Large	-	-	-	Remove
978	Corymbia citriodora	Spotted Gum	680		680	26	10	8	3	Regular	-	-	-	Epicormic	Lopped	Typical	-	-	-	-	Typical	-	-	-	-	-	-	Remove
979	Corymbia citriodora	Spotted Gum	260		260	18	7	3	2	Regular	-	-	-	-	-	Typical	-	-	-	-	Typical	-	-	-	-	-	-	Remove
980	Corymbia citriodora	Spotted Gum	200		200	18	5	2	2	Regular	-	-	-	-	-	Typical	-	-	-	-	Typical	-	-	-	-	-	-	Remove
981	Eucalyptus siderophloia	Grey Ironbark	500		500	23	12	6	2	Regular	-	-	-	-	-	Typical	-	-	-	-	Typical	-	-	-	-	-	-	Remove
982	Eucalyptus crebra	Narrow-leaved Ironbark	280		280	18	6	3	2	Regular	-	-	-	-	-	Typical	-	-	-	-	Typical	-	-	-	-	-	-	Remove
983	Eucalyptus crebra	Narrow-leaved Ironbark	100	100	120	14	4	2	1	Regular	-	-	-	-	-	Typical	-	-	-	-	Typical	-	-	-	-	-	-	Remove
984	Corymbia citriodora	Spotted Gum	420		420	16	3	5	2	Regular	-	Thinning	Die-back	-	-	Poor	-	-	Trunk Dmg.	-	Poor	-	-	Large	-	-	-	Remove
985	Corymbia citriodora	Spotted Gum	320		320	19	10	4	2	Regular	-	-	-	-	-	Typical	-	-	-	-	Typical	-	-	-	-	-	-	Remove
986	Corymbia citriodora	Spotted Gum	410		410	28	12	5	2	Regular	-	-	-	-	-	Typical	-	-	-	-	Typical	-	-	-	-	-	-	Remove
987	Corymbia citriodora	Spotted Gum	370		370	16	6	4	2	One-sided	-	-	-	-	-	Typical	-	-	-	-	Typical	-	-	-	-	-	-	Remove
988	Corymbia citriodora	Spotted Gum	470		470	22	10	6	2	Regular	-	-	-	-	-	Typical	-	-	-	-	Typical	-	-	-	-	-	-	Remove
989	Corymbia citriodora	Spotted Gum	550		550	27	8	7	3	One-sided	-	-	-	-	-	Typical	-	-	-	-	Typical	-	-	-	-	-	-	Remove
990	Corymbia citriodora	Spotted Gum	470		470	27	9	6	2	Regular	-	Thinning	-	Epicormic	-	Poor	-	-	-	-	Typical	-	-	-	-	-	-	Remove
991	Corymbia citriodora	Spotted Gum	240		240	17	4	3	2	Regular	-	Thinning	-	Epicormic	-	Poor	-	-	-	-	Typical	-	-	-	-	-	-	Retain
992	Corymbia citriodora	Spotted Gum	680		680	28	11	8	3	Regular	-	-	-	-	-	Typical	-	-	-	-	Typical	-	-	-	-	-	-	Retain
993	Eucalyptus siderophloia	Grey Ironbark	400		400	20	10	5	2	Regular	-	-	-	-	-	Typical	-	-	-	-	Typical	-	-	-	-	-	-	Retain
994	Corymbia citriodora	Spotted Gum	470		470	21	5	6	2	One-sided	-	-	-	-	-	Typical	-	-	-	-	Typical	-	-	-	-	-	-	Retain
995	Corymbia intermedia	Pink Bloodwood	540		540	30	10	6	3	Regular	-	-	-	-	-	Typical	-	-	-	-	Typical	-	-	-	-	-	-	Retain
996	Corymbia citriodora	Spotted Gum	260		260	21	2	3	2	Regular	-	Thinning	Die-back	-	-	Poor	-	-	-	-	Typical	-	-	-	-	-	-	Retain
997	Corymbia citriodora	Spotted Gum	300		300	24	3	4	2	Regular	-	-	-	Epicormic	-	Typical	-	-	-	-	Typical	-	-	-	-	-	-	Retain
998	Corymbia citriodora	Spotted Gum	540		540	27	10	6	3	One-sided	-	-	-	-	-	Typical	-	-	-	-	Typical	-	-	-	-	-	-	Retain
999	Corymbia citriodora	Spotted Gum	600		600	27	14	7	3	Regular	-	-	-	-	-	Typical	-	-	Trunk Dmg.	-	Typical	-	-	Large	-	-	-	Retain
1000	Corymbia citriodora	Spotted Gum	650		650	30	16	8	3	Regular	-	-	-	-	-	Typical	-	-	-	-	Typical	-	-	Large	-	-	-	Retain
1001	Corymbia citriodora	Spotted Gum	250		250	13	5	3	2	Regular	-	-	-	-	-	Typical	-	-	-	-	Typical	-	-	-	-	-	-	Retain
1002	Eucalyptus tereticornis	Forest Red Gum	260		260	17	5	3	2	One-sided	-	Thinning	-	-	-	Typical	-	-	-	-	Typical	-	-	-	-	-	-	Retain
1003	Corymbia citriodora	Spotted Gum	250		250	17	5	3	2	One-sided	-	-	-	-	-	Typical	-	-	-	-	Typical	-	-	-	-	-	-	Retain
1004	Angophora leiocarpa	Smooth-barked Apple	240		240	14	4	3	2	One-sided	-	-	-	-	-	Typical	-	-	-	-	Typical	-	-	-	-	-	-	Retain
1005	Corymbia citriodora	Spotted Gum	390		390	17	4	5	2	Regular	-	-	-	-	Lopped	Typical	-	-	-	-	Typical	-	-	-	-	-	-	Retain
1006	Eucalyptus tereticornis	Forest Red Gum	700		700	24	9	8	3	Regular	-	Thinning	Die-back	-	-	Poor	-	-	-	-	Typical	-	-	-	-	-	-	Retain
1007	Corymbia citriodora	Spotted Gum	350		350	18	6	4	2	Regular	-	-	-	-	-	Typical	Major	-	-	-	Typical	-	-	-	-	-	-	Retain
1008	Corymbia citriodora	Spotted Gum	330		330	27	10	4	2	Regular	-	-	-	-	-	Typical	-	-	-	-	Typical	-	-	-	-	-	-	Retain
1009	Eucalyptus moluccana	Gum Topped Box	400		400	25	11	5	2	Regular	-	-	-	-	-	Typical	-	-	-	-	Typical	-	-	-	-	-	-	Retain
1010	Eucalyptus moluccana	Gum Topped Box	310		310	24	7	4	2	Regular	-	-	-	-	-	Typical	-	-	-	-	Typical	-	-	-	-	-	-	Retain
1011	Eucalyptus crebra	Narrow-leaved Ironbark	300		300	17	6	4	2	Regular	-	Thinning	-	Epicormic	-	Typical	-	-	-	-	Typical	-	-	-	-	-	-	Retain
1012	Eucalyptus moluccana	Gum Topped Box	250		250	17	3	3	2	Regular	-	Thinning	Die-back	Epicormic	-	Poor	-	-	-	-	Typical	-	-	-	-	-	-	Retain
1013	Eucalyptus moluccana	Gum Topped Box	550		550	28	10	7	3	Regular	-	-	-	-	-	Typical	-	-	-	-	Typical	-	-	-	-	-	-	Retain
1014	Eucalyptus moluccana	Gum Topped Box	300		300	18	5	4	2	Regular	-	-	-	-	-	Typical	-	-	-	-	Typical	-	-	-	-	-	-	Retain
1015	Corymbia citriodora	Spotted Gum	340		340	20	7	4	2	Regular	-	-	-	-	-	Typical	-	-	-	-	Typical	-	-	-	-	-	-	Retain
1016	Corymbia intermedia	Pink Bloodwood	220	200	297	18	7	4	2	Regular	-	-	-	-	-	Typical	-	-	-	-	Typical	-	-	-	-	-	-	Retain
1017	Eucalyptus tereticornis	Forest Red Gum	400		400	25	6	5	2	Regular	-	-	-	-	-	Typical	-	-	-	-	Typical	-	-	-	-	-	-	Retain
1018	Lophostemon suaveolens	Swamp Box	220		220	16	4	3	2	Regular	-	-	-	-	-	Typical	-	-	-	-	Typical	-	-	-	-	-	-	Retain
1019	Lophostemon suaveolens	Swamp Box	200		200	11	3	2	2	Regular	-	-	-	-	-	Typical	-	-	-	-	Typical	-	-	-	-	-	-	Retain
1020	Eucalyptus tereticornis	Forest Red Gum	330	300	446	27	8	5	2	Regular	-	Thinning	-	-	-	Poor	-	-	-	-	Typical	-	-	-	-	-	-	Retain
1021	Lophostemon suaveolens	Swamp Box	200		200	16	4	2	2	Regular	-	-	-	-	-	Typical	-	-	-	-	Typical	-	-	-	-	-	-	Retain
1022	Eucalyptus siderophloia	Grey Ironbark	310		310	26	9	4	2	Regular	-	-	-	-	-	Typical	-	-	-	-	Typical	-	-	-	-	Termites	-	Remove - LCC sewer works
1023	Eucalyptus tereticornis	Forest Red Gum	480		480	30	10	6	2	Regular	-	Thinning	-	Epicormic	-	Poor	-	-	-	-	Typical	-	-	-	-	-	-	Remove - LCC sewer works
1024	Angophora leiocarpa	Smooth-barked Apple	300		300	18	7	4	2	Regular	-	-	-	-	-	Typical	-	-	-	-	Typical	-	-	-	-	-	-	Retain
1025	Lophostemon suaveolens	Swamp Box	200		200	16	6	2	2	Regular	-	-	-	-	-	Typical	-	-	-	-	Typical	-	-	-	-	-	-	Retain
1026	Angophora leiocarpa	Smooth-barked Apple	220		220	12	5	3	2	Regular	-	-	-	-	-	Typical	-	-	-	-	Typical	-	-	-	-	-	-	Retain
1027	Eucalyptus tereticornis	Forest Red Gum	240		240	17	6	3	2	Regular	-	-	-	-	-	Typical	-	-	-	-	Typical	-	-	-	-	-	-	Retain
1028	Eucalyptus tereticornis	Forest Red Gum	220		220	17	4	3	2	One-sided	-	-	-	-	-	Typical	-	-	-	-	Typical	-	-	-	-	-	-	Retain
1029	Lophostemon suaveolens	Swamp Box	200		200	14	6	2	2	Regular	-	-	-	-	-	Typical	-	-	-	-	Typical	-	-	-	-	-	-	Remove - LCC sewer works
1030	Lophostemon suaveolens	Swamp Box	220		220	16	5	3	2	Regular	-	-	-	-	-	Typical	-	-	-	-	Typical	-	-	-	-	-	-	Remove - LCC sewer works
1358	Corymbia citriodora	Spotted Gum	470		470	27	9	6	2	Regular	-	-	Die-back	-	-	Typical	-	-	-	-	Typical	-	-	-	-	-	-	Retain
1359	Corymbia citriodora	Spotted Gum	370		370	26	11	4	2	Regular	-	-	-	-	-	Typical	-	-	-	-	Typical	-	-	-	-	-	-	Retain
1360	Eucalyptus crebra	Narrow-leaved Ironbark	200		200	19	7	2	2	Regular	-	Thinning	-	-	-	Typical	-	-	-	-	Typical	-	-	-	-	-	-	Retain
1361	Eucalyptus crebra	Narrow-leaved Ironbark	210		210	17	8	3	2	Regular	-	Thinning	Die-back	Epicormic	-	Poor	-	-	Trunk Dmg.	-	Typical	-	-	-	-	-	-	Retain
1362	Corymbia citriodora	Spotted Gum	630		630	30	12	8	3	Regular	-	-	-	-	-	Typical	-	-	-	-	Typical	-	-	-	-	-	-	Retain
1363	Corymbia citriodora	Spotted Gum	200		200	15	8	2	2	One-sided	-	-	-	-	-	Typical	-	-	-	-	Typical	-	-	-	-	-	-	Retain
1364	Corymbia citriodora	Spotted Gum	290		290	18	7	3	2	Regular	-	-	Die-back	Epicormic	-	Poor	-	-	-	-	Typical	-	-	-	-	-	-	Retain
1365	Corymbia citriodora	Spotted Gum	210		210	14	7	3	2	Regular	-	-	-	-	-	Typical	-	-	-	-	Typical	-	-	-	-	-	-	Retain
1366	Corymbia citriodora	Spotted Gum	310		310	26	12	4	2	Regular	-	-	-	-	-													

Tree ID	Specimen Details								Canopy Condition Details								Trunk Condition Details					Fauna Details and Habitat Value						
	Botanical Name	Common Name	Trunk DBH (mm)	Additional Trunks DBH (mm)	Total DBH (mm) [AS 4970-2009]	Height (m)	Spread (m)	Tree Protection Zone (m)	Structural Root Zone (m)	Canopy Form	Spreading	Thinning	Die-Back	Epicormic Growth	Lopped	Canopy Health	Leaning	Vines	Trunk Damage	Fire Damage	Trunk Health	Scats	Scratches	Hollows	Nest	Termite Nest	Habitat Value	Retention
1370	Corymbia citriodora	Spotted Gum	240		240	23	8	3	2	One-sided	-	-	-	-	-	Typical	-	-	-	-	Typical	-	-	-	-	-	-	Retain
1371	Eucalyptus siderophloia	Grey Ironbark	220		220	23	10	3	2	Regular	-	-	Die-back	-	-	Typical	-	-	-	-	Typical	-	-	-	-	-	-	Retain
1372	Corymbia citriodora	Spotted Gum	380		380	27	11	5	2	Regular	-	-	-	-	-	Typical	-	-	-	-	Typical	-	-	-	-	-	-	Retain
1373	Eucalyptus tereticornis	Forest Red Gum	320		320	25	8	4	2	One-sided	-	-	Die-back	Epicormic	-	Poor	-	-	-	-	Typical	-	-	-	-	-	-	Retain
1374	Corymbia citriodora	Spotted Gum	340		340	26	13	4	2	Regular	-	-	-	-	-	Typical	-	-	-	-	Typical	-	-	-	-	-	-	Retain
1375	Eucalyptus tereticornis	Forest Red Gum	330		330	25	13	4	2	One-sided	-	-	-	-	-	Typical	-	-	-	-	Typical	-	-	-	-	-	-	Retain
1376	Corymbia citriodora	Spotted Gum	240		240	22	10	3	2	Regular	-	-	-	-	-	Typical	-	-	-	-	Typical	-	-	-	-	-	-	Retain
1377	Corymbia citriodora	Spotted Gum	360		360	31	8	4	2	Regular	-	-	Die-back	Epicormic	-	Poor	-	-	-	-	Typical	-	-	-	-	-	-	Retain
1378	Eucalyptus crebra	Narrow-leaved Ironbark	200		200	22	7	2	2	Regular	-	-	Die-back	-	-	Typical	-	-	-	-	Typical	-	-	-	-	-	-	Retain
1379	Corymbia citriodora	Spotted Gum	650		650	30	16	8	3	Regular	-	-	-	-	-	Typical	-	-	-	-	Typical	-	-	-	-	-	-	Retain
1380	Eucalyptus tereticornis	Forest Red Gum	350	110	367	26	12	4	2	Regular	-	-	-	-	-	Typical	-	-	-	-	Typical	-	-	-	-	-	-	Retain
1381	Corymbia citriodora	Spotted Gum	230		230	26	8	3	2	One-sided	-	-	-	-	-	Typical	-	-	-	-	Typical	-	-	-	-	-	-	Retain
1382	Corymbia citriodora	Spotted Gum	370		370	27	10	4	2	Regular	-	-	-	-	-	Typical	-	-	-	-	Typical	-	-	-	-	-	-	Retain
1383	Eucalyptus tereticornis	Forest Red Gum	220		220	25	8	3	2	One-sided	-	-	-	-	-	Typical	-	-	-	-	Typical	-	-	-	-	-	-	Retain
1384	Corymbia citriodora	Spotted Gum	510		510	31	11	6	2	Regular	-	-	Die-back	-	-	Typical	-	-	-	-	Typical	-	-	-	-	-	-	Retain
1385	Corymbia citriodora	Spotted Gum	430		430	26	9	5	2	Regular	-	-	-	-	-	Typical	Minor	-	-	-	Typical	-	-	-	-	-	-	Retain
1386	Corymbia citriodora	Spotted Gum	230		230	19	10	3	2	Regular	-	-	Die-back	-	-	Typical	-	-	-	-	Typical	-	-	-	-	-	-	Retain
1387	Eucalyptus siderophloia	Grey Ironbark	440		440	22	14	5	2	Regular	-	-	-	-	-	Typical	-	-	-	-	Typical	-	-	-	-	-	-	Retain
1388	Eucalyptus tereticornis	Forest Red Gum	380		380	19	10	5	2	Regular	-	Thinning	Die-back	-	-	Poor	-	-	-	-	Typical	-	-	-	-	-	-	Retain
1389	Corymbia citriodora	Spotted Gum	350		350	24	12	4	2	Regular	-	-	-	-	-	Typical	-	-	-	-	Typical	-	-	-	-	-	-	Retain
1390	Corymbia citriodora	Spotted Gum	230		230	17	9	3	2	One-sided	-	-	Die-back	Epicormic	-	Poor	-	-	-	-	Typical	-	-	-	-	-	-	Retain
1391	Corymbia citriodora	Spotted Gum	250		250	16	8	3	2	Regular	-	-	-	-	-	Typical	-	-	-	-	Typical	-	-	-	-	-	-	Retain
1392	Eucalyptus crebra	Narrow-leaved Ironbark	310		310	18	10	4	2	Regular	-	Thinning	-	-	-	Typical	-	-	-	-	Typical	-	-	-	-	-	-	Retain
1393	Eucalyptus crebra	Narrow-leaved Ironbark	220		220	15	6	3	2	Regular	-	-	-	-	-	Typical	-	-	-	-	Typical	-	-	-	-	-	-	Retain
1394	Eucalyptus seana	Narrow-leaved Red Gum	220		220	20	6	3	2	Regular	-	Thinning	-	-	-	Poor	-	-	-	-	Typical	-	-	-	-	-	-	Retain
1395	Eucalyptus moluccana	Gum Topped Box	360		360	24	10	4	2	Regular	-	Thinning	Die-back	-	-	Poor	-	-	-	-	Typical	-	-	-	-	-	-	Retain
1396	Corymbia citriodora	Spotted Gum	180	160, 150	284	17	11	3	2	Regular	-	-	-	-	-	Typical	-	-	-	-	Typical	-	-	-	-	-	-	Retain
1397	Eucalyptus crebra	Narrow-leaved Ironbark	260		260	20	12	3	2	Regular	-	-	-	-	-	Typical	-	-	-	-	Typical	-	-	-	-	-	-	Retain
1398	Eucalyptus crebra	Narrow-leaved Ironbark	290		290	21	10	3	2	One-sided	-	-	-	-	-	Typical	-	-	-	-	Typical	-	-	-	-	-	-	Retain
1399	Eucalyptus crebra	Narrow-leaved Ironbark	250		250	23	8	3	2	Regular	-	-	-	-	-	Typical	-	-	-	-	Typical	-	-	-	-	-	-	Retain
1400	Eucalyptus crebra	Narrow-leaved Ironbark	280		280	24	12	3	2	Regular	-	-	-	-	-	Typical	-	-	-	-	Typical	-	-	-	-	-	-	Retain
1401	Corymbia citriodora	Spotted Gum	250		250	21	8	3	2	Regular	-	-	Die-back	-	-	Typical	-	-	-	-	Typical	-	-	-	-	-	-	Retain
1402	Eucalyptus moluccana	Gum Topped Box	480		480	25	16	6	2	Regular	-	-	-	-	-	Typical	-	-	-	-	Typical	-	-	-	-	-	-	Retain
1403	Eucalyptus tereticornis	Forest Red Gum	230		230	23	9	3	2	Regular	-	-	Die-back	Epicormic	-	Poor	-	-	-	-	Typical	-	-	-	-	-	-	Retain
1404	Corymbia citriodora	Spotted Gum	270		270	24	10	3	2	Regular	-	-	-	-	-	Typical	-	-	-	-	Typical	-	-	-	-	-	-	Retain
1405	Eucalyptus siderophloia	Grey Ironbark	200	110	228	15	8	3	2	Regular	-	-	-	-	-	Typical	-	-	-	-	Typical	-	-	-	-	-	-	Retain
1406	Eucalyptus crebra	Narrow-leaved Ironbark	260		260	25	16	3	2	Regular	-	-	Die-back	-	-	Typical	-	-	-	-	Typical	-	-	-	-	-	-	Retain
1407	Eucalyptus crebra	Narrow-leaved Ironbark	300		300	25	10	4	2	Regular	-	-	-	-	-	Typical	-	-	-	-	Typical	-	-	-	-	-	-	Retain
1408	Corymbia citriodora	Spotted Gum	210		210	22	5	3	2	Regular	-	-	-	-	-	Typical	-	-	-	-	Typical	-	-	-	-	-	-	Retain
1409	Eucalyptus crebra	Narrow-leaved Ironbark	240		240	22	5	3	2	One-sided	-	-	-	-	-	Typical	-	-	-	-	Typical	-	-	-	-	-	-	Retain
1410	Eucalyptus siderophloia	Grey Ironbark	360		360	24	13	4	2	Regular	-	-	-	-	-	Typical	-	-	-	-	Typical	-	-	-	-	-	-	Retain
1411	Corymbia citriodora	Spotted Gum	200		200	20	8	2	2	Regular	-	-	-	-	-	Typical	-	-	-	-	Typical	-	-	-	-	-	-	Retain
1412	Corymbia citriodora	Spotted Gum	210		210	22	7	3	2	Regular	-	-	-	-	-	Typical	-	-	-	-	Typical	-	-	-	-	-	-	Retain
1413	Corymbia citriodora	Spotted Gum	200		200	21	5	2	2	Regular	-	Thinning	Die-back	-	-	Poor	-	-	-	-	Typical	-	-	-	-	-	-	Retain
1414	Eucalyptus crebra	Narrow-leaved Ironbark	340		340	25	11	4	2	Regular	-	-	-	-	-	Typical	-	-	-	-	Typical	-	-	-	-	-	-	Retain
1415	Corymbia citriodora	Spotted Gum	310		310	25	13	4	2	Regular	-	-	-	-	-	Typical	-	-	-	-	Typical	-	-	-	-	-	-	Retain
1416	Corymbia citriodora	Spotted Gum	250		250	24	9	3	2	Regular	-	-	-	-	-	Typical	-	-	-	-	Typical	-	-	-	-	-	-	Retain
1417	Eucalyptus crebra	Narrow-leaved Ironbark	220		220	25	7	3	2	Regular	-	-	-	-	-	Typical	-	-	-	-	Typical	-	-	-	-	-	-	Retain
1418	Corymbia citriodora	Spotted Gum	270		270	26	10	3	2	Regular	-	-	-	-	-	Typical	-	-	-	-	Typical	-	-	-	-	-	-	Retain
1419	Eucalyptus crebra	Narrow-leaved Ironbark	200		200	21	8	2	2	Regular	-	-	-	-	-	Typical	-	-	-	-	Typical	-	-	-	-	-	-	Retain
1420	Corymbia citriodora	Spotted Gum	230		230	22	9	3	2	Regular	-	-	-	-	-	Typical	-	-	-	-	Typical	-	-	-	-	-	-	Retain
1421	Corymbia citriodora	Spotted Gum	200		200	15	9	2	2	Regular	-	-	-	-	-	Typical	-	-	-	-	Typical	-	-	-	-	-	-	Retain
1422	Eucalyptus siderophloia	Grey Ironbark	200		200	17	7	2	2	Regular	-	-	-	-	-	Typical	-	-	-	-	Typical	-	-	-	-	-	-	Retain
1423	Eucalyptus crebra	Narrow-leaved Ironbark	210		210	17	5	3	2	Regular	-	-	-	-	-	Typical	Minor	-	-	-	Typical	-	-	-	-	-	-	Retain
1424	Eucalyptus siderophloia	Grey Ironbark	310		310	22	12	4	2	Regular	-	-	Die-back	Epicormic	-	Poor	-	-	-	-	Typical	-	-	-	-	-	-	Retain
1425	Eucalyptus crebra	Narrow-leaved Ironbark	300		300	22	10	4	2	One-sided	-	-	Die-back	Epicormic	-	Poor	-	-	-	-	Typical	-	-	-	-	-	-	Retain
1426	Corymbia citriodora	Spotted Gum	260	190	322	22	12	4	2	Regular	-	-	-	-	-	Typical	-	-	-	-	Typical	-	-	-	-	-	-	Retain
1427	Eucalyptus siderophloia	Grey Ironbark	330		330	24	13	4	2	Regular	-	-	Die-back	-	-	Typical	-	-	-	-	Typical	-	-	-	-	-	-	Retain
1428	Corymbia citriodora	Spotted Gum	200		200	20	8	2	2	Regular	-	-	-	-	-	Typical	-	-	-	-	Typical	-	-	-	-	-	-	Retain
1429	Eucalyptus siderophloia	Grey Ironbark	230		230	21	8	3	2	Regular	-	-	-	-	-	Typical	-	-	-	-	Typical	-	-	-	-	-	-	Retain
1430	Corymbia citriodora	Spotted Gum	200		200	19	9	2	2	Regular	-	-	-	-	-	Typical	-	-	-	-	Typical	-	-	-	-	-	-	Retain
1431	Eucalyptus crebra	Narrow-leaved Ironbark	370		370	25	13	4	2	Regular	-	-	-	-	-	Typical	-	-	-	-	Typical	-	-	-	-	-	-	Retain
1432	Eucalyptus crebra	Narrow-leaved Ironbark	320		320	22	12	4	2	Regular	-	-	-	-	-	Typical	-	-	-	-	Typical	-	-	-	-	-	-	Retain
1433	Eucalyptus siderophloia	Grey Ironbark	240	130	273	15	9	3	2	Regular	-	-	-	-	-	Typical	-	-	-	-	Typical	-	-	-	-	-	-	Retain
1434	Eucalyptus tereticornis	Forest Red Gum	250		250																							

Tree ID	Specimen Details								Canopy Condition Details							Trunk Condition Details					Fauna Details and Habitat Value							
	Botanical Name	Common Name	Trunk DBH (mm)	Additional Trunks DBH (mm)	Total DBH (mm) [AS 4970-2009]	Height (m)	Spread (m)	Tree Protection Zone (m)	Structural Root Zone (m)	Canopy Form	Spreading	Thinning	Die-Back	Epicormic Growth	Lopped	Canopy Health	Leaning	Vines	Trunk Damage	Fire Damage	Trunk Health	Scats	Scratches	Hollows	Nest	Termite Nest	Habitat Value	Retention
1438	Eucalyptus crebra	Narrow-leaved Ironbark	210		210	10	8	3	2	Regular	-	-	-	-	-	Typical	-	-	-	-	Typical	-	-	-	-	-	-	Retain
1439	Corymbia citriodora	Spotted Gum	250		250	18	10	3	2	Regular	-	-	-	-	-	Typical	-	-	-	-	Typical	-	-	-	-	-	-	Retain
1440	Corymbia citriodora	Spotted Gum	240		240	19	9	3	2	Regular	-	-	-	-	-	Typical	-	-	-	-	Typical	-	-	-	-	-	-	Retain
1441	Eucalyptus siderophloia	Grey Ironbark	200		200	15	8	2	2	Regular	-	-	-	-	-	Typical	-	-	-	-	Typical	-	-	-	-	-	-	Retain
1442	Eucalyptus siderophloia	Grey Ironbark	260		260	18	8	3	2	Regular	-	-	-	Epicormic	-	Poor	-	-	-	-	Typical	-	-	-	-	-	-	Retain
1443	Corymbia citriodora	Spotted Gum	200		200	15	8	2	2	Regular	-	-	-	-	-	Typical	-	-	-	-	Typical	-	-	-	-	-	-	Retain
1444	Eucalyptus siderophloia	Grey Ironbark	350		350	23	14	4	2	Regular	-	-	-	-	-	Typical	-	-	-	-	Typical	-	-	-	-	-	-	Retain
1445	Eucalyptus tereticornis	Forest Red Gum	230		230	17	8	3	2	Regular	-	-	-	-	-	Typical	-	-	-	-	Typical	-	-	-	-	-	-	Retain
1446	Corymbia citriodora	Spotted Gum	300		300	22	13	4	2	Regular	-	-	-	-	-	Typical	-	-	-	-	Typical	-	-	-	-	-	-	Retain
1447	Eucalyptus crebra	Narrow-leaved Ironbark	580		580	25	12	7	3	Regular	-	-	-	-	-	Typical	-	-	-	-	Typical	-	-	-	-	-	-	Retain
1448	Eucalyptus crebra	Narrow-leaved Ironbark	220		220	22	9	3	2	Regular	-	-	-	-	-	Typical	-	-	-	-	Typical	-	-	-	-	-	-	Retain
1449	Eucalyptus crebra	Narrow-leaved Ironbark	350		350	25	13	4	2	Regular	-	-	-	-	-	Typical	Minor	-	-	-	Typical	-	-	-	-	-	-	Retain
1450	Eucalyptus crebra	Narrow-leaved Ironbark	300		300	27	8	4	2	Regular	-	-	Die-back	Epicormic	-	Poor	-	-	-	-	Typical	-	-	-	-	-	-	Retain
1451	Corymbia citriodora	Spotted Gum	640		640	32	16	8	3	Regular	-	-	-	-	-	Typical	-	-	-	-	Typical	-	-	Small	Large	-	-	Retain
1452	Eucalyptus crebra	Narrow-leaved Ironbark	290		290	25	13	3	2	Regular	-	-	Die-back	Epicormic	-	Typical	-	-	-	-	Typical	-	-	-	-	-	-	Retain
1453	Corymbia citriodora	Spotted Gum	200		200	15	9	2	2	Regular	-	-	-	-	-	Typical	-	-	-	-	Typical	-	-	-	-	-	-	Remove
1454	Corymbia citriodora	Spotted Gum	220		220	16	8	3	2	Regular	-	-	-	-	-	Typical	-	-	-	-	Typical	-	-	-	-	-	-	Remove
1455	Corymbia citriodora	Spotted Gum	270		270	25	8	3	2	Regular	-	-	-	-	-	Typical	-	-	-	-	Typical	-	-	-	-	-	-	Remove
1456	Eucalyptus siderophloia	Grey Ironbark	210		210	17	9	3	2	Regular	-	-	-	-	-	Typical	-	-	-	-	Typical	-	-	-	-	-	-	Remove
1457	Corymbia citriodora	Spotted Gum	320		320	18	11	4	2	Regular	-	-	-	-	-	Typical	-	-	-	-	Typical	-	-	-	-	-	-	Remove
1458	Eucalyptus tereticornis	Forest Red Gum	280		280	23	7	3	2	Regular	-	-	-	-	-	Typical	-	-	-	-	Typical	-	-	-	-	-	-	Remove
1459	Corymbia citriodora	Spotted Gum	350		350	25	13	4	2	Regular	-	-	-	-	-	Typical	-	-	-	-	Typical	-	-	-	-	-	-	Remove
1460	Corymbia citriodora	Spotted Gum	270		270	20	9	3	2	Regular	-	-	-	-	-	Typical	-	-	-	-	Typical	-	-	-	-	-	-	Remove
1461	Eucalyptus tereticornis	Forest Red Gum	200		200	15	7	2	2	Regular	-	-	Die-back	-	-	Poor	-	-	-	-	Typical	-	-	-	-	-	-	Remove
1462	Corymbia citriodora	Spotted Gum	200		200	14	7	2	2	Regular	-	-	-	-	-	Typical	-	-	-	-	Typical	-	-	-	-	-	-	Remove
1463	Corymbia citriodora	Spotted Gum	360		360	23	10	4	2	One-sided	-	-	-	-	-	Typical	-	-	-	-	Typical	-	-	-	-	-	-	Remove
1464	Corymbia citriodora	Spotted Gum	430		430	25	12	5	2	Regular	-	-	-	-	-	Typical	-	-	-	-	Typical	-	-	-	-	-	-	Remove
1465	Corymbia citriodora	Spotted Gum	300		300	23	12	4	2	Regular	-	-	-	-	-	Typical	-	-	-	-	Typical	-	-	-	-	-	-	Remove
1466	Corymbia citriodora	Spotted Gum	230		230	14	6	3	2	Regular	-	-	-	Epicormic	-	Typical	-	-	-	-	Typical	-	-	-	-	-	-	Remove
1467	Corymbia citriodora	Spotted Gum	310		310	19	12	4	2	Regular	-	-	-	-	-	Typical	-	-	-	-	Typical	-	-	-	-	-	-	Remove
1468	Corymbia citriodora	Spotted Gum	270		270	17	8	3	2	Regular	-	Thinning	Die-back	-	-	Typical	-	-	-	-	Typical	-	-	-	-	-	-	Remove
1469	Eucalyptus crebra	Narrow-leaved Ironbark	250		250	16	11	3	2	Regular	-	-	-	-	-	Typical	-	-	-	-	Typical	-	-	-	-	-	-	Remove
1470	Corymbia citriodora	Spotted Gum	270		270	17	9	3	2	Regular	-	-	-	-	-	Typical	-	-	-	-	Typical	-	-	-	-	-	-	Remove
1471	Eucalyptus tereticornis	Forest Red Gum	200		200	18	7	2	2	Regular	-	-	-	-	-	Typical	-	-	-	-	Typical	-	-	-	-	-	-	Remove
1472	Corymbia tessellaris	Moreton Bay Ash	220		220	17	2	3	2	Regular	-	Thinning	Die-back	Epicormic	-	Poor	-	-	-	-	Typical	-	-	-	-	-	-	Remove
1473	Eucalyptus tereticornis	Forest Red Gum	230		230	15	8	3	2	Regular	-	-	-	-	-	Typical	-	-	-	-	Typical	-	-	-	-	-	-	Remove
1474	Corymbia citriodora	Spotted Gum	200		200	19	8	2	2	Regular	-	-	-	Epicormic	-	Typical	-	-	-	-	Typical	-	-	-	-	-	-	Remove
1475	Corymbia citriodora	Spotted Gum	330		330	22	9	4	2	Regular	-	-	-	-	-	Typical	-	-	-	-	Typical	-	-	-	-	-	-	Remove
1476	Eucalyptus tereticornis	Forest Red Gum	480		480	25	8	6	2	Regular	-	Thinning	Die-back	Epicormic	-	Poor	-	-	-	-	Typical	-	-	-	-	-	-	Remove
1477	Eucalyptus tereticornis	Forest Red Gum	350		350	26	7	4	2	Regular	-	Thinning	Die-back	Epicormic	-	Poor	-	-	-	-	Typical	-	-	-	-	-	-	Remove
1478	Corymbia citriodora	Spotted Gum	550		550	30	15	7	3	Regular	-	-	-	-	-	Typical	-	-	-	-	Typical	-	-	-	-	-	-	Remove
1479	Corymbia citriodora	Spotted Gum	420		420	27	9	5	2	One-sided	-	-	Die-back	-	-	Typical	-	-	-	-	Typical	-	-	-	-	-	-	Remove
1480	Corymbia citriodora	Spotted Gum	300		300	28	8	4	2	Regular	-	-	-	-	-	Typical	-	-	-	-	Typical	-	-	-	-	-	-	Remove
1481	Corymbia citriodora	Spotted Gum	410		410	27	8	5	2	Regular	-	-	Die-back	Epicormic	-	Typical	-	-	-	-	Typical	-	-	-	-	-	-	Remove
1482	Corymbia citriodora	Spotted Gum	340		340	17	9	4	2	Regular	-	Thinning	Die-back	Epicormic	-	Poor	-	-	Trunk Dmg.	-	Typical	-	-	-	-	-	-	Remove
1483	Corymbia citriodora	Spotted Gum	350		350	26	14	4	2	Regular	-	-	-	-	-	Typical	-	-	-	-	Typical	-	-	-	-	-	-	Remove
1484	Eucalyptus tereticornis	Forest Red Gum	330		330	13	4	4	2	One-sided	-	Thinning	Die-back	Epicormic	-	Poor	Major	-	Trunk Dmg.	-	Typical	-	-	-	-	-	-	Remove
1485	Corymbia citriodora	Spotted Gum	360		360	25	9	4	2	One-sided	-	-	Die-back	-	-	Typical	-	-	-	-	Typical	-	-	-	-	-	-	Remove
1486	Eucalyptus tereticornis	Forest Red Gum	530		530	29	13	6	3	Regular	-	-	-	-	-	Typical	-	-	-	-	Typical	-	-	-	-	-	-	Remove
1487	Corymbia citriodora	Spotted Gum	490		490	27	15	6	2	Regular	-	-	-	-	-	Typical	-	-	-	-	Typical	-	-	-	-	-	-	Remove
1488	Eucalyptus siderophloia	Grey Ironbark	270		270	17	9	3	2	Regular	-	-	Die-back	-	-	Typical	-	-	-	-	Typical	-	-	-	-	-	-	Retain
1489	Corymbia citriodora	Spotted Gum	410		410	24	11	5	2	Regular	-	-	-	-	-	Typical	-	-	-	-	Typical	-	-	-	-	-	-	Retain
1490	Corymbia citriodora	Spotted Gum	600		600	31	16	7	3	Regular	-	-	-	-	-	Typical	-	-	-	-	Typical	-	-	-	-	-	-	Retain
1491	Corymbia citriodora	Spotted Gum	300		300	19	9	4	2	Regular	-	-	-	-	-	Typical	-	-	-	-	Typical	-	-	-	-	-	-	Retain
1492	Angophora leiocarpa	Smooth-barked Apple	260		260	10	9	3	2	Regular	-	-	-	-	-	Typical	Major	-	-	-	Typical	-	-	-	-	-	-	Retain
1493	Eucalyptus crebra	Narrow-leaved Ironbark	380		380	21	14	5	2	Regular	-	-	-	-	-	Typical	-	-	-	-	Typical	-	-	-	-	-	-	Retain
1494	Eucalyptus crebra	Narrow-leaved Ironbark	510		510	24	13	6	2	Regular	-	-	Die-back	-	-	Typical	-	-	-	-	Typical	-	-	-	-	-	-	Retain
1495	Corymbia citriodora	Spotted Gum	330		330	16	14	4	2	Regular	-	-	-	-	-	Typical	-	-	-	-	Typical	-	-	-	-	-	-	Retain
1496	Eucalyptus moluccana	Gum Topped Box	250		250	22	10	3	2	Regular	-	-	-	-	-	Typical	-	-	-	-	Typical	-	-	-	-	-	-	Retain
1497	Eucalyptus moluccana	Gum Topped Box	200		200	12	9	2	2	Regular	-	-	-	-	-	Typical	-	-	-	-	Typical	-	-	-	-	-	-	Retain
1498	Eucalyptus tereticornis	Forest Red Gum	220		220	18	8	3	2	Regular	-	-	-	-	-	Typical	-	-	-	-	Typical	-	-	-	-	-	-	Retain
1499	Eucalyptus moluccana	Gum Topped Box	320		320	22	10	4	2	Regular	-	-	-	-	-	Typical	-	-	-	-	Typical	-	-	-	-	-	-	Retain
1500	Eucalyptus crebra	Narrow-leaved Ironbark	360		360	20	10	4	2	Regular	-	-	-	-	-	Typical	-	-	-	-	Typical	-	-	-	-	-	-	Retain
1501	Corymbia citriodora	Spotted Gum	250		250	19	8	3	2	Regular	-	-	-	-	-	Typical	-	-	Trunk Dmg.	-	Typical	-	-	-	-	-	-	Retain
1502	Eucalyptus crebra	Narrow-leaved Ironbark	360		360	21	9	4	2	Regular	-	-	-	-	-	Typical	-</											

Tree ID	Specimen Details								Canopy Condition Details								Trunk Condition Details					Fauna Details and Habitat Value							Retention
	Botanical Name	Common Name	Trunk DBH (mm)	Additional Trunks DBH (mm)	Total DBH (mm) [AS 4970-2009]	Height (m)	Spread (m)	Tree Protection Zone (m)	Structural Root Zone (m)	Canopy Form	Spreading	Thinning	Die-Back	Epicormic Growth	Lopped	Canopy Health	Leaning	Vines	Trunk Damage	Fire Damage	Trunk Health	Scats	Scratches	Hollows	Nest	Termite Nest	Habitat Value		
1506	Eucalyptus moluccana	Gum Topped Box	370		370	31	9	4	2	Regular	-	-	-	-	-	Typical	-	-	-	-	Typical	-	-	-	-	-	-	Retain	
1507	Eucalyptus moluccana	Gum Topped Box	350		350	24	11	4	2	Regular	-	-	-	-	-	Typical	-	-	-	-	Typical	-	-	-	-	-	-	Retain	
1508	Eucalyptus moluccana	Gum Topped Box	260	190	322	24	10	4	2	Regular	-	-	-	-	-	Typical	-	-	-	-	Typical	-	-	-	-	-	-	Retain	
1509	Angophora leiocarpa	Smooth-barked Apple	200		200	14	9	2	2	Regular	-	-	-	-	-	Typical	-	-	-	-	Typical	-	-	-	-	-	-	Retain	
1510	Eucalyptus moluccana	Gum Topped Box	350		350	23	9	4	2	Regular	-	-	-	-	-	Typical	-	-	Trunk Dmg.	-	Poor	-	-	-	-	-	-	Retain	
1511	Eucalyptus crebra	Narrow-leaved Ironbark	260		260	20	8	3	2	Regular	-	-	Die-back	-	-	Typical	-	-	-	-	Typical	-	-	-	-	-	-	Retain	
1512	Alphitonia excelsa	Soap Tree	200		200	12	9	2	2	Regular	-	-	-	-	-	Typical	-	-	-	-	Typical	-	-	-	-	-	-	Retain	
1513	Acacia disarrima	Hickory Wattle	200	130	239	13	6	3	2	Regular	-	-	Die-back	-	-	Typical	-	-	-	-	Typical	-	-	-	-	-	-	Retain	
1514	Corymbia citriodora	Spotted Gum	250		250	21	10	3	2	Regular	-	-	-	-	-	Typical	-	-	-	-	Typical	-	-	-	-	-	-	Retain	
1515	Eucalyptus tereticornis	Forest Red Gum	290		290	23	10	3	2	Regular	-	-	-	-	-	Typical	-	-	-	-	Typical	-	-	-	-	-	-	Retain	
1516	Eucalyptus crebra	Narrow-leaved Ironbark	260		260	19	8	3	2	Regular	-	-	-	-	-	Typical	-	-	-	-	Typical	-	-	-	-	Termites	-	Retain	
1517	Eucalyptus tereticornis	Forest Red Gum	270		270	23	10	3	2	Regular	-	-	-	-	-	Typical	-	-	-	-	Typical	-	-	-	-	-	-	Retain	
1518	Eucalyptus tereticornis	Forest Red Gum	280		280	21	10	3	2	Regular	-	-	-	-	-	Typical	-	-	-	-	Typical	-	-	-	-	-	-	Retain	
1519	Eucalyptus tereticornis	Forest Red Gum	230		230	14	5	3	2	Regular	-	-	-	-	Lopped	Typical	-	-	-	-	Typical	-	-	-	-	-	-	Retain	
1520	Corymbia citriodora	Spotted Gum	210		210	15	7	3	2	Regular	-	-	-	-	Lopped	Typical	-	-	-	-	Typical	-	-	-	-	-	-	Remove	
1521	Corymbia intermedia	Pink Bloodwood	210		210	19	9	3	2	Regular	-	-	-	-	-	Typical	-	-	-	-	Typical	-	-	-	-	-	-	Remove	
1522	Eucalyptus tereticornis	Forest Red Gum	250		250	25	8	3	2	Regular	-	-	-	-	-	Typical	-	-	-	-	Typical	-	-	-	-	-	-	Remove	
1523	Eucalyptus tereticornis	Forest Red Gum	250		250	27	9	3	2	Regular	-	-	-	-	-	Typical	-	-	-	-	Typical	-	-	-	-	-	-	Remove	
1524	Eucalyptus crebra	Narrow-leaved Ironbark	360		360	24	12	4	2	Regular	-	-	-	-	-	Typical	-	-	-	-	Typical	-	-	-	-	-	-	Remove	
1525	Lophostemon suaveolens	Swamp Box	230		230	13	8	3	2	Regular	-	-	-	-	-	Typical	-	-	-	-	Typical	-	-	-	-	-	-	Remove	
1526	Lophostemon suaveolens	Swamp Box	220	180	284	12	9	3	2	Regular	-	-	-	-	-	Typical	-	-	-	-	Typical	-	-	-	-	-	-	Remove	
1527	Eucalyptus tereticornis	Forest Red Gum	480		480	29	13	6	2	Regular	-	-	Die-back	-	-	Typical	-	-	-	-	Typical	-	-	-	-	-	-	Remove - LCC sewer works	
1528	Corymbia tessellaris	Moreton Bay Ash	260		260	24	10	3	2	Regular	-	-	-	-	-	Typical	-	-	-	-	Typical	-	-	-	-	-	-	Remove - LCC sewer works	
1937	Eucalyptus tereticornis	Forest Red Gum	350		350	28	8	4	2	One-sided	-	-	-	-	-	Typical	-	-	-	-	Typical	-	-	-	-	-	-	Retain	
1938	Eucalyptus tereticornis	Forest Red Gum	310		310	25	9	4	2	Regular	-	-	-	-	-	Typical	-	-	-	-	Typical	-	-	-	-	-	-	Retain	
1940	Corymbia citriodora	Spotted Gum	230		230	21	5	3	2	Regular	-	-	-	-	-	Typical	-	-	-	-	Typical	-	-	-	-	-	-	Retain	
1941	Corymbia citriodora	Spotted Gum	280		280	17	8	3	2	One-sided	-	-	-	-	-	Typical	Minor	-	-	-	Typical	-	-	-	-	-	-	Retain	
1942	Eucalyptus tereticornis	Forest Red Gum	430		430	24	10	5	2	Regular	-	-	-	-	-	Typical	-	-	-	-	Typical	-	-	-	-	-	-	Retain	
1943	Corymbia citriodora	Spotted Gum	370		370	26	14	4	2	Regular	-	-	-	-	-	Typical	-	-	-	-	Typical	-	-	-	-	-	-	Retain	
1944	Eucalyptus tereticornis	Forest Red Gum	310		310	24	12	4	2	Regular	-	-	-	-	-	Typical	-	-	-	-	Typical	-	-	-	-	Termites	-	Retain	
1945	Corymbia citriodora	Spotted Gum	260		260	21	7	3	2	Regular	-	-	Die-back	-	-	Typical	-	-	-	-	Typical	-	-	-	-	-	-	Retain	
1946	Corymbia citriodora	Spotted Gum	450		450	27	16	5	2	Regular	-	-	-	-	-	Typical	-	-	-	-	Typical	-	-	-	-	-	-	Retain	
1947	Angophora leiocarpa	Smooth-barked Apple	220		220	17	8	3	2	Regular	-	-	-	-	-	Typical	-	-	-	-	Typical	-	-	-	-	-	-	Retain	
1948	Eucalyptus tereticornis	Forest Red Gum	510		510	28	14	6	2	Regular	-	-	-	-	-	Typical	-	-	-	-	Typical	-	-	-	-	-	-	Retain	
1949	Corymbia intermedia	Pink Bloodwood	260		260	18	8	3	2	One-sided	-	-	-	-	-	Typical	-	-	-	-	Typical	-	-	-	-	-	-	Retain	
1950	Eucalyptus tereticornis	Forest Red Gum	500		500	25	14	6	2	Regular	-	-	-	-	-	Typical	-	-	-	-	Typical	-	-	-	-	-	-	Retain	
1951	Corymbia citriodora	Spotted Gum	350		350	26	10	4	2	Regular	-	-	-	-	-	Typical	-	-	-	-	Typical	-	-	-	-	-	-	Retain	
1952	Eucalyptus tereticornis	Forest Red Gum	260		260	16	6	3	2	Regular	-	-	-	-	-	Typical	Major	-	-	-	Typical	-	-	-	-	-	-	Retain	
1953	Corymbia citriodora	Spotted Gum	710		710	30	15	9	3	Regular	-	-	-	-	-	Typical	-	-	-	-	Typical	-	-	-	-	-	-	Retain	
1954	Eucalyptus tereticornis	Forest Red Gum	280		280	24	12	3	2	Regular	-	-	-	-	-	Typical	-	-	-	-	Typical	-	-	-	-	-	-	Retain	
1955	Corymbia citriodora	Spotted Gum	240		240	18	8	3	2	One-sided	-	-	-	-	-	Typical	-	-	-	-	Typical	-	-	-	-	-	-	Retain	
1956	Corymbia citriodora	Spotted Gum	510		510	26	12	6	2	Regular	-	-	-	-	-	Typical	-	-	-	-	Typical	-	-	-	-	-	-	Retain	
1957	Corymbia citriodora	Spotted Gum	200		200	12	7	2	2	One-sided	-	-	-	-	-	Typical	-	-	-	-	Typical	-	-	-	-	-	-	Retain	
1958	Corymbia citriodora	Spotted Gum	300		300	27	10	4	2	Regular	-	-	-	-	-	Typical	-	-	-	-	Typical	-	-	-	-	-	-	Retain	
1959	Eucalyptus tereticornis	Forest Red Gum	320		320	23	9	4	2	Regular	-	Thinning	-	-	-	Typical	-	-	-	-	Typical	-	-	-	-	-	-	Remove	
1960	Corymbia citriodora	Spotted Gum	240		240	23	10	3	2	Regular	-	-	-	-	-	Typical	-	-	-	-	Typical	-	-	-	-	-	-	Remove	
1961	Eucalyptus tereticornis	Forest Red Gum	210		210	18	5	3	2	Regular	-	Thinning	Die-back	-	-	Typical	-	-	-	-	Typical	-	-	-	-	-	-	Retain	
1962	Petalostigma pubescens	Quinine Bush	260		260	8	5	3	2	Regular	-	-	-	-	-	Typical	-	-	-	-	Typical	-	-	-	-	-	-	Remove	
1963	Corymbia intermedia	Pink Bloodwood	250		250	22	8	3	2	Regular	-	-	-	-	-	Typical	-	-	-	-	Typical	-	-	-	-	-	-	Remove	
1964	Corymbia citriodora	Spotted Gum	260		260	25	7	3	2	Regular	-	-	-	-	-	Typical	-	-	-	-	Typical	-	-	-	-	-	-	Remove	
1965	Corymbia citriodora	Spotted Gum	320		320	23	10	4	2	Regular	-	-	-	-	-	Typical	-	-	-	-	Typical	-	-	-	-	-	-	Remove	
1966	Corymbia citriodora	Spotted Gum	270		270	23	9	3	2	Regular	-	-	-	-	-	Typical	-	-	-	-	Typical	-	-	-	-	-	-	Remove	
1967	Corymbia citriodora	Spotted Gum	230		230	21	6	3	2	Regular	-	-	-	-	-	Typical	-	-	-	-	Typical	-	-	-	-	-	-	Remove	
1968	Eucalyptus tereticornis	Forest Red Gum	340		340	24	12	4	2	Regular	-	-	-	-	-	Typical	-	-	-	-	Typical	-	-	-	-	-	-	Remove	
1969	Corymbia citriodora	Spotted Gum	250		250	25	8	3	2	Regular	-	-	-	-	-	Typical	-	-	-	-	Typical	-	-	-	-	-	-	Remove	
1970	Corymbia citriodora	Spotted Gum	240		240	25	10	3	2	Regular	-	-	-	-	-	Typical	-	-	-	-	Typical	-	-	-	-	-	-	Remove	
1971	Corymbia citriodora	Spotted Gum	380		380	27	14	5	2	Regular	-	-	-	-	-	Typical	-	-	-	-	Typical	-	-	-	-	-	-	Remove	
1972	Corymbia citriodora	Spotted Gum	210		210	22	9	3	2	Regular	-	-	-	-	-	Typical	-	-	-	-	Typical	-	-	-	-	-	-	Remove	
1973	Corymbia citriodora	Spotted Gum	210		210	22	4	3	2	Regular	-	-	-	-	-	Typical	-	-	-	-	Typical	-	-	-	-	-	-	Remove	
1974	Corymbia citriodora	Spotted Gum	480		480	29	12	6	2	Regular	-	-	-	-	-	Typical	-	-	-	-	Typical	-	-	-	-	-	-	Remove	
1975	Corymbia citriodora	Spotted Gum	330		330	26	14	4	2	Regular	-	-	-	-	-	Typical	-	-	-	-	Typical	-	-	-	-	-	-	Remove	
1976	Corymbia citriodora	Spotted Gum	310		310	23	16	4	2	Regular	-	-	-	-	-	Typical	-	-	-	-	Typical	-	-	-	-	-	-	Remove	
1977	Eucalyptus tereticornis	Forest Red Gum	330		330	26	8	4	2	Regular	-	-	-	-	-	Typical	-	-	-	-	Typical	-	-	-	-	-	-	Remove	
1978	Eucalyptus tereticornis	Forest Red Gum	360		360	27	13	4	2	Regular	-	-	-	-	-	Typical	-	-	-	-	Typical	-	-	-	-	-	-	Remove	
1979	Eucalyptus tereticornis	Forest Red Gum	220		220	19	5	3	2	Regular	-	-	-	-	-	Typical	-	-	-	-	Typical								

Tree ID	Specimen Details								Canopy Condition Details								Trunk Condition Details					Fauna Details and Habitat Value						
	Botanical Name	Common Name	Trunk DBH (mm)	Additional Trunks DBH (mm)	Total DBH (mm) [AS 4970-2009]	Height (m)	Spread (m)	Tree Protection Zone (m)	Structural Root Zone (m)	Canopy Form	Spreading	Thinning	Die-Back	Epicormic Growth	Lopped	Canopy Health	Leaning	Vines	Trunk Damage	Fire Damage	Trunk Health	Scats	Scratches	Hollows	Nest	Termite Nest	Habitat Value	Retention
1983	Eucalyptus crebra	Narrow-leaved Ironbark	350		350	23	15	4	2	Regular	-	-	-	-	-	Typical	-	-	-	-	Typical	-	-	-	-	-	-	Remove
1984	Corymbia citriodora	Spotted Gum	430		430	30	17	5	2	Regular	-	-	-	-	-	Typical	-	-	-	-	Typical	-	-	-	-	-	-	Remove
1985	Corymbia citriodora	Spotted Gum	390		390	29	17	5	2	Regular	-	-	-	-	-	Typical	-	-	-	-	Typical	-	-	-	-	-	-	Remove
1986	Corymbia citriodora	Spotted Gum	450		450	24	12	5	2	Regular	-	-	-	-	-	Typical	-	-	-	-	Typical	-	-	-	-	-	-	Remove
1987	Corymbia citriodora	Spotted Gum	240		240	16	7	3	2	Regular	-	-	-	-	-	Typical	Major	-	-	-	Typical	-	-	-	-	-	-	Remove
1988	Eucalyptus crebra	Narrow-leaved Ironbark	500		500	26	12	6	2	One-sided	-	-	-	-	-	Typical	Minor	-	-	-	Typical	-	-	-	-	-	-	Remove
1989	Corymbia citriodora	Spotted Gum	240		240	16	8	3	2	Regular	-	-	-	-	-	Typical	-	-	-	-	Typical	-	-	-	-	-	-	Remove
1990	Eucalyptus tereticornis	Forest Red Gum	550		550	26	8	7	3	Regular	-	-	-	-	-	Typical	-	-	-	-	Typical	-	-	-	-	-	-	Retain
1991	Corymbia citriodora	Spotted Gum	230		230	19	6	3	2	Regular	-	-	-	-	-	Typical	-	-	-	-	Typical	-	-	-	-	-	-	Retain
1992	Corymbia citriodora	Spotted Gum	250		250	18	6	3	2	Regular	-	-	-	-	-	Typical	-	-	-	-	Typical	-	-	-	-	-	-	Retain
1993	Corymbia citriodora	Spotted Gum	220		220	23	5	3	2	One-sided	-	-	Die-back	-	-	Typical	-	-	-	-	Typical	-	-	-	-	-	-	Retain
1994	Eucalyptus crebra	Narrow-leaved Ironbark	240		240	21	6	3	2	One-sided	-	-	-	-	-	Typical	-	-	-	-	Typical	-	-	-	-	-	-	Retain
1995	Corymbia citriodora	Spotted Gum	240		240	18	8	3	2	Regular	-	-	-	-	-	Typical	-	-	-	-	Typical	-	-	-	-	-	-	Retain
1996	Eucalyptus crebra	Narrow-leaved Ironbark	210		210	19	4	3	2	One-sided	-	-	Die-back	Epicormic	-	Poor	-	-	-	-	Typical	-	-	-	-	-	-	Retain
1997	Eucalyptus crebra	Narrow-leaved Ironbark	240		240	14	6	3	2	Regular	-	-	Die-back	Epicormic	-	Typical	-	-	-	-	Typical	-	-	-	-	-	-	Retain
1998	Eucalyptus crebra	Narrow-leaved Ironbark	290		290	17	12	3	2	Regular	-	-	-	-	-	Typical	-	-	-	-	Typical	-	-	-	Termites	-	-	Retain
1999	Corymbia citriodora	Spotted Gum	240		240	15	8	3	2	Regular	-	-	-	-	-	Typical	-	-	-	-	Typical	-	-	-	-	-	-	Retain
2000	Eucalyptus moluccana	Gum Topped Box	330		330	22	7	4	2	Regular	-	-	-	-	-	Typical	-	-	Trunk Dmg.	-	Typical	-	-	-	-	-	-	Retain
2001	Eucalyptus moluccana	Gum Topped Box	480		480	31	11	6	2	Regular	-	-	-	-	-	Typical	-	-	-	-	Typical	-	-	-	-	-	-	Retain
2002	Corymbia citriodora	Spotted Gum	240		240	18	9	3	2	Regular	-	-	-	-	-	Typical	-	-	-	-	Typical	-	-	-	-	-	-	Retain
2003	Corymbia citriodora	Spotted Gum	410		410	23	8	5	2	Regular	-	-	Die-back	-	-	Typical	-	-	-	-	Typical	-	-	-	-	-	-	Retain
2004	Corymbia citriodora	Spotted Gum	250		250	21	7	3	2	Regular	-	-	Die-back	-	-	Typical	-	-	-	-	Typical	-	-	-	-	-	-	Retain
2005	Eucalyptus moluccana	Gum Topped Box	530		530	30	13	6	3	Regular	-	-	-	-	-	Typical	-	-	-	-	Typical	-	-	-	-	-	-	Remove
2006	Eucalyptus crebra	Narrow-leaved Ironbark	200		200	13	7	2	2	Regular	-	-	-	-	-	Typical	-	-	Trunk Dmg.	-	Typical	-	-	-	-	-	-	Remove
2007	Corymbia citriodora	Spotted Gum	320	280	425	24	12	5	2	Regular	-	-	-	-	-	Typical	-	-	-	-	Typical	-	-	-	-	-	-	Remove
2008	Corymbia citriodora	Spotted Gum	300		300	28	8	4	2	One-sided	-	-	Die-back	-	-	Typical	-	-	-	-	Typical	-	-	-	-	-	-	Remove
2009	Eucalyptus moluccana	Gum Topped Box	200		200	16	8	2	2	Regular	-	-	-	-	-	Typical	-	-	-	-	Typical	-	-	-	-	-	-	Remove
2010	Corymbia citriodora	Spotted Gum	260		260	25	8	3	2	Regular	-	-	-	-	-	Typical	-	-	-	-	Typical	-	-	-	-	-	-	Remove
2011	Corymbia citriodora	Spotted Gum	300		300	26	15	4	2	Regular	-	-	-	-	-	Typical	-	-	-	-	Typical	-	-	-	-	-	-	Retain
2012	Corymbia citriodora	Spotted Gum	300		300	28	7	4	2	Regular	-	-	-	-	-	Typical	-	-	-	-	Typical	-	-	-	-	-	-	Retain
2013	Corymbia citriodora	Spotted Gum	230		230	25	5	3	2	One-sided	-	-	-	-	-	Typical	-	-	-	-	Typical	-	-	-	-	-	-	Retain
2014	Eucalyptus moluccana	Gum Topped Box	360		360	29	12	4	2	Regular	-	-	-	-	-	Typical	Major	-	-	-	Typical	-	-	-	-	-	-	Retain
2015	Eucalyptus crebra	Narrow-leaved Ironbark	230		230	24	8	3	2	Regular	-	-	-	-	-	Typical	-	-	-	-	Typical	-	-	-	-	-	-	Retain
2016	Corymbia citriodora	Spotted Gum	260		260	17	9	3	2	Regular	-	-	-	-	-	Typical	-	-	-	-	Typical	-	-	-	-	-	-	Remove
2017	Corymbia citriodora	Spotted Gum	200		200	24	5	2	2	Regular	-	-	-	-	-	Typical	-	-	-	-	Typical	-	-	-	-	-	-	Remove
2018	Corymbia citriodora	Spotted Gum	210		210	22	8	3	2	Regular	-	-	-	-	-	Typical	-	-	-	-	Typical	-	-	-	-	-	-	Remove
2019	Corymbia citriodora	Spotted Gum	410		410	29	14	5	2	Regular	-	-	-	-	-	Typical	-	-	-	-	Typical	-	-	-	-	-	-	Retain
2020	Corymbia citriodora	Spotted Gum	360		360	26	15	4	2	Regular	-	-	-	-	-	Typical	-	-	-	-	Typical	-	-	-	-	-	-	Retain
2021	Corymbia citriodora	Spotted Gum	390		390	32	13	5	2	Regular	-	-	-	-	-	Typical	-	-	-	-	Typical	-	-	-	-	-	-	Retain
2022	Corymbia citriodora	Spotted Gum	370		370	28	11	4	2	Regular	-	-	-	-	-	Typical	-	-	-	-	Typical	-	-	-	-	-	-	Retain
2023	Eucalyptus crebra	Narrow-leaved Ironbark	200	170	262	15	8	3	2	Regular	-	-	-	-	-	Typical	-	-	-	-	Typical	-	-	-	-	-	-	Retain
2024	Corymbia citriodora	Spotted Gum	370		370	29	17	4	2	Regular	-	-	-	-	-	Typical	-	-	-	-	Typical	-	-	-	-	-	-	Retain
2025	Corymbia citriodora	Spotted Gum	380		380	30	16	5	2	Regular	-	-	-	-	-	Typical	-	-	-	-	Typical	-	-	-	-	-	-	Retain
2026	Corymbia citriodora	Spotted Gum	270		270	23	11	3	2	Regular	-	-	-	-	-	Typical	-	-	-	-	Typical	-	-	-	-	-	-	Retain
2027	Corymbia citriodora	Spotted Gum	420		420	26	12	5	2	Regular	-	-	-	-	-	Typical	-	-	-	-	Typical	-	-	-	-	-	-	Retain
2028	Corymbia citriodora	Spotted Gum	210		210	19	5	3	2	One-sided	-	-	Die-back	-	-	Typical	-	-	-	-	Typical	-	-	-	-	-	-	Retain
2029	Corymbia citriodora	Spotted Gum	330		330	31	15	4	2	Regular	-	-	-	-	-	Typical	-	-	-	-	Typical	-	-	-	-	-	-	Retain
2030	Eucalyptus crebra	Narrow-leaved Ironbark	210		210	14	9	3	2	Regular	-	Thinning	Die-back	-	-	Poor	-	-	-	-	Typical	-	-	-	-	-	-	Retain
2031	Corymbia citriodora	Spotted Gum	250		250	22	9	3	2	One-sided	-	-	-	-	-	Typical	Minor	-	-	-	Typical	-	-	-	-	-	-	Retain
2032	Corymbia citriodora	Spotted Gum	280		280	25	10	3	2	Regular	-	-	-	-	-	Typical	-	-	-	-	Typical	-	-	-	-	-	-	Retain
2033	Eucalyptus crebra	Narrow-leaved Ironbark	200		200	21	8	2	2	Regular	-	-	-	-	-	Typical	-	-	-	-	Typical	-	-	-	-	-	-	Retain
2034	Corymbia citriodora	Spotted Gum	290		290	27	11	3	2	Regular	-	-	-	-	-	Typical	-	-	-	-	Typical	-	-	-	-	-	-	Retain
2035	Corymbia citriodora	Spotted Gum	240		240	16	8	3	2	One-sided	-	-	-	-	-	Typical	-	-	-	-	Typical	-	-	-	-	-	-	Retain
2036	Corymbia citriodora	Spotted Gum	210		210	15	6	3	2	Regular	-	-	-	-	-	Typical	-	-	-	-	Typical	-	-	-	-	-	-	Retain
2037	Corymbia citriodora	Spotted Gum	250		250	28	9	3	2	Regular	-	-	-	-	-	Typical	-	-	-	-	Typical	-	-	-	-	-	-	Retain
2038	Eucalyptus crebra	Narrow-leaved Ironbark	270		270	29	9	3	2	Regular	-	-	-	-	-	Typical	-	-	Trunk Dmg.	-	Typical	-	-	-	-	-	-	Retain
2039	Eucalyptus crebra	Narrow-leaved Ironbark	250		250	21	8	3	2	Regular	-	-	-	-	-	Typical	-	-	-	-	Typical	-	-	-	-	-	-	Retain
2040	Eucalyptus moluccana	Gum Topped Box	220		220	22	9	3	2	Regular	-	-	-	-	-	Typical	-	-	-	-	Typical	-	-	-	-	-	-	Retain
2041	Corymbia citriodora	Spotted Gum	350		350	28	16	4	2	Regular	-	-	-	-	-	Typical	-	-	-	-	Typical	-	-	-	-	-	-	Retain
2042	Corymbia citriodora	Spotted Gum	200		200	15	6	2	2	Regular	-	-	-	-	-	Typical	-	-	-	-	Typical	-	-	-	-	-	-	Retain
2043	Corymbia citriodora	Spotted Gum	330		330	26	10	4	2	Regular	-	-	-	-	-	Typical	-	-	-	-	Typical	-	-	-	-	-	-	Retain
2044	Corymbia citriodora	Spotted Gum	250		250	26	5	3	2	Regular	-	-	Die-back	Epicormic	-	Poor	-	-	-	-	Typical	-	-	-	-	-	-	Retain
2045	Eucalyptus moluccana	Gum Topped Box	400		400	29	12	5	2	Regular	-	-	-	-	-	Typical	-	-	-	-	Typical	-	-	-	-	-	-	Retain
2046	Corymbia citriodora	Spotted Gum	290		290	20	10	3	2	Regular	-	-	-	-	-	Typical	-	-	-	-	Typical	-	-	-	-	-	-	Retain
2047	Corymbia citriodora	Spotted Gum	290		290	19	8	3	2	One-sided	-	-	-	-	-	Typical	-	-										

Tree ID	Specimen Details								Canopy Condition Details								Trunk Condition Details					Fauna Details and Habitat Value							
	Botanical Name	Common Name	Trunk DBH (mm)	Additional Trunks DBH (mm)	Total DBH (mm) [AS 4970-2009]	Height (m)	Spread (m)	Tree Protection Zone (m)	Structural Root Zone (m)	Canopy Form	Spreading	Thinning	Die-back	Epicormic Growth	Lopped	Canopy Health	Leaning	Vines	Trunk Damage	Fire Damage	Trunk Health	Scats	Scratches	Hollows	Nest	Termite Nest	Habitat Value	Retention	
2294	Eucalyptus tereticornis	Forest Red Gum	290		290	16	3	3	2	Regular	-	Thinning	-	Epicormic	-	Poor	-	-	-	-	Typical	-	-	-	-	-	-	Retain	
2295	Corymbia citriodora	Spotted Gum	255		255	18	5	3	2	Regular	-	-	-	-	-	Typical	-	-	-	-	Typical	-	-	-	-	-	-	Retain	
2296	Eucalyptus siderophloia	Grey Ironbark	220		220	16	3	3	2	Regular	-	-	-	-	-	Typical	-	-	-	-	Typical	-	-	-	-	-	-	Retain	
2297	Eucalyptus siderophloia	Grey Ironbark	460		460	19	4	6	2	Regular	-	-	-	-	-	Typical	-	-	Trunk Dmg.	-	Poor	-	-	-	-	-	-	Retain	
2298	Eucalyptus siderophloia	Grey Ironbark	500		500	22	9	6	2	Regular	-	-	-	-	-	Typical	-	-	Trunk Dmg.	-	Typical	-	-	-	-	-	-	Retain	
2299	Eucalyptus tereticornis	Forest Red Gum	800		800	24	9	10	3	Regular	-	Thinning	Die-back	-	-	Typical	-	-	-	-	Typical	-	-	Small	-	-	-	Retain	
2300	Corymbia citriodora	Spotted Gum	480		480	27	10	6	2	Regular	-	-	-	-	-	Typical	-	-	-	-	Typical	-	-	-	-	-	-	Remove	
2301	Eucalyptus tereticornis	Forest Red Gum	440		440	25	10	5	2	Regular	-	-	-	-	-	Typical	Minor	-	-	-	Typical	-	-	-	-	-	-	Remove	
2302	Corymbia citriodora	Spotted Gum	210		210	16	4	3	2	Regular	-	-	-	-	-	Typical	-	-	-	-	Typical	-	-	-	-	-	-	Remove	
2303	Corymbia citriodora	Spotted Gum	370		370	22	5	4	2	Regular	-	-	-	-	-	Typical	-	-	-	-	Typical	-	-	-	-	-	-	Remove	
2304	Corymbia citriodora	Spotted Gum	220		220	15	4	3	2	Regular	-	-	-	-	-	Typical	-	-	-	-	Typical	-	-	-	-	-	-	Remove	
2305	Corymbia citriodora	Spotted Gum	320		320	18	3	4	2	Regular	-	Thinning	Die-back	Epicormic	-	Poor	-	-	-	-	Typical	-	-	-	-	-	-	Remove	
2306	Eucalyptus tereticornis	Forest Red Gum	560		560	16	8	7	3	Regular	-	Thinning	Die-back	Epicormic	-	Poor	-	-	Trunk Dmg.	-	Typical	-	Old	Small	-	-	-	Remove	
2307	Eucalyptus tereticornis	Forest Red Gum	410		410	20	4	5	2	Regular	-	-	-	-	-	Typical	-	-	-	-	Typical	-	-	-	-	-	-	Remove	
2308	Corymbia tessellaris	Moreton Bay Ash	400		400	23	6	5	2	One-sided	-	-	-	-	-	Typical	-	-	-	-	Typical	-	-	-	-	-	-	Remove	
2309	Corymbia citriodora	Spotted Gum	520		520	26	10	6	3	Regular	-	-	-	-	-	Typical	-	-	-	-	Typical	-	-	-	-	-	-	Remove	
2310	Corymbia citriodora	Spotted Gum	220		220	17	4	3	2	Regular	-	-	-	-	-	Typical	-	-	-	-	Typical	-	-	-	-	-	-	Remove	
2311	Eucalyptus crebra	Narrow-leaved Ironbark	420		420	26	9	5	2	Regular	-	-	-	-	-	Typical	-	-	-	-	Typical	-	-	-	-	-	-	Remove	
2312	Corymbia citriodora	Spotted Gum	340		340	18	2	4	2	Regular	-	Thinning	Die-back	Epicormic	Lopped	Poor	-	-	-	-	Typical	-	-	-	-	-	-	Remove	
2313	Eucalyptus siderophloia	Grey Ironbark	245		245	16	4	3	2	One-sided	-	-	-	-	-	Typical	-	-	-	-	Typical	-	-	-	-	-	-	Remove	
2314	Corymbia citriodora	Spotted Gum	215	230, 150, 100	363	17	5	4	2	Regular	-	-	-	-	-	Typical	-	-	-	-	Typical	-	-	-	-	-	-	Remove	
2315	Corymbia citriodora	Spotted Gum	480		480	24	10	6	2	Regular	-	-	-	Epicormic	-	Typical	-	-	-	-	Typical	-	-	-	-	-	-	Remove	
2316	Eucalyptus siderophloia	Grey Ironbark	195		195	15	4	2	2	Regular	-	-	-	-	-	Typical	-	-	-	-	Typical	-	-	-	-	-	-	Remove	
2317	Eucalyptus siderophloia	Grey Ironbark	460		460	25	10	6	2	Regular	-	-	-	-	-	Typical	-	-	-	-	Typical	-	-	-	-	-	-	Remove	
2318	Eucalyptus siderophloia	Grey Ironbark	280		280	19	2	3	2	Regular	-	Thinning	Die-back	-	-	Poor	-	-	-	-	Typical	-	-	-	-	-	-	Remove	
2319	Eucalyptus siderophloia	Grey Ironbark	255		255	16	3	3	2	Regular	-	-	-	-	-	Typical	-	-	-	-	Typical	-	-	-	-	-	-	Remove	
2320	Corymbia citriodora	Spotted Gum	220		220	15	3	3	2	Regular	-	-	-	-	-	Typical	-	-	-	-	Typical	-	-	-	-	-	-	Remove	
2321	Corymbia citriodora	Spotted Gum	215		215	16	4	3	2	Regular	-	-	-	-	-	Typical	-	-	-	-	Typical	-	-	-	-	-	-	Remove	
2322	Corymbia citriodora	Spotted Gum	310		310	18	5	4	2	One-sided	-	Thinning	Die-back	Epicormic	-	Poor	-	-	-	-	Typical	-	-	-	-	-	-	Remove	
2323	Corymbia tessellaris	Moreton Bay Ash	260		260	17	3	3	2	Regular	-	Thinning	-	Epicormic	-	Poor	-	-	-	-	Typical	-	-	-	-	-	-	Remove	
2324	Eucalyptus crebra	Narrow-leaved Ironbark	530		530	26	10	6	3	Regular	-	-	-	-	-	Typical	-	-	-	-	Typical	-	-	-	-	-	-	Retain	
2325	Eucalyptus crebra	Narrow-leaved Ironbark	440		440	22	5	5	2	Regular	-	Thinning	-	Epicormic	-	Poor	-	-	-	-	Typical	-	-	-	-	-	-	Retain	
2326	Corymbia citriodora	Spotted Gum	215		215	16	4	3	2	Regular	-	-	-	-	-	Typical	-	-	-	-	Typical	-	-	-	-	-	-	Retain	
2327	Corymbia citriodora	Spotted Gum	390		390	17	5	5	2	Regular	-	-	-	-	-	Typical	-	-	-	-	Typical	-	-	-	-	-	-	Retain	
2328	Corymbia citriodora	Spotted Gum	530		530	24	14	6	3	Regular	-	-	-	-	-	Typical	-	-	-	-	Typical	-	-	-	-	-	-	Retain	
2329	Corymbia citriodora	Spotted Gum	400		400	20	8	5	2	Regular	-	-	-	-	-	Typical	-	-	-	-	Typical	-	-	-	-	-	-	Retain	
2330	Eucalyptus siderophloia	Grey Ironbark	240	120	268	16	4	3	2	Regular	-	-	-	-	-	Typical	-	-	-	-	Typical	-	-	-	-	-	-	Retain	
2331	Eucalyptus siderophloia	Grey Ironbark	330		330	18	5	4	2	Regular	-	-	-	-	-	Typical	-	-	-	-	Typical	-	-	-	-	-	-	Retain	
2332	Corymbia citriodora	Spotted Gum	300		300	17	4	4	2	Regular	-	-	-	-	-	Typical	-	-	-	-	Typical	-	-	Small	-	-	-	Retain	
2333	Eucalyptus crebra	Narrow-leaved Ironbark	400		400	18	9	5	2	Regular	-	-	-	-	-	Typical	-	-	-	-	Typical	-	-	-	-	-	-	Retain	
2334	Corymbia citriodora	Spotted Gum	480		480	24	8	6	2	Regular	-	Thinning	Die-back	Epicormic	-	Poor	-	-	-	-	Typical	-	-	-	-	-	-	Retain	
2335	Corymbia citriodora	Spotted Gum	380		380	23	9	5	2	Regular	-	-	-	-	-	Typical	-	-	-	-	Typical	-	-	-	-	-	-	Retain	
2336	Eucalyptus siderophloia	Grey Ironbark	300		300	18	4	4	2	Regular	-	-	-	-	-	Typical	-	-	-	-	Typical	-	-	-	-	-	-	Retain	
2337	Eucalyptus moluccana	Gum Topped Box	520		520	27	9	6	3	Regular	-	-	-	-	-	Typical	-	-	-	-	Typical	-	-	-	-	-	-	Retain	
2338	Eucalyptus tereticornis	Forest Red Gum	285		285	20	5	3	2	Regular	-	-	-	-	-	Typical	-	-	-	-	Typical	-	-	-	-	-	-	Retain	
2339	Eucalyptus siderophloia	Grey Ironbark	240		240	17	3	3	2	Regular	-	-	-	-	-	Typical	-	-	-	-	Typical	-	-	-	-	-	-	Retain	
2340	Eucalyptus siderophloia	Grey Ironbark	245		245	16	3	3	2	Regular	-	-	-	-	-	Typical	-	-	-	-	Typical	-	-	-	-	-	-	Retain	
2341	Corymbia citriodora	Spotted Gum	195		195	10	2	2	2	Regular	-	Thinning	Die-back	Epicormic	-	Poor	-	-	-	-	Typical	-	-	-	-	-	-	Retain	
2342	Angophora leiocarpa	Smooth-barked Apple	450		450	24	9	5	2	Regular	-	-	-	-	-	Typical	-	-	-	-	Typical	-	-	-	-	-	-	Retain	
2343	Eucalyptus moluccana	Gum Topped Box	475		475	28	10	6	2	Regular	-	-	-	-	-	Typical	-	-	-	-	Typical	-	-	-	-	-	-	Retain	
2344	Corymbia citriodora	Spotted Gum	270		270	18	3	3	2	Regular	-	Thinning	Die-back	Epicormic	-	Poor	-	-	-	-	Typical	-	-	-	-	-	-	Retain	
2345	Eucalyptus moluccana	Gum Topped Box	540		540	26	8	6	3	One-sided	-	-	-	-	-	Typical	-	-	-	-	Typical	-	-	-	-	-	-	Retain	
2346	Eucalyptus moluccana	Gum Topped Box	315		315	20	5	4	2	Regular	-	-	-	-	-	Typical	-	-	-	-	Typical	-	-	-	-	-	-	Retain	
2347	Corymbia citriodora	Spotted Gum	255		255	18	3	3	2	Regular	-	Thinning	-	Epicormic	-	Poor	-	-	-	-	Typical	-	-	-	-	-	-	Retain	
2348	Eucalyptus moluccana	Gum Topped Box	315		315	15	4	4	2	Regular	-	-	-	-	-	Typical	-	-	-	-	Typical	-	-	-	-	-	-	Retain	
2349	Eucalyptus moluccana	Gum Topped Box	320		320	19	5	4	2	Regular	-	-	-	-	-	Typical	-	-	-	-	Typical	-	-	-	-	-	-	Retain	
2350	Eucalyptus moluccana	Gum Topped Box	640		640	27	14	8	3	Regular	-	-	-	-	-	Typical	-	-	-	-	Typical	-	-	-	-	-	-	Retain	
2351	Corymbia citriodora	Spotted Gum	350		350	27	5	4	2	Regular	-	Thinning	Die-back	Epicormic	-	Poor	-	-	-	-	Typical	-	-	-	-	-	-	Retain	
2352	Corymbia citriodora	Spotted Gum	230		230	18	3	3	2	Regular	-	Thinning	-	Epicormic	-	Poor	-	-	-	-	Typical	-	-	-	-	-	-	Retain	
2353	Eucalyptus crebra	Narrow-leaved Ironbark	210		210	18	6	3	2	Regular	-	-	-	-	-	Typical	-	-	-	-	Typical	-	-	-	-	-	-	Retain	
2354	Corymbia citriodora	Spotted Gum	230		230	22	7	3	2	Regular	-	-	-	-	-	Typical	-	-	-	-	Typical	-	-	-	-	-	-	Retain	
2355	Corymbia citriodora	Spotted Gum	270		270	23	6	3	2	Regular	-	-	-	-	-	Typical	-	-	-	-	Typical	-	-	-	-	-	-	Retain	
2356	Corymbia citriodora	Spotted Gum	260		260	22	5	3	2	Regular	-	-	-	-	-	Typical	-	-	-	-	Typical	-	-	-	-	-	-	Retain	
2357	Corymbia citriodora	Spotted Gum	220		220	20	5	3	2	Regular	-	-	-	-	-	Typical	-	-	-	-	Typical	-	-	-	-	-	-	Retain	
2358	Corymbia citriodora	Spotted Gum	340		340	20	6	4																					

Tree ID	Specimen Details								Canopy Condition Details								Trunk Condition Details					Fauna Details and Habitat Value							
	Botanical Name	Common Name	Trunk DBH (mm)	Additional Trunks DBH (mm)	Total DBH (mm) [AS 4970-2009]	Height (m)	Spread (m)	Tree Protection Zone (m)	Structural Root Zone (m)	Canopy Form	Spreading	Thinning	Die-Back	Epicormic Growth	Lopped	Canopy Health	Leaning	Vines	Trunk Damage	Fire Damage	Trunk Health	Scats	Scratches	Hollows	Nest	Termite Nest	Habitat Value	Retention	
2362	Corymbia citriodora	Spotted Gum	230		230	14	4	3	2	One-sided	-	-	-	-	-	Typical	-	-	-	-	Typical	-	-	-	-	-	-	Retain	
2363	Eucalyptus siderophloia	Grey Ironbark	385		385	21	4	5	2	Regular	-	Thinning	Die-back	Epicormic	-	Poor	-	-	Trunk Dmg.	-	Typical	-	-	-	-	-	-	Retain	
2364	Corymbia citriodora	Spotted Gum	230		230	23	4	3	2	Regular	-	-	-	-	-	Typical	-	-	-	-	Typical	-	-	-	-	-	-	Retain	
2365	Corymbia citriodora	Spotted Gum	265		265	21	6	3	2	Regular	-	-	-	-	-	Typical	-	-	-	-	Typical	-	-	-	-	-	-	Retain	
2366	Corymbia citriodora	Spotted Gum	240		240	20	6	3	2	Regular	-	-	-	-	-	Typical	-	-	-	-	Typical	-	-	-	-	-	-	Retain	
2367	Corymbia citriodora	Spotted Gum	280		280	23	7	3	2	Regular	-	-	-	-	-	Typical	-	-	-	-	Typical	-	-	-	-	-	-	Retain	
2368	Corymbia citriodora	Spotted Gum	280		280	20	9	3	2	Regular	-	-	-	-	-	Typical	-	-	-	-	Typical	-	-	-	-	-	-	Retain	
2369	Eucalyptus moluccana	Gum Topped Box	220		220	14	5	3	2	Regular	-	-	-	-	-	Typical	-	-	-	-	Typical	-	-	-	-	-	-	Retain	
2370	Corymbia citriodora	Spotted Gum	200	180, 100	287	20	4	3	2	Regular	-	-	-	-	-	Typical	-	-	-	-	Typical	-	-	-	-	-	-	Retain	
2371	Corymbia citriodora	Spotted Gum	200		200	21	3	2	2	Regular	-	-	-	-	-	Typical	-	-	-	-	Typical	-	-	-	-	-	-	Retain	
2372	Corymbia citriodora	Spotted Gum	200	180	269	20	4	3	2	Regular	-	-	-	-	-	Typical	-	-	-	-	Typical	-	-	-	-	-	-	Retain	
2373	Corymbia citriodora	Spotted Gum	295		295	24	6	4	2	Regular	-	-	-	-	-	Typical	-	-	-	-	Typical	-	-	-	-	-	-	Retain	
2374	Corymbia citriodora	Spotted Gum	375		375	23	7	5	2	Regular	-	-	-	-	-	Typical	-	-	-	-	Typical	-	-	-	-	-	-	Retain	
2375	Eucalyptus moluccana	Gum Topped Box	250		250	25	5	3	2	Regular	-	-	-	-	-	Typical	-	-	-	-	Typical	-	-	-	-	-	-	Retain	
2376	Corymbia citriodora	Spotted Gum	280		280	23	7	3	2	Regular	-	-	-	-	-	Typical	-	-	-	-	Typical	-	-	-	-	-	-	Retain	
2377	Corymbia citriodora	Spotted Gum	230		230	24	5	3	2	Regular	-	-	-	-	-	Typical	-	-	-	-	Typical	-	-	-	-	-	-	Retain	
2378	Corymbia citriodora	Spotted Gum	210		210	20	3	3	2	Regular	-	Thinning	-	Epicormic	-	Poor	-	-	-	-	Typical	-	-	-	-	-	-	Retain	
2379	Corymbia citriodora	Spotted Gum	220		220	20	4	3	2	Regular	-	-	-	-	-	Typical	-	-	-	-	Typical	-	-	-	-	-	-	Retain	
2380	Corymbia citriodora	Spotted Gum	220		220	19	5	3	2	Regular	-	-	-	-	-	Typical	-	-	-	-	Typical	-	-	-	-	-	-	Retain	
2381	Eucalyptus siderophloia	Grey Ironbark	255		255	24	4	3	2	Regular	-	-	-	-	-	Typical	-	-	-	-	Typical	-	-	-	-	-	-	Retain	
2382	Corymbia citriodora	Spotted Gum	215		215	24	4	3	2	Regular	-	-	-	-	-	Typical	-	-	-	-	Typical	-	-	-	-	-	-	Retain	
2383	Corymbia citriodora	Spotted Gum	260		260	17	4	3	2	One-sided	-	-	-	-	-	Typical	Major	-	-	-	Typical	-	-	-	-	-	-	Retain	
2384	Corymbia citriodora	Spotted Gum	200		200	17	4	2	2	Regular	-	-	-	-	-	Typical	-	-	-	-	Typical	-	-	-	-	-	-	Retain	
2385	Corymbia citriodora	Spotted Gum	210		210	20	4	3	2	Regular	-	-	-	-	-	Typical	-	-	-	-	Typical	-	-	-	-	-	-	Retain	
2386	Eucalyptus siderophloia	Grey Ironbark	250		250	20	3	3	2	Regular	-	-	-	-	-	Typical	-	-	-	-	Typical	-	-	-	-	-	-	Retain	
2387	Eucalyptus crebra	Narrow-leaved Ironbark	235		235	22	4	3	2	Regular	-	-	-	-	-	Typical	-	-	-	-	Typical	-	-	-	-	-	-	Retain	
2388	Corymbia citriodora	Spotted Gum	650		650	34	15	8	3	Regular	-	-	-	-	-	Typical	-	-	-	-	Typical	-	-	-	-	-	-	Retain	
2389	Corymbia citriodora	Spotted Gum	330		330	15	7	4	2	Regular	-	-	-	-	-	Typical	-	-	-	-	Typical	-	-	-	-	-	-	Remove	
2390	Corymbia citriodora	Spotted Gum	330		330	17	6	4	2	Regular	-	-	-	-	-	Typical	-	-	-	-	Typical	-	-	-	-	-	-	Remove	
2391	Corymbia citriodora	Spotted Gum	280		280	21	6	3	2	Regular	-	-	-	-	-	Typical	-	-	-	-	Typical	-	-	-	-	-	-	Remove	
2392	Lophostemon suaveolens	Swamp Box	210		210	11	3	3	2	Regular	-	-	-	-	-	Typical	-	-	-	-	Typical	-	-	-	-	-	-	Remove	
2393	Corymbia intermedia	Pink Bloodwood	265		265	15	5	3	2	Regular	-	-	-	-	-	Typical	-	-	-	-	Typical	-	-	-	-	-	-	Remove	
2394	Acacia disparima	Hickory Wattle	250		250	10	4	3	2	Regular	-	-	-	-	-	Typical	-	-	-	-	Typical	-	-	-	-	-	-	Remove	
2395	Acacia disparima	Hickory Wattle	260		260	11	4	3	2	One-sided	-	-	-	-	-	Typical	-	-	-	-	Typical	-	-	-	-	-	-	Remove	
2396	Corymbia intermedia	Pink Bloodwood	265		265	9	3	3	2	Regular	-	-	-	-	Lopped	Typical	-	-	-	-	Typical	-	-	-	-	-	-	Remove	
2397	Lophostemon suaveolens	Swamp Box	275		275	11	4	3	2	Regular	-	-	-	-	-	Typical	-	-	-	-	Typical	-	-	-	-	-	-	Remove	
2398	Acacia disparima	Hickory Wattle	270		270	11	6	3	2	Regular	-	-	-	-	-	Typical	-	-	-	-	Typical	-	-	-	-	-	-	Remove	
2399	Lophostemon suaveolens	Swamp Box	285	210	354	12	5	4	2	Regular	-	-	-	-	-	Typical	-	-	-	-	Typical	-	-	-	-	-	-	Remove	
2400	Lophostemon suaveolens	Swamp Box	200		200	11	3	2	2	Regular	-	-	-	-	-	Typical	-	-	-	-	Typical	-	-	-	-	-	-	Remove	
2401	Angophora floribunda	Rough-barked Apple	365		365	18	6	4	2	Regular	-	-	-	-	-	Typical	-	-	-	-	Typical	-	-	-	-	-	-	Remove	
2402	Acacia disparima	Hickory Wattle	210	150	258	13	7	3	2	Regular	-	-	-	-	-	Typical	-	-	-	-	Typical	-	-	-	-	-	-	Remove	
2403	Corymbia intermedia	Pink Bloodwood	200		200	16	4	2	2	Regular	-	-	-	-	-	Typical	-	-	-	-	Typical	-	-	-	-	-	-	Remove	
2404	Angophora floribunda	Rough-barked Apple	310		310	17	7	4	2	Regular	-	-	-	-	-	Typical	-	-	-	-	Typical	-	-	-	-	-	-	Remove	
2405	Acacia disparima	Hickory Wattle	250		250	13	6	3	2	Regular	-	-	-	-	-	Typical	-	-	-	-	Typical	-	-	-	-	-	-	Remove	
2406	Eucalyptus tereticornis	Forest Red Gum	630		630	26	12	8	3	Regular	-	-	-	-	-	Typical	-	-	-	-	Typical	-	-	-	-	-	-	Remove	
2407	Casuarina cunninghamiana	River Sheoak	320		320	18	8	4	2	Regular	-	-	-	-	-	Typical	Minor	-	-	-	Typical	-	-	-	-	-	-	Remove	
2408	Casuarina cunninghamiana	River Sheoak	220		220	9	7	3	2	One-sided	-	-	-	-	-	Typical	Major	-	-	-	Typical	-	-	-	-	-	-	Remove	
2409	Casuarina cunninghamiana	River Sheoak	460		460	26	9	6	2	Regular	-	-	-	-	-	Typical	-	-	-	-	Typical	-	-	-	-	-	-	Remove	
2410	Euodia elleryana	corkwood	300		300	12	7	4	2	Regular	-	-	-	-	-	Typical	-	-	-	-	Typical	-	-	-	-	-	-	Remove	
2411	Euodia elleryana	corkwood	230		230	9	6	3	2	Regular	-	-	-	-	-	Typical	-	-	-	-	Typical	-	-	-	-	-	-	Remove	
2412	Casuarina cunninghamiana	River Sheoak	270		270	12	9	3	2	Regular	-	-	-	-	-	Typical	Major	-	-	-	Typical	-	-	-	-	-	-	Remove	
2413	Casuarina cunninghamiana	River Sheoak	490		490	22	9	6	2	Regular	-	-	-	-	-	Typical	-	-	-	-	Typical	-	-	-	-	-	-	Remove	
2414	Acacia disparima	Hickory Wattle	230		230	9	7	3	2	Regular	-	-	-	-	-	Typical	Minor	-	-	-	Typical	-	-	-	-	-	-	Remove	
2415	Angophora floribunda	Rough-barked Apple	220		220	16	6	3	2	Regular	-	-	-	-	-	Typical	-	-	-	-	Typical	-	-	-	-	-	-	Remove	
2416	Angophora floribunda	Rough-barked Apple	370	230	436	15	7	5	2	Regular	-	-	-	-	-	Typical	-	-	-	-	Typical	-	-	-	-	-	-	Remove	
2417	Casuarina cunninghamiana	River Sheoak	420		420	17	7	5	2	Regular	-	-	-	-	-	Typical	-	-	-	-	Typical	-	-	-	-	-	-	Remove	
2418	Melaleuca viminialis	Weeping Bottlebrush	220		220	12	6	3	2	Regular	-	-	-	-	-	Typical	-	-	-	-	Typical	-	-	-	-	-	-	Remove	
2419	Melaleuca viminialis	Weeping Bottlebrush	240		240	12	5	3	2	Regular	-	-	-	-	-	Typical	-	-	-	-	Typical	-	-	-	-	-	-	Remove	
2420	Lophostemon suaveolens	Swamp Box	280		280	14	6	3	2	Regular	-	-	-	-	-	Typical	-	-	-	-	Typical	-	-	-	-	-	-	Remove	
2421	Casuarina cunninghamiana	River Sheoak	250		250	21	5	3	2	Regular	-	-	-	-	-	Typical	-	-	-	-	Typical	-	-	-	-	-	-	Remove	
2422	Casuarina cunninghamiana	River Sheoak	240		240	20	4	3	2	Regular	-	-	-	-	-	Typical	-	-	-	-	Typical	-	-	-	-	-	-	Remove	
2423	Casuarina cunninghamiana	River Sheoak	220		220	18	5	3	2	Regular	-	-	-	-	-	Typical	-	-	-	-	Typical	-	-	-	-	-	-	Remove	
2424	Casuarina cunninghamiana	River Sheoak	400		400	24	9	5	2	Regular	-	-	-	-	-	Typical	-	-	-	-	Typical	-	-	-	-	-	-	Remove	
2425	Casuarina cunninghamiana	River Sheoak	460	260	528	22	9	6	3	Regular	-	-	-	-	-	Typical	-	-	-	-	Typical	-	-	-	-	-	-	Remove	
2426	Casuarina cunninghamiana	River Sheoak	420		420	23	9	5	2	Regular	-	-	-	-	-	Typical	-	-	-	-	Typical	-	-	-	-	-	-	Remove	
2427	Casuarina cunninghamiana	River Sheoak	420																										

Tree ID	Specimen Details								Canopy Condition Details								Trunk Condition Details					Fauna Details and Habitat Value							
	Botanical Name	Common Name	Trunk DBH (mm)	Additional Trunks DBH (mm)	Total DBH (mm) [AS 4970-2009]	Height (m)	Spread (m)	Tree Protection Zone (m)	Structural Root Zone (m)	Canopy Form	Spreading	Thinning	Die-Back	Epicormic Growth	Lopped	Canopy Health	Leaning	Vines	Trunk Damage	Fire Damage	Trunk Health	Scats	Scratches	Hollows	Nest	Termite Nest	Habitat Value	Retention	
2430	Casuarina cunninghamiana	River Sheoak	260		260	17	6	3	2	Regular	-	-	-	-	-	Typical	-	-	-	-	Typical	-	-	-	-	-	-	Remove	
2431	Casuarina cunninghamiana	River Sheoak	460		460	23	9	6	2	Regular	-	-	-	-	-	Typical	-	-	-	-	Typical	-	-	-	-	-	-	Remove	
2432	Eucalyptus tereticornis	corkwood	310		310	10	5	4	2	Regular	-	-	-	-	-	Typical	-	-	-	-	Typical	-	-	-	-	-	-	Remove	
2433	Casuarina cunninghamiana	River Sheoak	270		270	14	4	3	2	Regular	-	-	-	-	Lopped	Typical	-	-	-	-	Typical	-	-	-	-	-	-	Remove	
2434	Casuarina cunninghamiana	River Sheoak	270		270	17	5	3	2	Regular	-	-	-	-	-	Typical	-	-	-	-	Typical	-	-	-	-	-	-	Remove	
2435	Casuarina cunninghamiana	River Sheoak	420		420	21	7	5	2	Regular	-	-	-	-	-	Typical	-	-	-	-	Typical	-	-	-	-	-	-	Remove	
2436	Casuarina cunninghamiana	River Sheoak	360		360	18	7	4	2	Regular	-	-	-	-	-	Typical	-	-	-	-	Typical	-	-	-	-	-	-	Remove	
2437	Acacia disparrima	Hickory Wattle	200	190, 150	314	13	7	4	2	Regular	-	-	-	-	-	Typical	-	-	-	-	Typical	-	-	-	-	-	-	Remove	
2438	Eucalyptus tereticornis	Forest Red Gum	265		265	16	5	3	2	Regular	-	-	-	-	-	Typical	-	-	-	-	Typical	-	-	-	-	-	-	Remove	
2439	Eucalyptus tereticornis	Forest Red Gum	485		485	19	7	6	2	Regular	-	-	-	-	-	Typical	-	-	-	-	Typical	-	-	-	-	-	-	Remove	
2440	Lophostemon suaveolens	Swamp Box	200		200	12	3	2	2	Regular	-	-	-	-	-	Typical	-	-	-	-	Typical	-	-	-	-	-	-	Remove	
2441	Lophostemon suaveolens	Swamp Box	220		220	12	4	3	2	Regular	-	-	-	-	-	Typical	-	-	-	-	Typical	-	-	-	-	-	-	Remove	
2442	Lophostemon suaveolens	Swamp Box	320		320	13	5	4	2	Regular	-	-	-	-	-	Typical	-	-	-	-	Typical	-	-	-	-	-	-	Remove	
2534	Corymbia citriodora	Spotted Gum	270		270	17	11	3	2	Regular	-	-	-	-	-	Typical	-	-	-	-	Typical	-	-	-	-	-	-	Remove	
2535	Eucalyptus siderophloia	Grey Ironbark	390		390	22	12	5	2	Regular	-	-	-	-	-	Typical	-	-	-	-	Typical	-	-	-	-	-	-	Remove	
2536	Corymbia citriodora	Spotted Gum	310		310	15	12	4	2	Regular	-	-	-	-	-	Typical	-	-	-	-	Typical	-	-	-	-	-	-	Remove - Fill stockpiling	
2537	Corymbia intermedia	Pink Bloodwood	360		360	17	11	4	2	Regular	-	-	-	-	-	Typical	-	-	-	-	Typical	-	-	-	-	-	-	Remove	
2538	Corymbia intermedia	Pink Bloodwood	240		240	16	10	3	2	Regular	-	-	-	-	-	Typical	-	-	-	-	Typical	-	-	-	-	-	-	Remove	
2539	Eucalyptus tereticornis	Forest Red Gum	340		340	18	12	4	2	Regular	-	-	-	-	-	Typical	-	-	-	-	Typical	-	-	-	-	-	-	Remove	
2540	Eucalyptus siderophloia	Grey Ironbark	470		470	20	11	6	2	One-sided	-	-	-	-	-	Typical	-	-	Trunk Dmg.	-	Typical	-	-	-	-	-	-	Remove	
2541	Acacia leiocalyx	Early-flowering Black Wattle	160	170, 90	250	8	6	3	2	Regular	-	-	-	-	-	Typical	-	-	-	-	Typical	-	-	-	-	-	-	Remove	
2542	Corymbia citriodora	Spotted Gum	190		190	17	6	2	2	Regular	-	-	-	-	-	Typical	-	-	-	-	Typical	-	-	-	-	-	-	Remove	
2543	Corymbia citriodora	Spotted Gum	130		130	16	4	2	1	Regular	-	-	-	-	-	Typical	-	-	-	-	Typical	-	-	-	-	-	-	Remove	
2544	Acacia disparrima	Hickory Wattle	140		140	6	5	2	1	Regular	-	-	-	-	-	Typical	-	-	-	-	Typical	-	-	-	-	-	-	Remove	
2545	Corymbia citriodora	Spotted Gum	100		100	10	2	2	1	Regular	-	-	-	-	-	Typical	-	-	-	-	Typical	-	-	-	-	-	-	Remove	
2546	Corymbia citriodora	Spotted Gum	130		130	10	3	2	1	Regular	-	-	-	-	-	Typical	-	-	-	-	Typical	-	-	-	-	-	-	Remove	
2547	Acacia disparrima	Hickory Wattle	110	70	130	6	4	2	1	Regular	-	-	-	-	-	Typical	-	-	-	-	Typical	-	-	-	-	-	-	Remove	
2548	Corymbia citriodora	Spotted Gum	200		200	15	5	2	2	Regular	-	-	-	-	-	Typical	-	-	-	-	Typical	-	-	-	-	-	-	Remove	
2549	Corymbia citriodora	Spotted Gum	160		160	17	3	2	2	Regular	-	-	-	-	-	Typical	-	-	-	-	Typical	-	-	-	-	-	-	Remove	
2550	Acacia disparrima	Hickory Wattle	100	70	122	4	3	2	1	Regular	-	-	-	-	-	Typical	-	-	-	-	Typical	-	-	-	-	-	-	Remove	
2551	Corymbia citriodora	Spotted Gum	270		270	19	11	3	2	Regular	-	-	-	-	-	Typical	-	-	-	-	Typical	-	-	-	-	-	-	Remove	
2552	Acacia concurrens	Black Wattle	130		130	5	4	2	1	Regular	-	-	-	-	-	Typical	-	-	-	-	Typical	-	-	-	-	-	-	Remove	
2553	Corymbia citriodora	Spotted Gum	100		100	10	2	2	1	Regular	-	-	-	-	-	Typical	-	-	-	-	Typical	-	-	-	-	-	-	Remove	
2554	Acacia concurrens	Black Wattle	110		110	5	3	2	1	Regular	-	-	-	-	-	Typical	-	-	-	-	Typical	-	-	-	-	-	-	Remove	
2555	Corymbia citriodora	Spotted Gum	340		340	23	10	4	2	Regular	-	-	-	-	-	Typical	-	-	Trunk Dmg.	-	Typical	-	-	-	-	-	-	Remove	
2556	Acacia concurrens	Black Wattle	170		170	5	5	2	2	Regular	-	-	-	-	-	Typical	-	-	-	-	Typical	-	-	-	-	-	-	Remove	
2557	Acacia concurrens	Black Wattle	160		160	6	4	2	2	Regular	-	-	-	-	-	Typical	-	-	-	-	Typical	-	-	-	-	-	-	Remove	
2558	Corymbia citriodora	Spotted Gum	260		260	19	9	3	2	Regular	-	-	-	-	-	Typical	-	-	-	-	Typical	-	-	-	-	-	-	Remove	
2559	Eucalyptus tereticornis	Forest Red Gum	250		250	16	7	3	2	Regular	-	-	-	-	-	Typical	-	-	-	-	Typical	-	-	-	-	-	-	Remove	
2560	Corymbia citriodora	Spotted Gum	220		220	21	10	3	2	Regular	-	-	-	-	-	Typical	-	-	-	-	Typical	-	-	-	-	-	-	Remove	
2561	Corymbia citriodora	Spotted Gum	240		240	21	11	3	2	Regular	-	-	-	-	-	Typical	-	-	-	-	Typical	-	-	-	-	-	-	Remove	
2562	Corymbia citriodora	Spotted Gum	260		260	16	9	3	2	Regular	-	-	-	-	-	Typical	-	-	-	-	Typical	-	-	-	-	-	-	Remove	
2563	Corymbia citriodora	Spotted Gum	260		260	20	10	3	2	Regular	-	-	-	-	-	Typical	-	-	Trunk Dmg.	-	Typical	-	-	-	-	-	-	Remove	
2564	Eucalyptus siderophloia	Grey Ironbark	290		290	21	10	3	2	Regular	-	-	-	-	-	Typical	-	-	-	-	Typical	-	-	-	-	-	-	Remove	
2565	Angophora leiocarpa	Smooth-barked Apple	280		280	18	10	3	2	Regular	-	-	-	-	-	Typical	-	-	-	-	Typical	-	-	-	-	-	-	Remove	
2566	Eucalyptus tereticornis	Forest Red Gum	260		260	18	10	3	2	Regular	-	-	-	-	-	Typical	-	-	-	-	Typical	-	-	-	-	-	-	Remove	
2567	Corymbia citriodora	Spotted Gum	220		220	19	10	3	2	Regular	-	-	-	-	-	Typical	-	-	-	-	Typical	-	-	-	-	-	-	Remove	
2568	Eucalyptus crebra	Narrow-leaved Ironbark	320		320	18	10	4	2	Regular	-	-	-	-	-	Typical	-	-	Trunk Dmg.	-	Typical	-	-	-	-	-	-	Remove	
2569	Corymbia citriodora	Spotted Gum	170		170	18	9	2	2	One-sided	-	-	-	-	-	Typical	Minor	-	-	-	Typical	-	-	-	-	-	-	Remove	
2570	Corymbia intermedia	Pink Bloodwood	160	50	168	16	6	2	2	Regular	-	-	-	-	-	Typical	-	-	-	-	Typical	-	-	-	-	-	-	Remove	
2571	Corymbia citriodora	Spotted Gum	460		460	21	14	6	2	Regular	-	Thinning	Die-back	-	-	Typical	-	-	-	-	Typical	-	-	-	-	-	-	Remove	
2572	Corymbia citriodora	Spotted Gum	280		280	21	10	3	2	Regular	-	-	-	-	-	Typical	-	-	-	-	Typical	-	-	-	-	-	-	Remove	
2573	Corymbia citriodora	Spotted Gum	160		160	15	6	2	2	Regular	-	-	-	-	-	Typical	-	-	-	-	Typical	-	-	-	-	-	-	Remove	
2574	Corymbia citriodora	Spotted Gum	140		140	6	4	2	1	Regular	-	-	-	-	-	Typical	Major	-	-	-	Typical	-	-	-	-	-	-	Remove	
2575	Allocastrum littoralis	Black She Oak	130		130	6	3	2	1	Regular	-	-	-	-	-	Typical	-	-	-	-	Typical	-	-	-	-	-	-	Remove	
2576	Allocastrum littoralis	Black She Oak	100		100	7	2	2	1	Regular	-	-	-	-	-	Typical	-	-	-	-	Typical	-	-	-	-	-	-	Remove	
2577	Eucalyptus tereticornis	Forest Red Gum	130		130	8	2	2	1	Regular	-	-	-	-	-	Typical	-	-	-	-	Typical	-	-	-	-	-	-	Remove	
2578	Eucalyptus tereticornis	Forest Red Gum	160		160	7	4	2	2	Regular	-	-	-	-	-	Typical	Major	-	-	-	Typical	-	-	-	-	-	-	Remove	
2579	Acacia disparrima	Hickory Wattle	130		130	5	4	2	1	Regular	-	-	-	-	-	Typical	-	-	-	-	Typical	-	-	-	-	-	-	Remove	
2580	Eucalyptus siderophloia	Grey Ironbark	220		220	11	6	3	2	Regular	-	-	-	-	-	Typical	Major	-	-	-	Typical	-	-	-	-	-	-	Remove	
2581	Acacia disparrima	Hickory Wattle	140		140	9	5	2	1	Regular	-	-	-	-	-	Typical	-	-	-	-	Typical	-	-	-	-	-	-	Remove	
2582	Corymbia citriodora	Spotted Gum	260		260	19	10	3	2	Regular	-	-	-	-	-	Typical	-	-	-	-	Typical	-	-	-	-	-	-	Remove	
2583	Corymbia citriodora	Spotted Gum	260		260	16	9	3	2	Regular	-	-	-	-	-	Typical	-	-	-	-	Typical	-	-	-	-	-	-	Remove	
2584	Acacia concurrens	Black Wattle	150		150	5	3	2	1	Regular	-	-	-	-	-	Typical	-	-	-	-	Typical	-	-	-	-	-	-	Remove	
2585	Acacia concurrens	Black Wattle	150		150	5	4	2	1	Regular	-	-	-	-	-	Typical	-	-	-	-	Typical	-	-	-	-	Termite nest	-	Remove	
2586	Acacia leiocalyx	Early-flowering Black Wattle	160	120																									

Tree ID	Specimen Details									Canopy Condition Details							Trunk Condition Details					Fauna Details and Habitat Value							Retention
	Botanical Name	Common Name	Trunk DBH (mm)	Additional Trunks DBH (mm)	Total DBH (mm) [AS 4970-2009]	Height (m)	Spread (m)	Tree Protection Zone (m)	Structural Root Zone (m)	Canopy Form	Spreading	Thinning	Die-Back	Epicormic Growth	Lopped	Canopy Health	Leaning	Vines	Trunk Damage	Fire Damage	Trunk Health	Scats	Scratches	Hollows	Nest	Termite Nest	Habitat Value		
2589	Acacia leiocalyx	Early-flowering Black Wattle	130	60	143	5	4	2	1	Regular	-	-	-	-	-	Typical	-	-	-	-	Typical	-	-	-	-	-	-	Remove	
2590	Acacia leiocalyx	Early-flowering Black Wattle	130		130	6	4	2	1	Regular	-	-	-	-	-	Typical	-	-	-	-	Typical	-	-	-	-	-	-	Remove	
2591	Acacia leiocalyx	Early-flowering Black Wattle	100	80	128	7	4	2	1	Regular	-	-	-	-	-	Typical	-	-	-	-	Typical	-	-	-	-	-	-	Remove	
2592	Acacia leiocalyx	Early-flowering Black Wattle	100		100	5	3	2	1	Regular	-	-	-	-	-	Typical	-	-	-	-	Typical	-	-	-	-	-	-	Remove	
2593	Acacia leiocalyx	Early-flowering Black Wattle	140		140	7	3	2	1	Regular	-	-	-	-	-	Typical	-	-	-	-	Typical	-	-	-	-	-	-	Remove	
2594	Acacia leiocalyx	Early-flowering Black Wattle	100	90	135	5	3	2	1	Regular	-	-	-	-	-	Typical	-	-	-	-	Typical	-	-	-	-	-	-	Remove	
2595	Acacia leiocalyx	Early-flowering Black Wattle	120		120	6	3	2	1	Regular	-	-	-	-	-	Typical	-	-	-	-	Typical	-	-	-	-	-	-	Remove	
2596	Acacia leiocalyx	Early-flowering Black Wattle	150		150	6	4	2	1	Regular	-	-	-	-	-	Typical	-	-	-	-	Typical	-	-	-	-	-	-	Remove	
2597	Acacia leiocalyx	Early-flowering Black Wattle	110		110	5	3	2	1	Regular	-	-	-	-	-	Typical	-	-	-	-	Typical	-	-	-	-	-	-	Remove	
2598	Acacia leiocalyx	Early-flowering Black Wattle	140		140	6	3	2	1	Regular	-	-	-	-	-	Typical	-	-	-	-	Typical	-	-	-	-	-	-	Remove	
2663	Alphitonia excelsa	Soap Tree	140		140	11	5	2	1	Regular	-	-	-	-	-	Typical	-	-	-	-	Typical	-	-	-	-	-	-	Retain	
2664	Alphitonia excelsa	Soap Tree	120		120	11	4	2	1	Regular	-	-	-	-	-	Typical	-	-	-	-	Typical	-	-	-	-	-	-	Retain	
2665	Angophora subvelutina	Broad-leaved Apple	200		200	15	6	2	2	Regular	-	-	-	-	-	Typical	-	-	-	-	Typical	-	-	-	-	-	-	Retain	
2666	Angophora subvelutina	Broad-leaved Apple	290		290	16	6	3	2	Regular	-	-	-	-	-	Typical	-	-	-	-	Typical	-	-	-	-	-	-	Retain	
2667	Angophora subvelutina	Broad-leaved Apple	260		260	16	7	3	2	Regular	-	-	-	-	-	Typical	-	-	-	-	Typical	-	-	-	-	-	-	Retain	
2668	Angophora subvelutina	Broad-leaved Apple	400		400	17	9	5	2	Regular	-	-	-	-	-	Typical	-	-	-	-	Typical	-	-	-	-	-	-	Retain	
2669	Eucalyptus seeana	Narrow-leaved Red Gum	430		430	26	16	5	2	Regular	-	-	-	-	-	Typical	-	-	-	-	Typical	-	-	-	-	-	-	Retain	
2670	Lophostemon suaveolens	Swamp Box	120		120	16	5	2	1	Regular	-	-	-	-	-	Typical	-	-	-	-	Typical	-	-	-	-	-	-	Retain	
2671	Aphananthe philippinensis	Native Elm	540		540	20	14	6	3	Regular	-	-	-	-	-	Typical	-	Introduced	-	-	Typical	-	-	-	-	-	-	Retain	
2672	Angophora subvelutina	Broad-leaved Apple	430		430	21	11	5	2	Regular	-	-	-	-	-	Typical	-	-	-	-	Typical	-	-	-	-	-	-	Retain	
2673	Eucalyptus tereticornis	Forest Red Gum	190		190	17	5	2	2	Regular	-	-	-	-	-	Typical	-	-	-	-	Typical	-	-	-	-	-	-	Retain	
2674	Lophostemon suaveolens	Swamp Box	220		220	16	5	3	2	Regular	-	-	-	-	-	Typical	-	-	-	-	Typical	-	-	-	-	-	-	Retain	
2675	Lophostemon suaveolens	Swamp Box	270		270	16	6	3	2	Regular	-	-	-	-	-	Typical	-	-	-	-	Typical	-	-	-	-	-	-	Retain	
2676	Lophostemon suaveolens	Swamp Box	380		380	20	10	5	2	Regular	-	-	-	-	-	Typical	-	Introduced	-	-	Typical	-	-	-	-	-	-	Retain	
2677	Corymbia tessellaris	Moreton Bay Ash	380		380	22	12	5	2	Regular	-	-	-	-	-	Typical	-	-	-	-	Typical	-	-	-	-	-	-	Retain	
2678	Corymbia tessellaris	Moreton Bay Ash	420		420	22	12	5	2	Regular	-	-	Die-back	-	-	Poor	-	-	-	-	Typical	-	-	-	-	-	-	Retain	
2679	Aphananthe philippinensis	Native Elm	470		470	17	13	6	2	Regular	-	-	-	-	-	Typical	-	-	-	-	Typical	-	-	-	-	-	-	Retain	
2680	Lophostemon suaveolens	Swamp Box	290		290	17	8	3	2	Regular	-	-	-	-	-	Typical	-	-	-	-	Typical	-	-	-	-	-	-	Retain	
2681	Aphananthe philippinensis	Native Elm	370		370	16	10	4	2	Regular	-	-	-	-	-	Typical	-	-	Trunk Dmg.	-	Typical	-	-	-	-	-	-	Retain	
2682	Corymbia tessellaris	Moreton Bay Ash	660		660	29	17	8	3	Regular	-	-	-	-	-	Typical	-	-	-	-	Typical	-	-	-	-	-	-	Retain	
2683	Aphananthe philippinensis	Native Elm	380		380	16	12	5	2	Regular	-	-	-	-	-	Typical	-	Introduced	-	-	Typical	-	-	-	-	-	-	Retain	
2684	Aphananthe philippinensis	Native Elm	200		200	14	8	2	2	Regular	-	-	-	-	-	Typical	-	-	-	-	Typical	-	-	-	-	-	-	Retain	
2685	Allocasuarina littoralis	Black She Oak	340		340	18	10	4	2	Regular	-	-	-	-	-	Typical	-	Introduced	-	-	Typical	-	-	-	-	-	-	Retain	
2686	Eucalyptus tereticornis	Forest Red Gum	360		360	19	11	4	2	Regular	-	-	-	-	-	Typical	-	-	-	-	Typical	-	-	-	-	-	-	Retain	
2687	Eucalyptus tereticornis	Forest Red Gum	250		250	17	9	3	2	Regular	-	-	-	-	-	Typical	-	-	-	-	Typical	-	-	-	-	-	-	Retain	
2688	Lophostemon suaveolens	Swamp Box	300		300	17	7	4	2	Regular	-	-	-	-	-	Typical	-	-	-	-	Typical	-	-	-	-	-	-	Retain	
2689	Alphitonia excelsa	Soap Tree	300		300	14	6	4	2	Regular	-	-	-	-	-	Typical	-	Introduced	-	-	Typical	-	-	-	-	-	-	Retain	
2690	Eucalyptus tereticornis	Forest Red Gum	270		270	17	6	3	2	Regular	-	-	-	-	-	Typical	-	-	-	-	Typical	-	-	-	-	-	-	Retain	
2691	Lophostemon suaveolens	Swamp Box	330		330	16	9	4	2	Regular	-	-	Die-back	-	-	Typical	-	-	-	-	Typical	-	-	-	-	-	-	Retain	
2692	Acacia disparrima	Hickory Wattle	160	110	194	8	5	2	2	Regular	-	-	-	-	-	Typical	-	Introduced	-	-	Typical	-	-	-	-	-	-	Retain	
2693	Acacia disparrima	Hickory Wattle	170	160, 80	247	10	7	3	2	Regular	-	-	-	-	-	Typical	-	Introduced	-	-	Typical	-	-	-	-	-	-	Retain	
2694	Acacia disparrima	Hickory Wattle	190		190	13	7	2	2	Regular	-	-	-	-	-	Typical	-	Introduced	-	-	Typical	-	-	-	-	-	-	Retain	
2695	Corymbia tessellaris	Moreton Bay Ash	510		510	27	17	6	2	Regular	-	-	-	-	-	Typical	-	-	-	-	Typical	-	-	-	-	-	-	Retain	
2696	Eucalyptus tereticornis	Forest Red Gum	240		240	17	6	3	2	Regular	-	-	-	-	-	Typical	-	-	-	-	Typical	-	-	-	-	-	-	Retain	
2697	Acacia disparrima	Hickory Wattle	180		180	10	6	2	2	Regular	-	-	-	-	-	Typical	-	Introduced	-	-	Typical	-	-	-	-	-	-	Retain	
2698	Eucalyptus tereticornis	Forest Red Gum	800		800	26	16	10	3	Regular	-	-	-	-	-	Typical	-	-	-	-	Typical	-	-	-	-	-	-	Retain	
2699	Corymbia tessellaris	Moreton Bay Ash	160	90	184	16	5	2	2	Regular	-	-	-	-	-	Typical	-	Introduced	-	-	Typical	-	-	-	-	-	-	Retain	
2700	Acacia disparrima	Hickory Wattle	110		110	13	5	2	1	Regular	-	-	-	-	-	Typical	-	-	-	-	Typical	-	-	-	-	-	-	Retain	
2701	Angophora subvelutina	Broad-leaved Apple	120		120	13	2	2	1	Regular	-	-	-	Epicormic	-	Poor	-	-	-	-	Typical	-	-	-	-	-	-	Retain	
2702	Melaleuca viminialis	Weeping Bottlebrush	340	160, 180	417	14	9	5	2	Regular	-	-	-	-	-	Typical	Minor	-	-	-	Typical	-	-	-	-	-	-	Retain	
2703	Melaleuca viminialis	Weeping Bottlebrush	130	60	143	5	5	2	1	Regular	-	-	-	-	-	Typical	Major	-	-	-	Typical	-	-	-	-	-	-	Retain	
2704	Melaleuca viminialis	Weeping Bottlebrush	160	90, 60																									

Tree ID	Specimen Details								Canopy Condition Details								Trunk Condition Details					Fauna Details and Habitat Value								Retention
	Botanical Name	Common Name	Trunk DBH (mm)	Additional Trunks DBH (mm)	Total DBH (mm) [AS 4970-2009]	Height (m)	Spread (m)	Tree Protection Zone (m)	Structural Root Zone (m)	Canopy Form	Spreading	Thinning	Die-Back	Epicormic Growth	Lopped	Canopy Health	Leaning	Vines	Trunk Damage	Fire Damage	Trunk Health	Scats	Scratches	Hollows	Nest	Termite Nest	Habitat Value			
2721	Casuarina cunninghamiana	River Sheoak	260		260	17	9	3	2	Regular	-	-	-	-	-	Typical	-	-	-	-	Typical	-	-	-	-	-	-	-	Retain	
2722	Casuarina cunninghamiana	River Sheoak	360	260, 130	463	18	11	6	2	Regular	-	-	-	-	-	Typical	-	-	-	-	Typical	-	-	-	-	-	-	-	Retain	
2723	Casuarina cunninghamiana	River Sheoak	450		450	20	11	5	2	Regular	-	-	-	-	-	Typical	-	-	-	-	Typical	-	-	-	-	-	-	-	Retain	
2724	Eucalyptus tereticornis	Forest Red Gum	690		690	27	15	8	3	Regular	-	-	Die-back	-	-	Typical	-	-	-	-	Typical	-	Old	-	-	-	-	-	Retain	
2725	Eucalyptus tereticornis	Forest Red Gum	380		380	26	14	5	2	Regular	-	-	-	-	-	Typical	-	-	-	-	Typical	-	-	-	-	-	-	-	Retain	
2726	Eucalyptus tereticornis	Forest Red Gum	320		320	23	10	4	2	Regular	-	-	-	-	-	Typical	-	-	-	-	Typical	-	-	-	-	-	-	-	Retain	
2727	Corymbia tessellaris	Moreton Bay Ash	240		240	14	5	3	2	Regular	-	Thinning	Die-back	-	-	Poor	-	-	-	-	Typical	-	-	-	-	-	-	-	Retain	
2728	Corymbia tessellaris	Moreton Bay Ash	240		240	22	10	3	2	Regular	-	-	-	-	-	Typical	-	-	-	-	Typical	-	-	-	-	-	-	-	Retain	
2729	Corymbia tessellaris	Moreton Bay Ash	140		140	13	8	2	1	Regular	-	-	-	-	-	Typical	-	-	-	-	Typical	-	-	-	-	-	-	-	Retain	
2730	Eucalyptus tereticornis	Forest Red Gum	350		350	20	12	4	2	Regular	-	-	-	-	-	Typical	-	Introduced	-	-	Typical	-	-	-	-	-	-	-	Retain	
2731	Eucalyptus tereticornis	Forest Red Gum	140		140	13	5	2	1	Regular	-	-	Die-back	-	-	Typical	-	-	-	-	Typical	-	-	-	-	-	-	-	Retain	
2732	Eucalyptus tereticornis	Forest Red Gum	500		500	27	15	6	2	Regular	-	-	-	-	-	Typical	-	-	-	-	Typical	-	-	-	-	-	-	-	Retain	
2733	Alphitonia excelsa	Soap Tree	100		100	6	2	2	1	Regular	-	-	-	-	-	Typical	-	-	-	-	Typical	-	-	-	-	-	-	-	Retain	
2734	Acacia dispartima	Hickory Wattle	200		200	12	6	2	2	Regular	-	-	-	-	-	Typical	-	-	-	-	Typical	-	-	-	-	-	-	-	Retain	
2735	Corymbia tessellaris	Moreton Bay Ash	440		440	24	12	5	2	Regular	-	-	-	-	-	Typical	Minor	-	-	-	Typical	-	-	-	-	-	-	-	Retain	
2736	Acacia dispartima	Hickory Wattle	290		290	16	8	3	2	Regular	-	-	-	-	-	Typical	-	-	-	-	Typical	-	-	-	-	-	-	-	Retain	
2737	Angophora subvelutina	Broad-leaved Apple	540		540	22	13	6	3	Regular	-	-	-	-	-	Typical	-	-	-	-	Typical	-	-	-	-	-	-	-	Retain	
2738	Corymbia citriodora	Spotted Gum	100		100	6	2	2	1	Regular	-	-	-	-	-	Typical	-	-	-	-	Typical	-	-	-	-	-	-	-	Remove - Fill stockpiling	
2739	Corymbia citriodora	Spotted Gum	380		380	18	10	5	2	Regular	-	-	-	-	-	Typical	-	-	-	-	Typical	-	-	-	-	-	-	-	Remove - Fill stockpiling	
2740	Acacia concurrens	Black Wattle	100		100	6	3	2	1	Regular	-	-	-	-	-	Typical	-	Introduced	-	-	Typical	-	-	-	-	-	-	-	Remove - Fill stockpiling	
2741	Eucalyptus moluccana	Gum Topped Box	120		120	8	3	2	1	Regular	-	-	-	-	-	Typical	-	-	-	-	Typical	-	-	-	-	-	-	-	Remove - Fill stockpiling	
2742	Acacia dispartima	Hickory Wattle	150		150	5	4	2	1	Regular	-	-	-	-	-	Typical	-	-	-	-	Typical	-	-	-	-	-	-	-	Remove - Fill stockpiling	
2743	Corymbia citriodora	Spotted Gum	170		170	14	5	2	2	Regular	-	-	-	-	-	Typical	-	-	-	-	Typical	-	-	-	-	-	-	-	Remove - Fill stockpiling	
2744	Angophora leiocarpa	Smooth-barked Apple	100		100	12	3	2	1	Regular	-	-	-	-	-	Typical	-	-	-	-	Typical	-	-	-	-	-	-	-	Remove - Fill stockpiling	
2745	Eucalyptus moluccana	Gum Topped Box	130		130	10	3	2	1	Regular	-	-	-	-	-	Typical	Minor	-	-	-	Typical	-	-	-	-	-	-	-	Remove - Fill stockpiling	
2746	Corymbia intermedia	Pink Bloodwood	240		240	17	6	3	2	Regular	-	-	-	-	-	Typical	-	-	-	-	Typical	-	-	-	-	-	-	-	Remove - Fill stockpiling	
2747	Eucalyptus moluccana	Gum Topped Box	700		700	24	12	8	3	Regular	-	-	-	-	-	Typical	-	-	Trunk Dmg.	-	Typical	-	-	-	-	-	-	-	Remove - Fill stockpiling	
2748	Corymbia citriodora	Spotted Gum	160		160	14	5	2	2	Regular	-	-	-	-	-	Typical	-	-	-	-	Typical	-	-	-	-	-	-	-	Remove - Fill stockpiling	
2749	Lophostemon suaveolens	Swamp Box	180		180	13	5	2	2	Regular	-	-	-	-	-	Typical	-	-	-	-	Typical	-	-	-	-	-	-	-	Remove - Fill stockpiling	
2750	Corymbia citriodora	Spotted Gum	200		200	16	8	2	2	Regular	-	-	-	-	-	Typical	-	-	-	-	Typical	-	-	-	-	-	-	-	Remove - Fill stockpiling	
2751	Eucalyptus seeana	Narrow-leaved Red Gum	200		200	13	7	2	2	Regular	-	-	-	-	-	Typical	-	-	-	-	Typical	-	-	-	-	-	-	-	Remove - Fill stockpiling	
2752	Lophostemon suaveolens	Swamp Box	280		280	16	7	3	2	Regular	-	-	-	-	-	Typical	-	-	-	-	Typical	-	-	-	-	-	-	-	Remove - Fill stockpiling	
2753	Lophostemon suaveolens	Swamp Box	180		180	13	5	2	2	Regular	-	-	-	-	-	Typical	-	-	-	-	Typical	-	-	-	-	-	-	-	Retain	
2754	Corymbia citriodora	Spotted Gum	320		320	23	12	4	2	Regular	-	-	-	-	-	Typical	-	-	-	-	Typical	-	-	-	-	-	-	-	Retain	
2755	Lophostemon suaveolens	Swamp Box	110		110	7	3	2	1	Regular	-	-	-	-	-	Typical	-	-	-	-	Typical	-	-	-	-	-	-	-	Retain	
2756	Corymbia citriodora	Spotted Gum	110		110	9	2	2	1	Regular	-	-	-	-	-	Typical	-	-	-	-	Typical	-	-	-	-	-	-	-	Retain	
2757	Lophostemon suaveolens	Swamp Box	100		100	7	4	2	1	Regular	-	-	-	-	-	Typical	-	-	-	-	Typical	-	-	-	-	-	-	-	Retain	
2758	Eucalyptus seeana	Narrow-leaved Red Gum	450		450	23	13	5	2	Regular	-	-	-	-	-	Typical	-	-	-	-	Typical	-	-	-	-	-	-	-	Retain	
2759	Corymbia citriodora	Spotted Gum	270		270	22	12	3	2	One-sided	-	-	-	-	-	Typical	-	-	-	-	Typical	-	-	-	-	-	-	-	Retain	
2760	Corymbia citriodora	Spotted Gum	190		190	16	6	2	2	Regular	-	-	-	-	-	Typical	-	-	-	-	Typical	-	-	-	-	-	-	-	Retain	
2761	Corymbia tessellaris	Moreton Bay Ash	120		120	6	2	2	1	Regular	-	-	-	-	-	Typical	-	-	-	-	Typical	-	-	-	-	-	-	-	Retain	
2762	Corymbia citriodora	Spotted Gum	120		120	14	6	2	1	Regular	-	-	-	-	-	Typical	-	-	-	-	Typical	-	-	-	-	-	-	-	Retain	
2763	Corymbia citriodora	Spotted Gum	130		130	13	4	2	1	Regular	-	-	-	-	-	Typical	-	-	-	-	Typical	-	-	-	-	-	-	-	Retain	
2764	Corymbia citriodora	Spotted Gum	270		270	21	11	3	2	Regular	-	-	-	-	-	Typical	-	-	-	-	Typical	-	-	-	-	-	-	-	Retain	
2765	Corymbia citriodora	Spotted Gum	340		340	18	11	4	2	Regular	-	-	-	-	-	Typical	-	-	-	-	Typical	-	-	-	-	-	-	-	Retain	
2766	Eucalyptus seeana	Narrow-leaved Red Gum	270		270	18	8	3	2	Regular	-	-	-	-	-	Typical	-	-	-	-	Typical	-	-	-	-	-	-	-	Retain	
2767	Angophora subvelutina	Broad-leaved Apple	280		280	21	11	3	2	Regular	-	-	-	-	-	Typical	-	-	-	-	Typical	-	-	-	-	-	-	-	Retain	
2768	Angophora subvelutina	Broad-leaved Apple	150		150	15	7	2	1	Regular	-	-	-	-	-	Typical	-	-	-	-	Typical	-	-	-	-	-	-	-	Retain	
2769	Angophora subvelutina	Broad-leaved Apple	230		230	16	6	3	2	Regular	-	-	-	-	-	Typical	-	-	-	-	Typical	-	-	-	-	-	-	-	Retain	
2770	Angophora subvelutina	Broad-leaved Apple	350		350	21	13	4	2	Regular	-	-	-	-	-	Typical	-	-	-	-	Typical	-	-	-	-	-	-	-	Retain	
2771	Angophora subvelutina	Broad-leaved Apple	140		140	13	5	2	1	Regular	-	-	-	-	-	Typical	-	-	-	-	Typical	-	-	-	-	-	-	-	Retain	
2772	Acacia dispartima	Hickory Wattle	150		150	11	6	2	1	Regular	-	-	-	-	-	Typical	-	-	-	-	Typical	-	-	-	-	-	-	-	Retain	
2773	Angophora subvelutina	Broad-leaved Apple	380		380	21	11	5	2	Regular	-	-	-	-	-	Typical	-	-	-	-	Typical	-	-	-	-	-	-	-	Retain	
2774	Angophora subvelutina	Broad-leaved Apple	130		130	12	5	2	1	Regular	-	-	-	-	-	Typical	-	-	-	-	Typical	-	-	-	-	-	-	-	Retain	
2775	Corymbia tessellaris	Moreton Bay Ash	200		200	10	3	2	2	Regular	-	Thinning	Die-back	Epicormic	-	Poor	-	-	-	-	Typical	-	-	-	-	-	-	-	Retain	
2776	Alphitonia excelsa	Soap Tree	130		130	9	3	2	1	Regular	-	-	-	-	-	Typical	-	-	-	-	Typical	-	-	-	-	-	-	-	Retain	
2777	Casuarina cunninghamiana	River Sheoak	310		310	15	8	4	2	Regular	-	-	-	-	-	Typical	-	-	-	-	Typical	-	-	-	-	-	-	-	Retain	
2778	Angophora subvelutina	Broad-leaved Apple	120		120	8	4	2	1	Regular	-	-	-	-	-	Typical	-	-	-	-	Typical	-	-	-	-	-	-	-	Retain	
2779	Eucalyptus seeana	Narrow-leaved Red Gum	680		680	26	16	8	3	Regular	-	-	-	-	-	Typical	-	-	-	-	Typical	-	-	-	-	-	-	-	Retain	
2780	Melaleuca viminalis	Weeping Bottlebrush	120	100	156	8	5	2	2	Regular	-	-	-	-	-	Typical	Minor	-	-	-	Typical	-	-	-	-	-	-	-	Retain	
2781	Melaleuca viminalis	Weeping Bottlebrush	180		180	6	4	2	2	Regular	-	-	-	-	-	Typical	Major	-	-	-	Typical	-	-	-	-	-	-	-	Retain	
2782	Melaleuca viminalis	Weeping Bottlebrush	130		130	6	4	2	1	Regular	-	-	-	-	-	Typical	Major	-	-	-	Typical	-	-	-	-	-	-	-	Retain	
2783	Casuarina cunninghamiana	River Sheoak	120		120	7	4	2	1	Regular	-	-	-	-	-	Typical	-	-	-	-	Typical	-	-							

Tree ID	Specimen Details								Canopy Condition Details								Trunk Condition Details					Fauna Details and Habitat Value							
	Botanical Name	Common Name	Trunk DBH (mm)	Additional Trunks DBH (mm)	Total DBH (mm) [AS 4970-2009]	Height (m)	Spread (m)	Tree Protection Zone (m)	Structural Root Zone (m)	Canopy Form	Spreading	Thinning	Die-Back	Epicormic Growth	Lopped	Canopy Health	Leaning	Vines	Trunk Damage	Fire Damage	Trunk Health	Scats	Scratches	Hollows	Nest	Termite Nest	Habitat Value	Retention	
2857	Lophostemon suaveolens	Swamp Box	180		180	11	6	2	2	Regular	-	-	-	-	-	Typical	-	-	-	-	Typical	-	-	-	-	-	-	Retain	
2858	Eucalyptus tereticornis	Forest Red Gum	200		200	16	9	2	2	Regular	-	-	-	-	-	Typical	-	-	-	-	Typical	-	-	-	-	-	-	Retain	
2859	Eucalyptus seeana	Narrow-leaved Red Gum	200		200	16	8	2	2	Regular	-	-	-	-	-	Typical	-	-	-	-	Typical	-	-	-	-	-	-	Retain	
2860	Alphitonia excelsa	Soap Tree	150		150	11	6	2	1	Regular	-	-	-	-	-	Typical	-	-	-	-	Typical	-	-	-	-	-	-	Retain	
2882	Eucalyptus tereticornis	Forest Red Gum	280		280	18	11	3	2	One-sided	-	-	-	-	-	Typical	-	-	-	-	Typical	-	-	-	-	-	-	Retain	
2883	Corymbia citriodora	Spotted Gum	240		240	17	9	3	2	Regular	-	-	-	-	-	Typical	-	-	-	-	Typical	-	-	-	-	-	-	Retain	
2884	Eucalyptus tereticornis	Forest Red Gum	290		290	16	8	3	2	Regular	-	-	-	-	-	Typical	-	-	-	-	Typical	-	-	-	-	-	-	Retain	
2885	Eucalyptus crebra	Narrow-leaved Ironbark	250		250	17	8	3	2	Regular	-	-	-	-	-	Typical	-	-	-	-	Typical	-	-	-	-	-	-	Retain	
2886	Eucalyptus tereticornis	Forest Red Gum	200		200	16	8	2	2	Regular	-	-	-	-	-	Typical	-	-	-	-	Typical	-	-	-	-	-	-	Retain	
2887	Corymbia citriodora	Spotted Gum	320		320	19	9	4	2	Regular	-	-	-	-	-	Typical	-	-	-	-	Typical	-	-	-	-	-	-	Retain	
3018	Eucalyptus moluccana	Gum Topped Box	500		500	27	12	6	2	Regular	-	-	-	-	-	Typical	-	-	-	-	Typical	-	-	-	-	-	-	Remove	
3019	Corymbia citriodora	Spotted Gum	345		345	27	9	4	2	Regular	-	-	-	-	-	Typical	-	-	-	-	Typical	-	-	-	-	-	-	Remove	
3020	Acacia disparrima	Hickory Wattle	140		140	7	3	2	1	Regular	-	-	-	-	-	Typical	-	-	-	-	Typical	-	-	-	-	-	-	Remove	
3021	Alphitonia excelsa	Soap Tree	110		110	7	3	2	1	Regular	-	-	-	-	-	Typical	-	-	-	-	Typical	-	-	-	-	-	-	Remove	
3022	Corymbia citriodora	Spotted Gum	230		230	17	7	3	2	Regular	-	-	-	-	-	Typical	-	-	-	-	Typical	-	-	-	-	-	-	Remove	
3023	Eucalyptus moluccana	Gum Topped Box	270		270	24	7	3	2	Regular	-	-	Die-back	-	-	Typical	-	-	-	-	Typical	-	-	-	-	-	-	Remove	
3024	Alphitonia excelsa	Soap Tree	130		130	9	4	2	1	Regular	-	-	-	-	-	Typical	-	-	-	-	Typical	-	-	-	-	-	-	Remove	
3025	Alphitonia excelsa	Soap Tree	220		220	11	6	3	2	Regular	-	-	-	-	-	Typical	-	-	-	-	Typical	-	-	-	-	-	-	Remove	
3026	Alphitonia excelsa	Soap Tree	115		115	9	4	2	1	Regular	-	-	-	-	-	Typical	-	-	-	-	Typical	-	-	-	-	-	-	Remove	
3027	Acacia concurrens	Black Wattle	150		150	7	4	2	1	Regular	-	-	-	-	-	Typical	-	-	-	-	Typical	-	-	-	-	-	-	Remove	
3028	Alphitonia excelsa	Soap Tree	120		120	8	3	2	1	Regular	-	-	-	-	-	Typical	-	-	-	-	Typical	-	-	-	-	-	-	Remove	
3029	Acacia concurrens	Black Wattle	165		165	8	4	2	2	Regular	-	-	-	-	-	Typical	-	-	-	-	Typical	-	-	-	-	-	-	Remove	
3030	Eucalyptus crebra	Narrow-leaved Ironbark	255		255	19	7	3	2	Regular	-	-	-	-	-	Typical	-	-	-	-	Typical	-	-	-	-	-	-	Remove	
3031	Acacia disparrima	Hickory Wattle	105		105	7	4	2	1	Regular	-	-	-	-	-	Typical	-	-	-	-	Typical	-	-	-	-	-	-	Remove	
3032	Corymbia citriodora	Spotted Gum	420		420	24	9	5	2	Regular	-	-	-	-	-	Typical	-	-	-	-	Typical	-	-	-	-	-	-	Remove	
3033	Corymbia citriodora	Spotted Gum	170		170	18	7	2	2	Regular	-	-	-	-	-	Typical	-	-	-	-	Typical	-	-	-	-	-	-	Remove	
3034	Corymbia citriodora	Spotted Gum	190		190	18	7	2	2	Regular	-	-	-	-	-	Typical	-	-	-	-	Typical	-	-	-	-	-	-	Remove	
3035	Eucalyptus tereticornis	Forest Red Gum	125		125	11	5	2	1	Regular	-	-	-	-	-	Typical	Minor	-	-	-	Typical	-	-	-	-	-	-	Remove	
3036	Corymbia citriodora	Spotted Gum	130		130	15	5	2	1	Regular	-	-	-	-	-	Typical	-	-	-	-	Typical	-	-	-	-	-	-	Remove	
3037	Allocasuarina littoralis	Black She Oak	165		165	7	4	2	2	Regular	-	-	-	-	-	Typical	-	-	-	-	Typical	-	-	-	-	-	-	Remove	
3038	Corymbia citriodora	Spotted Gum	260		260	19	7	3	2	Regular	-	-	-	-	-	Typical	-	-	-	-	Typical	-	-	-	-	-	-	Remove	
3039	Corymbia citriodora	Spotted Gum	100		100	10	3	2	1	Regular	-	-	-	-	-	Typical	-	-	-	-	Typical	-	-	-	-	-	-	Remove	
3040	Corymbia citriodora	Spotted Gum	285		285	21	9	3	2	Regular	-	-	-	-	-	Typical	-	-	-	-	Typical	-	-	-	-	-	-	Remove	
3041	Acacia concurrens	Black Wattle	115		115	8	5	2	1	Regular	-	-	-	-	-	Typical	-	-	-	-	Typical	-	-	-	-	-	-	Remove	
3042	Eucalyptus crebra	Narrow-leaved Ironbark	220		220	18	8	3	2	Regular	-	-	-	-	-	Typical	-	-	-	-	Typical	-	-	-	-	-	-	Remove	
3043	Corymbia citriodora	Spotted Gum	165		165	16	5	2	2	Regular	-	-	-	-	-	Typical	-	-	-	-	Typical	-	-	-	-	-	-	Remove	
3044	Corymbia citriodora	Spotted Gum	165		165	12	7	2	2	Regular	-	-	-	-	-	Typical	Major	-	-	-	Typical	-	-	-	-	-	-	Remove	
3045	Corymbia citriodora	Spotted Gum	100		100	10	2	2	1	Regular	-	-	-	-	-	Typical	-	-	-	-	Typical	-	-	-	-	-	-	Remove	
3046	Alphitonia excelsa	Soap Tree	145		145	8	5	2	1	Regular	-	-	-	-	-	Typical	-	-	-	-	Typical	-	-	-	-	-	-	Remove	
3047	Corymbia citriodora	Spotted Gum	125		125	12	4	2	1	Regular	-	-	-	-	-	Typical	-	-	-	-	Typical	-	-	-	-	-	-	Remove	
3048	Acacia concurrens	Black Wattle	130		130	7	4	2	1	Regular	-	-	-	-	-	Typical	-	-	-	-	Typical	-	-	-	-	-	-	Remove	
3049	Corymbia citriodora	Spotted Gum	275		275	17	6	3	2	Regular	-	-	-	-	-	Typical	-	-	-	-	Typical	-	-	-	-	-	-	Remove	
3050	Eucalyptus crebra	Narrow-leaved Ironbark	205		205	16	5	2	2	Regular	-	-	-	-	-	Typical	-	-	-	-	Typical	-	-	-	-	-	-	Remove	
3051	Acacia concurrens	Black Wattle	120		120	7	4	2	1	Regular	-	-	-	-	-	Typical	-	-	-	-	Typical	-	-	-	-	-	-	Remove	
3052	Corymbia citriodora	Spotted Gum	370		370	22	10	4	2	Regular	-	-	-	-	-	Typical	-	-	-	-	Typical	-	-	-	-	-	-	Remove	
3053	Corymbia citriodora	Spotted Gum	185		185	15	6	2	2	Regular	-	-	-	-	-	Typical	-	-	-	-	Typical	-	-	-	-	-	-	Remove	
3054	Corymbia citriodora	Spotted Gum	110		110	12	3	2	1	Regular	-	-	-	-	-	Typical	-	-	-	-	Typical	-	-	-	-	-	-	Remove	
3055	Corymbia citriodora	Spotted Gum	100		100	11	4	2	1	Regular	-	Thinning	Die-back	Epicormic	-	Poor	-	-	-	-	Typical	-	-	-	-	-	-	Remove	
3056	DEAD/STAG		295		295	19	6	4	2	Regular	-	-	-	-	-	Typical	-	-	-	-	Typical	-	-	-	-	-	-	Remove	
3057	Alphitonia excelsa	Soap Tree	130		130	8	3	2	1	Regular	-	Thinning	Die-back	-	-	Poor	-	-	-	-	Typical	-	-	-	-	-	-	Remove	
3058	Eucalyptus tereticornis	Forest Red Gum	285		285	17	6	3	2	Regular	-	-	-	-	-	Typical	-	-	-	-	Typical	-	-	-	-	-	-	Remove	
3059	Corymbia citriodora	Spotted Gum	325		325	22	10	4	2	Regular	-	-	-	-	-	Typical	-	-	-	-	Typical	-	-	-	-	-	-	Remove	
3060	Acacia disparrima	Hickory Wattle	160		160	6	3	2	2	Regular	-	Thinning	Die-back	-	-	Poor	-	-	-	-	Typical	-	-	-	-	-	-	Remove	
3061	DEAD/STAG		285		285	21	7	3	2	Regular	-	-	-	-	-	Typical	-	-	-	-	Typical	-	-	-	-	-	-	Remove	
3062	Corymbia citriodora	Spotted Gum	230		230	18	7	3	2	Regular	-	-	-	-	-	Typical	-	-	-	-	Typical	-	-	-	-	-	-	Remove	
3063	Acacia disparrima	Hickory Wattle	100		100	7	3	2	1	Regular	-	-	-	-	-	Typical	-	-	-	-	Typical	-	-	-	-	-	-	Remove	
3064	Acacia concurrens	Black Wattle	100		100	7	3	2	1	Regular	-	-	-	-	-	Typical	-	-	-	-	Typical	-	-	-	-	-	-	Remove	
3065	Eucalyptus crebra	Narrow-leaved Ironbark	285		285	19	7	3	2	Regular	-	-	-	-	-	Typical	-	-	-	-	Typical	-	-	-	-	-	-	Remove	
3066	Corymbia citriodora	Spotted Gum	120		120	14	5	2	1	Regular	-	-	-	-	-	Typical	-	-	-	-	Typical	-	-	-	-	-	-	Remove	
3067	Acacia disparrima	Hickory Wattle	130	130	184	8	3	2	2	Regular	-	-	Die-back	-	-	Poor	-	-	-	-	Typical	-	-	-	-	-	-	Remove	
3068	Eucalyptus tereticornis	Forest Red Gum	285		285	19	7	3	2	Regular	-	-	-	-	-	Typical	-	-	-	-	Typical	-	-	-	-	-	-	Remove	
3069	Alphitonia excelsa	Soap Tree	175		175	8	4	2	2	Regular	-	Thinning	Die-back	-	-	Poor	Minor	-	Trunk Dmg.	-	Poor	-	-	-	-	-	-	Remove	
3070	Corymbia citriodora	Spotted Gum	235		235	23	9	3	2	Regular	-	-	-	-	-	Typical	-	-	-	-	Typical	-	-	-	-	-	-	Remove	
3071	Corymbia citriodora	Spotted Gum	210	130	247	17	7	3	2	Regular	-	-	-	-	-	Typical	-	-	-	-	Typical	-	-	-	-	-	-	Remove	
3072	Eucalyptus tereticornis	Forest Red Gum	140		140	12	5	2	1	Regular	-	-	-	-	-	Typical	-	-	-	-	Typical	-	-	-	-	-	-	Remove	
3073	Eucalyptus crebra	Narrow-leaved Ironbark	285		285	19	9	3	2	Regular	-	-	-</																

Tree ID	Specimen Details									Canopy Condition Details									Trunk Condition Details					Fauna Details and Habitat Value							
	Botanical Name	Common Name	Trunk DBH (mm)	Additional Trunks DBH (mm)	Total DBH (mm) [AS 4970-2009]	Height (m)	Spread (m)	Tree Protection Zone (m)	Structural Root Zone (m)	Canopy Form	Spreading	Thinning	Die-Back	Epicormic Growth	Lopped	Canopy Health	Leaning	Vines	Trunk Damage	Fire Damage	Trunk Health	Scats	Scratches	Hollows	Nest	Termite Nest	Habitat Value	Retention			
3076	Corymbia citriodora	Spotted Gum	380		380	23	7	5	2	One-sided	-	-	-	-	-	Typical	-	-	-	-	Typical	-	-	-	-	-	-	-	Remove		
3077	Acacia disparrima	Hickory Wattle	180		180	9	4	2	2	Regular	-	-	-	-	-	Typical	-	-	-	-	Typical	-	-	-	-	-	-	-	Remove		
3078	Corymbia citriodora	Spotted Gum	415		415	21	12	5	2	Regular	-	-	-	-	-	Typical	-	-	-	-	Typical	-	-	-	-	-	-	-	Remove		
3079	Corymbia citriodora	Spotted Gum	195		195	15	6	2	2	Regular	-	-	-	-	-	Typical	Minor	-	-	-	Typical	-	-	-	-	-	-	-	Remove		
3080	Eucalyptus tereticornis	Forest Red Gum	260		260	22	7	3	2	Regular	-	-	-	-	-	Typical	-	-	-	-	Typical	-	-	-	-	-	-	-	Remove		
3081	Eucalyptus tereticornis	Forest Red Gum	150		150	12	4	2	1	Regular	-	-	-	-	-	Typical	-	-	-	-	Typical	-	-	-	-	-	-	-	Remove		
3082	Corymbia citriodora	Spotted Gum	295		295	26	8	4	2	Regular	-	-	-	-	-	Typical	-	-	-	-	Typical	-	-	-	-	-	-	-	Remove		
3083	Corymbia citriodora	Spotted Gum	390		390	23	8	5	2	Regular	-	-	-	-	-	Typical	-	-	-	-	Typical	-	-	-	-	-	-	-	Remove		
3084	Corymbia citriodora	Spotted Gum	275		275	21	9	3	2	Regular	-	-	-	-	-	Typical	-	-	-	-	Typical	-	-	-	-	-	-	-	Remove		
3085	Corymbia citriodora	Spotted Gum	590		590	27	14	7	3	Regular	-	-	Die-back	-	-	Typical	-	-	-	-	Typical	-	-	-	-	-	-	-	Remove		
3086	Eucalyptus crebra	Narrow-leaved Ironbark	245		245	15	6	3	2	Regular	-	-	-	-	-	Typical	-	-	-	-	Typical	-	-	-	-	-	-	-	Remove		
3087	Corymbia citriodora	Spotted Gum	295		295	15	7	4	2	Regular	-	-	-	-	-	Typical	-	-	-	-	Typical	-	-	-	-	-	-	-	Remove - Fill stockpiling		
3088	Acacia concurrens	Black Wattle	120	120, 80	188	7	5	2	2	Regular	-	-	-	-	-	Typical	-	-	-	-	Typical	-	-	-	-	-	-	-	Remove		
3089	Acacia concurrens	Black Wattle	125		125	6	4	2	1	Regular	-	-	-	-	-	Typical	-	-	-	-	Typical	-	-	-	-	-	-	-	Remove		
3090	Acacia concurrens	Black Wattle	125		125	7	3	2	1	Regular	-	-	-	-	-	Typical	-	-	-	-	Typical	-	-	-	-	-	-	-	Remove		
3091	Acacia concurrens	Black Wattle	120		120	6	3	2	1	Regular	-	-	-	-	-	Typical	-	-	-	-	Typical	-	-	-	-	-	-	-	Remove		
3092	Acacia concurrens	Black Wattle	165		165	7	4	2	2	Regular	-	-	-	-	-	Typical	-	-	-	-	Typical	-	-	-	-	-	-	-	Remove		
3093	Acacia concurrens	Black Wattle	130	85	155	7	3	2	2	Regular	-	-	-	-	-	Typical	-	-	-	-	Typical	-	-	-	-	-	-	-	Remove		
3094	Acacia concurrens	Black Wattle	160	160	226	7	5	3	2	Regular	-	-	-	-	-	Typical	-	-	-	-	Typical	-	-	-	-	-	-	-	Remove		
3095	Acacia concurrens	Black Wattle	125	125	177	7	3	2	2	Regular	-	-	-	-	-	Typical	-	-	-	-	Typical	-	-	-	-	-	-	-	Remove		
3096	Acacia concurrens	Black Wattle	155	150	216	8	4	3	2	Regular	-	-	-	-	-	Typical	-	-	-	-	Typical	-	-	-	-	-	-	-	Remove		
3097	Acacia concurrens	Black Wattle	155		155	8	4	2	2	Regular	-	-	-	-	-	Typical	-	-	-	-	Typical	-	-	-	-	-	-	-	Remove		
3098	Acacia concurrens	Black Wattle	110		110	7	3	2	1	Regular	-	-	-	-	-	Typical	-	-	-	-	Typical	-	-	-	-	-	-	-	Remove		
3099	Acacia concurrens	Black Wattle	190		190	8	4	2	2	Regular	-	-	-	-	-	Typical	-	-	-	-	Typical	-	-	-	-	-	-	-	Remove		
3100	Acacia concurrens	Black Wattle	130		130	7	3	2	1	Regular	-	-	-	-	-	Typical	-	-	-	-	Typical	-	-	-	-	-	-	-	Remove		
3101	Acacia concurrens	Black Wattle	140		140	7	3	2	1	Regular	-	-	-	-	-	Typical	-	-	-	-	Typical	-	-	-	-	-	-	-	Remove		
3102	Acacia concurrens	Black Wattle	130		130	7	3	2	1	Regular	-	-	-	-	-	Typical	-	-	-	-	Typical	-	-	-	-	-	-	-	Remove		
3103	Acacia concurrens	Black Wattle	165	145	220	8	5	3	2	Regular	-	-	-	-	-	Typical	-	-	-	-	Typical	-	-	-	-	-	-	-	Remove		
3108	Eucalyptus crebra	Narrow-leaved Ironbark	320		320	21	9	4	2	Regular	-	-	-	-	-	Typical	-	-	-	-	Typical	-	-	-	-	-	-	-	Retain		
3109	Acacia concurrens	Black Wattle	240		240	8	6	3	2	Regular	-	-	-	-	-	Typical	-	-	-	-	Typical	-	-	-	-	-	-	-	Retain		
3110	Corymbia citriodora	Spotted Gum	165		165	11	2	2	2	Regular	-	-	-	-	-	Typical	-	-	-	-	Typical	-	-	-	-	-	-	-	Remove		
3111	Eucalyptus crebra	Narrow-leaved Ironbark	380		380	17	7	5	2	One-sided	-	-	-	-	-	Typical	-	-	-	-	Typical	-	-	-	-	-	-	-	Remove		
3112	Acacia concurrens	Black Wattle	150	140, 100, 20	229	6	6	3	2	Regular	-	-	-	-	-	Typical	-	-	-	-	Typical	-	-	-	-	-	-	-	Remove		
3113	Acacia concurrens	Black Wattle	150	120, 100, 120	248	5	6	3	2	Regular	-	-	-	-	-	Typical	-	-	-	-	Typical	-	-	-	-	-	-	-	Remove		
3114	Corymbia citriodora	Spotted Gum	285		285	18	8	3	2	Regular	-	-	Die-back	-	-	Typical	-	-	-	-	Typical	-	-	-	-	-	-	-	Remove		
3115	Corymbia citriodora	Spotted Gum	245		245	17	8	3	2	Regular	-	-	Die-back	-	-	Typical	-	-	-	-	Typical	-	-	-	-	-	-	-	Retain		
3116	Corymbia citriodora	Spotted Gum	310		310	19	6	4	2	Regular	-	-	Die-back	-	-	Typical	-	-	-	-	Typical	-	-	-	-	-	-	-	Retain		
3117	Corymbia citriodora	Spotted Gum	310		310	18	8	4	2	Regular	-	-	Die-back	-	-	Typical	-	-	-	-	Typical	-	-	-	-	-	-	-	Retain		
3118	Eucalyptus crebra	Narrow-leaved Ironbark	280		280	17	8	3	2	Regular	-	-	-	-	-	Typical	-	-	-	-	Typical	-	-	-	-	-	-	-	Retain		
3119	Corymbia citriodora	Spotted Gum	295		295	16	7	4	2	Regular	-	-	-	-	-	Typical	-	-	-	-	Typical	-	-	-	-	-	-	-	Retain		
3120	Corymbia citriodora	Spotted Gum	290		290	17	5	3	2	One-sided	-	-	-	-	-	Typical	-	-	-	-	Typical	-	-	-	-	-	-	-	Retain		
3121	Corymbia citriodora	Spotted Gum	155		155	11	5	2	2	Regular	-	-	-	-	-	Typical	-	-	-	-	Typical	-	-	-	-	-	-	-	Retain		
3122	Corymbia citriodora	Spotted Gum	140		140	10	2	2	1	Regular	-	-	-	-	-	Typical	-	-	-	-	Typical	-	-	-	-	-	-	-	Retain		
3123	Corymbia citriodora	Spotted Gum	170		170	11	3	2	2	Regular	-	-	-	-	-	Typical	-	-	-	-	Typical	-	-	-	-	-	-	-	Retain		
3124	Corymbia citriodora	Spotted Gum	370		370	21	10	4	2	Regular	-	-	-	-	-	Typical	-	-	-	-	Typical	-	-	-	-	-	-	-	Retain		
3125	Eucalyptus crebra	Narrow-leaved Ironbark	300		300	17	6	4	2	Regular	-	-	-	-	-	Typical	-	-	-	-	Typical	-	-	-	-	-	-	-	Retain		
3126	Eucalyptus tereticornis	Forest Red Gum	130		130	7	3	2	1	Regular	-	-	-	-	-	Typical	-	-	-	-	Typical	-	-	-	-	-	-	-	Retain		
3127	Acacia concurrens	Black Wattle	185		185	7	5	2	2	Regular	-	-	-	-	-	Typical	-	-	-	-	Typical	-	-	-	-	-	-	-	Retain		
3128	Corymbia citriodora	Spotted Gum	150		150	10	2	2	1	Regular	-	-	-	-	-	Typical	-	-	-	-	Typical	-	-	-	-	-	-	-	Retain		
3129	Corymbia citriodora	Spotted Gum	500		500	24	12	6	2	Regular	-	-	-	-	-	Typical	-	-	Trunk Dmg.	-	Typical	-	-	-	-	-	-	-	Retain		
3130	Corymbia citriodora	Spotted Gum	365		365	21	8	4	2	Regular	-	-	-	-	-	Typical	-	-	-	-	Typical	-	-	-	-	-	-	-	Retain		
3180	Angophora subvelutina	Broad-leaved Apple	420		420	21	9	5	2	Regular	-	-	-	-	-	Typical	-	-	-	-	Typical	-	-	-	-	-	-	-	Retain		
3181	Alphitonia excelsa	Soap Tree	115		115	11	5	2	1	Regular	-	-	-	-	-	Typical	-	-	-	-	Typical	-	-	-	-	-	-	-	Retain		
3182	Alphitonia excelsa	Soap Tree	130		130	10	4	2	1	Regular	-	-	-	-	-	Typical	-	-	-	-	Typical	-	-	-	-	-	-	-	Retain		
3183	Lophostemon suaveolens	Swamp Box	245		245	12	5	3	2	Regular	-	-	-	-	-	Typical	-	-	-	-	Typical	-	-	-	-	-	-	-	Retain		
3184	Lophostemon suaveolens	Swamp Box	260		260	14	6	3	2	Regular	-	-	-	-	-	Typical	-	-	-	-	Typical	-	-	-	-	-	-	-	Retain		
3185	Acacia disparrima	Hickory Wattle	215		215	13	6	3	2	Regular	-	-	-	-	-	Typical	-	-	-	-	Typical	-	-	-	-	-	-	-	Retain		
3186	Casuarina cunninghamiana	River Sheoak	265		265	21	7	3	2	Regular	-	-	-	-	-	Typical	-	-	-	-	Typical	-	-	-	-	-	-	-	Retain		
3187	Lophostemon suaveolens	Swamp Box	265		265	16	7	3	2	Regular	-	-	-	-	-	Typical	-	-	-	-	Typical	-	-	-	-	-	-	-	Retain		
3188	Lophostemon suaveolens	Swamp Box	275		275	15	6	3	2	Regular	-	-	-	-	-	Typical	-	-	-	-	Typical	-	-	-	-	-	-	-	Retain		
3189	Angophora subvelutina	Broad-leaved Apple	200		200	17	6	2	2	Regular	-	-	-	-	-	Typical	Minor	-	-	-	Typical	-	-	-	-	-	-	-	Retain		
3190	Lophostemon suaveolens	Swamp Box	255		255	16	6	3	2	Regular	-	-	-	-	-	Typical	-	-	-	-	Typical	-	-	-	-	-	-	-	Retain		
3191	Lophostemon suaveolens	Swamp Box	130		130	11	5	2	1	Regular	-	-	-	-	-	Typical	-	-	-	-	Typical	-	-	-	-	-	-	-	Retain		
3192	Lophostemon suaveolens	Swamp Box	270		270	16	6	3	2	Regular																					

Tree ID	Specimen Details								Canopy Condition Details							Trunk Condition Details					Fauna Details and Habitat Value							
	Botanical Name	Common Name	Trunk DBH (mm)	Additional Trunks DBH (mm)	Total DBH (mm) [AS 4970-2009]	Height (m)	Spread (m)	Tree Protection Zone (m)	Structural Root Zone (m)	Canopy Form	Spreading	Thinning	Die-Back	Epicormic Growth	Lopped	Canopy Health	Leaning	Vines	Trunk Damage	Fire Damage	Trunk Health	Scats	Scratches	Hollows	Nest	Termite Nest	Habitat Value	Retention
3265	Corymbia intermedia	Pink Bloodwood	400		400	24	11	5	2	Regular	-	-	-	-	-	Typical	-	-	-	-	Typical	-	-	-	-	-	-	Retain
3266	Corymbia tessellaris	Moreton Bay Ash	275		275	17	5	3	2	Regular	-	-	-	-	-	Typical	-	-	-	-	Typical	-	-	-	-	-	-	Retain
3267	Eucalyptus tereticornis	Forest Red Gum	265		265	21	7	3	2	Regular	-	-	Die-back	-	-	Typical	-	-	-	-	Typical	-	-	-	-	-	-	Retain
3268	Eucalyptus tereticornis	Forest Red Gum	430		430	24	7	5	2	Regular	-	-	-	-	-	Typical	-	-	-	-	Typical	-	-	-	-	-	-	Retain
3269	Angophora subvelutina	Broad-leaved Apple	430		430	23	12	5	2	Regular	-	-	-	-	-	Typical	-	-	-	-	Typical	-	-	-	-	-	-	Retain
3270	Lophostemon suaveolens	Swamp Box	210		210	12	5	3	2	Regular	-	-	-	-	-	Typical	-	-	-	-	Typical	-	-	-	-	-	-	Retain
3271	Eucalyptus tereticornis	Forest Red Gum	560		560	29	14	7	3	Regular	-	-	-	-	-	Typical	-	-	-	-	Typical	-	-	-	-	-	-	Retain
3272	Lophostemon suaveolens	Swamp Box	265		265	14	6	3	2	Regular	-	-	-	-	-	Typical	-	-	-	-	Typical	-	-	-	-	-	-	Retain
3273	Lophostemon suaveolens	Swamp Box	210		210	12	5	3	2	One-sided	-	-	-	-	-	Typical	-	-	-	-	Typical	-	-	-	-	-	-	Retain
3274	Lophostemon suaveolens	Swamp Box	165		165	10	4	2	2	Regular	-	-	-	-	-	Typical	-	-	-	-	Typical	-	-	-	-	-	-	Retain
3275	Eucalyptus tereticornis	Forest Red Gum	300		300	22	8	4	2	Regular	-	-	-	-	-	Typical	-	-	-	-	Typical	-	-	-	-	-	-	Retain
3276	Lophostemon suaveolens	Swamp Box	485		485	16	8	6	2	Regular	-	-	-	-	-	Typical	-	-	-	-	Typical	-	-	-	-	-	-	Retain
3277	Casuarina cunninghamiana	River Sheoak	320	220, 185, 165	461	17	10	6	2	Regular	-	-	-	-	-	Typical	Major	-	-	-	Typical	-	-	-	-	-	-	Retain
3278	Casuarina cunninghamiana	River Sheoak	320		320	17	8	4	2	Regular	-	-	-	-	-	Typical	-	-	-	-	Typical	-	-	-	-	-	-	Retain
3279	Casuarina cunninghamiana	River Sheoak	380		380	21	9	5	2	One-sided	-	-	-	-	-	Typical	Minor	-	-	-	Typical	-	-	-	-	-	-	Retain
3280	Casuarina cunninghamiana	River Sheoak	410		410	17	5	5	2	Regular	-	-	-	-	-	Typical	Minor	-	Trunk Dmg.	-	Typical	-	-	-	-	-	-	Retain
3281	Casuarina cunninghamiana	River Sheoak	720	590	931	23	16	11	3	Regular	-	-	-	-	-	Typical	-	-	-	-	Typical	-	-	-	-	-	-	Retain
3282	Acacia leiocalyx	Early-flowering Black Wattle	185		185	13	6	2	2	Regular	-	-	-	-	-	Typical	Minor	-	-	-	Typical	-	-	-	-	-	-	Retain
3283	Eucalyptus tereticornis	Forest Red Gum	295		295	20	7	4	2	Regular	-	-	-	-	-	Typical	-	-	-	-	Typical	-	-	-	-	-	-	Remove
3284	Angophora subvelutina	Broad-leaved Apple	180		180	15	5	2	2	Regular	-	-	-	-	-	Typical	-	-	-	-	Typical	-	-	-	-	-	-	Remove
3285	Acacia dispartima	Hickory Wattle	195		195	12	6	2	2	Regular	-	-	-	-	-	Typical	-	-	-	-	Typical	-	-	-	-	-	-	Remove
3286	Angophora subvelutina	Broad-leaved Apple	185		185	16	6	2	2	Regular	-	-	-	-	-	Typical	-	-	-	-	Typical	-	-	-	-	-	-	Remove
3287	Corymbia tessellaris	Moreton Bay Ash	155		155	13	4	2	2	Regular	-	-	-	-	-	Typical	-	-	-	-	Typical	-	-	-	-	-	-	Remove
3288	Angophora subvelutina	Broad-leaved Apple	265		265	21	6	3	2	Regular	-	-	-	-	-	Typical	-	-	-	-	Typical	-	-	-	-	-	-	Remove
3289	Angophora subvelutina	Broad-leaved Apple	300		300	22	8	4	2	Regular	-	-	-	-	-	Typical	-	-	-	-	Typical	-	-	-	-	-	-	Remove
3290	Angophora subvelutina	Broad-leaved Apple	275		275	15	6	3	2	Regular	-	-	-	-	-	Typical	-	-	-	-	Typical	-	-	-	-	-	-	Remove
3291	Angophora subvelutina	Broad-leaved Apple	245		245	16	7	3	2	Regular	-	-	-	-	-	Typical	-	-	-	-	Typical	-	-	-	-	-	-	Remove
3292	Eucalyptus tereticornis	Forest Red Gum	120		120	10	2	2	1	Regular	-	-	-	-	-	Typical	-	-	-	-	Typical	-	-	-	-	-	-	Retain
3293	Eucalyptus tereticornis	Forest Red Gum	195		195	17	3	2	2	Regular	-	-	-	-	-	Typical	-	-	-	-	Typical	-	-	-	-	-	-	Retain
3294	Corymbia intermedia	Pink Bloodwood	125		125	10	2	2	1	Regular	-	-	-	-	-	Typical	-	-	-	-	Typical	-	-	-	-	-	-	Retain
3295	Acacia concurrens	Black Wattle	165		165	11	6	2	2	Regular	-	-	-	-	-	Typical	-	-	-	-	Typical	-	-	-	-	-	-	Retain
3296	Acacia dispartima	Hickory Wattle	170		170	13	5	2	2	Regular	-	-	-	-	-	Typical	-	-	-	-	Typical	-	-	-	-	-	-	Retain
3297	Eucalyptus tereticornis	Forest Red Gum	220		220	21	6	3	2	Regular	-	-	-	-	-	Typical	-	-	-	-	Typical	-	-	-	-	-	-	Remove
3298	Angophora subvelutina	Broad-leaved Apple	185		185	15	4	2	2	Regular	-	-	-	-	-	Typical	-	-	-	-	Typical	-	-	-	-	-	-	Remove
3299	Angophora subvelutina	Broad-leaved Apple	300		300	18	5	4	2	Regular	-	-	-	-	-	Typical	-	-	-	-	Typical	-	-	-	-	-	-	Remove
3300	Angophora subvelutina	Broad-leaved Apple	310		310	18	7	4	2	Regular	-	-	-	-	-	Typical	-	-	-	-	Typical	-	-	-	-	-	-	Remove
3301	Acacia dispartima	Hickory Wattle	165		165	10	6	2	2	Regular	-	-	-	-	-	Typical	-	-	-	-	Typical	-	-	-	-	-	-	Remove
3302	Eucalyptus tereticornis	Forest Red Gum	560		560	23	11	7	3	Regular	-	-	-	-	-	Typical	-	-	-	-	Typical	-	-	-	-	-	-	Remove
3303	Acacia dispartima	Hickory Wattle	100		100	8	5	2	1	One-sided	-	-	-	-	-	Typical	-	-	-	-	Typical	-	-	-	-	-	-	Remove
3304	Casuarina cunninghamiana	River Sheoak	470		470	22	10	6	2	Regular	-	-	-	-	-	Typical	-	-	-	-	Typical	-	-	-	-	-	-	Remove
3305	Acacia dispartima	Hickory Wattle	145		145	7	4	2	1	Regular	-	-	-	-	-	Typical	-	-	Trunk Dmg.	-	Typical	-	-	-	-	-	-	Remove - Fill stockpiling
3306	Corymbia citriodora	Spotted Gum	520		520	32	16	6	3	Regular	-	-	-	-	-	Typical	-	-	-	-	Typical	-	-	-	-	-	-	Remove - Fill stockpiling
3307	Corymbia intermedia	Pink Bloodwood	170	130	214	11	3	3	2	Regular	-	-	-	-	-	Typical	-	-	-	-	Typical	-	-	-	-	-	-	Remove - Fill stockpiling
3308	Corymbia citriodora	Spotted Gum	195		195	11	2	2	2	Regular	-	Thinning	Die-back	Epicormic	Lopped	Poor	-	-	-	-	Typical	-	-	-	-	-	-	Remove - Fill stockpiling
3309	Alphitonia excelsa	Soap Tree	120		120	9	4	2	1	Regular	-	-	-	-	-	Typical	-	-	-	-	Typical	-	-	-	-	-	-	Remove - Fill stockpiling
3310	Alphitonia excelsa	Soap Tree	110		110	8	3	2	1	Regular	-	-	-	-	-	Typical	-	-	-	-	Typical	-	-	-	-	-	-	Remove - Fill stockpiling
3311	Acacia dispartima	Hickory Wattle	150		150	8	3	2	1	Regular	-	-	-	-	-	Typical	-	-	-	-	Typical	-	-	-	-	-	-	Remove - Fill stockpiling
3312	Angophora leiocarpa	Smooth-barked Apple	100	90, 60	147	7	2	2	1	Regular	-	-	-	-	-	Typical	-	-	-	-	Typical	-	-	-	-	-	-	Remove - Fill stockpiling
3313	Eucalyptus moluccana	Gum Topped Box	320		320	21	7	4	2	Regular	-	-	-	-	-	Typical	-	-	-	-	Typical	-	-	-	-	-	-	Remove - Fill stockpiling
3314	Eucalyptus crebra	Narrow-leaved Ironbark	105		105	7	2	2	1	Regular	-	-	-	-	-	Typical	-	-	-	-	Typical	-	-	-	-	-	-	Remove - Fill stockpiling
3315	Alphitonia excelsa	Soap Tree	140		140	7	2	2	1	Regular	-	-	-	-	-	Typical	-	-	-	-	Typical	-	-	-	-	-	-	Remove - Fill stockpiling
3316	Corymbia citriodora	Spotted Gum	300		300	17	5	4	2	Regular	-	-	-	-	-	Typical	-	-	-	-	Typical	-	-	-	-	-	-	Remove - Fill stockpiling
3317	Corymbia citriodora	Spotted Gum	130		130	9	2	2	1	Regular	-	-	-	-	-	Typical	-	-	-	-	Typical	-	-	-	-	-	-	Remove - Fill stockpiling
3318	Eucalyptus tereticornis	Forest Red Gum	230		230	15	6	3	2	Regular	-	-	-	-	-	Typical	-	-	-	-	Typical	-	-	-	-	-	-	Remove - Fill stockpiling
3319	Corymbia citriodora	Spotted Gum	145		145	11	4	2	1	Regular	-	-	-	-	-	Typical	-	-	-	-	Typical	-	-	-	-	-	-	Remove - Fill stockpiling
3320	Eucalyptus tereticornis	Forest Red Gum	300		300	19	7	4	2	Regular	-	-	-	-	-	Typical	-	-	-	-	Typical	-	-	-	-	-	-	Remove - Fill stockpiling
3321	Allocasuarina littoralis	Black She Oak	100		100	7	2	2	1	Regular	-	-	-	-	-	Typical	-	-	-	-	Typical	-	-	-	-	-	-	Remove - Fill stockpiling
3322	Lophostemon suaveolens	Swamp Box	125		125	7	3	2	1	Regular	-	-	-	-	-	Typical	-	-	-	-	Typical	-	-	-	-	-	-	Remove - Fill stockpiling
3323	Alphitonia excelsa	Soap Tree	135		135	8	3	2	1	Regular	-	-	-	-	-	Typical	-	-	-	-	Typical	-	-	-	-	-	-	Remove - Fill stockpiling
3324	Corymbia citriodora	Spotted Gum	285		285	23	7	3	2	Regular	-	-	-	-	-	Typical	-	-	-	-	Typical	-	-	-	-	-	-	Remove - Fill stockpiling
3325	Corymbia citriodora	Spotted Gum	180		180	17	5	2	2	Regular	-	-	-	-	-	Typical	-	-	-	-	Typical	-	-	-	-	-	-	Remove - Fill stockpiling
3326	Corymbia citriodora	Spotted Gum	180		180	17	4	2	2	Regular	-	-	-	-	-	Typical	-	-	-	-	Typical	-	-	-	-	-	-	Remove - Fill stockpiling
3327	Eucalyptus moluccana	Gum Topped Box	320		320	19	8	4	2	Regular	-	-	-	-	-	Typical	-	-	-	-	Typical	-	-	-	-	-	-	Remove - Fill stockpiling
3328	Allocasuarina littoralis	Black She Oak	215		215	11	6	3	2	Regular	-	-	-	-	-	Typical	-	-	-	-	Typical	-	-	-	-	-	-	Remove - Fill stockpiling
3329	Allocasuarina littoralis	Black She Oak	140		140	9	4	2	1	Regular	-	-	-	-	-													

Tree ID	Specimen Details								Canopy Condition Details								Trunk Condition Details					Fauna Details and Habitat Value							Retention
	Botanical Name	Common Name	Trunk DBH (mm)	Additional Trunks DBH (mm)	Total DBH (mm) [AS 4970-2009]	Height (m)	Spread (m)	Tree Protection Zone (m)	Structural Root Zone (m)	Canopy Form	Spreading	Thinning	Die-Back	Epicormic Growth	Lopped	Canopy Health	Leaning	Vines	Trunk Damage	Fire Damage	Trunk Health	Scats	Scratches	Hollows	Nest	Termite Nest	Habitat Value		
3333	Acacia concurrens	Black Wattle	120		120	7	3	2	1	Regular	-	-	-	-	-	Typical	-	-	-	-	Typical	-	-	-	-	-	-	Remove - Fill stockpiling	
3334	Acacia dispartima	Hickory Wattle	140	85, 65	176	8	4	2	2	Regular	-	-	-	-	-	Typical	-	-	-	-	Typical	-	-	-	-	-	-	Remove - Fill stockpiling	
3335	Corymbia citriodora	Spotted Gum	230		230	19	7	3	2	Regular	-	-	-	-	-	Typical	-	-	-	-	Typical	-	-	-	-	-	-	Remove - Fill stockpiling	
3336	Corymbia citriodora	Spotted Gum	220		220	19	5	3	2	Regular	-	-	-	-	-	Typical	-	-	-	-	Typical	-	-	-	-	-	-	Remove - Fill stockpiling	
3337	Corymbia citriodora	Spotted Gum	210		210	18	2	3	2	Regular	-	-	-	-	-	Typical	-	-	-	-	Typical	-	-	-	-	-	-	Remove - Fill stockpiling	
3338	Corymbia citriodora	Spotted Gum	135		135	13	2	2	1	Regular	-	-	-	-	-	Typical	-	-	-	-	Typical	-	-	-	-	-	-	Remove - Fill stockpiling	
3339	Acacia concurrens	Black Wattle	145		145	6	4	2	1	Regular	-	-	-	-	-	Typical	-	-	-	-	Typical	-	-	-	-	-	-	Remove - Fill stockpiling	
3340	Eucalyptus tereticornis	Forest Red Gum	120		120	8	2	2	1	Regular	-	-	-	-	-	Typical	-	-	-	-	Typical	-	-	-	-	-	-	Remove - Fill stockpiling	
3341	Melaleuca viminalis	Weeping Bottlebrush	280	270, 220, 200, 185	523	9	12	6	3	Regular	-	-	-	-	-	Typical	-	-	-	-	Typical	-	-	-	-	-	-	Retain	
3342	Alphitonia excelsa	Soap Tree	145		145	8	4	2	1	Regular	-	-	-	-	-	Typical	-	-	-	-	Typical	-	-	-	-	-	-	Retain	
3343	Angophora subvelutina	Broad-leaved Apple	105		105	9	2	2	1	Regular	-	-	-	-	-	Typical	-	-	-	-	Typical	-	-	-	-	-	-	Retain	
3344	Alphitonia excelsa	Soap Tree	110		110	10	4	2	1	Regular	-	-	-	-	-	Typical	-	-	-	-	Typical	-	-	-	-	-	-	Retain	
3345	Acacia concurrens	Black Wattle	130		130	10	5	2	1	Regular	-	-	-	-	-	Typical	-	-	-	-	Typical	-	-	-	-	-	-	Retain	
3346	Corymbia citriodora	Spotted Gum	310		310	19	7	4	2	Regular	-	-	-	-	-	Typical	-	-	-	-	Typical	-	-	-	-	-	-	Retain	
3347	Lophostemon suaveolens	Swamp Box	265		265	12	5	3	2	Regular	-	-	-	-	-	Typical	-	-	-	-	Typical	-	-	-	-	-	-	Retain	
3348	Lophostemon suaveolens	Swamp Box	125		125	10	3	2	1	Regular	-	-	-	-	-	Typical	-	-	-	-	Typical	-	-	-	-	-	-	Retain	
3349	Alphitonia excelsa	Soap Tree	165		165	11	5	2	2	Regular	-	-	-	-	-	Typical	-	-	-	-	Typical	-	-	-	-	-	-	Retain	
3350	Acacia dispartima	Hickory Wattle	165		165	9	5	2	2	Regular	-	-	-	-	-	Typical	Minor	-	-	-	Typical	-	-	-	-	-	-	Retain	
3351	Corymbia tessellaris	Moreton Bay Ash	220		220	19	4	3	2	Regular	-	-	-	-	-	Typical	-	-	-	-	Typical	-	-	-	-	-	-	Retain	
3352	Eucalyptus tereticornis	Forest Red Gum	320	260	412	21	8	5	2	Regular	-	-	-	-	-	Typical	-	-	-	-	Typical	-	-	-	-	-	-	Retain	
3353	Acacia dispartima	Hickory Wattle	200		200	10	6	2	2	Regular	-	-	-	-	-	Typical	-	-	-	-	Typical	-	-	-	-	-	-	Retain	
3354	Corymbia tessellaris	Moreton Bay Ash	185		185	17	6	2	2	Regular	-	-	-	-	-	Typical	-	-	-	-	Typical	-	-	-	-	-	-	Retain	
3355	Alphitonia excelsa	Soap Tree	120		120	8	3	2	1	Regular	-	-	-	-	-	Typical	-	-	-	-	Typical	-	-	-	-	-	-	Retain	
3356	Corymbia citriodora	Spotted Gum	375		375	22	8	5	2	Regular	-	-	-	-	-	Typical	-	-	-	-	Typical	-	-	-	-	-	-	Retain	
3357	Lophostemon suaveolens	Swamp Box	210		210	14	6	3	2	Regular	-	-	-	-	-	Typical	-	-	-	-	Typical	-	-	-	-	-	-	Retain	
3358	Angophora subvelutina	Broad-leaved Apple	420		420	21	12	5	2	Regular	-	-	-	-	-	Typical	-	-	-	-	Typical	-	-	-	-	-	-	Retain	
3359	Corymbia tessellaris	Moreton Bay Ash	220		220	18	5	3	2	Regular	-	-	-	-	-	Typical	-	-	-	-	Typical	-	-	-	-	-	-	Retain	
3360	Angophora subvelutina	Broad-leaved Apple	320		320	17	9	4	2	Regular	-	-	-	-	-	Typical	-	-	-	-	Typical	-	-	-	-	-	-	Retain	
3361	Acacia dispartima	Hickory Wattle	145		145	9	4	2	1	Regular	-	-	-	-	-	Typical	-	-	-	-	Typical	-	-	-	-	-	-	Retain	
3362	Acacia concurrens	Black Wattle	125		125	10	5	2	1	Regular	-	-	-	-	-	Typical	-	-	-	-	Typical	-	-	-	-	-	-	Retain	
3363	Lophostemon suaveolens	Swamp Box	240	240	339	13	7	4	2	Regular	-	-	-	-	-	Typical	-	-	-	-	Typical	-	-	-	-	-	-	Retain	
3364	Corymbia tessellaris	Moreton Bay Ash	125		125	13	3	2	1	Regular	-	-	-	-	-	Typical	-	-	-	-	Typical	-	-	-	-	-	-	Retain	
3365	Corymbia intermedia	Pink Bloodwood	200		200	15	5	2	2	Regular	-	-	-	-	-	Typical	-	-	-	-	Typical	-	-	-	-	-	-	Retain	
3366	Acacia dispartima	Hickory Wattle	160		160	8	4	2	2	Regular	-	-	-	-	-	Typical	-	-	-	-	Typical	-	-	-	-	-	-	Retain	
3367	Eucalyptus tereticornis	Forest Red Gum	320		320	23	9	4	2	Regular	-	-	-	-	-	Typical	-	-	-	-	Typical	-	-	-	-	-	-	Retain	
3368	Eucalyptus tereticornis	Forest Red Gum	220		220	21	7	3	2	Regular	-	-	-	-	-	Typical	-	-	-	-	Typical	-	-	-	-	-	-	Retain	
3369	Corymbia citriodora	Spotted Gum	180		180	15	7	2	2	Regular	-	-	-	-	-	Typical	Major	-	-	-	Typical	-	-	-	-	-	-	Retain	
3370	Corymbia intermedia	Pink Bloodwood	180		180	15	5	2	2	Regular	-	-	-	-	-	Typical	-	-	-	-	Typical	-	-	-	-	-	-	Retain	
3371	Acacia concurrens	Black Wattle	130		130	7	3	2	1	Regular	-	-	-	-	-	Typical	-	-	-	-	Typical	-	-	-	-	-	-	Retain	
3372	Angophora subvelutina	Broad-leaved Apple	210		210	12	5	3	2	Regular	-	-	-	-	-	Typical	-	-	-	-	Typical	-	-	-	-	-	-	Retain	
3373	Eucalyptus crebra	Narrow-leaved Ironbark	170		170	14	3	2	2	Regular	-	-	-	-	-	Typical	-	-	-	-	Typical	-	-	-	-	-	-	Retain	
3374	Corymbia citriodora	Spotted Gum	220		220	17	3	3	2	Regular	-	-	-	-	-	Typical	-	-	-	-	Typical	-	-	-	-	-	-	Retain	
3375	Corymbia citriodora	Spotted Gum	125		125	12	2	2	1	Regular	-	-	-	-	-	Typical	-	-	-	-	Typical	-	-	-	-	-	-	Retain	
3376	Corymbia citriodora	Spotted Gum	155		155	15	4	2	2	Regular	-	-	-	-	-	Typical	-	-	-	-	Typical	-	-	-	-	-	-	Retain	
3377	Corymbia citriodora	Spotted Gum	115		115	15	2	2	1	Regular	-	-	-	-	-	Typical	-	-	-	-	Typical	-	-	-	-	-	-	Retain	
3378	Corymbia citriodora	Spotted Gum	160		160	11	3	2	2	One-sided	-	-	-	-	-	Typical	-	-	-	-	Typical	-	-	-	-	-	-	Retain	
3379	Eucalyptus crebra	Narrow-leaved Ironbark	180		180	17	6	2	2	Regular	-	-	-	-	-	Typical	-	-	-	-	Typical	-	-	-	-	-	-	Retain	
3380	Acacia concurrens	Black Wattle	180		180	9	5	2	2	Regular	-	-	-	-	-	Typical	-	-	-	-	Typical	-	-	-	-	-	-	Retain	
3381	Corymbia tessellaris	Moreton Bay Ash	185		185	16	5	2	2	Regular	-	-	-	-	-	Typical	-	-	-	-	Typical	-	-	-	-	-	-	Retain	
3382	Corymbia citriodora	Spotted Gum	125		125	10	2	2	1	Regular	-	-	-	-	-	Typical	-	-	-	-	Typical	-	-	-	-	-	-	Retain	
3383	Lophostemon suaveolens	Swamp Box	145		145	10	3	2	1	Regular	-	Thinning	Die-back	-	-	Poor	-	-	-	-	Typical	-	-	-	-	-	-	Retain	
3384	Corymbia citriodora	Spotted Gum	125		125	10	3	2	1	Regular	-	-	-	-	-	Typical	-	-	-	-	Typical	-	-	-	-	-	-	Retain	
3385	Corymbia tessellaris	Moreton Bay Ash	360		360	17	7	4	2	Regular	-	-	-	-	-	Typical	-	-	-	-	Typical	-	-	-	-	-	-	Retain	
3386	Corymbia tessellaris	Moreton Bay Ash	140		140	12	2	2	1	Regular	-	-	-	-	-	Typical	-	-	-	-	Typical	-	-	-	-	-	-	Retain	
3387	Eucalyptus crebra	Narrow-leaved Ironbark	185	170	251	14	5	3	2	Regular	-	-	-	-	-	Typical	-	-	-	-	Typical	-	-	-	-	-	-	Retain	
3388	Angophora subvelutina	Broad-leaved Apple	170		170	9	3	2	2	Regular	-	-	-	-	-	Typical	-	-	-	-	Typical	-	-	-	-	-	-	Retain	
3389	Eucalyptus crebra	Narrow-leaved Ironbark	210		210	19	4	3	2	Regular	-	-	-	-	-	Typical	-	-	-	-	Typical	-	-	-	-	-	-	Retain	
3390	Eucalyptus crebra	Narrow-leaved Ironbark	195		195	18	4	2	2	Regular	-	-	-	-	-	Typical	-	-	-	-	Typical	-	-	-	-	-	-	Retain	
3391	Angophora subvelutina	Broad-leaved Apple	255		255	13	7	3	2	Regular	-	-	-	-	-	Typical	-	-	-	-	Typical	-	-	-	-	-	-	Retain	
3392	Eucalyptus tereticornis	Forest Red Gum	420		420	19	9	5	2	Regular	-	-	-	-	-	Typical	-	-	-	-	Typical	-	-	-	-	-	-	Retain	
3393	Corymbia intermedia	Pink Bloodwood	145		145	9	4	2	1	One-sided	-	-	-	-	-	Typical	Minor	-	-	-	Typical	-	-	-	-	-	-	Retain	
3394	Alphitonia excelsa	Soap Tree	110		110	7	3	2	1	Regular	-	-	-	-	-	Typical	-	-	-	-	Typical	-	-	-	-	-	-	Retain	
3395	Corymbia citriodora	Spotted Gum	105		105	12	3	2	1	Regular	-	-	-	-	-	Typical	-	-	-	-	Typical	-	-	-	-	-	-	Retain	
3396	Corymbia citriodora	Spotted Gum	105		105	12	2	2	1	Regular	-	-	-	-	-	Typical	-	-	-	-	Typical	-	-	-	-	-	-	Retain	
3397	Corymbia citriodora	Spotted Gum	130		130	12	4	2	1	Regular	-	-	-																

Tree ID	Specimen Details								Canopy Condition Details								Trunk Condition Details					Fauna Details and Habitat Value							Retention
	Botanical Name	Common Name	Trunk DBH (mm)	Additional Trunks DBH (mm)	Total DBH (mm) [AS 4970-2009]	Height (m)	Spread (m)	Tree Protection Zone (m)	Structural Root Zone (m)	Canopy Form	Spreading	Thinning	Die-Back	Epicormic Growth	Lopped	Canopy Health	Leaning	Vines	Trunk Damage	Fire Damage	Trunk Health	Scats	Scratches	Hollows	Nest	Termite Nest	Habitat Value		
3401	Acacia concurrens	Black Wattle	175		175	9	4	2	2	Regular	-	-	-	-	-	Typical	-	-	-	-	Typical	-	-	-	-	-	-	Retain	
3402	Corymbia citriodora	Spotted Gum	125		125	11	3	2	1	Regular	-	-	-	-	-	Typical	-	-	-	-	Typical	-	-	-	-	-	-	Retain	
3403	Acacia dissparrima	Hickory Wattle	120	100	156	8	4	2	2	Regular	-	-	-	-	-	Typical	-	-	-	-	Typical	-	-	-	-	-	-	Retain	
3404	Corymbia citriodora	Spotted Gum	120		120	13	2	2	1	Regular	-	-	-	-	-	Typical	-	-	-	-	Typical	-	-	-	-	-	-	Retain	
3405	Lophostemon suaveolens	Swamp Box	180		180	11	5	2	2	Regular	-	-	-	-	-	Typical	-	-	-	-	Typical	-	-	-	-	-	-	Retain	
3406	Corymbia citriodora	Spotted Gum	190		190	17	4	2	2	Regular	-	-	-	-	-	Typical	-	-	-	-	Typical	-	-	-	-	-	-	Retain	
3407	Acacia concurrens	Black Wattle	105		105	8	3	2	1	Regular	-	-	-	-	-	Typical	-	-	-	-	Typical	-	-	-	-	-	-	Retain	
3408	Acacia dissparrima	Hickory Wattle	160		160	7	4	2	2	Regular	-	-	-	-	-	Typical	-	-	-	-	Typical	-	-	-	-	-	-	Retain	
3409	Acacia dissparrima	Hickory Wattle	150		150	7	4	2	1	Regular	-	-	-	-	-	Typical	-	-	-	-	Typical	-	-	-	-	-	-	Retain	
3410	Lophostemon suaveolens	Swamp Box	210	190	283	12	5	3	2	Regular	-	-	-	-	-	Typical	-	-	-	-	Typical	-	-	-	-	-	-	Retain	
3411	Acacia concurrens	Black Wattle	135		135	7	3	2	1	Regular	-	Thinning	Die-back	-	-	Poor	-	-	-	-	Typical	-	-	-	-	-	-	Retain	
3412	Lophostemon suaveolens	Swamp Box	185		185	12	5	2	2	Regular	-	-	-	-	-	Typical	-	-	-	-	Typical	-	-	-	-	-	-	Retain	
3413	Eucalyptus crebra	Narrow-leaved Ironbark	165	160	230	17	5	3	2	Regular	-	-	-	-	-	Typical	-	-	-	-	Typical	-	-	-	-	-	-	Retain	
3414	Acacia dissparrima	Hickory Wattle	150		150	7	4	2	1	Regular	-	-	-	-	-	Typical	-	-	-	-	Typical	-	-	-	-	-	-	Retain	
3415	Lophostemon suaveolens	Swamp Box	420		420	12	7	5	2	Regular	-	-	-	-	-	Typical	-	-	-	-	Typical	-	-	-	-	-	-	Retain	
3416	Casuarina cunninghamiana	River Sheoak	220		220	12	5	3	2	Regular	-	-	-	-	-	Typical	-	-	-	-	Typical	-	-	-	-	-	-	Retain	
3417	Lophostemon suaveolens	Swamp Box	230		230	13	5	3	2	Regular	-	-	-	-	-	Typical	-	-	-	-	Typical	-	-	-	-	-	-	Retain	
3418	Eucalyptus crebra	Narrow-leaved Ironbark	125		125	11	4	2	1	Regular	-	-	-	-	-	Typical	-	-	-	-	Typical	-	-	-	-	-	-	Retain	
3419	Eucalyptus tereticornis	Forest Red Gum	585		585	26	12	7	3	Regular	-	-	-	-	-	Typical	-	-	-	-	Typical	-	-	-	-	-	-	Retain	
3420	Lophostemon suaveolens	Swamp Box	320		320	13	7	4	2	Regular	-	-	-	-	-	Typical	-	-	-	-	Typical	-	-	-	-	-	-	Retain	
3421	Lophostemon suaveolens	Swamp Box	220		220	12	5	3	2	Regular	-	-	-	-	-	Typical	-	-	-	-	Typical	-	-	-	-	-	-	Retain	
3422	Eucalyptus crebra	Narrow-leaved Ironbark	185		185	17	4	2	2	Regular	-	-	-	-	-	Typical	-	-	-	-	Typical	-	-	-	-	-	-	Retain	
3423	Melaleuca viminialis	Weeping Bottlebrush	220		220	9	6	3	2	Regular	-	Thinning	Die-back	-	-	Poor	-	-	-	-	Typical	-	-	-	-	-	-	Retain	
3424	Casuarina cunninghamiana	River Sheoak	310		310	19	8	4	2	Regular	-	-	-	-	-	Typical	-	-	-	-	Typical	-	-	-	-	-	-	Retain	
3425	Melaleuca viminialis	Weeping Bottlebrush	350		350	9	7	4	2	Regular	-	-	-	-	-	Typical	-	-	-	-	Typical	-	-	-	-	-	-	Retain	
3426	Melaleuca viminialis	Weeping Bottlebrush	200	145	247	8	6	3	2	Regular	-	-	-	-	-	Typical	-	-	-	-	Typical	-	-	-	-	-	-	Retain	
3427	Melaleuca viminialis	Weeping Bottlebrush	170		170	7	4	2	2	Regular	-	-	-	-	-	Typical	-	-	-	-	Typical	-	-	-	-	-	-	Retain	
3428	Melaleuca viminialis	Weeping Bottlebrush	110	65	128	5	4	2	1	Regular	-	-	-	-	-	Typical	-	-	-	-	Typical	-	-	-	-	-	-	Retain	
3429	Acacia dissparrima	Hickory Wattle	130		130	8	4	2	1	Regular	-	-	-	-	-	Typical	-	-	-	-	Typical	-	-	-	-	-	-	Retain	
3430	Acacia dissparrima	Hickory Wattle	120		120	8	3	2	1	Regular	-	-	-	-	-	Typical	-	-	-	-	Typical	-	-	-	-	-	-	Retain	
3431	Lophostemon suaveolens	Swamp Box	125	105, 70	178	6	3	2	2	Regular	-	-	-	-	-	Typical	-	-	-	-	Typical	-	-	-	-	-	-	Retain	
3432	Lophostemon suaveolens	Swamp Box	170		170	9	4	2	2	Regular	-	-	-	-	-	Typical	-	-	-	-	Typical	-	-	-	-	-	-	Retain	
3433	Acacia dissparrima	Hickory Wattle	100	90, 70	152	9	5	2	1	Regular	-	-	-	-	-	Typical	-	-	-	-	Typical	-	-	-	-	-	-	Retain	
3434	Corymbia tessellaris	Moreton Bay Ash	230		230	17	6	3	2	Regular	-	-	-	-	-	Typical	-	-	-	-	Typical	-	-	-	-	-	-	Retain	
3435	Lophostemon suaveolens	Swamp Box	340		340	17	9	4	2	Regular	-	-	-	-	-	Typical	-	-	-	-	Typical	-	-	-	-	-	-	Retain	
3436	Lophostemon suaveolens	Swamp Box	155		155	10	3	2	2	Regular	-	-	-	-	-	Typical	-	-	-	-	Typical	-	-	-	-	-	-	Retain	
3437	Eucalyptus crebra	Narrow-leaved Ironbark	310		310	18	7	4	2	Regular	-	-	-	-	-	Typical	-	-	-	-	Typical	-	-	-	-	-	-	Retain	
3438	Lophostemon suaveolens	Swamp Box	460		460	17	9	6	2	Regular	-	-	-	-	-	Typical	-	-	-	-	Typical	-	-	-	-	-	-	Retain	
3439	Lophostemon suaveolens	Swamp Box	125		125	10	3	2	1	Regular	-	-	-	-	-	Typical	-	-	-	-	Typical	-	-	-	-	-	-	Retain	
3440	Lophostemon suaveolens	Swamp Box	120		120	8	3	2	1	Regular	-	-	-	-	-	Typical	-	-	-	-	Typical	-	-	-	-	-	-	Retain	
3441	Lophostemon suaveolens	Swamp Box	125		125	9	3	2	1	Regular	-	-	-	-	-	Typical	-	-	-	-	Typical	-	-	-	-	-	-	Retain	
3442	Lophostemon suaveolens	Swamp Box	150		150	11	4	2	1	Regular	-	-	-	-	-	Typical	-	-	-	-	Typical	-	-	-	-	-	-	Retain	
3443	Lophostemon suaveolens	Swamp Box	205		205	12	4	2	2	Regular	-	-	-	-	-	Typical	-	-	-	-	Typical	-	-	-	-	-	-	Retain	
3444	Acacia dissparrima	Hickory Wattle	155		155	8	2	2	2	Regular	-	Thinning	Die-back	Epicormic	-	Poor	-	-	-	-	Typical	-	-	-	-	-	-	Retain	
3445	Casuarina cunninghamiana	River Sheoak	300		300	17	9	4	2	Regular	-	-	-	-	-	Typical	Minor	-	-	-	Typical	-	-	-	-	-	-	Retain	
3446	Eucalyptus tereticornis	Forest Red Gum	120		120	11	3	2	1	Regular	-	-	-	-	-	Typical	-	-	-	-	Typical	-	-	-	-	-	-	Retain	
3447	Acacia concurrens	Black Wattle	145		145	12	5	2	1	Regular	-	-	-	-	-	Typical	Minor	-	-	-	Typical	-	-	-	-	-	-	Retain	
3448	Casuarina cunninghamiana	River Sheoak	220		220	17	6	3	2	Regular	-	-	-	-	-	Typical	-	-	-	-	Typical	-	-	-	-	-	-	Retain	
3449	Eucalyptus tereticornis	Forest Red Gum	120		120	14	2	2	1	Regular	-	-	-	-	-	Typical	-	-	-	-	Typical	-	-	-	-	-	-	Retain	
3450	Casuarina cunninghamiana	River Sheoak	365		365	17	10	4	2	Regular	-	-	-	-	-	Typical	-	-	-	-	Typical	-	-	-	-	-	-	Retain	
3451	Alphitonia excelsa	Soap Tree	110		110	9	3	2	1	Regular	-	-	-	-	-	Typical	-	-	-	-	Typical	-	-	-	-	-	-	Retain	
3452	Acacia dissparrima	Hickory Wattle	160		160	10	3	2	2	Regular	-	-	-	-	-	Typical	-	-	-	-	Typical	-	-	-	-	-	-	Retain	
3453	Corymbia tessellaris	Moreton Bay Ash	320		320	23	9	4	2	Regular	-	-	-	-	-	Typical	-	-	-	-	Typical	-	-	-	-	-	-	Retain	
3454	Acacia dissparrima	Hickory Wattle	165		165	10	5	2	2	Regular	-	-	-	-	-	Typical	-	-	-	-	Typical	-	-	-	-	-	-	Retain	
3455	Lophostemon suaveolens	Swamp Box	130		130	9	2	2	1	Regular	-	-	-	-	-	Typical	-	-	-	-	Typical	-	-	-	-	-	-	Retain	
3456	Angophora subvelutina	Broad-leaved Apple	540		540	21	12	6	3	Regular	-	-	-	-	-	Typical	-	-	-	-	Typical	-	-	-	-	-	-	Retain	
3457	Acacia dissparrima	Hickory Wattle	135		135	10	3	2	1	Regular	-	-	-	-	-	Typical	-	-	-	-	Typical	-	-	-	-	-	-	Retain	
3458	Lophostemon suaveolens	Swamp Box	320		320	14	7	4	2	Regular	-	-	-	-	-	Typical	-	-	-	-	Typical	-	-	-	-	-	-	Retain	
3459	Acacia concurrens	Black Wattle	145		145	9	4	2	1	Regular	-	-	-	-	-	Typical	-	-	-	-	Typical	-	-	-	-	-	-	Retain	
3460	Lophostemon suaveolens	Swamp Box	220		220	12	5	3	2	Regular	-	-	-	-	-	Typical	-	-	-	-	Typical	-	-	-	-	-	-	Retain	
3461	Corymbia intermedia	Pink Bloodwood	230		230	15	5	3	2	Regular	-	-	-	-	-	Typical	-	-	-	-	Typical	-	-	-	-	-	-	Retain	
3462	Lophostemon suaveolens	Swamp Box	120		120	7	3	2	1	Regular	-	-	-	-	-	Typical	-	-	-	-	Typical	-	-	-	-	-	-	Retain	
3463	Angophora subvelutina	Broad-leaved Apple	420	380	566	22	14	7	3	Regular	-	-	-	-	-	Typical	-	-	-	-	Typical	-	-	-	-	-	-	Retain	
3464	Corymbia intermedia	Pink Bloodwood	280		280	21	7	3	2	Regular	-	-	-	-	-	Typical	-	-	-	-	Typical	-	-	-	-	-	-	Retain	
3465	Alphitonia excelsa	Soap Tree	125		125	9	4	2	1	Regular	-	-	-	-	-	Typical	-	-	-	-	Typical	-	-	-	-	-	-	Retain	
3466	Eucalyptus crebra	Narrow-leaved Ironbark																											

Tree ID	Specimen Details								Canopy Condition Details								Trunk Condition Details					Fauna Details and Habitat Value							
	Botanical Name	Common Name	Trunk DBH (mm)	Additional Trunks DBH (mm)	Total DBH (mm) [AS 4970-2009]	Height (m)	Spread (m)	Tree Protection Zone (m)	Structural Root Zone (m)	Canopy Form	Spreading	Thinning	Die-Back	Epicormic Growth	Lopped	Canopy Health	Leaning	Vines	Trunk Damage	Fire Damage	Trunk Health	Scats	Scratches	Hollows	Nest	Termite Nest	Habitat Value	Retention	
3469	Corymbia tessellaris	Moreton Bay Ash	220		220	16	5	3	2	Regular	-	-	-	-	-	Typical	-	-	-	-	Typical	-	-	-	-	-	-	Retain	
3470	Acacia disparrima	Hickory Wattle	165	145, 120	250	10	6	3	2	Regular	-	-	-	-	-	Typical	-	-	-	-	Typical	-	-	-	-	-	-	Retain	
3471	Acacia disparrima	Hickory Wattle	185		185	7	4	2	2	Regular	-	-	-	-	-	Typical	-	-	-	-	Typical	-	-	-	-	-	-	Retain	
3472	Acacia disparrima	Hickory Wattle	165	125, 100	230	8	4	3	2	Regular	-	-	-	-	-	Typical	-	-	-	-	Typical	-	-	-	-	-	-	Retain	
3473	Lophostemon suaveolens	Swamp Box	220		220	12	5	3	2	Regular	-	-	-	-	-	Typical	-	-	-	-	Typical	-	-	-	-	-	-	Retain	
3474	Alphitonia excelsa	Soap Tree	145		145	7	3	2	1	Regular	-	-	-	-	-	Typical	-	-	-	-	Typical	-	-	-	-	-	-	Retain	
3475	Eucalyptus tereticornis	Forest Red Gum	135		135	11	3	2	1	Regular	-	-	-	-	-	Typical	-	-	-	-	Typical	-	-	-	-	-	-	Retain	
3476	Corymbia intermedia	Pink Bloodwood	330		330	21	7	4	2	Regular	-	-	-	-	-	Typical	-	-	-	-	Typical	-	-	-	-	-	-	Retain	
3477	Corymbia tessellaris	Moreton Bay Ash	190		190	13	3	2	2	Regular	-	-	-	-	-	Typical	-	-	-	-	Typical	-	-	-	-	-	-	Retain	
3478	Acacia concurrens	Black Wattle	125		125	7	4	2	1	Regular	-	-	-	-	-	Typical	-	-	-	-	Typical	-	-	-	-	-	-	Retain	
3479	Acacia disparrima	Hickory Wattle	145		145	7	4	2	1	Regular	-	-	-	-	-	Typical	Minor	-	-	-	Typical	-	-	-	-	-	-	Retain	
3480	Lophostemon suaveolens	Swamp Box	120		120	7	3	2	1	Regular	-	-	-	-	-	Typical	-	-	-	-	Typical	-	-	-	-	-	-	Retain	
3481	Eucalyptus tereticornis	Forest Red Gum	420		420	23	9	5	2	Regular	-	-	-	-	-	Typical	-	-	-	-	Typical	-	-	-	-	-	-	Retain	
3482	Lophostemon suaveolens	Swamp Box	230		230	13	7	3	2	Regular	-	-	-	-	-	Typical	-	-	-	-	Typical	-	-	-	-	-	-	Retain	
3483	Lophostemon suaveolens	Swamp Box	230		230	16	5	3	2	Regular	-	-	-	-	-	Typical	-	-	-	-	Typical	-	-	-	-	-	-	Retain	
3484	Lophostemon suaveolens	Swamp Box	220		220	16	5	3	2	Regular	-	-	-	-	-	Typical	-	-	-	-	Typical	-	-	-	-	-	-	Retain	
3485	Corymbia tessellaris	Moreton Bay Ash	245		245	19	6	3	2	Regular	-	-	-	-	-	Typical	-	-	-	-	Typical	-	-	-	-	-	-	Retain	
3486	Corymbia citriodora	Spotted Gum	300	200	361	17	11	4	2	One-sided	-	-	-	-	-	Typical	Minor	-	-	-	Typical	-	-	-	-	-	-	Retain	
3487	Corymbia citriodora	Spotted Gum	300	200	361	17	11	4	2	One-sided	-	-	-	-	-	Typical	Minor	-	-	-	Typical	-	-	-	-	-	-	Retain	
3488	Acacia disparrima	Hickory Wattle	100	80	128	8	5	2	1	Regular	-	-	-	-	-	Typical	-	-	-	-	Typical	-	-	-	-	-	-	Retain	
3489	Eucalyptus crebra	Narrow-leaved Ironbark	260		260	16	7	3	2	Regular	-	-	-	-	-	Typical	-	-	-	-	Typical	-	-	-	-	-	-	Retain	
3496	Lophostemon suaveolens	Swamp Box	280		280	17	4	3	2	Regular	-	-	-	-	-	Typical	-	-	-	-	Typical	-	-	-	-	-	-	Retain	
3497	Eucalyptus tereticornis	Forest Red Gum	460		460	18	7	6	2	Regular	-	Thinning	Die-back	-	-	Typical	-	-	-	-	Typical	-	-	-	-	-	-	Retain	
3498	Melaleuca viminalis	Weeping Bottlebrush	200		200	11	6	2	2	Regular	-	-	-	-	-	Typical	-	-	-	-	Typical	-	-	-	-	-	-	Remove	
3499	Melaleuca viminalis	Weeping Bottlebrush	200		200	10	5	2	2	Regular	-	-	-	-	-	Typical	Major	-	-	-	Typical	-	-	-	-	-	-	Remove	
3500	Allocastraria littoralis	Black She Oak	260	230	347	14	6	4	2	Irregular	-	-	-	-	-	Typical	Major	-	-	-	Typical	-	-	-	-	-	-	Remove	
3501	Melaleuca viminalis	Weeping Bottlebrush	220		220	5	2	3	2	Regular	-	-	-	-	-	Typical	Major	-	-	-	Typical	-	-	-	-	-	-	Remove	
3502	Allocastraria littoralis	Black She Oak	280	280	396	19	7	5	2	Regular	-	-	-	-	-	Typical	-	-	-	-	Typical	-	-	-	-	-	-	Remove	
3503	Allocastraria littoralis	Black She Oak	240	90, 110, 90, 200	355	20	5	4	2	Regular	-	-	-	-	-	Typical	-	-	-	-	Typical	-	-	-	-	-	-	Remove	
3504	Allocastraria littoralis	Black She Oak	210		210	23	6	3	2	Regular	-	-	-	-	-	Typical	-	-	-	-	Typical	-	-	-	-	-	-	Remove	
3505	Allocastraria littoralis	Black She Oak	730		730	23	8	9	3	Regular	-	-	-	-	-	Typical	-	-	-	-	Typical	-	-	-	-	-	-	Remove	
3506	Lophostemon suaveolens	Swamp Box	310		310	12	4	4	2	Regular	-	-	-	-	-	Typical	-	-	-	-	Typical	-	-	-	-	-	-	Remove	
3507	Allocastraria littoralis	Black She Oak	470		470	24	10	6	2	Regular	-	-	-	-	-	Typical	-	-	-	-	Typical	-	-	-	-	-	-	Remove	
3508	Lophostemon suaveolens	Swamp Box	270		270	10	4	3	2	Regular	-	-	-	-	-	Typical	-	-	-	-	Typical	-	-	-	-	-	-	Remove	
3509	Allocastraria littoralis	Black She Oak	240	290	376	20	10	5	2	Irregular	-	-	-	-	-	Typical	Major	-	-	-	Typical	-	-	-	-	-	-	Remove	
3510	Melaleuca viminalis	Weeping Bottlebrush	210	200	290	10	8	3	2	Irregular	-	-	-	-	-	Typical	Major	-	-	-	Typical	-	-	-	-	-	-	Remove	
3511	Eucalyptus tereticornis	Forest Red Gum	480		480	27	9	6	2	Regular	-	-	-	-	-	Typical	-	-	-	-	Typical	-	-	-	-	-	-	Remove	
3512	Corymbia tessellaris	Moreton Bay Ash	460		460	25	9	6	2	Regular	-	Thinning	Die-back	-	-	Poor	-	-	-	-	Typical	-	-	-	-	-	-	Remove	
3513	Corymbia tessellaris	Moreton Bay Ash	540		540	26	12	6	3	Regular	-	-	-	-	-	Typical	-	-	-	-	Typical	-	-	-	-	-	-	Remove	
3514	Casuarina cunninghamiana	River Sheoak	470		470	23	6	6	2	Regular	-	-	-	-	-	Typical	-	-	-	-	Typical	-	-	-	-	-	-	Remove	
3515	Casuarina cunninghamiana	River Sheoak	440		440	18	6	5	2	Regular	-	-	-	-	-	Typical	-	-	-	-	Typical	-	-	-	-	-	-	Remove	
3516	Eucalyptus tereticornis	Forest Red Gum	690		690	32	12	8	3	Regular	-	-	-	-	-	Typical	-	-	-	-	Typical	-	-	-	-	-	-	Remove	
3517	Casuarina cunninghamiana	River Sheoak	480		480	23	9	6	2	Regular	-	-	-	-	-	Typical	-	-	-	-	Typical	-	-	-	-	-	-	Remove	
3518	Angophora subvelutina	Broad-leaved Apple	630		630	27	12	8	3	Regular	-	-	-	-	-	Typical	-	-	-	-	Typical	-	-	-	-	-	-	Remove	
3519	Angophora subvelutina	Broad-leaved Apple	660		660	26	12	8	3	Regular	-	-	-	-	-	Typical	-	-	-	-	Typical	-	-	-	-	-	-	Remove	
3520	Eucalyptus tereticornis	Forest Red Gum	590		590	26	11	7	3	Regular	-	-	-	-	-	Typical	-	-	-	-	Typical	-	-	-	-	-	-	Remove	
3521	Angophora subvelutina	Broad-leaved Apple	750		750	28	14	9	3	Regular	-	-	-	-	-	Typical	-	-	-	-	Typical	-	-	-	-	-	-	Remove	
3522	Angophora subvelutina	Broad-leaved Apple	390		390	23	8	5	2	Regular	-	-	-	-	-	Typical	-	-	-	-	Typical	-	-	-	-	-	-	Remove	
3523	Eucalyptus tereticornis	Forest Red Gum	490		490	25	12	6	2	Regular	-	-	-	-	-	Typical	-	-	-	-	Typical	-	-	-	-	-	-	Remove	
3524	DEAD/STAG		1250		1250	12	1	15	4	Regular	-	-	-	-	-	Typical	-	-	-	-	Typical	-	-	Large	-	-	High	Remove	
3525	Eucalyptus tereticornis	Forest Red Gum	370		370	22	8	4	2	Regular	-	-	-	-	-	Typical	-	-	-	-	Typical	-	-	-	-	-	-	Remove	
3526	Angophora subvelutina	Broad-leaved Apple	300		300	19	5	4	2	Regular	-	-	-	-	-	Typical	-	-	-	-	Typical	-	-	-	-	-	-	Retain	
3527	Corymbia intermedia	Pink Bloodwood	450		450	21	10	5	2	Regular	-	-	-	-	-	Typical	-	-	-	-	Typical	-	-	-	-	-	-	Retain	
3528	Corymbia intermedia	Pink Bloodwood	560		560	20	8	7	3	Regular	-	-	-	-	-	Typical	-	-	-	-	Typical	-	-	-	-	-	-	Retain	
3529	Eucalyptus tereticornis	Forest Red Gum	650		650	27	14	8	3	Regular	-	-	-	-	-	Typical	-	-	-	-	Typical	-	-	-	-	-	-	Retain	
3530	Eucalyptus tereticornis	Forest Red Gum	510		510	23	9	6	2	Regular	-	-	-	-	-	Typical	-	-	-	-	Typical	-	-	-	-	-	-	Retain	
3531	Corymbia tessellaris	Moreton Bay Ash	210		210	17	4	3	2	Regular	-	-	-	-	-	Typical	-	-	-	-	Typical	-	-	-	-	-	-	Retain	
3532	Angophora subvelutina	Broad-leaved Apple	280		280	17	8	3	2	Regular	-	-	-	-	-	Typical	-	-	-	-	Typical	-	-	-	-	-	-	Retain	
3533	Angophora subvelutina	Broad-leaved Apple	480		480	25	14	6	2	Regular	-	-	-	-	-	Typical	-	-	-	-	Typical	-	-	-	-	-	-	Retain	
3534	Casuarina cunninghamiana	River Sheoak	210		210	18	4	3	2	Regular	-	-	-	-	-	Typical	-	-	-	-	Typical	-	-	-	-	-	-	Retain	
3535	Lophostemon suaveolens	Swamp Box	310		310	14	6	4	2	Regular	-	-	-	-	-	Typical	-	-	-	-	Typical	-	-	-	-	-	-	Remove	
3536	Lophostemon suaveolens	Swamp Box	220		220	8	2	3	2	Regular	-	-	-	-	-	Typical	-	-	-	-	Typical	-	-	-	-	-	-	Retain	
3537	Corymbia citriodora	Spotted Gum	310		310	19	2	4	2	Regular	-	Thinning	Die-back	-	-	Typical	-	-	-	-	Typical	-	-	-	-	-	-	Retain	
3538	Casuarina cunninghamiana	River Sheoak	280		280	17	5	3	2	Regular	-	-	-	-	-	Typical	-	-	-	-	Typical	-	-	-	-	-	-	Retain	
3539	Casuarina cunninghamiana	River Sheoak	280		280	14	5	3	2	Regular	-	-	-	-	-	Typical	-	-	-	-	Typical	-	-	-	-	-</			

Tree ID	Specimen Details								Canopy Condition Details								Trunk Condition Details					Fauna Details and Habitat Value						
	Botanical Name	Common Name	Trunk DBH (mm)	Additional Trunks DBH (mm)	Total DBH (mm) [AS 4970-2009]	Height (m)	Spread (m)	Tree Protection Zone (m)	Structural Root Zone (m)	Canopy Form	Spreading	Thinning	Die-Back	Epicormic Growth	Lopped	Canopy Health	Leaning	Vines	Trunk Damage	Fire Damage	Trunk Health	Scats	Scratches	Hollows	Nest	Termite Nest	Habitat Value	Retention
3543	Acacia concurrens	Black Wattle	170		170	9	4	2	2	Regular	-	-	-	-	-	Typical	-	-	-	-	Typical	-	-	-	-	-	-	Remove
3544	Eucalyptus tereticornis	Forest Red Gum	640		640	20	8	8	3	Regular	-	-	-	-	-	Typical	-	-	-	-	Typical	-	-	-	-	-	-	Remove
3545	Eucalyptus tereticornis	Forest Red Gum	530		530	21	9	6	3	Regular	-	-	-	-	-	Typical	-	-	-	-	Typical	-	-	-	-	-	-	Retain
3546	Lophostemon confertus	Brush Box	220	200	297	13	7	4	2	Regular	-	-	-	-	-	Typical	-	-	-	-	Typical	-	-	-	-	-	-	Retain
3547	Eucalyptus tereticornis	Forest Red Gum	380		380	19	5	5	2	Regular	-	-	-	-	-	Typical	-	-	-	-	Typical	-	-	-	-	-	-	Retain
3548	Eucalyptus tereticornis	Forest Red Gum	500		500	21	10	6	2	Regular	-	-	-	-	-	Typical	-	-	-	-	Typical	-	-	-	-	-	-	Retain
3549	Lophostemon confertus	Brush Box	230		230	13	5	3	2	Regular	-	-	-	-	-	Typical	-	-	-	-	Typical	-	-	-	-	-	-	Retain
3550	Corymbia tessellaris	Moreton Bay Ash	180		180	16	5	2	2	Regular	-	-	-	-	-	Typical	-	-	-	-	Typical	-	-	-	-	-	-	Retain
3551	Corymbia tessellaris	Moreton Bay Ash	190		190	16	4	2	2	Regular	-	-	-	-	-	Typical	-	-	-	-	Typical	-	-	-	-	-	-	Retain
3552	Corymbia tessellaris	Moreton Bay Ash	180		180	14	4	2	2	Regular	-	-	-	-	-	Typical	-	-	-	-	Typical	-	-	-	-	-	-	Retain
3553	Lophostemon suaveolens	Swamp Box	100		100	7	2	2	1	Regular	-	-	-	-	-	Typical	-	-	-	-	Typical	-	-	-	-	-	-	Retain
3554	Acacia dispartima	Hickory Wattle	130	100	164	7	2	2	2	Regular	-	-	-	-	-	Typical	-	-	-	-	Typical	-	-	-	-	-	-	Retain
3555	Acacia dispartima	Hickory Wattle	190		190	10	3	2	2	Regular	-	-	-	-	-	Typical	-	-	-	-	Typical	-	-	-	-	-	-	Retain
3556	Lophostemon suaveolens	Swamp Box	100		100	8	2	2	1	Regular	-	-	-	-	-	Typical	-	-	-	-	Typical	-	-	-	-	-	-	Retain
3557	Angophora subvelutina	Broad-leaved Apple	230		230	17	5	3	2	Regular	-	-	-	-	-	Typical	-	-	-	-	Typical	-	-	-	-	-	-	Retain
3558	Lophostemon suaveolens	Swamp Box	140		140	7	3	2	1	Regular	-	-	-	-	-	Typical	-	-	-	-	Typical	-	-	-	-	-	-	Retain
3559	Lophostemon suaveolens	Swamp Box	120		120	9	2	2	1	Regular	-	-	-	-	-	Typical	-	-	-	-	Typical	-	-	-	-	-	-	Retain
3560	Corymbia tessellaris	Moreton Bay Ash	150		150	16	6	2	1	Regular	-	-	-	-	-	Typical	-	-	-	-	Typical	-	-	-	-	-	-	Retain
3561	Lophostemon suaveolens	Swamp Box	160		160	15	3	2	2	Regular	-	-	-	-	-	Typical	-	-	-	-	Typical	-	-	-	-	-	-	Retain
3562	Lophostemon suaveolens	Swamp Box	160		160	14	2	2	2	Regular	-	-	-	-	-	Typical	-	-	-	-	Typical	-	-	-	-	-	-	Retain
3563	Lophostemon suaveolens	Swamp Box	100		100	7	2	2	1	Regular	-	-	-	-	-	Typical	-	-	-	-	Typical	-	-	-	-	Termite nest	-	Retain
3564	Acacia dispartima	Hickory Wattle	120	70	139	8	4	2	1	Regular	-	-	-	-	-	Typical	-	-	-	-	Typical	-	-	-	-	-	-	Retain
3565	Acacia dispartima	Hickory Wattle	80	80, 80, 80	160	7	4	2	2	Regular	-	-	-	-	-	Typical	-	-	-	-	Typical	-	-	-	-	-	-	Retain
3566	Lophostemon suaveolens	Swamp Box	170		170	14	5	2	2	Regular	-	-	-	-	-	Typical	-	-	-	-	Typical	-	-	-	-	-	-	Retain
3570	Corymbia citriodora	Spotted Gum	500		500	20	8	6	2	Regular	-	-	-	-	-	Typical	-	-	-	-	Typical	-	-	-	-	-	-	Remove
3571	Corymbia citriodora	Spotted Gum	210		210	12	5	3	2	Regular	-	-	-	-	-	Typical	-	-	-	-	Typical	-	-	-	-	-	-	Remove
3572	Corymbia citriodora	Spotted Gum	340		340	22	9	4	2	Regular	-	-	-	-	-	Typical	-	-	-	-	Typical	-	-	-	-	-	-	Remove
3573	Corymbia citriodora	Spotted Gum	170		170	15	4	2	2	Regular	-	-	-	-	-	Typical	-	-	-	-	Typical	-	-	-	-	-	-	Remove
3574	Corymbia citriodora	Spotted Gum	230		230	15	5	3	2	Regular	-	-	-	-	-	Typical	-	-	-	-	Typical	-	-	-	-	-	-	Remove
3575	Corymbia citriodora	Spotted Gum	220	140	261	16	7	3	2	Regular	-	-	-	-	-	Typical	-	-	-	-	Typical	-	-	-	-	-	-	Remove
3576	Corymbia citriodora	Spotted Gum	130		130	11	4	2	1	Regular	-	-	-	-	-	Typical	-	-	-	-	Typical	-	-	-	-	-	-	Remove
3577	Corymbia citriodora	Spotted Gum	250		250	17	8	3	2	Regular	-	-	-	-	-	Typical	-	-	-	-	Typical	-	-	-	-	-	-	Remove
3578	Corymbia citriodora	Spotted Gum	130		130	10	3	2	1	Regular	-	-	-	-	-	Typical	-	-	-	-	Typical	-	-	-	-	-	-	Remove
3579	Corymbia tessellaris	Moreton Bay Ash	110		110	8	3	2	1	Regular	-	-	-	-	-	Typical	-	-	-	-	Typical	-	-	-	-	-	-	Remove
3580	Corymbia citriodora	Spotted Gum	200		200	16	7	2	2	Regular	-	-	-	-	-	Typical	-	-	-	-	Typical	-	-	-	-	-	-	Remove
3581	Corymbia citriodora	Spotted Gum	270		270	19	9	3	2	Regular	-	-	-	-	-	Typical	-	-	-	-	Typical	-	-	-	-	-	-	Remove
3582	Corymbia tessellaris	Moreton Bay Ash	160	160	226	15	6	3	2	Regular	-	-	-	-	-	Typical	-	-	-	-	Typical	-	-	-	-	-	-	Remove
3583	Eucalyptus tereticornis	Forest Red Gum	220		220	17	6	3	2	Regular	-	-	-	-	-	Typical	-	-	-	-	Typical	-	-	-	-	-	-	Remove
3584	Eucalyptus tereticornis	Forest Red Gum	160		160	13	5	2	2	Regular	-	-	-	-	-	Typical	-	-	-	-	Typical	-	-	-	-	-	-	Remove
3585	Corymbia tessellaris	Moreton Bay Ash	170		170	14	5	2	2	Regular	-	-	-	-	-	Typical	-	-	-	-	Typical	-	-	-	-	-	-	Remove
3586	Corymbia citriodora	Spotted Gum	290		290	19	9	3	2	Regular	-	-	-	-	-	Typical	-	-	-	-	Typical	-	-	-	-	-	-	Remove
3587	Eucalyptus crebra	Narrow-leaved Ironbark	200		200	15	6	2	2	Regular	-	-	-	-	-	Typical	-	-	-	-	Typical	-	-	-	-	-	-	Remove
3588	Corymbia citriodora	Spotted Gum	150	140, 110, 110, 100	276	15	7	3	2	Regular	-	-	-	-	-	Typical	-	-	-	-	Typical	-	-	-	-	-	-	Remove
3589	Corymbia tessellaris	Moreton Bay Ash	230		230	18	7	3	2	Regular	-	-	-	-	-	Typical	-	-	-	-	Typical	-	-	-	-	-	-	Remove
3590	Corymbia citriodora	Spotted Gum	320		320	19	9	4	2	Regular	-	-	-	-	-	Typical	-	-	-	-	Typical	-	-	-	-	-	-	Remove
3591	Corymbia citriodora	Spotted Gum	230		230	18	9	3	2	Regular	-	-	-	-	-	Typical	-	-	-	-	Typical	-	-	-	-	-	-	Remove
3592	Corymbia citriodora	Spotted Gum	570	220	611	20	11	7	3	Regular	-	-	-	-	-	Typical	-	-	-	-	Typical	-	-	-	-	-	-	Remove
3593	Eucalyptus crebra	Narrow-leaved Ironbark	270		270	16	6	3	2	Regular	-	-	-	-	-	Typical	-	-	-	-	Typical	-	-	-	-	-	-	Remove
3594	Corymbia citriodora	Spotted Gum	120		120	10	3	2	1	Regular	-	-	-	-	-	Typical	-	-	-	-	Typical	-	-	-	-	-	-	Remove
3595	Corymbia citriodora	Spotted Gum	270		270	18	7	3	2	Regular	-	-	-	-	-	Typical	-	-	-	-	Typical	-	-	-	-	-	-	Remove
3596	Corymbia citriodora	Spotted Gum	230		230	16	4	3	2	Regular	-	-	-	-	-	Typical	-	-	-	-	Typical	-	-	-	-	-	-	Remove
3597	Corymbia citriodora	Spotted Gum	220		220	18	8	3	2	Regular	-	-	-	-	-	Typical	-	-	-	-	Typical	-	-	-	-	-	-	Remove
3598	Corymbia citriodora	Spotted Gum	110		110	11	3	2	1	Regular	-	-	-	-	-	Typical	-	-	-	-	Typical	-	-	-	-	-	-	Remove
3599	Corymbia citriodora	Spotted Gum	230		230	16	7	3	2	Regular	-	-	-	-	-	Typical	-	-	-	-	Typical	-	-	-	-	-	-	Remove
3600	Corymbia citriodora	Spotted Gum	330		330	19	8	4	2	Regular	-	-	-	-	-	Typical	-	-	-	-	Typical	-	-	-	-	-	-	Remove
3601	Corymbia citriodora	Spotted Gum	160		160	14	3	2	2	Regular	-	-	-	-	-	Typical	-	-	-	-	Typical	-	-	-	-	-	-	Remove
3602	Corymbia citriodora	Spotted Gum	110		110	7	2	2	1	Regular	-	Thinning	-	-	-	Poor	-	-	-	-	Typical	-	-	-	-	-	-	Remove
3603	Corymbia citriodora	Spotted Gum	250		250	16	6	3	2	Regular	-	-	-	-	-	Typical	-	-	-	-	Typical	-	-	-	-	-	-	Remove
3604	Corymbia citriodora	Spotted Gum	120		120	10	3	2	1	Regular	-	-	-	-	-	Typical	-	-	-	-	Typical	-	-	-	-	-	-	Remove
3605	Corymbia citriodora	Spotted Gum	140		140	13	4	2	1	Regular	-	-	-	-	-	Typical	-	-	-	-	Typical	-	-	-	-	-	-	Remove
3606	Corymbia citriodora	Spotted Gum	300		300	19	8	4	2	Regular	-	-	-	-	-	Typical	-	-	-	-	Typical	-	-	-	-	-	-	Remove
3607	Corymbia citriodora	Spotted Gum	150		150	10	3	2	1	Regular	-	-	-	-	-	Typical	-	-	-	-	Typical	-	-	-	-	-	-	Remove
3608	Corymbia citriodora	Spotted Gum	200		200	11	4	2	2	Regular	-	-	-	-	-	Typical	-	-	-	-	Typical	-	-	-	-	-	-	Remove
3609	Corymbia citriodora	Spotted Gum	330		330	20	8	4	2	Regular	-	-	-	-	-	Typical	-	-	-	-	Typical	-	-	-	-	-	-	Remove
3610	Corymbia citriodora	Spotted Gum	250		250	20	6	3	2	Regular	-	-	-	-	-	Typical	-	-	-	-	Typical	-	-	-	-	-	-	Remove
3611	Corymbia citriodora	Spotted Gum	180		180																							

Tree ID	Specimen Details								Canopy Condition Details								Trunk Condition Details					Fauna Details and Habitat Value							Retention
	Botanical Name	Common Name	Trunk DBH (mm)	Additional Trunks DBH (mm)	Total DBH (mm) [AS 4970-2009]	Height (m)	Spread (m)	Tree Protection Zone (m)	Structural Root Zone (m)	Canopy Form	Spreading	Thinning	Die-Back	Epicormic Growth	Lopped	Canopy Health	Leaning	Vines	Trunk Damage	Fire Damage	Trunk Health	Scats	Scratches	Hollows	Nest	Termite Nest	Habitat Value		
3614	Lophostemon suaveolens	Swamp Box	140		140	7	2	2	1	Regular	-	-	-	-	-	Typical	-	-	-	-	Typical	-	-	-	-	-	-	Remove	
3615	Corymbia citriodora	Spotted Gum	100		100	7	2	2	1	Regular	-	-	-	-	-	Typical	-	-	-	-	Typical	-	-	-	-	-	-	Remove	
3616	Corymbia citriodora	Spotted Gum	160		160	12	3	2	2	Regular	-	-	-	-	-	Typical	-	-	-	-	Typical	-	-	-	-	-	-	Remove	
3617	Eucalyptus crebra	Narrow-leaved Ironbark	130		130	8	2	2	1	Regular	-	-	-	-	-	Typical	-	-	-	-	Typical	-	-	-	-	-	-	Remove	
3618	Eucalyptus crebra	Narrow-leaved Ironbark	100		100	7	2	2	1	Regular	-	-	-	-	-	Typical	-	-	-	-	Typical	-	-	-	-	-	-	Remove	
3619	Eucalyptus crebra	Narrow-leaved Ironbark	280		280	17	7	3	2	Regular	-	-	-	-	-	Typical	-	-	-	-	Typical	-	-	-	-	-	-	Remove	
3620	Eucalyptus crebra	Narrow-leaved Ironbark	200		200	15	4	2	2	Regular	-	-	-	-	-	Typical	-	-	-	-	Typical	-	-	-	-	-	-	Remove	
3621	Corymbia citriodora	Spotted Gum	100		100	7	2	2	1	Regular	-	-	-	-	-	Typical	-	-	-	-	Typical	-	-	-	-	-	-	Remove	
3622	Corymbia citriodora	Spotted Gum	180		180	10	4	2	2	Regular	-	-	-	-	-	Typical	-	-	-	-	Typical	-	-	-	-	-	-	Remove	
3623	Corymbia citriodora	Spotted Gum	300		300	22	8	4	2	Regular	-	-	-	-	-	Typical	-	-	-	-	Typical	-	-	-	-	-	-	Remove	
3624	Corymbia citriodora	Spotted Gum	110		110	14	3	2	1	Regular	-	-	-	-	-	Typical	-	-	-	-	Typical	-	-	-	-	-	-	Remove	
3625	Alphitonia excelsa	Soap Tree	130		130	7	4	2	1	Regular	-	-	-	-	-	Typical	-	-	-	-	Typical	-	-	-	-	-	-	Remove	
3626	Corymbia citriodora	Spotted Gum	400		400	19	7	5	2	Regular	-	-	-	-	-	Typical	-	-	-	-	Typical	-	-	-	-	-	-	Remove	
3627	Corymbia citriodora	Spotted Gum	200	180	269	18	7	3	2	Regular	-	-	-	-	-	Typical	-	-	-	-	Typical	-	-	-	-	-	-	Remove	
3628	Corymbia citriodora	Spotted Gum	100		100	7	2	2	1	Regular	-	-	-	-	-	Typical	-	-	-	-	Typical	-	-	-	-	-	-	Remove	
3629	Corymbia citriodora	Spotted Gum	250		250	17	6	3	2	Regular	-	-	-	-	-	Typical	-	-	-	-	Typical	-	-	-	-	-	-	Remove	
3630	Eucalyptus tereticornis	Forest Red Gum	200		200	15	4	2	2	Regular	-	-	-	-	-	Typical	-	-	-	-	Typical	-	-	-	-	-	-	Remove	
3631	Eucalyptus tereticornis	Forest Red Gum	220		220	17	4	3	2	Regular	-	-	-	-	-	Typical	-	-	-	-	Typical	-	-	-	-	-	-	Remove	
3632	Corymbia citriodora	Spotted Gum	190		190	19	5	2	2	Regular	-	-	-	-	-	Typical	-	-	-	-	Typical	-	-	-	-	-	-	Remove	
3633	Eucalyptus tereticornis	Forest Red Gum	250		250	19	5	3	2	Regular	-	-	-	-	-	Typical	-	-	-	-	Typical	-	-	-	-	-	-	Remove	
3634	Corymbia citriodora	Spotted Gum	200		200	14	5	2	2	Regular	-	-	-	-	-	Typical	-	-	-	-	Typical	-	-	-	-	-	-	Remove	
3635	Corymbia citriodora	Spotted Gum	160		160	15	5	2	2	Regular	-	-	-	-	-	Typical	-	-	-	-	Typical	-	-	-	-	-	-	Remove	
3636	Alphitonia excelsa	Soap Tree	140		140	8	3	2	1	Regular	-	-	-	-	-	Typical	-	-	-	-	Typical	-	-	-	-	-	-	Remove	
3637	Corymbia citriodora	Spotted Gum	130		130	8	3	2	1	Regular	-	-	-	-	-	Typical	-	-	-	-	Typical	-	-	-	-	-	-	Remove	
3638	Corymbia citriodora	Spotted Gum	400		400	21	10	5	2	Regular	-	-	-	-	-	Typical	-	-	-	-	Typical	-	-	-	-	-	-	Remove	
3639	Corymbia citriodora	Spotted Gum	200		200	17	5	2	2	Regular	-	-	-	-	-	Typical	-	-	-	-	Typical	-	-	-	-	-	-	Remove	
3640	Eucalyptus crebra	Narrow-leaved Ironbark	190		190	17	5	2	2	Regular	-	-	-	-	-	Typical	-	-	-	-	Typical	-	-	-	-	-	-	Remove	
3641	Corymbia tessellaris	Moreton Bay Ash	150		150	15	4	2	1	Regular	-	-	-	-	-	Typical	-	-	-	-	Typical	-	-	-	-	-	-	Remove	
3642	Corymbia tessellaris	Moreton Bay Ash	140		140	14	2	2	1	Regular	-	-	-	-	-	Typical	-	-	-	-	Typical	-	-	-	-	-	-	Remove	
3643	Alphitonia excelsa	Soap Tree	160		160	9	3	2	2	Regular	-	-	-	-	-	Typical	-	-	-	-	Typical	-	-	-	-	-	-	Remove	
3644	Lophostemon suaveolens	Swamp Box	270		270	10	4	3	2	Regular	-	-	-	-	-	Typical	-	-	-	-	Typical	-	-	-	-	-	-	Remove	
3645	Eucalyptus tereticornis	Forest Red Gum	170	80	188	9	3	2	2	Regular	-	-	-	-	-	Typical	-	-	-	-	Typical	-	-	-	-	-	-	Remove	
3646	Acacia disparrima	Hickory Wattle	150	130	198	9	6	2	2	Regular	-	-	-	-	-	Typical	-	-	-	-	Typical	-	-	-	-	-	-	Remove	
3647	Eucalyptus tereticornis	Forest Red Gum	180		180	10	3	2	2	Regular	-	-	-	-	-	Typical	-	-	-	-	Typical	-	-	-	-	-	-	Remove	
3648	Eucalyptus crebra	Narrow-leaved Ironbark	300		300	18	10	4	2	Regular	-	-	-	-	-	Typical	-	-	-	-	Typical	-	-	-	-	-	-	Remove	
3649	Eucalyptus crebra	Narrow-leaved Ironbark	320		320	19	10	4	2	Regular	-	-	-	-	-	Typical	-	-	-	-	Typical	-	-	-	-	-	-	Remove	
3650	Eucalyptus crebra	Narrow-leaved Ironbark	190	80	206	14	4	2	2	Regular	-	-	-	-	-	Typical	-	-	-	-	Typical	-	-	-	-	-	-	Remove - Fill stockpiling	
3651	Eucalyptus tereticornis	Forest Red Gum	300		300	18	7	4	2	Regular	-	-	-	-	-	Typical	-	-	-	-	Typical	-	-	-	-	-	-	Remove - Fill stockpiling	
3652	Eucalyptus tereticornis	Forest Red Gum	270		270	17	7	3	2	Regular	-	-	-	-	-	Typical	-	-	-	-	Typical	-	-	-	-	-	-	Remove - Fill stockpiling	
3653	Eucalyptus crebra	Narrow-leaved Ironbark	230		230	17	6	3	2	Regular	-	-	-	-	-	Typical	-	-	-	-	Typical	-	-	-	-	-	-	Remove - Fill stockpiling	
3654	Acacia disparrima	Hickory Wattle	180	110, 100	233	9	5	3	2	Regular	-	-	-	-	-	Typical	-	-	-	-	Typical	-	-	-	-	-	-	Remove	
3655	Corymbia tessellaris	Moreton Bay Ash	230		230	17	7	3	2	Regular	-	-	-	-	-	Typical	-	-	-	-	Typical	-	-	-	-	-	-	Remove	
3656	Corymbia intermedia	Pink Bloodwood	250		250	18	8	3	2	Regular	-	-	-	-	-	Typical	-	-	-	-	Typical	-	-	-	-	-	-	Remove	
3657	Allocasuarina littoralis	Black She Oak	200	160	256	9	6	3	2	Regular	-	-	-	-	-	Typical	-	-	-	-	Typical	-	-	-	-	-	-	Remove	
3658	Corymbia citriodora	Spotted Gum	280		280	16	7	3	2	Regular	-	-	-	-	-	Typical	-	-	-	-	Typical	-	-	-	-	-	-	Remove - Fill stockpiling	
3659	Eucalyptus crebra	Narrow-leaved Ironbark	180		180	14	3	2	2	Regular	-	-	-	-	-	Typical	-	-	-	-	Typical	-	-	-	-	-	-	Remove - Fill stockpiling	
3660	Eucalyptus tereticornis	Forest Red Gum	300		300	16	5	4	2	Regular	-	-	-	-	-	Typical	-	-	-	-	Typical	-	-	-	-	-	-	Remove - Fill stockpiling	
3661	Corymbia citriodora	Spotted Gum	190		190	16	5	2	2	Regular	-	-	-	-	-	Typical	-	-	-	-	Typical	-	-	-	-	-	-	Remove	
3662	Corymbia citriodora	Spotted Gum	210	160, 90	279	17	6	3	2	Regular	-	-	-	-	-	Typical	-	-	-	-	Typical	-	-	-	-	-	-	Remove	
3663	Corymbia citriodora	Spotted Gum	260		260	14	4	3	2	Regular	-	-	-	-	-	Typical	-	-	-	-	Typical	-	-	-	-	-	-	Remove - Fill stockpiling	
3664	Eucalyptus crebra	Narrow-leaved Ironbark	240		240	16	5	3	2	Regular	-	-	-	-	-	Typical	-	-	Trunk Dmg.	Poor	-	-	-	-	-	-	-	Remove - Fill stockpiling	
3665	Corymbia citriodora	Spotted Gum	220		220	17	7	3	2	Regular	-	-	-	-	-	Typical	-	-	-	-	Typical	-	-	-	-	-	-	Remove - Fill stockpiling	
3666	Corymbia citriodora	Spotted Gum	200		200	17	5	2	2	Regular	-	-	-	-	-	Typical	-	-	-	-	Typical	-	-	-	-	-	-	Retain	
3667	Acacia disparrima	Hickory Wattle	170		170	7	5	2	2	Regular	-	-	-	-	-	Typical	-	-	-	-	Typical	-	-	-	-	-	-	Retain	
3668	Corymbia citriodora	Spotted Gum	270		270	15	7	3	2	Regular	-	-	-	-	-	Typical	-	-	-	-	Typical	-	-	-	-	-	-	Retain	
3669	Corymbia citriodora	Spotted Gum	250		250	16	6	3	2	Regular	-	-	-	-	-	Typical	-	-	-	-	Typical	-	-	-	-	-	-	Retain	
3670	Corymbia citriodora	Spotted Gum	390		390	18	8	5	2	Regular	-	-	-	-	-	Typical	-	-	-	-	Typical	-	-	-	-	-	-	Retain	
3671	Eucalyptus tereticornis	Forest Red Gum	260		260	16	3	3	2	Regular	-	-	-	-	-	Typical	-	-	-	-	Typical	-	-	-	-	-	-	Retain	
3672	Eucalyptus tereticornis	Forest Red Gum	290		290	16	5	3	2	Regular	-	-	-	-	-	Typical	-	-	-	-	Typical	-	-	-	-	-	-	Retain	
3673	Eucalyptus tereticornis	Forest Red Gum	290		290	18	7	3	2	Regular	-	-	-	-	-	Typical	-	-	-	-	Typical	-	-	-	-	-	-	Retain	
3681	Corymbia intermedia	Pink Bloodwood	280		280	17	6	3	2	Regular	-	-	-	-	-	Typical	-	-	-	-	Typical	-	-	-	-	-	-	Retain	
3682	Corymbia intermedia	Pink Bloodwood	450		450	18	9	5	2	Regular	-	-	-	-	-	Typical	-	-	-	-	Typical	-	-	-	-	-	-	Retain	
3683	Angophora leiocarpa	Smooth-barked Apple	360		360	14	9	4	2	Regular	-	-	-	-	-	Typical	-	-	-	-	Typical	-	-	-	-	-	-	Retain	
3684	Eucalyptus crebra	Narrow-leaved Ironbark	300		300	16	4	4	2	One-sided	-	-	-	-	-	Typical	-	-	-	-	Typical	-	-	-	-	-	-	Retain	
3685	Acacia disparrima	Hickory Wattle	160		160	10	4	2	2	One-sided	-	-	-	-	-	Typical	-	-	-	-	Typical	-	-	-	-	-			

Tree ID	Specimen Details								Canopy Condition Details								Trunk Condition Details					Fauna Details and Habitat Value							Retention
	Botanical Name	Common Name	Trunk DBH (mm)	Additional Trunks DBH (mm)	Total DBH (mm) [AS 4970-2009]	Height (m)	Spread (m)	Tree Protection Zone (m)	Structural Root Zone (m)	Canopy Form	Spreading	Thinning	Die-Back	Epicormic Growth	Lopped	Canopy Health	Leaning	Vines	Trunk Damage	Fire Damage	Trunk Health	Scats	Scratches	Hollows	Nest	Termite Nest	Habitat Value		
3689	Eucalyptus tereticornis	Forest Red Gum	290		290	18	5	3	2	Regular	-	-	-	-	-	Typical	-	-	-	-	Typical	-	-	-	-	-	-	Remove - Fill stockpiling	
3690	Eucalyptus crebra	Narrow-leaved Ironbark	310		310	17	7	4	2	Regular	-	-	-	-	-	Typical	-	-	-	-	Typical	-	-	-	-	-	-	Remove - Fill stockpiling	
3691	Corymbia tessellaris	Moreton Bay Ash	110		110	13	3	2	1	Regular	-	-	-	-	-	Typical	-	-	-	-	Typical	-	-	-	-	-	-	Remove - Fill stockpiling	
3692	Corymbia tessellaris	Moreton Bay Ash	170		170	15	4	2	2	Regular	-	-	-	-	-	Typical	-	-	-	-	Typical	-	-	-	-	-	-	Remove - Fill stockpiling	
3693	Eucalyptus crebra	Narrow-leaved Ironbark	340		340	18	6	4	2	Regular	-	-	-	-	-	Typical	-	-	-	-	Typical	-	-	-	-	-	-	Remove - Fill stockpiling	
3694	Allocasuarina littoralis	Black She Oak	170		170	13	5	2	2	Regular	-	-	-	-	-	Typical	-	-	-	-	Typical	-	-	-	-	-	-	Remove - Fill stockpiling	
3698	Eucalyptus tereticornis	Forest Red Gum	690		690	21	10	8	3	Regular	-	-	-	-	-	Typical	-	-	-	-	Typical	-	-	-	-	-	-	Retain	
3699	Acacia dispartima	Hickory Wattle	240		240	7	5	3	2	Regular	-	-	-	-	-	Typical	-	-	-	-	Typical	-	-	-	-	-	-	Retain	
3917	Corymbia citriodora	Spotted Gum	260		260	17	4	3	2	Regular	-	-	-	-	-	Typical	-	-	-	-	Typical	-	-	-	-	-	-	Remove - Fill stockpiling	
3918	Corymbia citriodora	Spotted Gum	340		340	22	8	4	2	Regular	-	-	-	-	-	Typical	-	-	-	-	Typical	-	-	-	-	-	-	Remove - Fill stockpiling	
3919	Corymbia citriodora	Spotted Gum	230		230	16	5	3	2	Regular	-	-	-	-	-	Typical	-	-	-	-	Typical	-	-	-	-	-	-	Remove - Fill stockpiling	
3920	Eucalyptus tereticornis	Forest Red Gum	270		270	21	8	3	2	Regular	-	-	-	-	-	Typical	-	-	-	-	Typical	-	-	-	-	-	-	Remove - Fill stockpiling	
3921	Corymbia citriodora	Spotted Gum	130		130	13	2	2	1	Regular	-	-	-	-	-	Typical	-	-	-	-	Typical	-	-	-	-	-	-	Remove - Fill stockpiling	
3922	Eucalyptus tereticornis	Forest Red Gum	180		180	18	3	2	2	Regular	-	-	-	-	-	Typical	-	-	-	-	Typical	-	-	-	-	-	-	Remove - Fill stockpiling	
3923	Acacia dispartima	Hickory Wattle	200		200	10	3	2	2	Regular	-	-	-	-	-	Typical	-	-	-	-	Typical	-	-	-	-	-	-	Remove - Fill stockpiling	
3924	Eucalyptus tereticornis	Forest Red Gum	60		60	16	3	2	1	Regular	-	-	-	-	-	Typical	-	-	-	-	Typical	-	-	-	-	-	-	Remove - Fill stockpiling	
3925	Eucalyptus siderophloia	Grey Ironbark	280		280	21	7	3	2	Regular	-	-	-	-	-	Typical	-	-	-	-	Typical	-	-	-	-	-	-	Remove - Fill stockpiling	
3926	Corymbia citriodora	Spotted Gum	210		210	18	5	3	2	Regular	-	-	-	-	-	Typical	-	-	-	-	Typical	-	-	-	-	-	-	Remove - Fill stockpiling	
3927	Allocasuarina littoralis	Black She Oak	210		210	13	3	3	2	Regular	-	-	-	-	-	Typical	-	-	-	-	Typical	-	-	-	-	-	-	Remove - Fill stockpiling	
3928	Corymbia citriodora	Spotted Gum	160		160	18	4	2	2	Regular	-	-	-	-	-	Typical	-	-	-	-	Typical	-	-	-	-	-	-	Remove - Fill stockpiling	
3934	Eucalyptus tereticornis	Forest Red Gum	510		510	20	9	6	2	Regular	-	-	-	-	-	Typical	-	-	-	-	Typical	-	-	-	-	-	-	Retain	
3935	Corymbia intermedia	Pink Bloodwood	240		240	15	3	3	2	Regular	-	-	-	-	-	Typical	-	-	-	-	Typical	-	-	-	-	-	-	Retain	
3936	Corymbia intermedia	Pink Bloodwood	260		260	17	3	3	2	Regular	-	Thinning	Die-back	Epicormic	-	Poor	-	-	-	-	Typical	-	-	-	-	-	-	Retain	
3939	Acacia concurrens	Black Wattle	230		230	8	3	3	2	Regular	-	-	-	-	-	Typical	-	-	-	-	Typical	-	-	-	-	-	-	Retain	
3940	Corymbia intermedia	Pink Bloodwood	310		310	19	4	4	2	Regular	-	Thinning	Die-back	Epicormic	-	Poor	-	-	-	-	Typical	-	-	-	-	-	-	Retain	
4354	Casuarina cunninghamiana	River Sheoak	300		300	22	7	4	2	Regular	-	-	-	-	-	Typical	-	-	-	-	Typical	-	-	-	-	-	-	Remove	
4355	Alphitonia excelsa	Soap Tree	230		230	13	6	3	2	Regular	-	-	-	-	-	Typical	-	-	-	-	Typical	-	-	-	-	-	-	Remove	
4356	Casuarina cunninghamiana	River Sheoak	360		360	25	12	4	2	Regular	-	-	-	-	-	Typical	-	-	-	-	Typical	-	-	-	-	-	-	Remove	
4357	Casuarina cunninghamiana	River Sheoak	275		275	22	9	3	2	Regular	-	-	-	-	-	Typical	-	-	-	-	Typical	-	-	-	-	-	-	Retain	
4358	Casuarina cunninghamiana	River Sheoak	280		280	22	10	3	2	Regular	-	-	-	-	-	Typical	-	-	-	-	Typical	-	-	-	-	-	-	Retain	
4359	Melia azedarach	White Cedar	180		180	12	8	2	2	Regular	-	-	-	-	-	Typical	-	-	-	-	Typical	-	-	-	-	-	-	Remove	
4360	DEAD/STAG		295		295	19	5	4	2	Regular	-	-	-	-	-	Typical	-	-	-	-	Typical	-	-	-	-	-	-	Remove	
4361	Lophostemon suaveolens	Swamp Box	190		190	16	4	2	2	Regular	-	-	-	-	-	Typical	-	-	-	-	Typical	-	-	-	-	-	-	Retain	
4362	Angophora subvelutina	Broad-leaved Apple	165		165	13	3	2	2	Regular	-	-	-	-	-	Typical	-	-	-	-	Typical	-	-	-	-	-	-	Retain	
4363	Casuarina cunninghamiana	River Sheoak	285	200	348	21	7	4	2	Regular	-	-	-	-	-	Typical	-	-	-	-	Typical	-	-	-	-	-	-	Retain	
4364	Casuarina cunninghamiana	River Sheoak	230		230	18	6	3	2	Regular	-	-	-	-	-	Typical	Minor	-	-	-	Typical	-	-	-	-	-	-	Retain	
4365	Angophora subvelutina	Broad-leaved Apple	255		255	16	7	3	2	One-sided	-	-	-	-	-	Typical	Minor	-	-	-	Typical	-	-	-	-	-	-	Retain	
4366	Angophora subvelutina	Broad-leaved Apple	520		520	22	11	6	3	Regular	-	-	-	-	-	Typical	-	-	-	-	Typical	-	-	-	-	-	-	Retain	
4367	Alphitonia excelsa	Soap Tree	155		155	9	4	2	2	Regular	-	-	-	-	-	Typical	-	-	-	-	Typical	-	-	-	-	-	-	Retain	
4368	Angophora subvelutina	Broad-leaved Apple	640		640	23	11	8	3	Regular	-	-	-	-	-	Typical	-	-	-	-	Typical	-	-	-	-	-	-	Retain	
4369	Lophostemon suaveolens	Swamp Box	165		165	11	3	2	2	Regular	-	-	-	-	-	Typical	-	-	-	-	Typical	-	-	-	-	-	-	Retain	
4370	Lophostemon suaveolens	Swamp Box	150		150	11	3	2	1	Regular	-	-	-	-	-	Typical	-	-	-	-	Typical	-	-	-	-	-	-	Retain	
4371	Alphitonia excelsa	Soap Tree	155		155	11	4	2	2	Regular	-	-	-	-	-	Typical	-	-	-	-	Typical	-	-	-	-	-	-	Retain	
4372	Angophora subvelutina	Broad-leaved Apple	280		280	17	7	3	2	Regular	-	-	-	-	-	Typical	-	-	-	-	Typical	-	-	-	-	-	-	Retain	
4373	Corymbia tessellaris	Moreton Bay Ash	130		130	14	3	2	1	Regular	-	-	-	-	-	Typical	-	-	-	-	Typical	-	-	-	-	-	-	Retain	
4374	Angophora subvelutina	Broad-leaved Apple	430		430	22	9	5	2	Regular	-	-	-	-	-	Typical	-	-	-	-	Typical	-	-	-	-	-	-	Retain	
4375	Corymbia tessellaris	Moreton Bay Ash	195	100	219	16	5	3	2	Regular	-	-	-	-	-	Typical	-	-	-	-	Typical	-	-	-	-	-	-	Retain	
4376	Acacia melanoxylon	Australian Blackwood	175		175	12	5	2	2	Regular	-	-	-	-	-	Typical	-	-	-	-	Typical	-	-	-	-	-	-	Retain	
4377	Corymbia tessellaris	Moreton Bay Ash	280		280	17	8	3	2	Regular	-	-	-	-	-	Typical	Minor	-	-	-	Typical	-	-	-	-	-	-	Retain	
4378	Eucalyptus tereticornis	Forest Red Gum	275		275	18	4	3	2	Regular	-	-	-	-	-	Typical	-	-	-	-	Typical	-	-	-	-	-	-	Retain	
4379	Eucalyptus tereticornis	Forest Red Gum	295		295	21	7	4	2	Regular	-	-	-	-	-	Typical	-	-	-	-	Typical	-	-	-	-	-	-	Retain	
4380	Angophora subvelutina	Broad-leaved Apple	165		165	12	5	2	2	Regular	-	-	-	-	-	Typical	-	-	-	-	Typical	-	-	-	-	-	-	Retain	
4381	Alphitonia excelsa	Soap Tree	180		180	13	5	2	2	Regular	-	-	-	-	-	Typical	-	-	-	-	Typical	-	-	-	-	-	-	Retain	
4382	Corymbia tessellaris	Moreton Bay Ash	160	125	203	13	4	2	2	Regular	-	-	-	-	-	Typical	-	-	-	-	Typical	-	-	-	-	-	-	Retain	
4383	Angophora subvelutina	Broad-leaved Apple	390		390	19	9	5	2	Regular	-	-	-	-	-	Typical	-	-	-	-	Typical	-	-	-	-	-	-	Retain	
4384	Alphitonia excelsa	Soap Tree	165		165	11	5	2	2	Regular	-	-	-	-	-	Typical	-	-	-	-	Typical	-	-	-	-	-	-	Retain	
4385	Eucalyptus tereticornis	Forest Red Gum	400		400	24	8	5	2	Regular	-	-	-	-	-	Typical	-	-	-	-	Typical	-	-	-	-	-	-	Retain	
4386	Eucalyptus tereticornis	Forest Red Gum	230		230	21	6	3	2	Regular	-	-	-	-	-	Typical	-	-	-	-	Typical	-	-	-	-	-	-	Retain	
4387	Corymbia tessellaris	Moreton Bay Ash	140		140	13	3	2	1	Regular	-	-	-	-	-	Typical	-	-	-	-	Typical	-	-	-	-	-	-	Retain	
4388	Acacia dispartima	Hickory Wattle	130		130	12	5	2	1	Regular	-	-	-	-	-	Typical	-	-	-	-	Typical	-	-	-	-	-	-	Retain	
4389	Angophora subvelutina	Broad-leaved Apple	585		585	22	12	7	3	Regular	-	-	-	-	-	Typical	-	-	-	-	Typical	-	-	-	-	-	-	Retain	
4390	Acacia dispartima	Hickory Wattle	240		240	11	6	3	2	Regular	-	Thinning	Die-back	-	-	Typical	-	Introduced	-	-	Typical	-	-	-	-	-	-	Retain	
4391	Lophostemon suaveolens	Swamp Box	145		145	10	3	2	1	Regular	-	-	-	-	-	Typical	-	-	-	-	Typical	-	-	-	-	-	-	Retain	
4392	Alphitonia excelsa	Soap Tree	125		125	8	3	2	1	Regular	-	-	-	-	-	Typical	-	-	-	-	Typical	-	-	-	-	-	-	Retain	
4393	Angophora subvelutina	Broad-leaved Apple	420		420	24	9	5	2	Regular	-	-	-	-	-	Typical	-												

Tree ID	Specimen Details								Canopy Condition Details								Trunk Condition Details					Fauna Details and Habitat Value							Retention
	Botanical Name	Common Name	Trunk DBH (mm)	Additional Trunks DBH (mm)	Total DBH (mm) (AS 4970-2009)	Height (m)	Spread (m)	Tree Protection Zone (m)	Structural Root Zone (m)	Canopy Form	Spreading	Thinning	Die-Back	Epicormic Growth	Lopped	Canopy Health	Leaning	Vines	Trunk Damage	Fire Damage	Trunk Health	Scats	Scratches	Hollows	Nest	Termite Nest	Habitat Value		
4397	Alphitonia excelsa	Soap Tree	155	90	179	12	6	2	2	Regular	-	-	-	-	-	Typical	-	-	-	-	Typical	-	-	-	-	-	-	Retain	
4398	Lophostemon suaveolens	Swamp Box	275		275	14	5	3	2	Regular	-	-	-	-	-	Typical	-	-	-	-	Typical	-	-	-	-	-	-	Retain	
4399	Lophostemon suaveolens	Swamp Box	385		385	16	8	5	2	Regular	-	-	-	-	-	Typical	-	-	-	-	Typical	-	-	-	-	-	-	Retain	
4400	Acacia dispartima	Hickory Wattle	170		170	11	5	2	2	Regular	-	-	-	-	-	Typical	-	-	-	-	Typical	-	-	-	-	-	-	Retain	
4401	Corymbia tessellaris	Moreton Bay Ash	240		240	15	3	3	2	Regular	-	-	-	-	-	Typical	-	-	Trunk Dmg.	-	Typical	-	-	-	-	-	-	Retain	
4402	Corymbia tessellaris	Moreton Bay Ash	220		220	17	6	3	2	Regular	-	-	-	-	-	Typical	-	-	-	-	Typical	-	-	-	-	-	-	Retain	
4403	Acacia dispartima	Hickory Wattle	165		165	11	5	2	2	Regular	-	-	-	-	-	Typical	-	-	-	-	Typical	-	-	-	-	-	-	Retain	
4404	Lophostemon suaveolens	Swamp Box	230		230	14	6	3	2	Regular	-	-	-	-	-	Typical	-	-	-	-	Typical	-	-	-	-	-	-	Retain	
4405	Lophostemon suaveolens	Swamp Box	265		265	11	5	3	2	Regular	-	-	-	-	-	Typical	-	-	-	-	Typical	-	-	-	-	-	-	Retain	
4406	Corymbia tessellaris	Moreton Bay Ash	180		180	11	8	2	2	Regular	-	-	-	-	-	Typical	Major	-	-	-	Poor	-	-	-	-	-	-	Retain	
4407	Acacia dispartima	Hickory Wattle	195		195	9	5	2	2	Regular	-	-	-	-	-	Typical	-	-	-	-	Typical	-	-	-	-	-	-	Retain	
4408	Acacia dispartima	Hickory Wattle	175		175	9	4	2	2	Regular	-	-	-	-	-	Typical	-	-	-	-	Typical	-	-	-	-	-	-	Retain	
4409	Alphitonia excelsa	Soap Tree	175		175	12	5	2	2	Regular	-	-	-	-	-	Typical	-	-	-	-	Typical	-	-	-	-	-	-	Retain	
4410	Eucalyptus crebra	Narrow-leaved Ironbark	660		660	26	9	8	3	Regular	-	-	-	-	-	Typical	-	-	Trunk Dmg.	-	Typical	-	-	-	-	-	-	Retain	
4411	Eucalyptus tereticornis	Forest Red Gum	185		185	13	3	2	2	Regular	-	-	-	-	-	Typical	-	-	-	-	Typical	-	-	-	-	-	-	Retain	
4412	Acacia dispartima	Hickory Wattle	150		150	9	3	2	1	Regular	-	-	-	-	-	Typical	-	-	-	-	Typical	-	-	-	-	-	-	Retain	
4413	Lophostemon suaveolens	Swamp Box	135		135	7	2	2	1	Regular	-	-	-	-	-	Typical	-	-	-	-	Typical	-	-	-	-	-	-	Retain	
4414	Angophora subvelutina	Broad-leaved Apple	275		275	16	7	3	2	Regular	-	-	-	-	-	Typical	-	-	-	-	Typical	-	-	-	-	-	-	Retain	
4415	Eucalyptus crebra	Narrow-leaved Ironbark	360		360	17	7	4	2	Regular	-	-	-	-	Lopped	Typical	-	-	Trunk Dmg.	-	Typical	-	-	-	-	-	-	Retain	
4416	Lophostemon suaveolens	Swamp Box	135		135	9	2	2	1	Regular	-	-	-	-	-	Typical	-	-	-	-	Typical	-	-	-	-	-	-	Retain	
4417	Lophostemon suaveolens	Swamp Box	165		165	10	2	2	2	Regular	-	-	-	-	-	Typical	-	-	-	-	Typical	-	-	-	-	-	-	Retain	
4418	Lophostemon suaveolens	Swamp Box	145		145	10	2	2	1	Regular	-	-	-	-	-	Typical	-	-	-	-	Typical	-	-	-	-	-	-	Retain	
4419	Lophostemon suaveolens	Swamp Box	265		265	11	5	3	2	Regular	-	-	-	-	-	Typical	-	-	-	-	Typical	-	-	-	-	-	-	Retain	
4420	Lophostemon suaveolens	Swamp Box	270		270	13	6	3	2	Regular	-	-	-	-	-	Typical	-	-	-	-	Typical	-	-	-	-	-	-	Retain	
4423	Melaleuca irbyana	Weeping Paperbark	275		275	7	5	3	2	One-sided	-	-	-	-	Lopped	Typical	-	-	-	-	Typical	-	-	-	-	-	-	Remove - Fill stockpiling	
4424	Allocasuarina littoralis	Black She Oak	160		160	11	5	2	2	Regular	-	-	-	-	-	Typical	-	-	-	-	Typical	-	-	-	-	-	-	Remove	
4425	Corymbia intermedia	Pink Bloodwood	210		210	10	3	3	2	Regular	-	Thinning	Die-back	-	-	Poor	-	-	-	-	Typical	-	-	-	-	Termite nest	-	Remove	
4426	Corymbia citriodora	Spotted Gum	320		320	16	6	4	2	Regular	-	-	-	-	-	Typical	-	-	-	-	Typical	-	-	-	-	-	-	Remove	
4427	Corymbia citriodora	Spotted Gum	195		195	13	5	2	2	Regular	-	-	-	-	-	Typical	-	-	-	-	Typical	-	-	-	-	-	-	Remove	
4428	Corymbia citriodora	Spotted Gum	185		185	14	4	2	2	Regular	-	-	-	-	-	Typical	-	-	-	-	Typical	-	-	-	-	-	-	Remove	
4429	Alphitonia excelsa	Soap Tree	125		125	9	2	2	1	Regular	-	-	-	-	-	Typical	-	-	-	-	Typical	-	-	-	-	-	-	Remove	
4430	Alphitonia excelsa	Soap Tree	105		105	8	2	2	1	Regular	-	Thinning	Die-back	-	-	Poor	-	-	-	-	Typical	-	-	-	-	-	-	Remove	
4431	Corymbia citriodora	Spotted Gum	105		105	11	2	2	1	Regular	-	-	-	-	-	Typical	-	-	-	-	Typical	-	-	-	-	-	-	Remove	
4432	Alphitonia excelsa	Soap Tree	105	50	116	8	3	2	1	Regular	-	-	-	-	-	Typical	-	-	-	-	Typical	-	-	-	-	-	-	Remove	
4433	Corymbia citriodora	Spotted Gum	275		275	18	5	3	2	Regular	-	Thinning	Die-back	-	-	Typical	-	-	-	-	Typical	-	-	-	-	-	-	Remove	
4434	Corymbia citriodora	Spotted Gum	135		135	13	4	2	1	Regular	-	-	-	-	-	Typical	-	-	-	-	Typical	-	-	-	-	-	-	Remove	
4435	Corymbia citriodora	Spotted Gum	275		275	19	3	3	2	Regular	-	-	-	-	-	Typical	-	-	-	-	Typical	-	-	-	-	-	-	Remove	
4436	Corymbia citriodora	Spotted Gum	130		130	11	3	2	1	Regular	-	-	-	-	-	Typical	-	-	-	-	Typical	-	-	-	-	-	-	Remove	
4437	Corymbia citriodora	Spotted Gum	130		130	10	2	2	1	Regular	-	-	-	-	-	Typical	-	-	-	-	Typical	-	-	-	-	-	-	Remove	
4438	Alphitonia excelsa	Soap Tree	100		100	8	3	2	1	Regular	-	-	-	-	-	Typical	-	-	-	-	Typical	-	-	-	-	-	-	Remove	
4439	Corymbia citriodora	Spotted Gum	220		220	17	5	3	2	Regular	-	-	-	-	-	Typical	-	-	-	-	Typical	-	-	-	-	-	-	Remove	
4440	Corymbia citriodora	Spotted Gum	220		220	12	5	3	2	Regular	-	-	-	-	-	Typical	-	-	-	-	Typical	-	-	-	-	-	-	Remove	
4441	DEAD/STAG		275		275	18	3	3	2	Regular	-	-	-	-	-	Typical	-	-	-	-	Typical	-	-	-	-	-	-	Remove	
4442	Corymbia intermedia	Pink Bloodwood	275		275	17	6	3	2	Regular	-	-	-	-	-	Typical	-	-	-	-	Typical	-	-	-	-	-	-	Remove	
4443	Eucalyptus crebra	Narrow-leaved Ironbark	165		165	14	3	2	2	Regular	-	-	-	-	-	Typical	-	-	-	-	Typical	-	-	-	-	-	-	Remove	
4444	Eucalyptus crebra	Narrow-leaved Ironbark	170		170	14	4	2	2	Regular	-	-	-	-	-	Typical	-	-	-	-	Typical	-	-	-	-	-	-	Remove	
4445	Eucalyptus tereticornis	Forest Red Gum	280		280	16	6	3	2	Regular	-	-	-	-	-	Typical	-	-	-	-	Typical	-	-	-	-	-	-	Remove	
4446	Corymbia citriodora	Spotted Gum	340		340	21	9	4	2	Regular	-	-	-	-	-	Typical	-	-	-	-	Typical	-	-	-	-	-	-	Remove	
4447	Eucalyptus crebra	Narrow-leaved Ironbark	150		150	11	3	2	1	Regular	-	-	-	-	-	Typical	-	-	-	-	Typical	-	-	-	-	-	-	Remove	
4448	Corymbia citriodora	Spotted Gum	300		300	19	5	4	2	Regular	-	-	-	-	-	Typical	-	-	-	-	Typical	-	-	-	-	-	-	Remove	
4449	Eucalyptus moluccana	Gum Topped Box	290	180	341	17	9	4	2	Regular	-	-	-	-	-	Typical	-	-	-	-	Typical	-	-	-	-	-	-	Remove	
4450	Corymbia citriodora	Spotted Gum	195		195	16	4	2	2	Regular	-	-	-	-	-	Typical	-	-	-	-	Typical	-	-	-	-	-	-	Remove	
4451	Corymbia citriodora	Spotted Gum	195		195	17	4	2	2	Regular	-	-	-	-	-	Typical	-	-	-	-	Typical	-	-	-	-	-	-	Remove	
4452	Corymbia citriodora	Spotted Gum	175		175	15	4	2	2	Regular	-	-	-	-	-	Typical	-	-	-	-	Typical	-	-	-	-	-	-	Remove	
4453	Eucalyptus tereticornis	Forest Red Gum	320		320	19	7	4	2	Regular	-	-	-	-	-	Typical	-	-	-	-	Typical	-	-	-	-	-	-	Remove	
4454	Corymbia citriodora	Spotted Gum	420		420	21	9	5	2	Regular	-	-	-	-	-	Typical	-	-	-	-	Typical	-	-	-	-	-	-	Remove	
4455	Corymbia citriodora	Spotted Gum	180		180	15	4	2	2	Regular	-	-	-	-	-	Typical	-	-	-	-	Typical	-	-	-	-	-	-	Remove	
4456	Eucalyptus moluccana	Gum Topped Box	190	100	215	15	6	3	2	Regular	-	-	-	-	-	Typical	-	-	-	-	Typical	-	-	-	-	-	-	Remove	
4457	Corymbia citriodora	Spotted Gum	340	160, 105, 65	396	22	9	5	2	Regular	-	-	-	-	-	Typical	-	-	-	-	Typical	-	-	-	-	-	-	Remove	
4458	Eucalyptus moluccana	Gum Topped Box	230		230	12	5	3	2	Regular	-	-	-	-	-	Typical	Minor	-	-	-	Typical	-	-	-	-	-	-	Remove	
4459	Corymbia citriodora	Spotted Gum	160	80, 65, 95, 85	229	13	5	3	2	Regular	-	-	-	-	-	Typical	-	-	-	-	Typical	-	-	-	-	-	-	Remove	
4460	Corymbia citriodora	Spotted Gum	185		185	11	4	2	2	Regular	-	-	-	-	-	Typical	-	-	-	-	Typical	-	-	-	-	-	-	Remove	
4461	DEAD/STAG		360		360	24	7	4	2	Regular	-	-	-	-	-	Typical	-	-	-	-	Typical	-	-	-	-	-	-	Remove	
4462	Corymbia citriodora	Spotted Gum	205		205	16	5	2	2	Regular	-	-	-	-	-	Typical	-	-	-	-	Typical	-	-	-	-	-	-	Remove	
4463	Corymbia citriodora	Spotted Gum	165		165	11	4	2	2	Regular	-	-	-	-	-	Typical	-	-	-	-	Typical	-	-	-	-	-	-	Remove	
4464	Eucalyptus crebra	Narrow-leaved																											

Tree ID	Specimen Details								Canopy Condition Details								Trunk Condition Details					Fauna Details and Habitat Value						
	Botanical Name	Common Name	Trunk DBH (mm)	Additional Trunks DBH (mm)	Total DBH (mm) [AS 4970-2009]	Height (m)	Spread (m)	Tree Protection Zone (m)	Structural Root Zone (m)	Canopy Form	Spreading	Thinning	Die-Back	Epicormic Growth	Lopped	Canopy Health	Leaning	Vines	Trunk Damage	Fire Damage	Trunk Health	Scats	Scratches	Hollows	Nest	Termite Nest	Habitat Value	Retention
4467	Eucalyptus crebra	Narrow-leaved Ironbark	220		220	13	5	3	2	Regular	-	-	-	-	-	Typical	-	-	-	-	Typical	-	-	-	-	Termite nest	-	Remove
4468	Corymbia citriodora	Spotted Gum	130		130	12	3	2	1	Regular	-	-	-	-	-	Typical	-	-	-	-	Typical	-	-	-	-	-	-	Remove
4469	Corymbia citriodora	Spotted Gum	295		295	18	6	4	2	Regular	-	-	Die-back	-	-	Typical	-	-	-	-	Typical	-	-	-	-	-	-	Remove
4470	Eucalyptus moluccana	Gum Topped Box	175		175	14	3	2	2	Regular	-	-	-	-	-	Typical	-	-	-	-	Typical	-	-	-	-	-	-	Remove
4471	Corymbia citriodora	Spotted Gum	270		270	15	4	3	2	Regular	-	-	-	-	-	Typical	-	-	-	-	Typical	-	-	-	-	-	-	Remove
4472	Corymbia citriodora	Spotted Gum	390		390	23	9	5	2	Regular	-	-	-	-	-	Typical	-	-	-	-	Typical	-	-	-	-	-	-	Remove
4473	Corymbia citriodora	Spotted Gum	145		145	11	2	2	1	Regular	-	-	-	-	-	Typical	-	-	-	-	Typical	-	-	-	-	-	-	Remove
4474	Eucalyptus crebra	Narrow-leaved Ironbark	165		165	12	4	2	2	Regular	-	Thinning	Die-back	-	-	Poor	-	-	-	-	Typical	-	-	-	-	-	-	Remove
4475	Corymbia citriodora	Spotted Gum	325		325	18	5	4	2	Regular	-	-	-	-	-	Typical	-	-	-	-	Typical	-	-	-	-	-	-	Remove
4476	Eucalyptus crebra	Narrow-leaved Ironbark	145		145	8	3	2	1	Regular	-	-	-	-	-	Typical	-	-	-	-	Typical	-	-	-	-	-	-	Remove
4477	Eucalyptus tereticornis	Forest Red Gum	165		165	13	4	2	2	Regular	-	-	-	-	-	Typical	-	-	-	-	Typical	-	-	-	-	-	-	Remove
4478	Corymbia citriodora	Spotted Gum	145		145	12	3	2	1	Regular	-	-	-	-	-	Typical	-	-	-	-	Typical	-	-	-	-	-	-	Remove
4479	Eucalyptus tereticornis	Forest Red Gum	165		165	13	4	2	2	Regular	-	-	-	-	-	Typical	-	-	-	-	Typical	-	-	-	-	-	-	Remove
4480	Eucalyptus crebra	Narrow-leaved Ironbark	345		345	22	7	4	2	Regular	-	-	-	-	-	Typical	-	-	-	-	Typical	-	-	-	-	-	-	Remove
4481	Corymbia citriodora	Spotted Gum	365	170	403	18	7	5	2	Regular	-	-	-	-	-	Typical	-	-	-	-	Typical	-	-	-	-	-	-	Remove
4482	Corymbia citriodora	Spotted Gum	185		185	14	5	2	2	Regular	-	-	-	-	-	Typical	-	-	-	-	Typical	-	-	-	-	-	-	Remove
4483	Corymbia citriodora	Spotted Gum	390		390	24	9	5	2	Regular	-	-	-	-	-	Typical	-	-	-	-	Typical	-	-	-	-	-	-	Remove
4484	Corymbia citriodora	Spotted Gum	165		165	12	3	2	2	Regular	-	-	-	-	-	Typical	-	-	-	-	Typical	-	-	-	-	-	-	Remove
4485	Corymbia citriodora	Spotted Gum	310		310	19	7	4	2	Regular	-	-	-	-	-	Typical	-	-	-	-	Typical	-	-	-	-	-	-	Remove
4486	Corymbia citriodora	Spotted Gum	185		185	15	3	2	2	Regular	-	Thinning	Die-back	-	-	Poor	-	-	-	-	Typical	-	-	-	-	-	-	Remove
4487	Eucalyptus crebra	Narrow-leaved Ironbark	145		145	12	2	2	1	Regular	-	-	-	-	-	Typical	-	-	-	-	Typical	-	-	-	-	-	-	Remove
4488	Corymbia tessellaris	Moreton Bay Ash	225		225	16	4	3	2	Regular	-	-	-	-	-	Typical	-	-	-	-	Typical	-	-	-	-	-	-	Remove
4489	Alphitonia excelsa	Soap Tree	165		165	11	5	2	2	Regular	-	Thinning	Die-back	-	-	Poor	-	-	-	-	Typical	-	-	-	-	-	-	Remove
4490	Angophora leiocarpa	Smooth-barked Apple	195		195	11	5	2	2	Regular	-	-	-	-	-	Typical	-	-	-	-	Typical	-	-	-	-	-	-	Remove
4491	Eucalyptus tereticornis	Forest Red Gum	285		285	15	6	3	2	Regular	-	-	-	-	-	Typical	-	-	-	-	Typical	-	-	-	-	-	-	Remove
4492	Corymbia citriodora	Spotted Gum	165		165	12	5	2	2	Regular	-	-	-	-	-	Typical	-	-	-	-	Typical	-	-	-	-	-	-	Remove
4493	Eucalyptus tereticornis	Forest Red Gum	230		230	17	6	3	2	Regular	-	-	-	-	-	Typical	-	-	-	-	Typical	-	-	-	-	-	-	Remove
4494	Acacia disparrima	Hickory Wattle	150		150	8	4	2	1	Regular	-	-	-	-	-	Typical	-	-	Trunk Dmg.	-	Typical	-	-	-	-	-	-	Remove
4495	Alphitonia excelsa	Soap Tree	155		155	10	4	2	2	Regular	-	-	-	-	-	Typical	-	-	-	-	Typical	-	-	-	-	-	-	Remove
4496	Eucalyptus crebra	Narrow-leaved Ironbark	175		175	15	3	2	2	Regular	-	-	-	-	-	Typical	-	-	-	-	Typical	-	-	-	-	-	-	Remove
4497	Eucalyptus crebra	Narrow-leaved Ironbark	245		245	15	5	3	2	Regular	-	-	-	-	-	Typical	-	-	-	-	Typical	-	-	-	-	-	-	Remove
4498	Eucalyptus crebra	Narrow-leaved Ironbark	190		190	16	4	2	2	Regular	-	-	-	-	-	Typical	-	-	-	-	Typical	-	-	-	-	-	-	Remove
4499	Eucalyptus crebra	Narrow-leaved Ironbark	320		320	19	8	4	2	Regular	-	-	-	-	-	Typical	-	-	-	-	Typical	-	-	-	-	-	-	Remove
4500	Alphitonia excelsa	Soap Tree	200		200	8	4	2	2	Regular	-	-	-	-	-	Typical	-	-	-	-	Typical	-	-	-	-	-	-	Remove
4501	Alphitonia excelsa	Soap Tree	190		190	7	5	2	2	Regular	-	-	-	-	-	Typical	Major	-	-	-	Typical	-	-	-	-	-	-	Remove
4502	Alphitonia excelsa	Soap Tree	150		150	10	5	2	1	Regular	-	-	-	-	-	Typical	-	-	-	-	Typical	-	-	-	-	-	-	Remove
4503	Eucalyptus crebra	Narrow-leaved Ironbark	100		100	10	2	2	1	Regular	-	-	-	-	-	Typical	-	-	-	-	Typical	-	-	-	-	-	-	Remove
4504	Acacia disparrima	Hickory Wattle	140		140	9	5	2	1	Regular	-	-	-	-	-	Typical	-	-	-	-	Typical	-	-	-	-	-	-	Remove
4505	Acacia disparrima	Hickory Wattle	240		240	9	5	3	2	Regular	-	-	-	-	-	Typical	-	-	-	-	Typical	-	-	-	-	-	-	Remove
4506	Alphitonia excelsa	Soap Tree	165		165	12	5	2	2	Regular	-	-	-	-	-	Typical	-	-	-	-	Typical	-	-	-	-	-	-	Remove
4507	Corymbia citriodora	Spotted Gum	165		165	15	3	2	2	Regular	-	-	-	-	-	Typical	-	-	-	-	Typical	-	-	-	-	-	-	Remove
4508	Eucalyptus tereticornis	Forest Red Gum	155		155	13	3	2	2	Regular	-	-	-	-	-	Typical	-	-	-	-	Typical	-	-	-	-	-	-	Remove
4509	Corymbia citriodora	Spotted Gum	125		125	11	4	2	1	Regular	-	-	-	-	-	Typical	-	-	-	-	Typical	-	-	-	-	-	-	Remove
4510	Alphitonia excelsa	Soap Tree	235		235	12	6	3	2	Regular	-	-	-	-	-	Typical	-	-	-	-	Typical	-	-	-	-	-	-	Remove
4511	Alphitonia excelsa	Soap Tree	205		205	12	6	2	2	Regular	-	-	-	-	-	Typical	-	-	-	-	Typical	-	-	-	-	-	-	Remove
4512	Eucalyptus crebra	Narrow-leaved Ironbark	350	150	381	21	5	5	2	Regular	-	-	-	-	-	Typical	-	-	-	-	Typical	-	-	-	-	-	-	Remove
4513	Corymbia citriodora	Spotted Gum	185		185	14	3	2	2	Regular	-	-	-	-	-	Typical	-	-	-	-	Typical	-	-	-	-	-	-	Remove
4514	Corymbia citriodora	Spotted Gum	120		120	9	2	2	1	Regular	-	-	-	-	-	Typical	-	-	-	-	Typical	-	-	-	-	-	-	Remove
4515	Corymbia citriodora	Spotted Gum	390		390	22	9	5	2	Regular	-	-	-	-	-	Typical	-	-	-	-	Typical	-	-	-	-	-	-	Remove
4516	Alphitonia excelsa	Soap Tree	125	70	143	11	5	2	1	Regular	-	-	-	-	-	Typical	-	-	-	-	Typical	-	-	-	-	-	-	Remove
4517	Alphitonia excelsa	Soap Tree	100		100	6	3	2	1	Regular	-	-	-	-	-	Typical	-	-	-	-	Typical	-	-	-	-	-	-	Remove
4518	Corymbia citriodora	Spotted Gum	330		330	22	8	4	2	Regular	-	-	-	-	-	Typical	-	-	-	-	Typical	-	-	-	-	-	-	Remove
4519	Eucalyptus crebra	Narrow-leaved Ironbark	300		300	16	6	4	2	Regular	-	-	-	-	-	Typical	-	-	-	-	Typical	-	-	-	-	-	-	Remove
4520	Acacia disparrima	Hickory Wattle	140	80	161	9	4	2	2	Regular	-	-	-	-	-	Typical	-	-	-	-	Typical	-	-	-	-	-	-	Remove
4521	Eucalyptus crebra	Narrow-leaved Ironbark	285		285	17	6	3	2	Regular	-	-	-	-	-	Typical	-	-	-	-	Typical	-	-	-	-	-	-	Remove
4522	Corymbia citriodora	Spotted Gum	305		305	21	6	4	2	Regular	-	-	-	-	-	Typical	-	-	-	-	Typical	-	-	-	-	-	-	Remove
4523	Corymbia citriodora	Spotted Gum	385		385	22	8	5	2	Regular	-	-	-	-	-	Typical	-	-	-	-	Typical	-	-	-	-	-	-	Remove
4524	Corymbia citriodora	Spotted Gum	195		195	17	3	2	2	Regular	-	-	-	-	-	Typical	-	-	-	-	Typical	-	-	-	-	-	-	Remove
4525	Eucalyptus tereticornis	Forest Red Gum	130		130	9	3	2	1	Regular	-	Thinning	Die-back	-	-	Poor	-	-	-	-	Typical	-	-	-	-	-	-	Remove
4526	Eucalyptus tereticornis	Forest Red Gum	155		155	15	2	2	2	Regular	-	-	-	-	-	Typical	-	-	-	-	Typical	-	-	-	-	-	-	Remove
4527	Corymbia citriodora	Spotted Gum	385		385	19	8	5	2	Regular	-	Thinning	Die-back	-	-	Typical	-	-	-	-	Typical	-	-	-	-	-	-	Remove
4528	Corymbia citriodora	Spotted Gum	145		145	10	3	2	1	Regular	-	-	-	-	-	Typical	-	-	-	-	Typical	-	-	-	-	-	-	Remove
4529	Corymbia citriodora	Spotted Gum	105		105	10	3	2	1	Regular	-	-	-	-	-	Typical	-	-	-	-	Typical	-	-	-	-	-	-	Remove
4530	Corymbia citriodora	Spotted Gum	375		375	22	9	5	2	Regular	-	-	-	-	-	Typical	-	-	-	-	Typical	-	-	-	-	-	-	Remove
4531	Corymbia citriodora	Spotted Gum	265		265	18	5	3	2	Regular	-	-	-	-	-	Typical	-	-	-	-	Typical	-	-	-	-	-	-	Remove
4532	Eucalyptus tereticornis	Forest Red Gum	230		230	18	4																					

Tree ID	Specimen Details								Canopy Condition Details								Trunk Condition Details					Fauna Details and Habitat Value								Retention
	Botanical Name	Common Name	Trunk DBH (mm)	Additional Trunks DBH (mm)	Total DBH (mm) [AS 4970-2009]	Height (m)	Spread (m)	Tree Protection Zone (m)	Structural Root Zone (m)	Canopy Form	Spreading	Thinning	Die-Back	Epicormic Growth	Lopped	Canopy Health	Leaning	Vines	Trunk Damage	Fire Damage	Trunk Health	Scats	Scratches	Hollows	Nest	Termite Nest	Habitat Value			
4535	Corymbia citriodora	Spotted Gum	230		230	15	6	3	2	Regular	-	-	-	Epicormic	Lopped	Poor	-	-	-	-	Typical	-	-	-	-	-	-	-	Remove	
4536	Acacia disparrima	Hickory Wattle	150	100	180	8	6	2	2	Regular	-	-	-	-	-	Typical	-	-	-	-	Typical	-	-	-	-	-	-	-	Remove	
4537	Eucalyptus crebra	Narrow-leaved Ironbark	210		210	13	5	3	2	Regular	-	-	-	-	-	Typical	Minor	-	-	-	Typical	-	-	-	-	-	-	-	Remove	
4538	Lophostemon suaveolens	Swamp Box	105		105	8	3	2	1	Regular	-	-	-	-	-	Typical	-	-	-	-	Typical	-	-	-	-	-	-	-	Remove	
4539	Corymbia citriodora	Spotted Gum	185		185	16	4	2	2	Regular	-	Thinning	Die-back	-	-	Poor	-	-	Trunk Dmg.	-	Poor	-	-	-	-	-	-	Remove		
4540	Corymbia citriodora	Spotted Gum	290		290	17	7	3	2	Regular	-	-	-	-	-	Typical	-	-	-	-	Typical	-	-	-	-	-	-	-	Remove	
4541	Eucalyptus crebra	Narrow-leaved Ironbark	320		320	18	8	4	2	Regular	-	-	-	-	-	Typical	-	-	-	-	Typical	-	-	-	-	-	-	-	Remove	
4542	Eucalyptus tereticornis	Forest Red Gum	565		565	22	9	7	3	Regular	-	-	-	-	-	Typical	-	-	-	-	Typical	-	-	-	-	-	-	-	Remove	
4543	Corymbia citriodora	Spotted Gum	135		135	9	4	2	1	Regular	-	-	-	-	-	Typical	-	-	-	-	Typical	-	-	-	-	-	-	-	Remove	
4544	Alphitonia excelsa	Soap Tree	140		140	9	4	2	1	Regular	-	-	-	-	-	Typical	-	-	-	-	Typical	-	-	-	-	-	-	-	Remove	
4545	Corymbia citriodora	Spotted Gum	160	130	206	14	5	2	2	Regular	-	-	-	-	-	Typical	-	-	-	-	Typical	-	-	-	-	-	-	-	Remove	
4546	Eucalyptus tereticornis	Forest Red Gum	260		260	18	4	3	2	Regular	-	-	-	-	-	Typical	-	-	Trunk Dmg.	-	Typical	-	-	-	-	-	-	-	Remove	
4547	Eucalyptus tereticornis	Forest Red Gum	200		200	16	3	2	2	Regular	-	Thinning	Die-back	-	-	Poor	-	-	-	-	Typical	-	-	-	-	-	-	-	Remove	
4548	Alphitonia excelsa	Soap Tree	180		180	11	5	2	2	Regular	-	-	-	-	-	Typical	-	-	-	-	Typical	-	-	-	-	-	-	-	Remove	
4549	Eucalyptus crebra	Narrow-leaved Ironbark	205		205	18	5	2	2	Regular	-	-	-	-	-	Typical	-	-	-	-	Typical	-	-	-	-	-	-	-	Remove	
4550	Eucalyptus crebra	Narrow-leaved Ironbark	265		265	18	6	3	2	Regular	-	-	-	-	-	Typical	-	-	-	-	Typical	-	-	-	-	-	-	-	Remove	
4551	Eucalyptus crebra	Narrow-leaved Ironbark	340		340	19	8	4	2	Regular	-	-	-	-	-	Typical	-	-	-	-	Typical	-	-	-	-	-	-	-	Remove	
4552	Eucalyptus siderophloia	Grey Ironbark	185		185	13	5	2	2	One-sided	-	-	-	-	-	Typical	Minor	-	Trunk Dmg.	-	Typical	-	-	-	-	-	-	-	Remove	
4553	Eucalyptus tereticornis	Forest Red Gum	390		390	16	8	5	2	Regular	-	-	-	-	-	Typical	-	-	-	-	Typical	-	-	-	-	-	-	-	Remove	
4554	Eucalyptus crebra	Narrow-leaved Ironbark	265		265	15	4	3	2	Regular	-	-	-	-	-	Typical	-	-	-	-	Typical	-	-	-	-	-	-	-	Remove	
4555	Acacia disparrima	Hickory Wattle	205		205	9	4	2	2	Regular	-	-	-	-	-	Typical	-	-	-	-	Typical	-	-	-	-	-	-	-	Remove	
4556	Eucalyptus tereticornis	Forest Red Gum	270		270	18	5	3	2	Regular	-	-	-	-	-	Typical	-	-	-	-	Typical	-	-	-	-	-	-	-	Remove	
4557	Eucalyptus tereticornis	Forest Red Gum	320		320	17	4	4	2	Regular	-	Thinning	Die-back	Epicormic	-	Poor	-	-	-	-	Typical	-	-	-	-	-	-	-	Remove - Fill stockpiling	
4558	Corymbia intermedia	Pink Bloodwood	205		205	16	5	2	2	Regular	-	-	-	-	-	Typical	-	-	-	-	Typical	-	-	-	-	-	-	-	Remove - Fill stockpiling	
4559	Eucalyptus crebra	Narrow-leaved Ironbark	365		365	18	9	4	2	Regular	-	-	-	-	-	Typical	-	-	-	-	Typical	-	-	-	-	-	-	-	Remove - Fill stockpiling	
4560	Eucalyptus tereticornis	Forest Red Gum	200		200	17	6	2	2	One-sided	-	-	-	-	-	Typical	-	-	-	-	Typical	-	-	-	-	-	-	-	Remove - Fill stockpiling	
4561	Eucalyptus tereticornis	Forest Red Gum	325		325	17	7	4	2	Regular	-	-	-	-	-	Typical	-	-	-	-	Typical	-	-	-	-	-	-	-	Remove - Fill stockpiling	
4562	Eucalyptus crebra	Narrow-leaved Ironbark	360		360	17	6	4	2	One-sided	-	-	-	-	-	Typical	-	-	Trunk Dmg.	-	Typical	-	-	-	-	-	-	-	Remove - Fill stockpiling	
4563	Corymbia intermedia	Pink Bloodwood	260	210	334	17	6	4	2	Regular	-	-	-	-	-	Typical	-	-	-	-	Typical	-	-	-	-	-	-	-	Remove	
4564	Corymbia citriodora	Spotted Gum	310		310	19	7	4	2	Regular	-	-	-	-	-	Typical	-	-	-	-	Typical	-	-	-	-	-	-	-	Remove - Fill stockpiling	
4565	Corymbia citriodora	Spotted Gum	185		185	15	5	2	2	Regular	-	-	-	-	-	Typical	-	-	-	-	Typical	-	-	-	-	-	-	-	Remove - Fill stockpiling	
4566	Corymbia citriodora	Spotted Gum	270	145	306	18	7	4	2	Regular	-	-	-	-	-	Typical	-	-	-	-	Typical	-	-	-	-	-	-	-	Remove	
4567	Corymbia citriodora	Spotted Gum	330		330	17	5	4	2	Regular	-	Thinning	Die-back	-	-	Poor	-	-	-	-	Typical	-	-	-	-	-	-	-	Remove	
4568	Alphitonia excelsa	Soap Tree	220		220	11	6	3	2	Regular	-	-	-	-	-	Typical	-	-	-	-	Typical	-	-	-	-	-	-	-	Remove	
4569	Corymbia citriodora	Spotted Gum	165		165	15	5	2	2	Regular	-	-	-	-	-	Typical	-	-	-	-	Typical	-	-	-	-	-	-	-	Remove	
4570	Eucalyptus tereticornis	Forest Red Gum	300		300	18	6	4	2	Regular	-	Thinning	Die-back	-	-	Poor	-	-	-	-	Typical	-	-	-	-	-	-	-	Remove	
4571	Alphitonia excelsa	Soap Tree	135		135	9	4	2	1	Regular	-	-	-	-	-	Typical	-	-	-	-	Typical	-	-	-	-	-	-	-	Remove	
4572	Eucalyptus crebra	Narrow-leaved Ironbark	290		290	18	7	3	2	Regular	-	-	-	-	-	Typical	-	-	-	-	Typical	-	-	-	-	-	-	-	Remove - Fill stockpiling	
4573	Eucalyptus crebra	Narrow-leaved Ironbark	220		220	17	4	3	2	Regular	-	-	-	-	-	Typical	-	-	Trunk Dmg.	-	Typical	-	-	-	-	-	-	-	Remove - Fill stockpiling	
4574	Corymbia citriodora	Spotted Gum	330		330	17	6	4	2	Regular	-	-	-	-	-	Typical	-	-	-	-	Typical	-	-	-	-	-	-	-	Retain	
4575	Acacia leiocalyx	Early-flowering Black Wattle	185		185	6	6	2	2	Regular	-	-	-	-	-	Typical	-	-	-	-	Typical	-	-	-	-	-	-	-	Retain	
4576	Eucalyptus crebra	Narrow-leaved Ironbark	200		200	16	4	2	2	Regular	-	-	-	-	-	Typical	-	-	-	-	Typical	-	-	-	-	-	-	-	Retain	
4577	Acacia leiocalyx	Early-flowering Black Wattle	180	80	197	6	5	2	2	Regular	-	-	-	-	-	Typical	-	-	-	-	Typical	-	-	-	-	-	-	-	Retain	
4581	Eucalyptus tereticornis	Forest Red Gum	200		200	17	5	2	2	Regular	-	-	-	-	-	Typical	-	-	-	-	Typical	-	-	-	-	-	-	-	Retain	
4582	Corymbia citriodora	Spotted Gum	305		305	18	7	4	2	Regular	-	-	-	-	-	Typical	-	-	-	-	Typical	-	-	-	-	-	-	-	Retain	
4583	Eucalyptus tereticornis	Forest Red Gum	145		145	13	5	2	1	Regular	-	-	-	-	-	Typical	-	-	-	-	Typical	-	-	-	-	-	-	-	Retain	
4584	Corymbia citriodora	Spotted Gum	285		285	18	8	3	2	Regular	-	-	-	-	-	Typical	-	-	-	-	Typical	-	-	-	-	-	-	-	Retain	
4585	Eucalyptus tereticornis	Forest Red Gum	205		205	18	3	2	2	Regular	-	-	-	-	-	Typical	-	-	-	-	Typical	-	-	-	-	-	-	-	Retain	
4586	Eucalyptus crebra	Narrow-leaved Ironbark	205		205	12	5	2	2	Regular	-	-	-	-	-	Typical	-	-	-	-	Typical	-	-	-	-	Termite nest	-	-	Retain	
4587	Eucalyptus crebra	Narrow-leaved Ironbark	315		315	19	8	4	2	Regular	-	-	-	-	-	Typical	-	-	-	-	Typical	-	-	-	-	-	-	-	Retain	
4594	Eucalyptus tereticornis	Forest Red Gum	365		365	18	8	4	2	Regular	-	-	-	-	-	Typical	-	-	-	-	Typical	-	-	-	-	-	-	-	Retain	
4595	Corymbia citriodora	Spotted Gum	350		350	19	8	4	2	Regular	-	-	-	-	-	Typical	-	-	-	-	Typical	-	-	-	-	-	-	-	Retain	
4596	Eucalyptus tereticornis	Forest Red Gum	300		300	20	4	4	2	Regular	-	-	-	-	-	Typical	-	-	-	-	Typical	-	-	-	-	-	-	-	Retain	
4597	Eucalyptus crebra	Narrow-leaved Ironbark	260		260	17	5	3	2	Regular	-	-	-	-	-	Typical	-	-	-	-	Typical	-	-	-	-	-	-	-	Retain	
4598	Eucalyptus tereticornis	Forest Red Gum	325		325	17	7	4	2	Regular	-	-	-	-	-	Typical	-	-	-	-	Typical	-	-	-	-	-	-	-	Retain	
4599	Corymbia citriodora	Spotted Gum	305		305	17	9	4	2	Regular	-	-	-	-	-	Typical	-	-	-	-	Typical	-	-	-	-	-	-	-	Retain	
4600	Acacia leiocalyx	Early-flowering Black Wattle	220	140	261	6	6	3	2	Regular	-	-	-	-	-	Typical	-	-	-	-	Typical	-	-	-	-	-	-	-	Retain	
4601	Eucalyptus tereticornis	Forest Red Gum	295		295	18	8	4	2	Regular	-	-	-	-	-	Typical	-	-	-	-	Typical	-	-	-	-	-	-	-	Remove - Fill stockpiling	
4602	Eucalyptus tereticornis	Forest Red Gum	320		320	19	5	4	2	Regular	-	-	-	-	-	Typical	-	-	-	-	Typical	-	-	-	-	-	-	-	Remove - Fill stockpiling	
4603	Acacia leiocalyx	Early-flowering Black Wattle	270		270	8	5	3	2	Regular	-	-	-	-	-	Typical	-	-	-	-	Typical	-	-	-	-	-	-	-	Remove - Fill stockpiling	
4604	Eucalyptus tereticornis	Forest Red Gum	390		390	19	10	5	2	Regular	-	-	-	-	-	Typical	-	-	-	-	Typical	-	-	-	-	-	-	-	Remove - Fill stockpiling	
4605	Corymbia intermedia	Pink Bloodwood	300	100, 90	329	19	8	4	2	Regular	-	-	-	-	-	Typical	-	-	-	-	Typical	-	-	-	Small	-	-	-	Retain	
4606	Eucalyptus crebra	Narrow-leaved Ironbark	360		360	19	8	4	2	Regular	-	-	-	-	-	Typical	-	-												

Tree ID	Specimen Details									Canopy Condition Details							Trunk Condition Details					Fauna Details and Habitat Value							
	Botanical Name	Common Name	Trunk DBH (mm)	Additional Trunks DBH (mm)	Total DBH (mm) [AS 4970-2009]	Height (m)	Spread (m)	Tree Protection Zone (m)	Structural Root Zone (m)	Canopy Form	Spreading	Thinning	Die-Back	Epicormic Growth	Lopped	Canopy Health	Leaning	Vines	Trunk Damage	Fire Damage	Trunk Health	Scats	Scratches	Hollows	Nest	Termite Nest	Habitat Value	Retention	
4612	Corymbia citriodora	Spotted Gum	180	120	180	11	5	2	2	Regular	-	Thinning	-	-	-	Poor	-	-	Trunk Dmg.	-	Poor	-	-	-	-	-	-	Retain	
4613	Corymbia citriodora	Spotted Gum	250		250	14	6	3	2	Regular	-	Thinning	-	-	-	-	Poor	-	-	Trunk Dmg.	-	Poor	-	-	-	-	-	-	Retain
4614	Eucalyptus tereticornis	Forest Red Gum	165		204	12	5	2	2	Regular	-	-	-	-	-	-	Typical	-	-	-	-	Typical	-	-	-	-	-	-	Retain
4615	Acacia disparrima	Hickory Wattle	190		190	6	5	2	2	Regular	-	-	-	-	-	-	Typical	-	-	-	-	Typical	-	-	-	-	-	-	Retain
4616	Eucalyptus tereticornis	Forest Red Gum	320	340, 230	520	18	7	6	3	Regular	-	-	-	-	-	Typical	-	-	-	-	Typical	-	-	-	-	-	-	Remove - Fill stockpiling	
4617	Corymbia intermedia	Pink Bloodwood	270	230	355	14	6	4	2	Regular	-	-	-	-	-	Typical	-	-	-	-	Typical	-	-	-	-	-	-	Remove - Fill stockpiling	
4618	Corymbia citriodora	Spotted Gum	125	230	125	8	3	2	1	Regular	-	-	-	-	-	Typical	-	-	-	-	Typical	-	-	-	-	-	-	Remove - Fill stockpiling	
4619	Eucalyptus tereticornis	Forest Red Gum	270		270	17	5	3	2	Regular	-	Thinning	Die-back	-	-	-	Poor	-	-	-	-	Typical	-	-	-	-	-	-	Remove
4620	Corymbia citriodora	Spotted Gum	160		160	15	3	2	2	Regular	-	-	-	-	-	-	Typical	-	-	-	-	Typical	-	-	-	-	-	-	Remove
4621	Corymbia tessellaris	Moreton Bay Ash	270		270	16	7	3	2	Regular	-	-	-	-	-	-	Typical	-	-	-	-	Typical	-	-	-	-	-	-	Remove
4622	Corymbia citriodora	Spotted Gum	240	270	240	16	3	3	2	Regular	-	Thinning	-	-	-	Typical	-	-	-	-	Typical	-	-	-	-	-	-	Remove	
4623	Corymbia citriodora	Spotted Gum	160		160	13	2	2	2	Regular	-	Thinning	Die-back	-	-	-	Poor	-	-	-	-	Typical	-	-	-	-	-	-	Remove
4624	Corymbia citriodora	Spotted Gum	250		250	16	7	3	2	Regular	-	-	-	-	-	-	Typical	-	-	-	-	Typical	-	-	-	-	-	-	Remove
4625	Corymbia tessellaris	Moreton Bay Ash	200		200	17	5	2	2	Regular	-	-	-	-	-	-	Typical	-	-	-	-	Typical	-	-	-	-	-	-	Remove
4626	Eucalyptus tereticornis	Forest Red Gum	170	270	170	15	4	2	2	Regular	-	-	-	-	-	Typical	-	-	-	-	Typical	-	-	-	-	-	-	Remove	
4627	Eucalyptus moluccana	Gum Topped Box	530		595	23	11	7	3	Regular	-	-	-	-	-	-	Typical	-	-	-	-	Typical	-	-	-	-	-	-	Remove
4628	Corymbia citriodora	Spotted Gum	205		205	16	4	2	2	Regular	-	-	-	-	-	-	Typical	-	-	-	-	Typical	-	-	-	-	-	-	Remove
4629	Eucalyptus tereticornis	Forest Red Gum	220		220	16	5	3	2	Regular	-	Thinning	-	-	-	-	Poor	-	-	-	-	Typical	-	-	-	-	-	-	Remove
4630	Eucalyptus crebra	Narrow-leaved Ironbark	220	200	220	16	5	3	2	Regular	-	Thinning	-	-	-	Poor	-	-	-	-	Typical	-	-	-	-	-	-	Remove	
4631	Angophora floribunda	Rough-barked Apple	160		200	13	5	2	2	Regular	-	-	-	-	-	-	Typical	-	-	-	-	Typical	-	-	-	-	-	-	Remove
4632	Angophora subvelutina	Broad-leaved Apple	660		660	15	8	8	3	Regular	-	-	-	-	-	-	Typical	-	-	-	-	Typical	-	-	-	-	-	-	Remove
4633	Acacia disparrima	Hickory Wattle	160		160	7	4	2	2	Regular	-	-	-	-	Lopped	Typical	-	-	-	-	Typical	-	-	-	-	-	-	-	Retain
4634	Eucalyptus tereticornis	Forest Red Gum	300	360	300	21	7	4	2	Regular	-	-	-	-	-	Typical	-	-	-	-	Typical	-	-	-	-	-	-	Retain	
4635	Corymbia intermedia	Pink Bloodwood	360		360	22	9	4	2	Regular	-	-	-	-	-	-	Typical	-	-	-	-	Typical	-	-	-	-	-	-	Retain
4636	Lophostemon suaveolens	Swamp Box	185		185	12	4	2	2	Regular	-	-	-	-	-	-	Typical	-	-	-	-	Typical	-	-	-	-	-	-	Retain