

LEGEND

-  YARRABILBA SITE BOUNDARY
-  RECONFIGURATION OF A LOT APPLICATION TWO
-  PROPOSED STAGE BOUNDARY

LOT YIELD			LOT AREA		
Lot Type	No. Lots	% Total Lots	Average Size	% of Total Area	Area
T1	1	0.22%	797m ²	0.42%	797m ²
T2	80	17.24%	591m ²	24.89%	47349m ²
C1	7	1.51%	588m ²	2.17%	4121m ²
C2	84	18.10%	483m ²	21.35%	40609m ²
PV	90	19.40%	418m ²	19.80%	37666m ²
V	51	10.99%	328m ²	8.82%	16777m ²
TCY1	2	0.43%	613m ²	0.65%	1227m ²
TCY2	11	2.37%	410m ²	2.37%	4517m ²
TC	27	5.82%	297m ²	4.23%	8043m ²
TV	18	3.88%	261m ²	2.48%	4712m ²
TCE f	32	6.90%	198m ²	3.34%	6355m ²
TRV	33	7.11%	337m ²	5.85%	11121m ²
MFF	20	4.31%	185m ²	1.95%	3717m ²
MFS	3	0.65%	652m ²	1.03%	1957m ²
SMT	5	1.08%	252m ²	0.66%	1262m ²
Total Number of Lots	464				

MINIMUM RESIDENTIAL DENSITY	28.19 du 454 du 16.5 du/ha	MAXIMUM RESIDENTIAL DENSITY	28.19 du 502 du 17.8 du/ha
-----------------------------	----------------------------------	-----------------------------	----------------------------------

LAND USE BUDGET

RESIDENTIAL	19.02 ha
NEW ROAD - LOCAL	7.22 ha
OPEN SPACE - LOCAL	1.94 ha
SUB-TOTAL	28.19 ha
NEW ROAD - MAJOR	1.48 ha
OPEN SPACE - GREENSPACE CORRIDOR AND BUFFERS	4.53 ha
TOTAL ROL APPLICATION 1 AREA	34.20 ha

NOTE:
MINIMUM DWELLINGS is based on the development of one dwelling on each single family lot, two dwellings on each multi family strata (MFS) lot, and one dwelling on each multi family freehold (MFF).

MAXIMUM DWELLINGS for terrace (TCE) and multi family strata (MFS) lots is based on four flats on rear loaded terraces and the development of the maximum number of dwellings on 2014 lots.

DENSITY calculations include the area of residential lots, local roads and local parks.

The boundaries, roads and pathways shown hereon are subject to detailed engineering design, final survey and approval of subsequent development applications by the relevant authorities.

PLANS AND DOCUMENTS
referred to in the PDA APPROVAL

15 DEC 2014

MEDQ

Lend Lease

Date 28 NOV 2014

PRECINCT TWO - RECONFIGURATION OF A LOT APPLICATION TWO **RECONFIGURATION OF A LOT**

NOTE: This plan is indicative only, and specific uses, road alignment, boundaries, setbacks, and building layout shown may vary due to detailed design consideration. ©2014 Lend Lease Communities (Australia). All rights reserved. Except as permitted by Lend Lease, no part of this publication may be reproduced or distributed in any form or by any means, or stored in a database or retrieval system, without the permission of Lend Lease.



AMENDED IN RED

11 DEC 2014

By: BRIANNA FYFFE (name)
MEDQ

LEGEND



YARRABILBA SITE BOUNDARY



RECONFIGURATION OF A LOT
APPLICATION TWO



PROPOSED STAGE BOUNDARY

LOT TYPE	
TRADITIONAL (T1, T2)	
COURTYARD (C1, C2)	
PREMIUM VILLA (PV)	
VILLA (V)	
TOWN COURTYARD (TCY1, TCY2)	
TOWN COTTAGE (TC)	
TOWN VILLA (TV)	
TERRACE FRONT LOADED (TOF)	
TOWN PREMIUM VILLA (TPV)	
MULTI-FAMILY FREEHOLD (MFF)	
MULTI-FAMILY STRATA (MFS)	
SMART LOT (SMT)	

V01S15

PINEHILL

WILKINS

SEAWEST

SUMMERVIEW

PRECINCT TWO - RECONFIGURATION OF A LOT APPLICATION TWO RECONFIGURATION OF A LOT

NOTE: This plan is indicative only, and specific uses, road alignment, boundaries, setbacks, and building layout shown may vary due to detailed design consideration. © 2014 Lend Lease Communities (Australia). All rights reserved. Except as permitted by Lend Lease, no part of this publication may be reproduced or distributed in any form or by any means, or stored in a database or retrieval system, without the permission of Lend Lease.











0 20 40 60 80 100m
Scale 1:2,000 at A3



Lend Lease

LEGEND

-  YARRABILBA SITE BOUNDARY
-  RECONFIGURATION OF A LOT APPLICATION TWO
-  PROPOSED STAGE BOUNDARY

          LOT TYPE	
	TRADITIONAL (T1, T2)
	COURTYARD (C1, C2)
	PREMIUM VILLA (PV)
	VILLA (V)
	TOWN COURTYARD (TCY1, TCY2)
	TOWN COTTAGE (TC)
	TOWN VILLA (TV)
	TERRACE FRONT LOADED (TCF)
	TOWN PREMIUM VILLA (TPV)
	MULTI-FAMILY FREEHOLD (MFF)
	MULTI-FAMILY STRATA (MFS)
	SMART LOT (SMT)

AMENDED IN RED

11 DEC 2014

By: **BRIANNA FUFFE** (name)
MEDQ

PLANS AND DOCUMENTS
referred to in the PDA APPROVAL

15 DEC 2014

MEDQ

ROAD

PRECINCT TWO - RECONFIGURATION OF A LOT APPLICATION TWO RECONFIGURATION OF A LOT

NOTE: This plan is indicative only, and specific uses, road alignment, boundaries, setbacks, and building layout shown may vary due to detailed design consideration. © 2014 Lend Lease Communities (Australia). All rights reserved. Except as permitted by Lend Lease, no part of this publication may be reproduced or distributed in any form or by any means, or stored in a database or retrieval system, without the permission of Lend Lease.



LEGEND

- YARRABILBA SITE BOUNDARY
- RECONFIGURATION OF A LOT APPLICATION TWO
- PROPOSED STAGE BOUNDARY

LOT TYPE	
TRADITIONAL (T1, T2)	
COURTYARD (C1, C2)	
PREMIUM VILLA (PV)	
VILLA (V)	
TOWN COURTYARD (TCY1, TCY2)	
TOWN COTTAGE (TC)	
TOWN VILLA (TV)	
TERRACE FRONT LOADED (TCF)	
TOWN PREMIUM VILLA (TPV)	
MULTI-FAMILY FREEHOLD (MFF)	
MULTI-FAMILY STRATA (MFS)	
SMART LOT (SMT)	

AMENDED IN RED

11 DEC 2014
 By: **BRIANNA FYFFE (name)**
MEDQ

PLANS AND DOCUMENTS
 referred to in the PDA APPROVAL

15 DEC 2014
MEDQ


PRECINCT TWO - RECONFIGURATION OF A LOT APPLICATION TWO RECONFIGURATION OF A LOT

NOTE: This plan is indicative only, and specific uses, road alignment, boundaries, setbacks, and building layout shown may vary due to detailed design consideration. © 2014 Lend Lease Communities (Australia). All rights reserved. Except as permitted by Lend Lease, no part of this publication may be reproduced or distributed in any form or by any means, or stored in a database or retrieval system, without the permission of Lend Lease.



LEGEND

-  YARRABILBA SITE BOUNDARY
-  RECONFIGURATION OF A LOT APPLICATION TWO
-  PROPOSED STAGE BOUNDARY

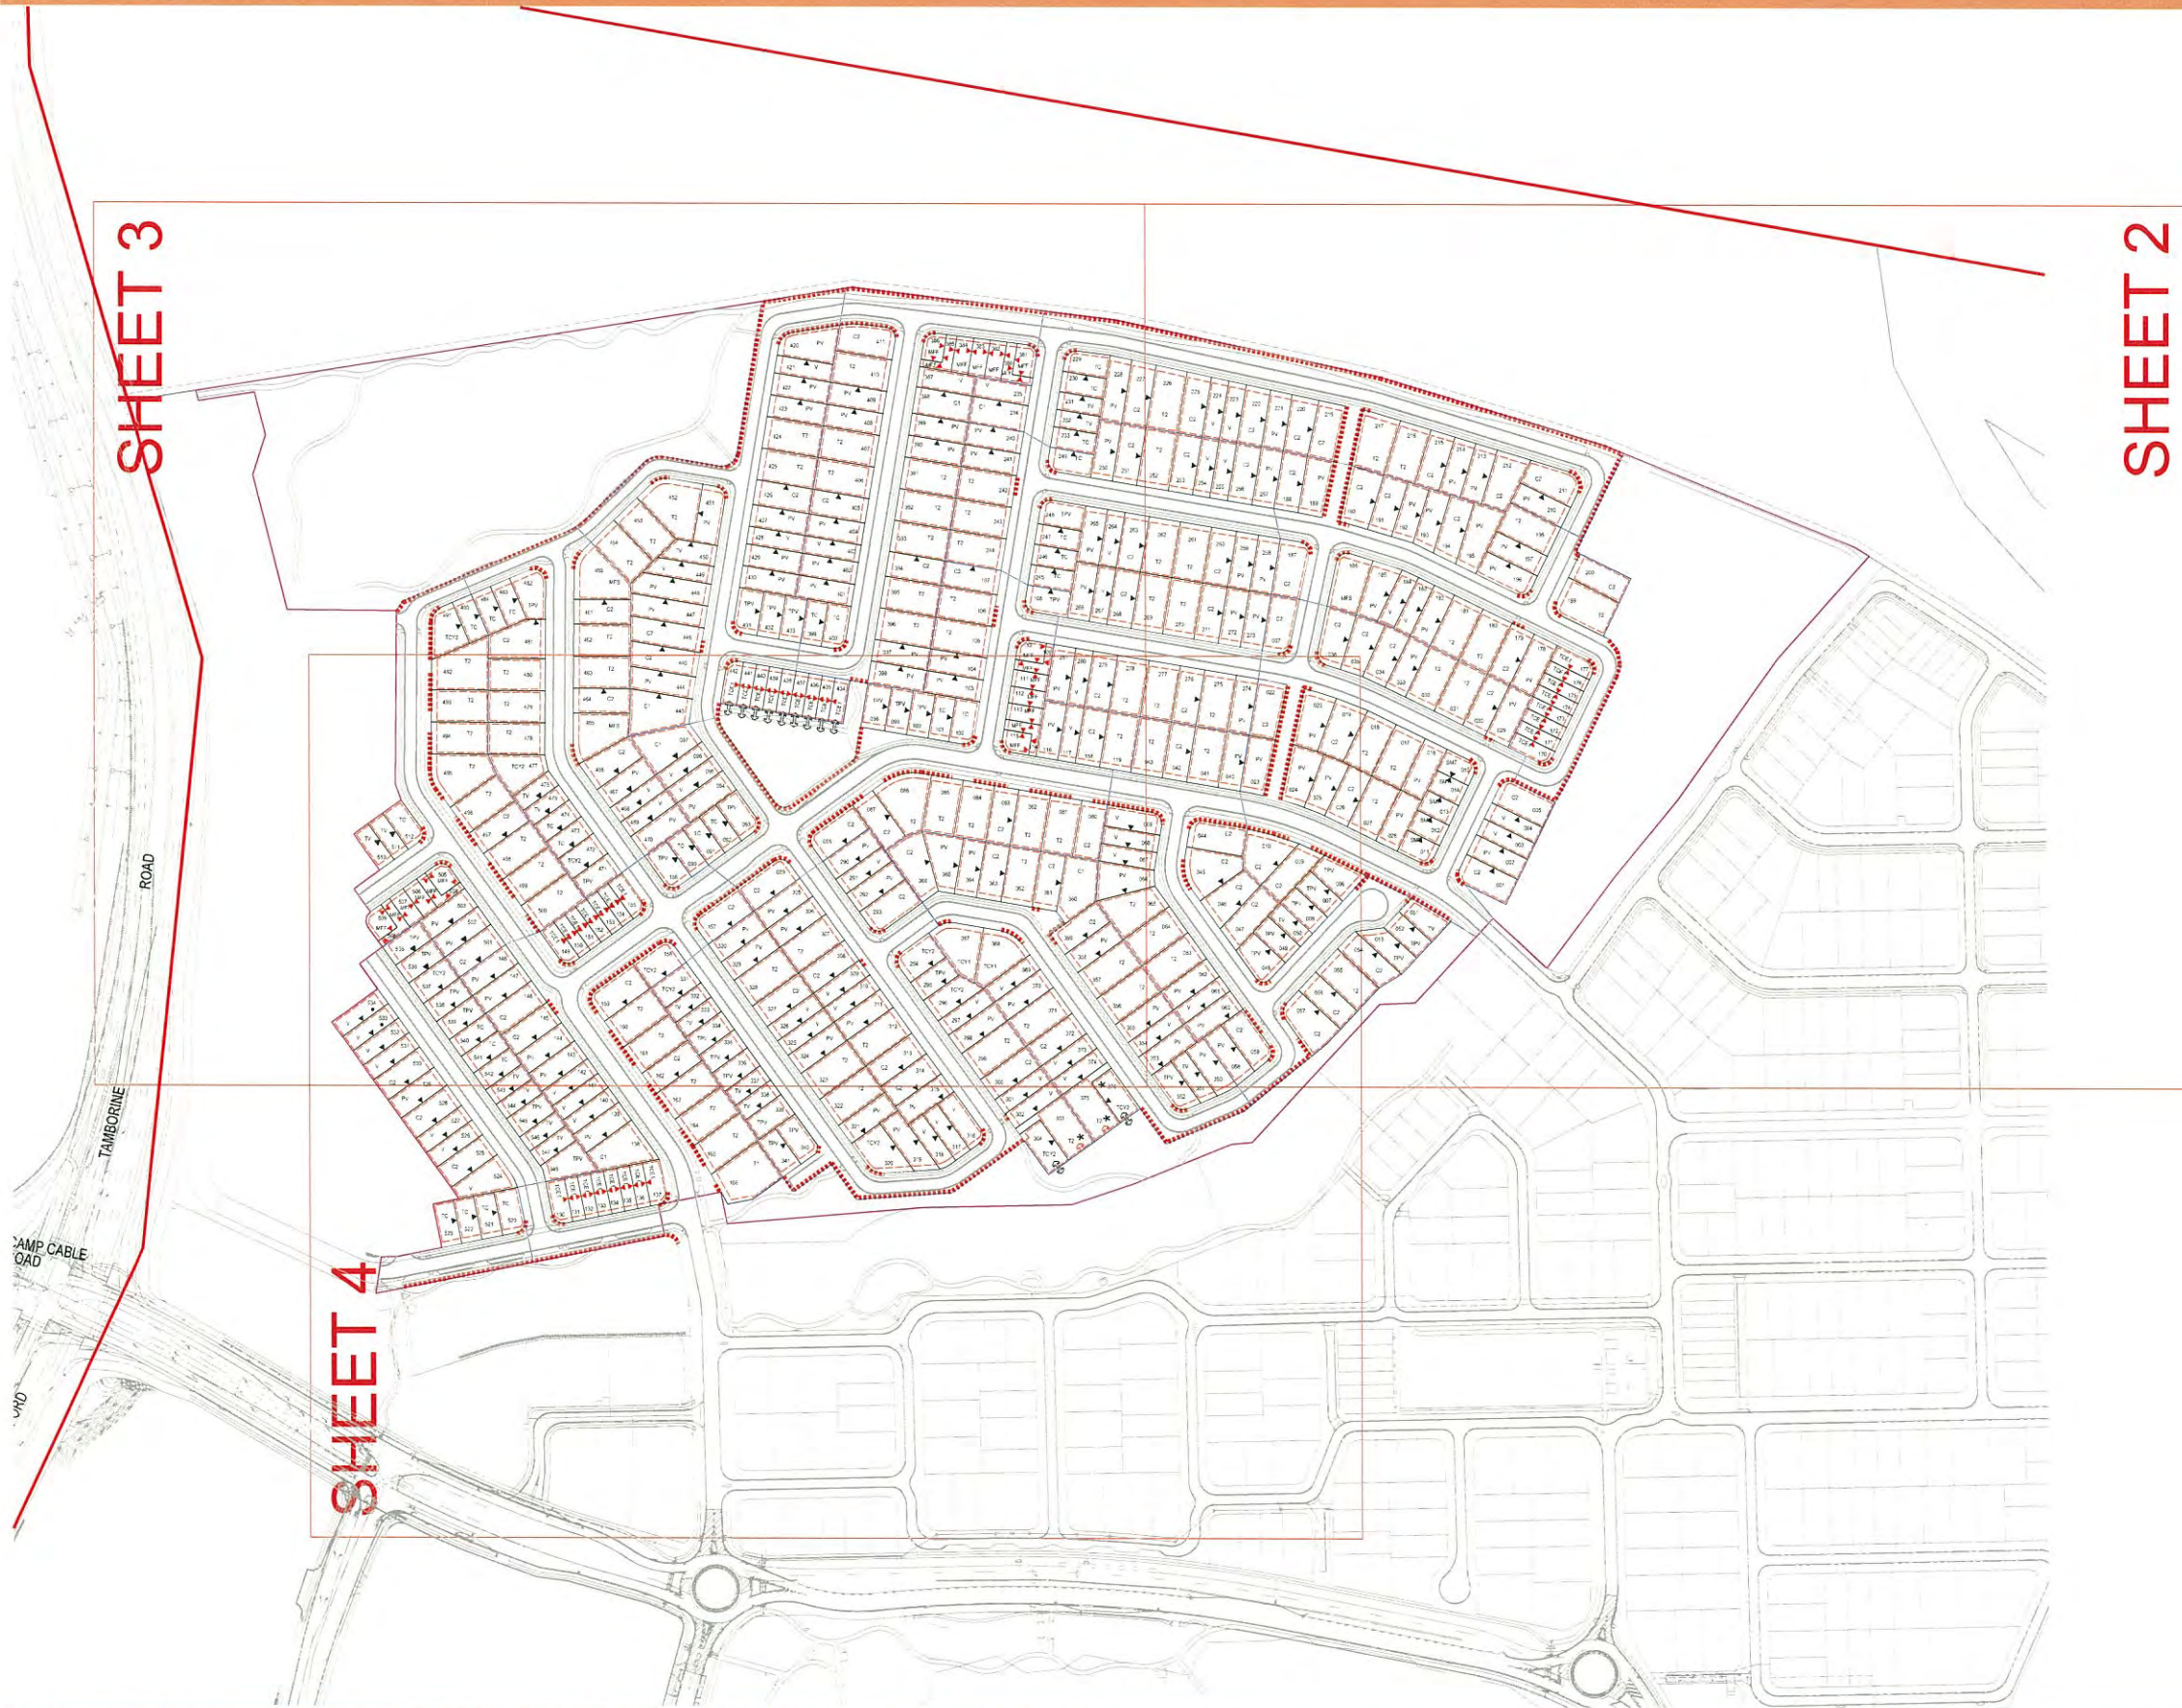

PLANS AND DOCUMENTS
referred to in the PDA APPROVAL

15 DEC 2014

MEDQ

PRECINCT TWO - RECONFIGURATION OF A LOT APPLICATION TWO PLAN OF DEVELOPMENT

NOTE: This plan is indicative only, and specific uses, road alignment, boundaries, setbacks, and building layout shown may vary due to detailed design consideration. © 2014 Lend Lease Communities (Australia). All rights reserved. Except as permitted by Lend Lease, no part of this publication may be reproduced or distributed in any form or by any means, or stored in a database or retrieval system, without the permission of Lend Lease.

0 100 200 300 400 500m

Scale 1:10,000 at A3

North

Lend Lease

AMENDED IN RED

11 DEC 2014

By: **BRIANNA FYFFE** (name)
MEDQ

LEGEND

-  YARRABILBA SITE BOUNDARY
-  RECONFIGURATION OF A LOT APPLICATION TWO
-  PROPOSED STAGE BOUNDARY
-  BUILD TO BOUNDARY LINE
-  MANDATORY BUILD TO BOUNDARY LINE
-  NO VEHICULAR ACCESS
-  MANDATORY PRIMARY STREET FRONTAGE
-  ACOUSTIC ATTENUATION REQUIRED IN DWELLING
-  BUILDING ENVELOPE

SETBACK TABLE

LOT TYPE	FRONT - PRIMARY FRONTAGE	REAR AND SIDE (to wall)	BUILD TO BOUNDARY	FIRST FLOOR SIDE	CORNER LOTS - SECONDARY FRONTAGE
(T1) TRADITIONAL 1	Ground floor 3.0	0.9	N/A	2.0	1.5
(T2) TRADITIONAL 2	Ground floor 3.0	0.9	N/A	1.0	1.5
(C1) COURTYARD 1	Ground floor 3.0	0.9	0.0	1.0	1.5
(C2) COURTYARD 2	Ground floor 3.0	0.9	0.0	1.0	1.5
(TCY1) TOWN COURTYARD 1	Ground floor 3.0	0.9	0.0	1.0	1.5
(TCY2) TOWN COURTYARD 2	Ground floor 3.0	0.9	0.0	1.0	1.5
(PV) PREMIUM VILLA	Ground floor 3.0	0.9	0.0	1.0	1.5
(TPV) TOWN PREMIUM VILLA	Ground floor 3.0	0.9	0.0	1.0	1.5
(V) VILLA	Ground floor 3.0	0.9	0.0	1.0	1.5
(TV) TOWN VILLA	Ground floor 3.0	0.9	0.0	1.0	1.5
(TC) TOWN COTTAGE	Ground floor 3.0	0.9	0.0	1.0	1.5
(TCD) TERRACE (DUAL LOADED)	Ground floor 2.4	0.9	0.0	0.0	1.0
(TCE) TERRACE (DUAL LOADED)	Ground floor 2.4	0.9*	0.0	0.0	1.0
(MFS) MULTIFAMILY STRATA*	Ground floor 3.0	0.9	0.0	1.0	1.5
(MFF) MULTIFAMILY FREEHOLD	Ground floor 2.0	0.9	0.0	1.0	1.5
(SMT) SMART LOT	Ground floor 3.0	0.9	0.0	1.0	1.5


* Includes garages
^ Constitutes Multiple Residential Development

RETAINING WALL HEIGHT TABLE

LOT TYPE	Traditional Premium	Town Courtyard	Premium Villa Town Cottage	Villa Town Villa	Terrace	MFF (Multi Family Freehold) MFS (Multi Family Strata)	Maximum Retaining Height
Earthworks	Cut Average	1.5	1.4	1.25	1.0	0.5	1.8
Front Boundaries	Cut Average	1.5	1.4	Fill Maximum height of 1.0 m	0.5	0.5	1.8
Side Boundaries	Cut Average	1.0	0.7	0.6	0.5	0.5	1.8
Boundaries	Fill Average	1.0	0.7	0.6	0.5	0.5	1.8
Rear Boundary	Cut Average	1.5	1.5	1.5	1.5	1.5	1.8
				Fill Maximum height of 1.0 m			1.8

Note: Retaining walls with a height of 1m or more require RPEQ certification

SPECIAL SITING REQUIREMENTS FOR CORNER ALLOTMENTS

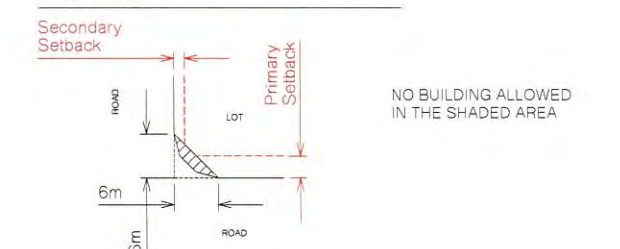

THESE CRITERIA MUST BE READ IN CONJUNCTION WITH RESIDENTIAL PLAN OF DEVELOPMENT SHEET 5 OF 5 [DGN No P02-ROL2-POD141128] - DESIGN CRITERIA FOR RESIDENTIAL DEVELOPMENT

PLANS AND DOCUMENTS referred to in the PDA APPROVAL

15 DEC 2014

MEDQ

PRECINCT TWO - RECONFIGURATION OF A LOT APPLICATION TWO PLAN OF DEVELOPMENT

NOTE: This plan is indicative only, and specific uses, road alignment, boundaries, setbacks, and building layout shown may vary due to detailed design considerations. © 2014 Lend Lease Communities (Australia). All rights reserved. Except as permitted by Lend Lease, no part of this publication may be reproduced or distributed in any form or by any means, or stored in a database or retrieval system, without the permission of Lend Lease.

AMENDED IN RED

11 DEC 2014

By: **BRIANNA FYFFE (name)**
MEDQ

LEGEND

 YARRABILBA SITE BOUNDARY

 RECONFIGURATION OF A LOT APPLICATION TWO

 PROPOSED STAGE BOUNDARY

 BUILD TO BOUNDARY LINE

 MANDATORY BUILD TO BOUNDARY LINE NO VEHICULAR ACCESS

 MANDATORY PRIMARY STREET FRONTAGE

 ACOUSTIC ATTENUATION REQUIRED IN DWELLING

 BUILDING ENVELOPE

 ACOUSTIC ATTENUATION REQUIRED IN DWELLING

SETBACK TABLE

LOT TYPE		FRONT - PRIMARY FRONTAGE	REAR AND SIDE (to wall)	BUILD TO BOUNDARY	FIRST FLOOR SIDE	CORNER LOTS - SECONDARY FRONTAGE	
(T1)	TRADITIONAL 1	Ground floor	3.0	0.9	N/A	2.0	1.5
(T2)	TRADITIONAL 2	Ground floor	3.0	0.9	N/A	1.0	1.5
(C1)	COURTYARD 1	Ground floor	3.0	0.9	0.0	1.0	1.5
(C2)	COURTYARD 2	Ground floor	3.0	0.9	0.0	1.0	1.5
(TCY1)	TOWN COURTYARD 1	Ground floor	3.0	0.9	0.0	1.0	1.5
(TCY2)	TOWN COURTYARD 2	Ground floor	3.0	0.9	0.0	1.0	1.5
(PV)	PREMIUM VILLA	Ground floor	3.0	0.9	0.0	1.0	1.5
(TPV)	TOWN PREMIUM VILLA	Ground floor	3.0	0.9	0.0	1.0	1.5
(V)	VILLA	Ground floor	3.0	0.9	0.0	1.0	1.5
(TV)	TOWN VILLA	Ground floor	3.0	0.9	0.0	1.0	1.5
(TC)	TOWN COTTAGE	Ground floor	3.0	0.9	0.0	1.0	1.5
(TCF)	TERRACE (FRONT LOADED)	Ground floor	2.4	0.9	0.0	0.0	1.0
(TCD)	TERRACE (DUAL LOADED)	Ground floor	2.4	0.9*	0.0	0.0	1.0
(MFS)	MULTI-FAMILY STRATA*	Ground floor	3.0	0.9	0.0	1.0	1.5
(MFF)	MULTI-FAMILY FREEHOLD	Ground floor	2.0	0.9	0.0	1.0	1.5
(SMI)	SMART LOT	Ground floor	3.0	0.9	0.0	1.0	1.5

*Includes garages


^ Constitutes Multiple Residential Development

RETAINING WALL HEIGHT TABLE

LOT TYPE	Traditional Residential	Town Courtyard	Premium Villa Town Cottage	Villa Town Villa	Terrace	MFF (Multi Family Freehold)	MFS (Multi Family Strata)	Maximum Retaining Height
Front Boundaries	Cut Average	1.5	1.4	1.25	1.0	0.5	0.5	1.8
Side Boundaries	Cut Average	1.0	0.7	0.6	0.5	0.5	0.5	1.5
Rear Boundaries	Cut Average	1.0	0.7	0.6	0.5	0.5	0.5	1.0
Boundary	Cut Average	1.5	1.5	1.5	1.5	1.5	1.5	1.0

Note: Retaining walls with a height of 1m or more require RPEQ certification

SPECIAL SITING REQUIREMENTS FOR CORNER ALLOTMENTS

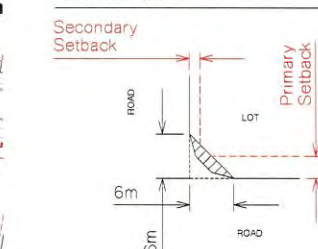

NO BUILDING ALLOWED IN THE SHADED AREA

THESE CRITERIA MUST BE READ IN CONJUNCTION WITH RESIDENTIAL PLAN OF DEVELOPMENT SHEET 5 OF 5 [DGN No P02-ROL2-POD141128] - DESIGN CRITERIA FOR RESIDENTIAL DEVELOPMENT

PLANS AND DOCUMENTS referred to in the PDA APPROVAL

15 DEC 2014

MEDQ

PRECINCT TWO - RECONFIGURATION OF A LOT APPLICATION TWO PLAN OF DEVELOPMENT

NOTE: This plan is indicative only, and specific uses, road alignment, boundaries, setbacks, and building layout shown may vary due to detailed design considerations. © 2014 Land Lease Communities (Australia). All rights reserved. Except as permitted by Land Lease, no part of this publication may be reproduced or distributed in any form or by any means, or stored in a database or retrieval system, without the permission of Land Lease.


LEGEND

-  YARRABILBA SITE BOUNDARY
-  RECONFIGURATION OF A LOT APPLICATION TWO
-  PROPOSED STAGE BOUNDARY
-  BUILD TO BOUNDARY LINE
-  MANDATORY BUILD TO BOUNDARY LINE NO VEHICULAR ACCESS
-  NON-STANDARD BUILDING ENVELOPE
-  MANDATORY PRIMARY STREET FRONTAGE
-  ACOUSTIC ATTENUATION REQUIRED IN DWELLING
-  BUILDING ENVELOPE
-  ACOUSTIC ATTENUATION REQUIRED IN DWELLING

SETBACK TABLE


LOT TYPE	FRONT - PRIMARY FRONTAGE	REAR AND SIDE (to wall)	BUILD TO BOUNDARY	FIRST FLOOR SIDE	CORNER LOTS - SECONDARY FRONTAGE
(T1) TRADITIONAL 1	Ground floor 3.0	0.9	N/A	2.0	1.5
(T2) TRADITIONAL 2	Ground floor 3.0	0.9	N/A	1.0	1.5
(C1) COURTYARD 1	Ground floor 3.0	0.9	0.0	1.0	1.5
(C2) COURTYARD 2	Ground floor 3.0	0.9	0.0	1.0	1.5
(TCY1) TOWN COURTYARD 1	Ground floor 3.0	0.9	0.0	1.0	1.5
(TCY2) TOWN COURTYARD 2	Ground floor 3.0	0.9	0.0	1.0	1.5
(PV) PREMIUM VILLA	Ground floor 3.0	0.9	0.0	1.0	1.5
(TPV) TOWN PREMIUM VILLA	Ground floor 3.0	0.9	0.0	1.0	1.5
(V) VILLA	Ground floor 3.0	0.9	0.0	1.0	1.5
(TV) TOWN VILLA	Ground floor 3.0	0.9	0.0	1.0	1.5
(TC) TOWN COTTAGE	Ground floor 3.0	0.9	0.0	1.0	1.5
(TCP) TERRACE (FRONT LOADED)	Ground floor 2.4	0.9	0.0	0.0	1.0
(TCD) TERRACE (DUAL LOADED)	Ground floor 2.4	0.9	0.0	0.0	1.0
(MFS) MULTIFAMILY STRATA	Ground floor 3.0	0.9	0.0	1.0	1.5
(MFF) MULTIFAMILY FREEHOLD	Ground floor 2.0	0.9	0.0	1.0	1.5
(SMT) SMART LOT	Ground floor 3.0	0.9	0.0	1.0	1.5

* Includes garages
^ Constitutes Multiple Residential Development

RETAINING WALL HEIGHT TABLE

LOT TYPE	Traditional Redline	Town Courtyard	Premium Villa Town Premium Villa	Villa Town Villa	Terrace	MFF (Multi Family Freehold) MFS (Multi Family Strata)	Maximum Retaining Height
Front Boundaries	Cut Average 1.5	1.4	1.25	1.0	0.5	0.5	1.0
Side Boundaries	Cut Average 1.0	0.7	0.6	0.5	0.5	0.5	1.0
Back Boundaries	Cut Average 1.0	0.7	0.6	0.5	0.5	0.5	1.0
Boundary	Cut Average 1.5	1.5	1.5	1.5	1.5	1.5	1.0

Note: Retaining walls with a height of 1m or more require RPEQ certification

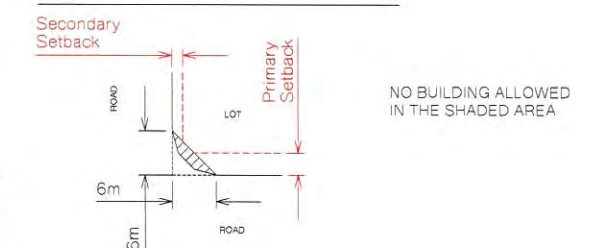SPECIAL SITING REQUIREMENTS FOR CORNER ALLOTMENTS


THESE CRITERIA MUST BE READ IN CONJUNCTION WITH RESIDENTIAL PLAN OF DEVELOPMENT SHEET 5 OF 5 [DGN No P02-ROL2-POD141128] - DESIGN CRITERIA FOR RESIDENTIAL DEVELOPMENT

PLANS AND DOCUMENTS referred to in the PDA APPROVAL

15 DEC 2014

MEDQ

PRECINCT TWO - RECONFIGURATION OF A LOT APPLICATION TWO PLAN OF DEVELOPMENT

NOTE: This plan is indicative only, and specific uses, road alignment, boundaries, setbacks, and building layout shown may vary due to detailed design consideration. © 2014 Lend Lease Communities (Australia). All rights reserved. Except as permitted by Lend Lease, no part of this publication may be reproduced or distributed in any form or by any means, or stored in a database or retrieval system, without the permission of Lend Lease.

DESIGN CRITERIA FOR RESIDENTIAL DEVELOPMENT

The following guidelines apply to all detached dwellings and freehold terraces. Apartments, strata title and other units not held in freehold will be subject to additional design criteria as listed below.

1. General:
 - (i) Easements over infrastructure have not been shown which may affect setbacks. Eaves must not protrude into easements.
 - (ii) The maximum height of unattached buildings shall not exceed 8.5m and for attached buildings or lots greater than 450sqm a building height of 10.5m may be permitted as measured from the natural ground level.
 - (iii) It is assumed that the pad level of each block will be the average of the four corners of the block. Buildings will be built to this pad level unless the consent of property owners on both sides of the block is obtained to vary the pad level.
 - (iv) Where allotments are so marked, the house construction must comply with the current Australian Standard for Domestic Construction regarding acoustics (AS 3671:1989 *Acoustic-Road traffic noise intrusion Building siting and construction*) such that the indoor noise levels from AS/NZS 2107:2000 of 40dB(A) for bedrooms and 45dB(A) for living rooms are achieved.
2. Eaves and Roof Pitch:
 - (i) All roofs must incorporate eaves of at least 450mm to any street or park frontage.
 - (ii) Hip roofs are preferred to be of a pitch of between 20 and 35 degrees.
 - (iii) Skillion roofs are preferred to be a pitch of between 7 and 15 degrees.
 - (iv) Roof pitches outside of these requirements will be considered on architectural merit.
3. Setbacks:
 - (i) Setbacks are as per the Setback Table included on the Plan of Development unless otherwise specified.
 - (ii) Setbacks to the first floor and second floor (where permitted) are the same as those of the ground floor excluding on build to boundary walls where any floors above the ground floor must be setback a minimum of 1.0 metre.
 - (iii) All setbacks are measured to the wall. No projection will be closer to a side boundary than 450mm including gutter of fascia, with the exception of any eave returning to a build to boundary wall.
 - (iv) Front verandah and covered areas to the front door are permitted to extend into the front setback on the condition that the roofed area is not enclosed. For front setbacks, this roofed area can extend to 1.0m from the front property line.
 - (v) **Build to boundary lines are nominated on this Plan of Development. Built to boundary wall lengths are to accord with Note 14 of this Plan of Development**
 - (vi) **Parapets are considered to be a wall and are to comply with the Setback Table included on this Plan of Development.**
 - (vii) Buildings to be sited in accordance with the 'Special Siting Requirements for Corner Allotments.'
 - (viii) Front setbacks on corner lots are determined by the frontage that the front facade is addressing, for example, if the facade is facing the primary frontage it needs to be in accordance with the front setback.
4. Site Cover and Amenity:
 - (i) Site cover for each lot is not to exceed the following:
 - a. 80% for dual attached lots;
 - b. 70% for build to the boundary lots;
 - c. 60% for lots that do not use a build to boundary;
 - d. 60% Multi Family Strata (MFS) lots.
 - (ii) Total outdoor private open space accessible from the ground floor dwelling, either covered or uncovered, should be generally flat without any fall exceeding 70mm vertical for every 1.0 m horizontally. The total outdoor space should equal at least 15% of the total site area. Refer to specific requirements for MFS lots.
5. Parking, Garages and Carports:
 - (i) It is the requirement that at least one covered space per dwelling is off street.
 - (ii) All garages and carports to primary and secondary frontages on detached, MFF, MFS, SMT and GAR lots must be setback a minimum of 5.0m to the wall of the garage and a further 240mm to any garage door. The eave requirement must comply with item 2(i) above. The extended roofs allowed in note 3(iv) are not permitted in front of garage doors or carports. (Excluding Multi-family freehold product)
 - (iii) TCF product, excluding those on a corner lot must have a single or tandem garage integrated into the dwelling, with 5.0m to the front wall at the garage and a further 240mm to the garage door. Corner lot TCF product can provide a double garage or carport on the secondary frontage at the rear of the house with a 1.0m side setback to the wall and a further 240mm to the garage door.
 - (iv) All TCD product must locate the garaging to the rear lane. TCD product over 5.99m wide can have a double garage (max width 6.0m) with the wall setback a minimum of 0.9m with a further 240mm to the garage door. TCD product under 6.0m wide can only have a single or tandem garage to the same setback requirements.
 - (v) Carports must include a roof design, design features and materials which are consistent with the form and materials of the home.
 - (vi) Carports must include either a garage door at the front or screening to the rear.
 - (vii) **Double garages for narrow lots (10m-12.49m) are to comply with Note 16 on this Plan of Development**
6. Driveways:
 - (i) The driveway must be laid at the grade of the adjacent verge area. No grade changes to the verge for the construction of a driveway will be allowed. Where there is a footpath within the verge (either installed or to be installed post house construction) the material of the footpath including joints and edges must be maintained with the driveway commencing from either edge.
 - (ii) Maximum driveway grades within lots must not exceed 1:5, or 1:4 with transitions at both ends of the driveway.
 - (iii) The finish of the driveway is not to be plain concrete.
 - (iv) Driveways must be offset at least 300mm from the side property boundary.
 - (v) Driveways must be completed prior to occupation and be located as shown on the approved Functional Layout Roadworks Plan, unless otherwise agreed to by DSDIP
 - (vi) Driveways across the verge must comply with the local council requirements and widths cannot exceed 3.0m for a single garage or 5.0m for a double garage.
 - (vii) **Driveways are to accord with Logan City Council's standards. Prior to construction, approval from Logan City Council for Vehicular Access to Residential Premises is required**
7. Retaining Walls, Earthworks and Sloping Land:
 - (i) Retaining wall heights must not exceed those nominated in the Retaining Wall Heights table included on the Residential Plan of Development.
 - (ii) If these requirements are not able to be achieved, construction methods other than slab on ground construction are to be used. If elevated construction is to be used, under floor services must be located or screened to minimise their appearance to adjoining properties and public spaces.
 - (iii) Retaining walls forward of the building line to any street, park or lane front or visible from any public realm cannot exceed 1.0 m in height. All other retaining walls cannot exceed 1.8m in height without stepping elements incorporated.
 - (iv) Where the block allows for build to the boundary, the build to the boundary wall must be projected to 150mm below the likely pad level of the adjacent block. The pad level can be assumed to be the average of the four corners of the adjacent block using the As Built levels. The build down of the build to boundary wall must be in a material consistent with the wall above it.
 - (v) The front wall of the home must not be more than 50% below the midpoint level of the front boundary.

- 8.External Building Materials:

No raw, unfinished or untreated materials are permitted for external building works. This includes galvanised iron, zinc or aluminium coated steel, corrugated or unpainted fibre cement sheeting and bare, painted or uncoloured concrete block work or commons brickwork. Other materials will be considered on their architectural merits eg natural stone.
 - 9.Front Facade Articulation:

Facades of the home fronting the street must include a highly visible entry and two of the following elements - a verandah, porch or portico, feature window, front facing entry doors, oversized entry doors or feature walls to enhance the presentation of the home to the street.
 - 10.Homes with more than one Visible Facade (Corner Homes):

Homes which have a secondary street frontage or are located directly adjacent to a park must be designed to address these frontages through the use of feature windows, decorative fencing, and detailing to match the front elevation.
 11. Fencing:
 - (i) No front fencing is desirable on primary street frontages in order to ensure the predominance of landscaping in front of buildings.
 - (ii) Any fencing on the primary street frontage is to be a maximum of 1.2 metres in height and decorative in style, with the exception of regulation fencing required around pools.
 - (iii) Fencing up to 1.5 m in height will be permitted on primary street frontages if it is:
 - a. an open style fence that is 50% transparent, or
 - b. is a courtyard wall constructed of face brickwork or masonry piers with coloured render or textured finish, or
 - c. is of architectural merit.
 - (iv) Fencing provided to a secondary street frontage can be up to 1.8 metres in height and must be decorative fencing.
 - (v) All side fencing must either return to the house a minimum of 1.0 metre behind the front building line or continue forward of the front building line as decorative fencing.
 - (vi) Decorative fencing is to be constructed of rendered and painted masonry piers or painted or stained posts, with infill panels of coloured metal tube, painted or stained timber palings or horizontal battens. Timber paling fences will only be accepted if they are painted in a colour which complements the design of the home, and treated with decorative capping or trims and provided with pronounced posts.
 - (vii) Secondary fencing must finish 4.0m behind the front wall of your home.
 - (viii) Untreated or coloured metal sheeting, fibrous cement or non-decorative timber fencing is not acceptable as a decorative fence.
 - (ix) Fencing and retaining walls erected by Lend Lease must not be altered, removed or modified in any way, without the prior written approval from Lend Lease.
 - (x) Fencing for TCD lots to the rear lane must include a fence to the portion of the lane frontage not occupied by the garage. This portion of fence must include a pedestrian entry from the lane
 12. Landscaping:
 - (i) At least 50% of your front yard is landscaped with grass and/or garden beds. A significant portion of this area must include gardens with trees and/or shrubs capable of growing 3.0m tall and at least 600mm high at the time of planting. Please refer to the preferred Yarrabilba plant species list for guidance.
 - Outdoor Structure and Services
 - (i) All outdoor structures visible from the street or public spaces including but not limited to, roof or wall mounted air-conditioning units, satellite dishes, antennas, water tanks and clotheslines must be suitably screened and located to minimise detrimental visual impact.
 - (ii) Solar panels and collectors for hot water units are the exception to this standard when orientated to maximise their effectiveness.
 14. Build to Boundary Wall Lengths & Particular Requirements
 - (i) The maximum length of build to boundary for any detached lot, SMT or GAR shall be 15m.
 - (ii) The maximum length of build to boundary for any TCF product shall be 18m and for and TCD product shall be 20 m.
 - (iii) **For the MFF product, built to boundary walls are to generally accord with the relevant approved Typical House Plans - Lots less than 250m2**
- 15. ADDITIONAL DESIGN CRITERIA FOR MULTI FAMILY STRATA (MFS) LOTS (CONSISTUTES MULTIPLE RESIDENTIAL DEVELOPMENT)**
- (i) MFS lots are defined as a set of two or more dwellings on a single allotment which address all street frontages with the appearance of a traditional single residential dwelling.
 - (ii) **Each dwelling must** include a laundry, food preparation area, sanitary facilities, bin storage area and clothes drying area. The clothes drying and bin storage areas must not be visible from any street frontage.
 - (iii) All dwellings must be sited in accordance with the Residential Plan of Development.
 - (iv) Buildings must address all streets as primary frontages with a minimum of one (1) dwelling per street frontage.
 - (v) Lots that have park frontage are to address the park through the inclusion of at least three of the following design elements:
 - a. A verandah, porch or portico;
 - b. Awning and shade structures;
 - c. Variation to roof and building lines;
 - d. Inclusion of window openings; and
 - e. Use of varying building materials and treatments.
 - (vi) All buildings with a width of more than 10 metres that are visible from a road or a park are to be articulated to reduce the mass of the building by one or more of the following:
 - a. Windows are recessed into the facade;
 - b. Balconies, porches or verandahs are provided;
 - c. Window hoods are provided; or
 - d. Shadow lines are created on the building through minor changes in the facade (100mm minimum).
 - (vii) The extent of garages must not exceed 40 percent of the lot frontage on any street frontage except where Double Garages on Narrow Lot Requirements are met.
 - (viii) Private outdoor living space must be provided at a minimum of 25m² for each dwelling. Outdoor living space must:
 - a. Incorporate a minimum of one single area of 16m² on the ground floor or 12m² for elevated areas of outdoor living space;
 - b. Primary outdoor spaces must be accessible from the indoor living spaces and must have a minimum dimension of 4.0 metres for ground level living or 2.0 metres for elevated outdoor living spaces. Primary spaces must not have a slope of more than 10%; and
 - c. Private outdoor living spaces must be clearly delineated for each dwelling.

- 16. Double Garages on Narrow Lots Residential Lots**
Double garages for Lots between 10m -12.49m inwidth are permitted provided the following design criteria are followed:
1. The garage door:
 - i. Width must not exceed 4.8m;
 - ii. Must have a minimum 450mm eave above it;
 - iii. Must be setback a minimum of 230mm behind the pillar of the garage door; and
 - iv. Must have a sectional, tilt or roller door.
 - 2a. Excluding the garage, the front façade of the dwelling must include a front verandah, porch or portico extending 1600mm forward of the front wall with the following:
 - i. Front piers with distinct materials and/or colours to the front façade of the dwelling;
 - ii. A front door and windows with a sidelight.

OR

- 2b. Alternatively, the front wall of the house can be setback to align with the rear of the garage if a gatehouse and front yard landscaping or courtyard wall and front yard landscaping on the front property boundary are part of the proposal. Pergola structures between the gatehouse and the house entry can also be included.

AMENDED IN RED

11 DEC 2014

By: BRIANNA PIFFE (name)
MEDQ

PLANS AND DOCUMENTS
referred to in the PDA APPROVAL


15 DEC 2014

MEDQ

THESE CRITERIA MUST BE READ IN CONJUNCTION
WITH RESIDENTIAL PLAN OF DEVELOPMENT
SHEETS 1 TO 4 [Dgn No. P02V01.ROL2-POD141128]

PRECINCT TWO - RECONFIGURATION OF A LOT APPLICATION TWO PLAN OF DEVELOPMENT - DESIGN CRITERIA FOR RESIDENTIAL DEVELOPMENT

NOTE: This plan is indicative only, and specific uses, road alignment, boundaries, setbacks, and building layout shown may vary due to detailed design consideration. © 2014 Lend Lease Communities (Australia). All rights reserved. Except as permitted by Lend Lease, no part of this publication may be reproduced or distributed in any form or by any means, or stored in a database or retrieval system, without the permission of Lend Lease.

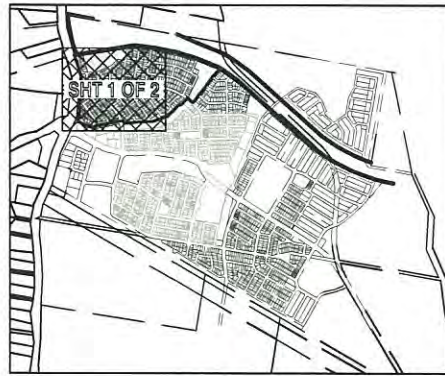

KEY PLAN
SCALE 1 : 25,000

LEGEND

- STAGE BOUNDARY
- PROPOSED KERB FACE
- PROPOSED ROAD CENTRELINE
- PROPOSED 'GREENWAY CORRIDOR'
- PROPOSED FOOTPATH
- PROPOSED LINEMARKING (EDGE)
- PROPOSED LINEMARKING (LANE LINE)
- REMNANT OF CONCERN REGIONAL ECOSYSTEM
- NOMINATED DRIVEWAY LOCATION

ACOUSTIC TREATMENT
REFER KN DWG
13-106-SK 60-62

EXISTING SALES
BUILDING TO BE
REMOVED

DRIVEWAY CONFIGURATION
TO BE CONFIRMED DURING
DETAIL DESIGN


MAJOR PEDESTRIAN LINK
ALIGNMENT TO BE CONFIRMED
DURING DETAIL DESIGN

MAJOR PEDESTRIAN LINK
ALIGNMENT TO BE CONFIRMED
DURING DETAIL DESIGN

PLANS AND DOCUMENTS
referred to in the PDA APPROVAL

15 DEC 2014

MEDQ

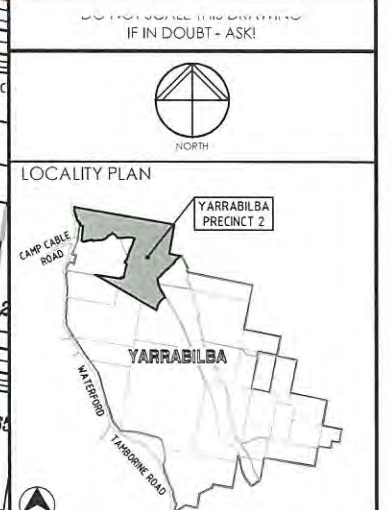

REVISIONS

No	Description	Date	By
A	APPROVAL	01/09/14	NC
B	BUS BAYS AMENDED	24/10/14	NC
C	LOT LAYOUT AMENDED	07/11/14	JA

Associated Consultants

RPS

RPS Australia East Pty Ltd
ACN 140 292 762
ABN 44 140 292 762
Suite 4, Robina East Quay Corporate Park,
(North Building) 34-38 Glenferrie Drive, Robina
PO Box 1048 Robina QLD 4225
T +61 7 555 36600
F +61 7 555 36699
W rpsgroup.com.au

Client

Lend Lease

Project

YARRABILBA

PRECINCT 2
PRELIMINARY PLANNING
FUNCTIONAL LAYOUT

KN GROUP PTY LTD
CONSULTING ENGINEERS


LEVEL 2 - 71 GREY STREET
SOUTH BRISBANE
QUEENSLAND 4101
PHONE 07 3017 1900
FAX 07 3017 1911
EMAIL kn@knpl.com.au
ABN 35 112 053 611


Approved - RPEQ 13805

Drawing Title

**V01 FUNCTIONAL LAYOUT
ROADWORKS PLAN
SHEET 1 OF 2**

Drawn	JAS	Designed	JAS	Checked	GBG	Date	SEPT 14
Scale	AS SHOWN						Sheet 1 of 5
Drawing No	A1 13-106-SK051						Revision C

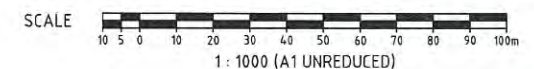

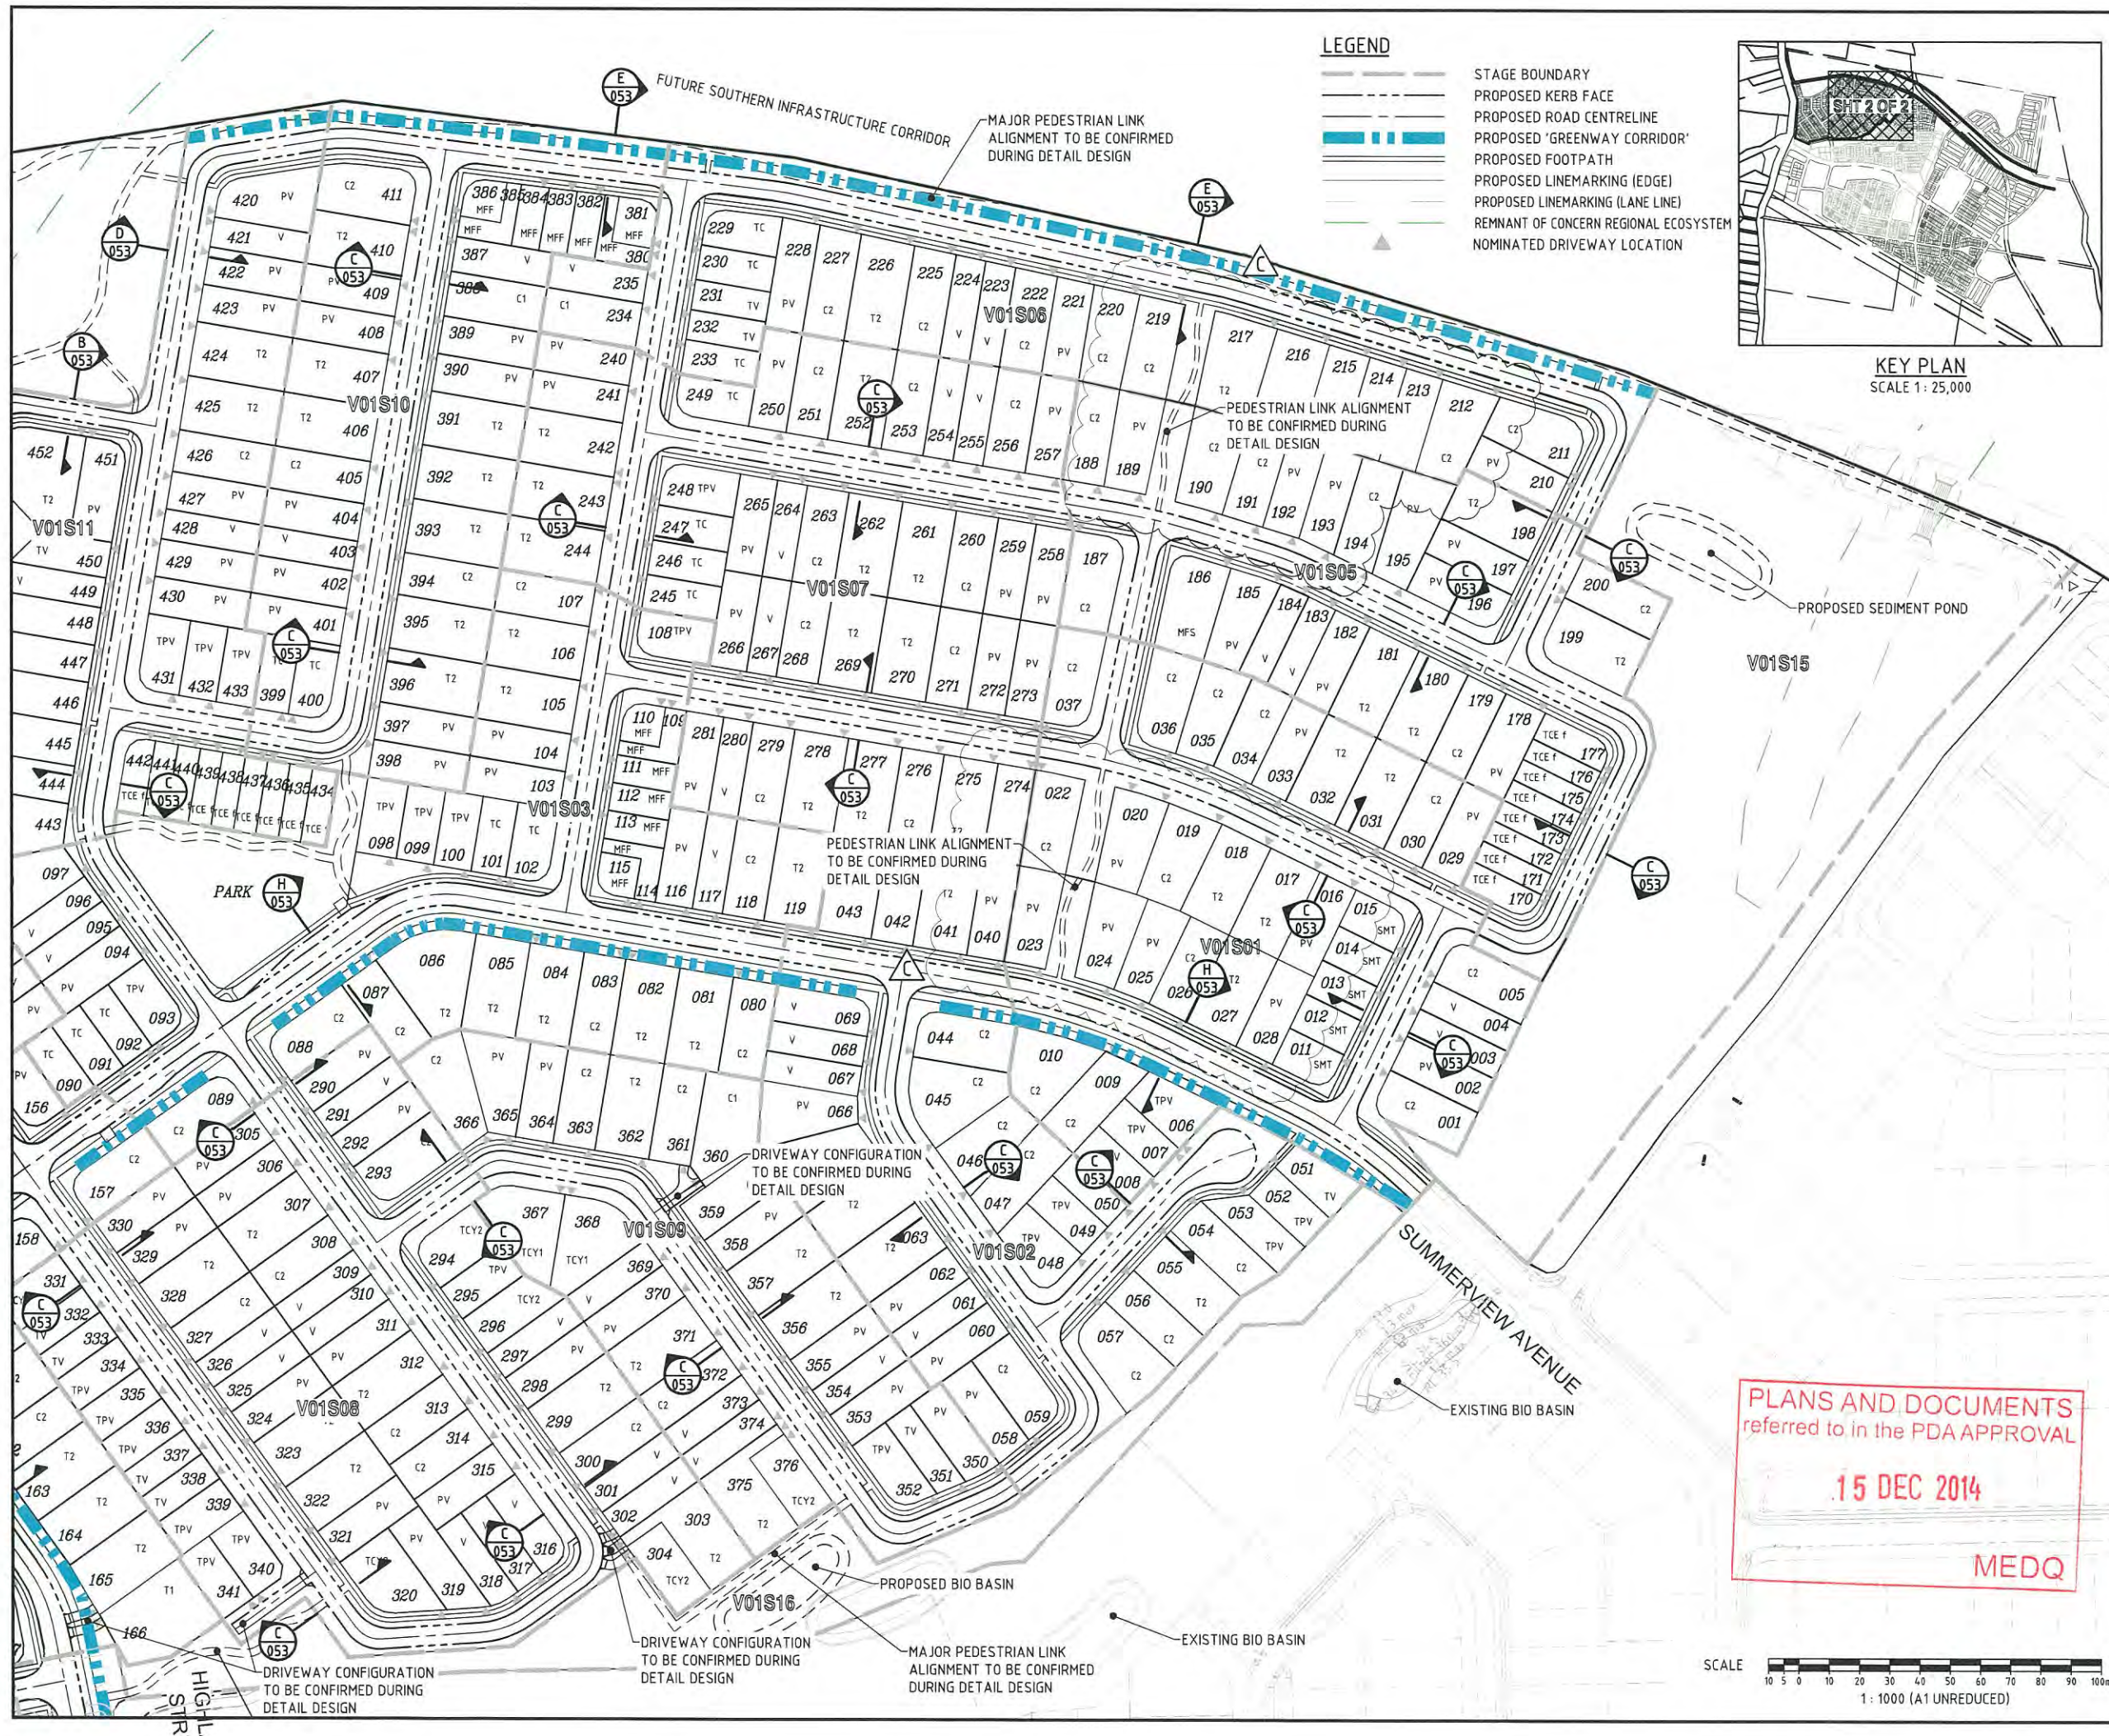

LEGEND

- STAGE BOUNDARY
- PROPOSED KERB FACE
- PROPOSED ROAD CENTRELINE
- PROPOSED 'GREENWAY CORRIDOR'
- PROPOSED FOOTPATH
- PROPOSED LINEMARKING (EDGE)
- PROPOSED LINEMARKING (LANE LINE)
- REMNANT OF CONCERN REGIONAL ECOSYSTEM
- NOMINATED DRIVEWAY LOCATION



KEY PLAN
SCALE 1:25,000

DO NOT SCALE THIS DRAWING
IF IN DOUBT - ASK!

NORTH

LOCALITY PLAN

CAMP CABLE ROAD

YARRABILBA

YARRABILBA PRECINCT 2


REVISIONS

No	Description	Date	By
A	APPROVAL	01/09/14	NC
B	BUS BAYS AMENDED	24/10/14	NC
C	LOT LAYOUT AMENDED	07/11/14	JA

Associated Consultants

RPS

RPS Australia East Pty Ltd
ACN 140 282 762
ABN 44 140 282 762
Suite 4, Rohna East Quay Corporate Park
(North Building) 34-36 Glenferrie Drive, Rohna
T +61 7 555 36000
F +61 7 555 36009
W rpsgroup.com.au

Client

Lend Lease

Project

YARRABILBA

PRECINCT 2
PRELIMINARY PLANNING
FUNCTIONAL LAYOUT

KN GROUP PTY LTD
CONSULTING ENGINEERS

LEVEL 2 - 71 GREY STREET
SOUTH BRISBANE
QUEENSLAND 4101
PHONE 07 3017 1900
FAX 07 3017 1911
EMAIL kn@knpl.com.au
ABN 35 112 053 611

Approved - RPEQ 12805

Drawing Title

**V01 FUNCTIONAL LAYOUT
ROADWORKS PLAN
SHEET 2 OF 2**

Drawn	Designed	Checked	Date
JAS	JAS	GBG	SEPT 14

Scale

AS SHOWN

Sheet

1 of 5

Drawing No

A1 13-106-SK052

Revision

C

PLANS AND DOCUMENTS
referred to in the PDA APPROVAL


15 DEC 2014

MEDQ


SCALE

10 5 0 10 20 30 40 50 60 70 80 90 100m


1:1000 (A1 UNREDUCED)

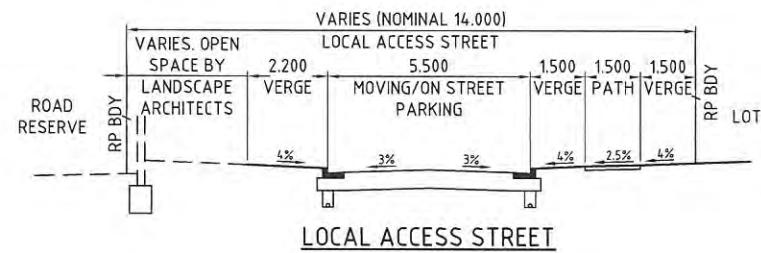


A SECTION
SCALE 1:100

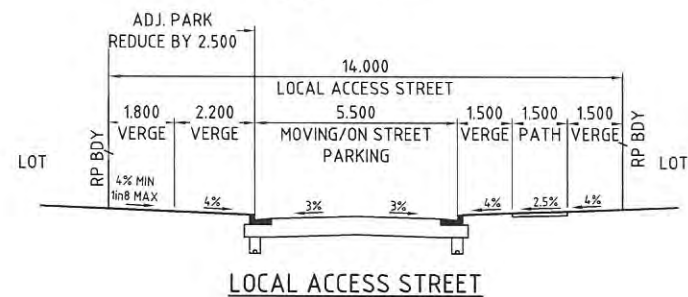


B SECTION
SCALE 1:100

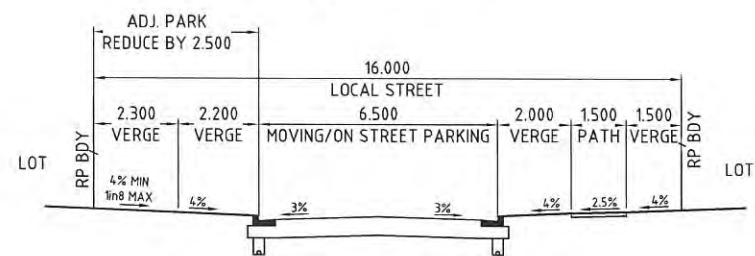


C SECTION
SCALE 1:100

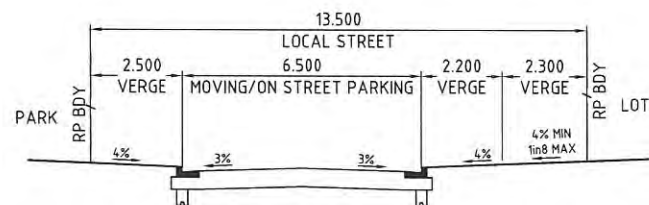

D SECTION
SCALE 1:100

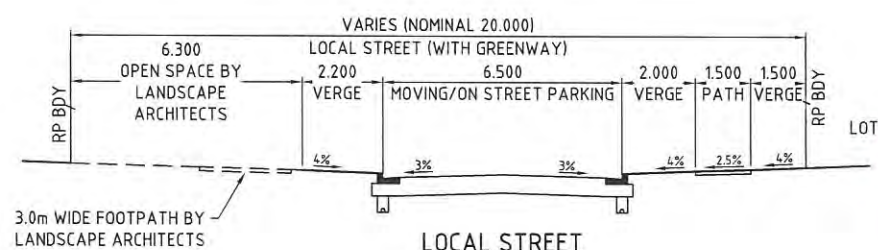


E SECTION
SCALE 1:100

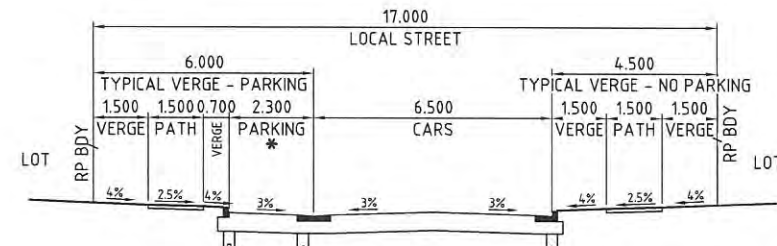


F SECTION
SCALE 1:100

* DENOTES CAR PARKING NOT CONTINUOUS ALONG STREET. VERGE WIDTH ADJUSTS WITH/WITHOUT CAR PARKING

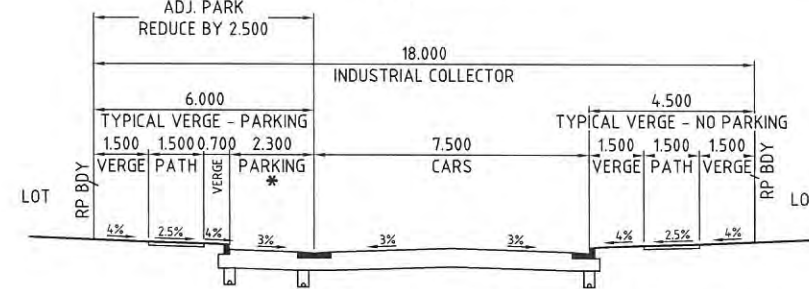


G SECTION
SCALE 1:100

* DENOTES CAR PARKING NOT CONTINUOUS ALONG STREET. VERGE WIDTH ADJUSTS WITH/WITHOUT CAR PARKING

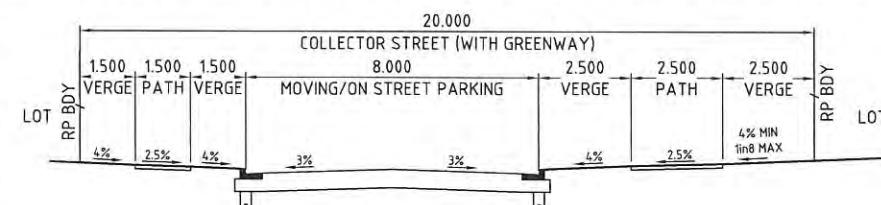


H SECTION
SCALE 1:100

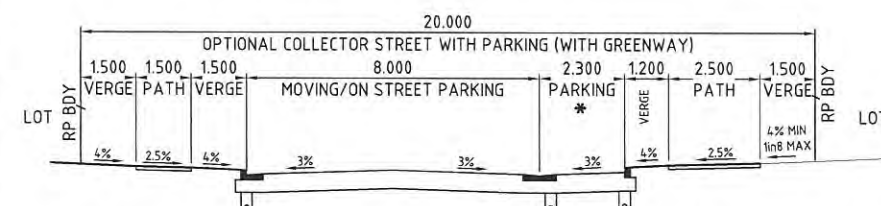

H2 SECTION
SCALE 1:100

* DENOTES CAR PARKING NOT CONTINUOUS ALONG STREET. VERGE WIDTH ADJUSTS WITH/WITHOUT CAR PARKING

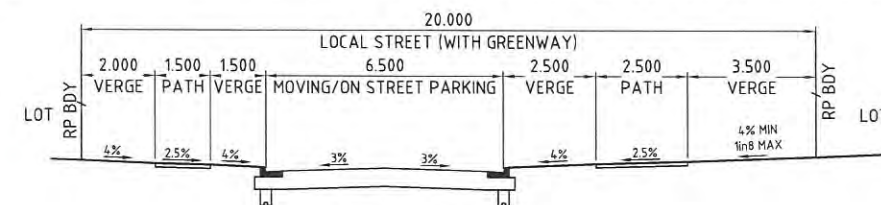

I SECTION
SCALE 1:100

SCALE
1 : 100 (A1 UNREDUCED)

DO NOT SCALE THIS DRAWING
IF IN DOUBT - ASK!

NORTH

LOCALITY PLAN

CAMP CABLE ROAD

YARRABILBA PRECINCT 2

YARRABILBA

REVISIONS

No	Description	Date	By
A	APPROVAL	01/09/14	NC
B	SECTION TITLES AMENDED	15/10/14	NC
C	SECTION H2 ADDED	23/10/14	NC
D	ROAD WIDTH AMENDED	04/11/14	LO

Associated Consultants

RPS
RPS Australia East Pty Ltd
ACN 140 292 762
ABN 44 140 292 762
Suite 4, Robina East Duty Corporate Park
T +61 7 555 36900
F +61 7 555 36999
W rpsgroup.com.au

Client

Lend Lease

Project

YARRABILBA
PRECINCT 2
PRELIMINARY PLANNING
FUNCTIONAL LAYOUT

KN GROUP PTY LTD
CONSULTING ENGINEERS

LEVEL 2 - 71 GREY STREET
SOUTH BRISBANE
QUEENSLAND 4101
PHONE 07 3017 1900
FAX 07 3017 1911
EMAIL kn@knpl.com.au
ABN 35 112 053 611

Approved - RPEQ 12805

Drawing title

**V01 FUNCTIONAL LAYOUT
TYPICAL SECTIONS**

Drawn	Designed	Checked	Date
JAS	JAS	GBG	SEPT 14


Scale	Sheet
AS SHOWN	- of 5

Drawing No	Revision
A1	D

PLANS AND DOCUMENTS
referred to in the PDA APPROVAL

15 DEC 2014

MEDQ

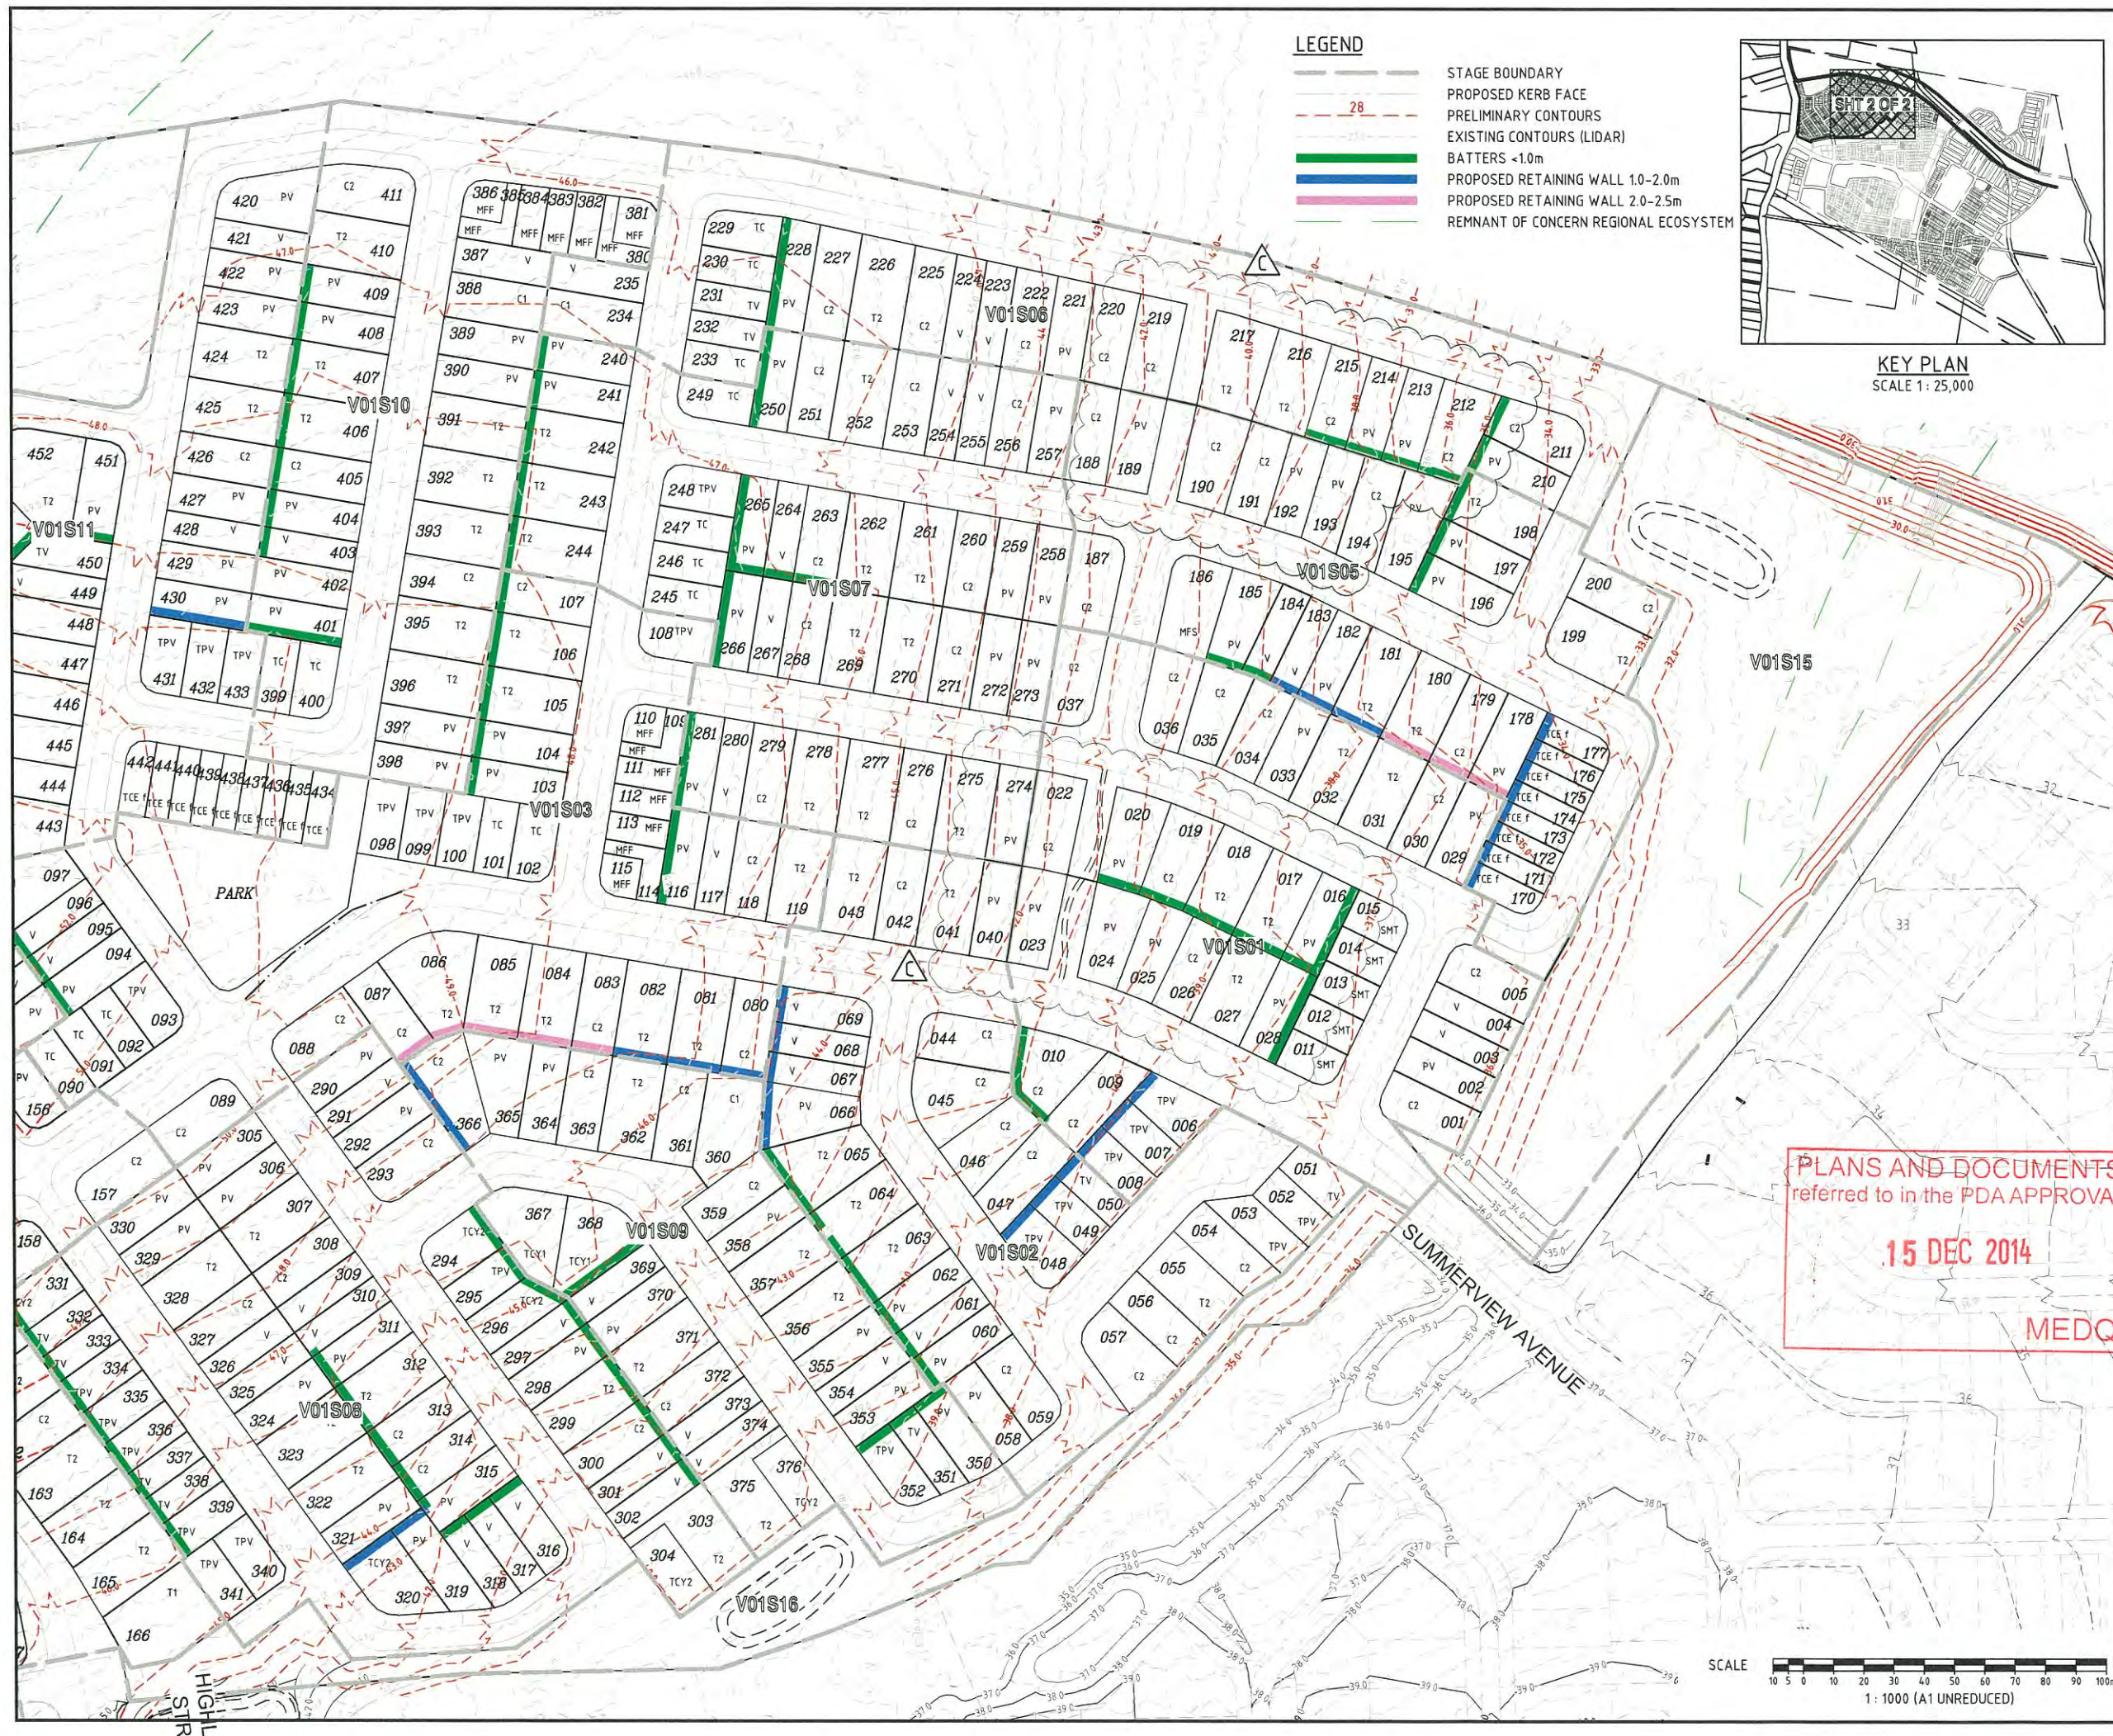

IF IN DOUBT - ASK!

LOCALITY PLAN

REVISIONS

No	Description	Date	B
A	APPROVAL	01/09/14	NC
B	BUS BAYS AMENDED	24/10/14	NC
C	LOT LAYOUT AMENDED	07/11/14	JA

Associated Consultants

RPS Australia East Pty Ltd
ACN 140 292 762
ABN 44 140 292 762
Suite 4 - Robina East Quay Corporate Park
(North Building) 24-26 Glenfern Drive, Rob
PO Box 1048 Robina QLD 4226
T +61 7 555 30900
F +61 7 555 30999
w rpsgroup.com.au

Client

Project

PRECINCT 2
PRELIMINARY PLANNING
FUNCTIONAL LAYOUT

KN GROUP PTY LTD
CONSULTING ENGINEERS

LEVEL 2 - 71 GREY STREET
SOUTH BRISBANE
QUEENSLAND 4101
PHONE 07 3017 1900
FAX 07 3017 1911
EMAIL kn@knpl.com.au
ABN 35 112 053 611

Approved - RPEQ 12805

Drawing Title

V01 FUNCTIONAL LAYOUT
EARTHWORKS PLAN
SHEET 2 OF 2

Drawn	Designed	Checked	Date
JAS	JAS	GBG	SEPT 14


Scale	Sheet
AS SHOWN	- of 5

Drawing No	Revision
A1	C

PLANS AND DOCUMENTS
referred to in the PDA APPROVAL

15 DEC 2014

MEDQ

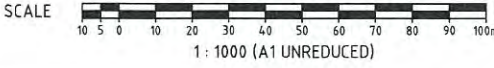

MINIMUM PARK AREA - 5000SQM
(EXCLUDING REMNANT ENDANGERED REGIONAL ECOSYSTEM)

THROUGH DETAILED DESIGN THE LOCATION OF PARK BOUNDARIES MAY BE ALTERED.

PLANS AND DOCUMENTS
referred to in the PDA APPROVAL

15 DEC 2014

MEDQ



YARRABILBA PRECINCT TWO - OPEN SPACE CONCEPT PLAN 01

NOTE: This plan is indicative only, and specific uses, road alignment, boundaries, setbacks, and building layout shown may vary due to detailed design consideration. ©2014 Lend Lease Communities (Australia). All rights reserved. Except as permitted by Lend Lease, no part of this publication may be reproduced or distributed in any form or by any means, or stored in a database or retrieval system, without the permission of Lend Lease.

LOCAL RECREATION PARK
MINIMUM PARK AREA 500sq m



PLANS AND DOCUMENTS
referred to in the PDA APPROVAL

15 DEC 2014

MEDQ

Legend

-  Proposed trees - refer Precinct Two Plant Schedule.
-  Project signature planting such as *Araucaria cunninghamii* and *Ficus macrophylla*.
-  Seating node with signature walls, shade trees & community seating.
-  Open lawn area for informal active recreation.
-  Shared path 2.5m wide.
-  Low walls to match signature stone.
-  Scattered exotic flowering trees and grass to edge of park.

Note : Paths, seating, drinking fountain, lock rail and bollards will be provided - refer to Yarrabilba Furniture and Finishes palette for typical examples.

YARRABILBA PRECINCT TWO - OPEN SPACE CONCEPT PLAN 01a

NOTE: This plan is indicative only, and specific uses, road alignment, boundaries, setbacks, and building layout shown may vary due to detailed design consideration. ©2014 Lend Lease Communities (Australia). All rights reserved. Except as permitted by Lend Lease, no part of this publication may be reproduced or distributed in any form or by any means, or stored in a database or retrieval system, without the permission of Lend Lease.



Road and Street Landscape Character

A. Yarrabilba Drive - A canopy dominated trunk collector with tall Eucalypt and urban character trees providing shade canopy and pedestrian scale to verges with a simple grassed and textured understorey. Species to match those used in Precinct 1.

B. Urban setting on a trunk collector with formally placed urban street trees in scale with surrounding development with detailed pedestrian level plantings and landscape. Includes frequent small scale trees for pedestrian shade, medium canopy trees over roads and tall accent feature trees & feature paving.

C. Open parkland setting on a local street with the character of adjacent park flowing into streetscape, generally medium height native shade and urban tree canopy over grassland.

D. Endemic character streetscape - mix of canopy from adjacent natural areas to provide shade to paths and a dominant character to the streetscape.

E. Greenway streets with widened verge and double shade canopy to one side where possible. Trees with medium height canopy and grass dominated surface treatment. Species to match those used in Precinct 1.

F. Canopy dominated trunk collector with landmark and urban character trees as well as smaller trees providing shade canopy and pedestrian scale. A simple grassed and textured understorey.

G. Suburban local street with medium to low scale canopy trees placed informally to provide a unifying element to residential streets across Yarrabilba. Species selection is dominated by native trees punctuated by groups of flowering feature native or exotic trees. Feature trees may vary for differentiation between villages.

H. Adjacent the Southern Infrastructure Corridor (SIC) street trees will include a mix of landmark trees to match the scale of the SIC and smaller dense canopy trees for shade, pedestrian scale and screening at street level.

Notes:
 - For locations and dimensions of street carriageways and footpaths refer to engineering cross sections - dwg no. 13-106-SK007 and SK008.
 - For street tree size and typical details refer to Precinct Two Plant Schedules.

PLANS AND DOCUMENTS
referred to in the PDA APPROVAL

15 DEC 2014

MEDQ

YARRABILBA PRECINCT TWO - ROAD AND STREETScape LANDSCAPE CHARACTER

NOTE: This plan is indicative only, and specific uses, road alignment, boundaries, setbacks, and building layout shown may vary due to detailed design consideration. ©2014 Lend Lease Communities (Australia). All rights reserved. Except as permitted by Lend Lease, no part of this publication may be reproduced or distributed in any form or by any means, or stored in a database or retrieval system, without the permission of Lend Lease.


Legend

- 1 Shared path 2.5m wide.
- 2 3m wide shared path on top of bund
- 3 Water inlet pond with aquatic vegetation.
- 4 Flood storage area to hydraulic engineers details.
- 5 Drainage line crossing treatment with bridge like elements - variation in road pavement, landscape treatment and vegetation.
- A Remnant 'of Concern' Regional Ecosystem – retain existing vegetation, rehabilitate and remove weed species.
- B Riparian character rehabilitation – building on the Remnant 'of Concern' Vegetation on the creek lines revegetate the riparian beds and banks of the creek lines on a manner that respects the water regime of the developed site.
- C Riparian canopy rehabilitation with grassed verges to residential areas and incorporation of water quality elements where suitable.
- D Local native character streetscape mix of canopy trees from adjacent natural areas in a informal style to provide shade to paths and a dominant character to the streetscape.
- E Low shrubs & groundcovers to suit riparian zone and drainage regime. Trees not permitted due to bund engineering constraints.

PLANS AND DOCUMENTS
referred to in the PDA APPROVAL

15 DEC 2014

MEDQ

PRECINCT TWO - RECONFIGURATION OF A LOT APPLICATION TWO LINEAR PARK CONCEPT PLAN

NOTE: This plan is indicative only, and specific uses, road alignment, boundaries, setbacks, and building layout shown may vary due to detailed design consideration. © 2012 Lend Lease Communities (Australia). All rights reserved. Except as permitted by Lend Lease, no part of this publication may be reproduced or distributed in any form or by any means, or stored in a database or retrieval system, without the permission of Lend Lease.

LEGEND

- YARRABILBA SITE BOUNDARY
- RECONFIGURATION OF A LOT APPLICATION TWO
- OPEN SPACE

PLANS AND DOCUMENTS
referred to in the PDA APPROVAL

15 DEC 2014

MEDQ



PRECINCT TWO - RECONFIGURATION OF A LOT APPLICATION TWO PROPOSED OPEN SPACE ALLOTMENT NUMBERS

NOTE: This plan is indicative only, and specific uses, road alignment, boundaries, setbacks, and building layout shown may vary due to detailed design consideration. ©2014 Lend Lease Communities (Australia). All rights reserved. Except as permitted by Lend Lease, no part of this publication may be reproduced or distributed in any form or by any means, or stored in a database or retrieval system, without the permission of Lend Lease.

